



EQT (Chevron Data) 02-13-21

Marshall County, WV Chevron

Hines Pad EQT

M06H - Slot M06H

OH

Design: Hines M06H As Drilled

Standard Survey Report

19 July, 2021

05/27/2022



EQT
Survey Report

Database: EDM_Definitive	Local Co-ordinate Reference: Well M06H - Slot M06H
Company: EQT (Chevron Data) 02-13-21	TVD Reference: GL at 1125.00' & 25' KB @ 1149.998usft
Project: Marshall County, WV Chevron	MD Reference: GL at 1125.00' & 25' KB @ 1149.998usft
Site: Hines Pad EQT	North Reference: True
Well: M06H	Survey Calculation Method: Minimum Curvature
Wellbore: OH	
Design: Hines M06H As Drilled	

Project Marshall County, WV Chevron

Map: US State Plane 1983	System Datum: Mean Sea Level
Geo: North American Datum 1983	
Map Zone: West Virginia Northern Zone	

Site Hines Pad EQT

Site Position:	Northing: 514,501.050 usft	Latitude: 39.91
From: Map	Easting: 1,631,895.930 usft	Longitude: -80.70
Position Uncertainty: 1.500 usft	Slot Radius: 13-3/16 "	Grid Convergence: -0.7653 °

Well M06H - Slot M06H

Well Position: +N/-S 0.000 usft	Northing: 514,422.018 usft	Latitude: 39.9061759
+E/-W 0.000 usft	Easting: 1,632,054.071 usft	Longitude: 80.6993461°W
Position Uncertainty: 0.000 usft	Wellhead Elevation: 0.000 usft	Ground Level: 1,124.998 usft

Wellbore OH

Magnetics	Model Name	Sample Date	Declination (°)	Dip Angle (°)	Field Strength (nT)
	IGRF2000	12/31/2004	-8.4133	68.2443	53,878.81392253

Design Hines M06H As Drilled

Audio:

Version: 1.0	Phase: ACTUAL	Tie On Depth: 0.000
---------------------	----------------------	----------------------------

Vertical Section:	Depth From (TVD) (usft)	+N/-S (usft)	+E/-W (usft)	Direction (°)
	0.000	0.000	0.000	158.934

Survey Program Date 7/19/2021 ACTUAL Tie On Depth: 0.000

From (')	To (usft)	Survey (Wellbore)	Tool Name	Description
0.00	376.999	SDI Keeper v1.04 (OH)	SDI Standard Keeper 104	Standard Wireline Keeper ver 1.0.4
0.00	7,002.998	MWD (OH)	MWD c	MWD - Standard c


Survey

Measured Depth (usft)	Inclination (°)	Azimuth (°)	Vertical Depth (usft)	Subsea Depth (usft)	+N/-S (usft)	+E/-W (usft)	Vertical Section (usft)	Dogleg Rate (°/100usft)	Build Rate (°/100usft)	Turn Rate (°/100usft)



EQT
Survey Report

Database:	EDM_Definitive	Local Co-ordinate Reference:	Well M06H - Slot M06H
Company:	EQT (Chevron Data) 02-13-21	TVD Reference:	GL at 1125.00' & 25' KB @ 1149.998usft
Project:	Marshall County, WV Chevron	MD Reference:	GL at 1125.00' & 25' KB @ 1149.998usft
Site:	Hines Pad EQT	North Reference:	True
Well:	M06H	Survey Calculation Method:	Minimum Curvature
Wellbore:	OH		
Design:	Hines M06H As Drilled		

Measured Depth (usft)	Inclination (°)	Azimuth (°)	Vertical Depth (usft)	Subsea Depth (usft)	MD Reference		Vertical Section (usft)	Dogleg Rate (°/100usft)	Build Rate (°/100usft)	Turn Rate (°/100usft)
					+N/-S (usft)	+E/-W (usft)				
207.999	0.000	207.970	207.999	-941.999	0.336	-0.005	-0.380	0.74865	0.68000	-20.12404
232.999	0.000	232.970	232.999	-816.999	0.336	0.000	-0.455	0.34611	0.08000	0.338018
257.999	0.000	257.970	257.999	-691.999	0.336	-0.005	-0.557	0.30045	0.24000	-37.24008
282.999	0.000	282.970	282.999	-567.000	0.336	+0.010	-0.643	0.39327	0.12000	-37.00014
307.998	0.328	219.750	307.998	-842.000	0.525	-0.052	-0.724	0.09324	-0.08000	-8.32002
332.997	0.400	284.780	332.997	-817.001	0.561	-0.811	-0.815	0.45887	0.44000	20.12004
357.996	0.450	219.180	357.996	-792.001	0.601	-0.992	-0.918	0.14190	-0.04000	-19.36004
382.995	0.520	277.000	382.995	-666.010	0.773	-2.471	-1.615	0.22870	0.22603	-3.56165
407.994	0.600	264.720	407.994	-541.013	0.774	-2.912	-1.770	0.65308	0.45181	-33.12910
536.993	0.690	263.650	536.993	-415.017	0.994	-3.445	-1.886	0.56663	0.46875	-18.96879
561.992	0.730	219.320	561.992	-290.024	0.606	-4.072	-1.936	1.29331	1.12903	-30.09684
586.991	0.820	215.090	586.991	-165.035	0.187	-4.826	-1.909	0.88293	0.80645	-13.64519
611.990	0.900	207.920	611.990	-40.050	-0.273	-5.664	-1.781	1.10018	0.83871	-22.12908
636.989	2.070	204.100	636.989	185.069	-0.874	-6.553	-1.540	0.68919	0.54839	-12.06454
721.000	0.990	202.190	721.000	-428.088	-1.531	-7.433	-1.243	0.34392	-0.25807	-6.41937
746.000	2.120	200.470	746.000	-303.109	-2.250	-8.330	-0.894	0.47822	0.43750	-5.37501
771.000	2.060	208.140	771.000	-178.130	-2.989	-9.190	-0.514	0.35560	-0.22581	-7.51614
796.000	1.720	222.310	796.000	-53.147	-3.705	-9.918	-0.108	1.25865	-1.09678	-18.80649
821.000	1.710	219.600	821.000	171.855	-4.406	-10.525	0.328	0.27317	-0.03226	-9.06453
877.000	1.310	211.590	877.000	-272.172	-5.065	-11.005	0.771	1.45319	-1.29033	-25.61296
902.000	1.000	204.370	902.000	-147.178	-5.613	-11.302	1.175	1.10198	-1.00000	-23.19360
927.000	0.910	182.970	927.000	-209.182	-6.121	-11.430	1.603	1.14209	-0.28125	-66.87514
952.000	0.670	154.130	952.000	-178.185	-6.530	-11.364	2.009	1.47414	-0.77420	-93.03245
977.000	0.580	133.420	977.000	-147.188	-6.820	-11.151	2.356	0.78078	0.03226	-66.58078
1,002.000	0.810	98.940	1,002.000	-116.190	-6.980	-10.801	2.631	1.48239	0.41936	-111.45184
1,027.000	0.670	92.780	1,027.000	-85.193	-7.023	-10.404	2.814	0.51881	-0.45161	-19.87101
1,052.000	0.900	75.730	1,052.000	-53.195	-6.977	-10.001	2.916	0.79065	0.40625	-53.28136
1,077.000	0.680	74.330	1,077.000	-22.198	-6.876	-9.619	2.959	0.45523	-0.45161	-4.51614
1,102.000	0.670	73.170	1,102.000	8.800	-6.783	-9.299	2.987	0.29307	-0.29032	-3.74194
1,127.000	0.170	90.470	1,127.000	39.799	-6.730	-9.107	3.007	1.29664	-1.29033	23.54843
1,152.000	0.100	181.060	1,152.000	71.799	-6.750	-9.060	3.043	0.66401	-0.21875	314.34438
1,177.000	0.650	204.390	1,177.000	102.798	-6.880	-9.204	3.112	1.92163	1.77420	172.03261
1,202.000	1.320	239.220	1,202.000	133.793	-7.173	-9.667	3.219	2.36888	2.35484	15.58068
1,227.000	2.050	239.670	1,227.000	164.779	-7.644	-10.467	3.371	2.16171	2.16129	1.45162
1,345.000	2.700	234.650	1,345.000	195.752	-8.347	-11.541	3.641	2.19957	2.09678	-16.19358
1,370.000	0.320	202.310	1,370.000	227.708	-9.351	-12.891	4.093	2.00556	1.96875	-7.31251
1,395.000	0.390	206.220	1,395.000	258.646	-10.627	-14.361	4.755	2.15832	1.77420	-19.61294
1,420.000	4.490	222.160	1,420.000	289.564	-12.252	-15.933	5.707	2.18741	1.96775	-13.12906
1,445.000	5.200	221.970	1,445.000	320.453	-14.196	-17.687	6.890	2.29091	2.29033	-0.61290
1,501.000	5.840	221.340	1,501.000	351.309	-16.425	-19.668	8.258	2.07372	2.06452	-2.03226
1,526.000	6.410	221.340	1,526.000	382.126	-18.988	-21.923	9.839	1.78125	1.78125	0.00000
1,551.000	6.590	219.520	1,551.000	412.927	-21.658	-24.196	11.513	0.86119	0.54839	-5.87098



EQT
Survey Report

Database:	EDM_Definitive	Local Co-ordinate Reference:	Well M06H - Slot M06H
Company:	EQT (Chevron Data) 02-13-21	TVD Reference:	GL at 1125.00' & 25' KB @ 1149.998usft
Project:	Marshall County, WV Chevron	MD Reference:	GL at 1125.00' & 25' KB @ 1149.998usft
Site:	Hines Pad EQT	North Reference:	True
Well:	M06H	Survey Calculation Method:	Minimum Curvature
Wellbore:	OH		
Design:	Hines M06H As Drilled		

Survey					MD Reference:						
Measured Depth (usft)	Inclination (°)	Azimuth (°)	Vertical Depth (usft)	Subsea Depth (usft)	North Reference		Vertical Section (usft)	Dogleg Rate (°/100usft)	Build Rate (°/100usft)	Turn Rate (°/100usft)	
					+N/-S (usft)	+E/-W (usft)					
1,584.715	8.720	170.050	1,584.715	444.718	-94.410	-28.485	13.293	0.52721	0.46387	-1.80846	
1,625.498	8.590	170.010	1,625.498	475.500	-94.425	-29.700	15.171	0.75656	0.41936	-5.32259	
1,657.264	7.900	170.010	1,657.264	507.264	-94.430	-31.270	17.215	0.86602	0.65625	-7.43750	
1,658.029	7.600	170.810	1,658.029	538.029	-94.434	-31.710	18.200	0.93145	0.68452	-7.34517	
1,719.777	7.200	170.810	1,719.777	569.777	-94.439	-33.600	21.252	0.99037	0.84375	-11.16125	
1,750.510	7.420	210.000	1,750.510	600.521	-94.463	-38.365	23.240	0.47981	0.35484	2.51613	
1,781.264	7.070	220.000	1,781.264	631.266	-94.724	-40.900	25.176	0.60181	-0.51613	2.41936	
1,812.008	7.400	210.000	1,812.008	662.010	-94.757	-43.160	27.071	0.88320	0.61290	2.25484	
1,842.747	7.600	200.000	1,842.747	692.749	-94.807	-45.091	28.979	0.26804	-0.12902	-1.70968	
1,874.470	7.200	210.000	1,874.470	724.482	-94.819	-48.855	31.043	1.09792	-0.03125	-3.50002	
1,905.224	7.300	210.000	1,905.224	755.226	-94.840	-51.090	33.131	0.47646	-0.35484	-2.48388	
1,935.978	7.010	210.000	1,935.978	785.978	-94.836	-53.400	35.243	0.50689	-0.29032	-3.29033	
1,966.725	7.100	210.000	1,966.725	816.727	-61.203	-58.742	37.357	0.92205	0.58065	4.25485	
1,997.466	7.200	210.000	1,997.466	847.469	-61.208	-58.122	39.493	0.42332	0.06452	-3.48388	
2,107.766	5.450	208.780	2,107.766	957.769	-70.100	-64.853	46.767	1.92479	-1.78379	-3.54956	
2,196.518	3.610	209.160	2,196.518	1,046.521	-80.832	-68.030	50.978	2.71927	-2.71911	0.42697	
2,285.419	2.400	210.720	2,285.419	1,135.421	-84.841	-70.176	53.574	0.71059	-0.68539	4.00001	
2,375.378	1.320	217.700	2,375.378	1,225.380	-85.887	-72.222	54.188	2.44138	-1.20000	72.26681	
2,454.350	1.270	248.270	2,454.350	1,314.363	-84.779	-73.421	52.723	1.70096	-0.05618	80.34848	
2,553.336	1.400	12.000	2,553.336	1,403.339	-82.748	-73.373	50.845	0.61589	0.14607	25.87646	
2,643.323	1.130	110.190	2,643.323	1,493.325	-81.980	-72.306	50.512	2.12887	-0.30000	108.76689	
2,732.268	2.670	150.520	2,732.268	1,582.271	-84.223	-70.386	53.295	2.40184	1.95506	45.32593	
2,821.121	3.720	163.170	2,821.121	1,671.123	-88.934	-68.451	58.386	1.26020	0.96629	14.20228	
2,910.966	2.600	163.950	2,910.966	1,760.968	-93.985	-66.959	63.636	0.83502	-0.83334	0.91111	
3,000.874	2.150	167.000	3,000.874	1,850.877	-97.886	-65.934	67.645	0.92370	-0.91111	3.43334	
3,089.839	1.200	217.310	3,089.839	1,939.841	-100.263	-66.124	69.795	1.87643	-1.07865	56.43832	
3,179.825	0.750	218.330	3,179.825	2,029.827	-101.530	-67.037	70.649	0.46156	-0.45556	-4.36668	
3,268.815	0.810	217.830	3,268.815	2,118.817	-102.602	-67.806	71.373	0.15222	0.13483	4.77529	
3,358.804	0.900	218.570	3,358.804	2,208.806	-103.578	-68.818	71.920	0.29641	-0.01111	18.82226	
3,447.788	1.250	247.490	3,447.788	2,297.791	-104.349	-70.270	72.118	0.45633	0.37079	14.51688	
3,537.769	1.320	256.180	3,537.769	2,387.772	-104.929	-72.016	72.031	0.23195	-0.12222	9.63335	
3,626.754	0.670	275.200	3,626.754	2,476.757	-105.068	-73.611	71.588	0.42393	-0.16854	21.48319	
3,716.742	0.900	278.720	3,716.742	2,566.745	-104.891	-75.068	70.898	0.09966	-0.07778	3.82223	
3,805.736	0.450	284.870	3,805.736	2,655.738	-104.634	-76.083	70.294	0.53448	-0.49438	18.14610	
3,895.734	0.710	315.290	3,895.734	2,745.736	-104.309	-76.582	69.812	0.22339	-0.16667	22.68893	
3,985.732	0.250	344.970	3,985.732	2,835.734	-103.916	-76.813	69.362	0.17181	-0.02222	32.92229	
4,074.731	0.710	343.050	4,074.731	2,924.733	-103.543	-76.919	68.976	0.09034	-0.08989	-2.08989	
4,163.730	0.290	368.830	4,163.730	3,013.732	-103.243	-77.140	68.616	0.18228	0.08989	-37.33715	
4,253.728	0.370	327.430	4,253.728	3,103.731	-102.852	-77.471	68.132	0.14249	0.08889	19.55560	
4,342.727	0.350	303.070	4,342.727	3,192.729	-102.459	-77.852	67.629	0.16799	-0.02247	-26.69668	
4,432.724	0.300	290.050	4,432.724	3,282.726	-102.002	-78.329	67.031	0.21693	0.16667	19.08893	
4,521.721	0.460	308.790	4,521.721	3,371.723	-101.477	-78.852	66.353	0.12207	-0.04494	-13.58430	



EQT
Survey Report

Database:	EDM Definitive	Local Co-ordinate Reference:	Well M06H - Sigt M06H
Company:	EQT (Chevron Data) 02-13-21	TVD Reference:	GL at 1125.00' & 25' KB @ 1149.998usft
Site:	Hines Pad EQT	North Reference:	True
Well:	M06H	Survey Calculation Method:	Minimum Curvature
Wellbore:	GH		
Design:	Hines M06H As Drilled		

Survey					MD Reference:						
Measured Depth (usft)	Inclination (°)	Azimuth (°)	Vertical Depth (usft)	Subsea Depth (usft)	North Reference:		Vertical Section (usft)	Dogleg Rate (°/100usft)	Build Rate (°/100usft)	Turn Rate (°/100usft)	
					+N/-S (usft)	+E/-W (usft)					
LP=823' MD/8331' TVD											
6,825.000	89.230	158.310	6,320.980	5,170.982	-933.657	-122.048	827.392	0.00626	0.00000	0.00000	
6,911.988	89.350	158.720	6,322.083	5,172.085	-1,016.453	-89.459	916.368	0.48004	0.13485	0.46075	
7,000.990	89.930	160.080	6,323.380	5,173.382	-1,099.752	-58.149	1,005.354	1.58348	-0.41573	1.52809	
7,089.995	90.890	155.630	6,324.993	5,174.985	-1,180.048	-24.165	1,095.298	5.05476	0.00000	-5.05557	
7,179.000	89.250	150.360	6,325.514	5,176.516	-1,262.277	16.283	1,183.771	5.78621	0.07865	-5.78653	
7,268.005	89.930	147.660	6,328.061	5,178.063	-1,339.419	62.598	1,272.405	3.02278	-0.07778	-3.02223	
7,358.000	89.950	147.010	6,329.669	5,179.671	-1,414.330	110.625	1,359.573	0.73100	-0.03371	-0.73034	
7,448.005	88.710	150.490	6,331.507	5,181.509	-1,491.208	157.359	1,448.110	3.77532	-0.26667	3.76667	
7,538.000	88.000	150.730	6,333.301	5,183.303	-1,568.722	201.054	1,536.150	0.52370	0.30337	0.42697	
7,627.984	88.000	151.450	6,334.974	5,184.976	-1,647.511	244.521	1,625.297	0.75100	-0.10000	0.74445	
7,717.984	88.000	152.050	6,336.722	5,186.724	-1,726.958	284.565	1,713.827	4.04431	-0.03371	4.04495	
7,808.984	89.200	157.990	6,338.246	5,188.248	-1,809.485	320.414	1,803.724	3.28798	0.37778	3.26667	



EQT
Survey Report

Database:	EDM_Definitive	Local Co-ordinate Reference:	Well M06H - Stop M06H
Company:	EQT (Chevron Data) 02-13-21	TVD Reference:	GL at 1125.00' & 25' KB @ 1149.998usft
Project:	Marshall County, WV Chevron	MD Reference:	GL at 1125.00' & 25' KB @ 1149.998usft
Site:	Hines Pad EQT	North Reference:	True
Well:	M06H	Survey Calculation Method:	Minimum Curvature
Wellbore:	OH		
Design:	Hines M06H As Drilled		

Measured Depth (usft)	Inclination (°)	Azimuth (°)	Vertical Depth (usft)	Subsea Depth (usft)	MD Reference:		Vertical Section (usft)	Dogleg Rate (°/100usft)	Build Rate (°/100usft)	Turn Rate (°/100usft)
					+N/-S (usft)	+E/-W (usft)				



EQT
Survey Report

Database:	EDM_Definitive	Local Co-ordinate Reference:	Well M06H - Slot M06H
Company:	EQT (Chevron Data) 02-13-21	TVD Reference:	GL at 1125.00' & 25' KB @ 1149.998usft
Project:	Marshall County, WV Chevron	MD Reference:	GL at 1125.00' & 25' KB @ 1149.998usft
Site:	Mines Pad EQT	North Reference:	True
Well:	M06H	Survey Calculation Method:	Minimum Curvature
Wellbore:	OH		
Design:	Mines M06H As Drilled		

Wellbore	Measured Depth (usft)	Inclination (°)	Azimuth (°)	Vertical Depth (usft)	Subsea Depth (usft)	North Reference:		Vertical Section (usft)	Dogleg Rate (°/100usft)	Build Rate (°/100usft)	Turn Rate (°/100usft)
						+N/-S (usft)	+E/-W (usft)				
	12,013.97	89.800	158.880	6,373.532	5,223.535	-5,050.537	1,975.031	5,985.697	0.28479	0.06742	0.34832
	12,130.97	89.800	158.880	6,373.742	5,223.744	-5,130.486	2,019.403	6,073.549	0.48492	-0.03371	0.48315
	12,144.97	89.890	162.190	6,374.103	5,224.106	-5,804.537	2,082.688	6,162.736	2.09643	-0.17778	-2.08889
	12,231.91	89.890	163.280	6,374.849	5,224.851	-5,888.695	2,103.459	6,251.211	1.28288	-0.38202	1.22472
	12,317.87	89.900	163.380	6,376.193	5,226.195	-5,968.295	2,141.381	6,339.961	3.91810	-0.46315	0.93315
	12,400.97	89.760	160.120	6,377.214	5,227.217	-6,052.797	2,174.843	6,429.932	4.26371	0.95556	4.15556
	12,509.97	89.650	160.970	6,377.362	5,227.364	-6,136.714	2,204.266	6,518.895	0.86561	0.28090	0.86598
	12,619.97	90.460	157.290	6,378.977	5,226.979	-6,220.794	2,236.342	6,608.878	4.11807	0.47778	-4.08890
	12,728.9	89.480	158.290	6,378.713	5,226.715	-6,300.870	2,271.459	6,697.812	1.38784	-0.65169	-1.19101
	12,814.97	89.570	154.190	6,378.629	5,226.632	-6,380.384	2,308.774	6,786.619	2.29457	0.10112	-2.29214
	12,901.97	89.480	150.710	6,378.647	5,226.949	-6,460.197	2,350.391	6,876.629	3.88798	-0.10000	-3.88567
	12,987.97	89.600	149.040	6,377.183	5,227.185	-6,540.903	2,395.698	6,964.877	2.07884	-0.06667	-2.07778
	13,088.97	89.890	151.620	6,377.563	5,227.566	-6,618.153	2,439.884	7,052.843	3.12699	-0.14607	3.12360
	13,175.97	90.690	154.650	6,377.276	5,227.278	-6,697.503	2,480.166	7,141.368	3.47493	1.11236	3.29214
	13,264.97	89.690	155.590	6,376.321	5,226.323	-6,778.525	2,516.971	7,230.204	2.29666	-0.14607	2.29214
	13,354.97	89.800	159.640	6,376.784	5,226.786	-6,862.025	2,550.512	7,320.180	3.87421	-1.87778	3.38890
	13,443.97	89.000	165.600	6,378.385	5,228.388	-6,946.898	2,577.118	7,408.944	6.64398	0.24719	6.64046
	13,533.97	89.350	166.140	6,379.618	5,229.621	-7,034.157	2,599.125	7,498.281	0.72088	0.30000	0.65556



EQT
Survey Report

Database:	EDM_Definitive	Local Co-ordinate Reference:	Well M06H - Sto(M06H
Company:	EQT (Chevron Data) 02-13-21	TVD Reference:	GL at 1125.00' & 25' KB @ 1149.988usft
Site:	Hines Pad EQT	North Reference:	True
Well:	M06H	Survey Calculation Method:	Minimum Curvature
Wellbore:	OH		
Design:	Hines M06H As Drilled		

Survey

Wellbore	Measured Depth (usft)	Inclination (°)	Azimuth (°)	Vertical Depth (usft)	Subsea Depth (usft)	MD Reference:		Vertical Section (usft)	Dogleg Rate (°/100usft)	Build Rate (°/100usft)	Turn Rate (°/100usft)
						+N/-S (usft)	+E/-W (usft)				
	15.591.97	88.710	154.900	5,407.894	5,257.896	-8,825.794	3,395.362	9,456.379	0.00000	0.00000	0.00000
Projection to TD/Deepest Point of Well=15558' MD/ 6409' TVD											
	15.556.96	88.710	154.900	5,409.131	5,259.134	-8,875.560	3,418.674	9,511.198	0.00000	0.00000	0.00000



EQT
Survey Report

Database:	EDM_Definitive	Local Co-ordinate Reference:	Well M06H - Slot M06H
Company:	EQT (Chevron Data) 02-13-21	TVD Reference:	GL at 1125.00' & 25' KB @ 1149.899usft
Project:	Marcellus County, WV Chevron	MD Reference:	GL at 1125.00' & 25' KB @ 1149.998usft
Site:	Hines Pad EQT	North Reference:	True
Well:	M06H	Survey Calculation Method:	Minimum Curvature
Wellbore:	OH		
Design:	Hines M06H As Drilled		

Design Targets										
Target Name	Dip Angle	Dip Dir.	TVD	+N/-S	+E/-W	Northing	Easting	Latitude	Longitude	
- hit/miss target	(°)	(°)	(usft)	(-99.553)	(-80.254)	(usft)	(usft)			
- Shape										
KOP=4757'	0.000	0.000	4,750.72	-99.553	-80.254	614,299.490	1,331,972.490	39.3059026	80.6996321°W	
Target center	0.255	0.000	0.000	MD (4791.2)	TVD (-4791.2)	(-86 E)				
KOP=6277'	0.000	0.000	6,320.56	-99.553	-80.254	614,299.490	1,331,915.890	39.3033310	80.6997600°W	
Target center	0.255	0.000	0.000	MD (6320.2)	TVD (-6320.2)	(-86 E)				
KOP=8408'	0.000	0.000	8,408.12	-99.553	-80.254	614,299.490	1,335,354.180	39.3318099	80.6871632°W	
Target center	0.255	0.000	0.000	MD (8408.1)	TVD (-8408.1)	(-86 E)				

Formations						
Measured Depth (usft)	Vertical Depth (usft)	Name	Lithology	Dip (°)	Dip Direction (°)	
6,277.600	6,277.600	Top of Marcellus@6277' TVD		-0.5000		

Design Annotations					
Measured Depth (usft)	Vertical Depth (usft)	Local Coordinates		Comment	
		+N/-S (usft)	+E/-W (usft)		
4,750.72	4,750.715	-99.553	-80.254	KOP=4757' MD/4791' TVD	
6,320.56	6,320.560	-99.553	-80.254	KOP=6277' MD/6320' TVD	
8,408.12	8,408.120	-99.553	-80.254	KOP=8408' MD/8408' TVD	


Checked By: _____ Approved By: _____ Date: _____



KB Elevation= GL at 1125.00' & 25' KB @ 1149.998usft
 Ground Elevation= 1124.998
 All measurements were taken from KB Elevation

 Site: Hines Pad EQT
 Well: M06H
 Wellbore: OH
 Design: Hines M06H As Drilled

EQT (Chevron Data) 02-13-21

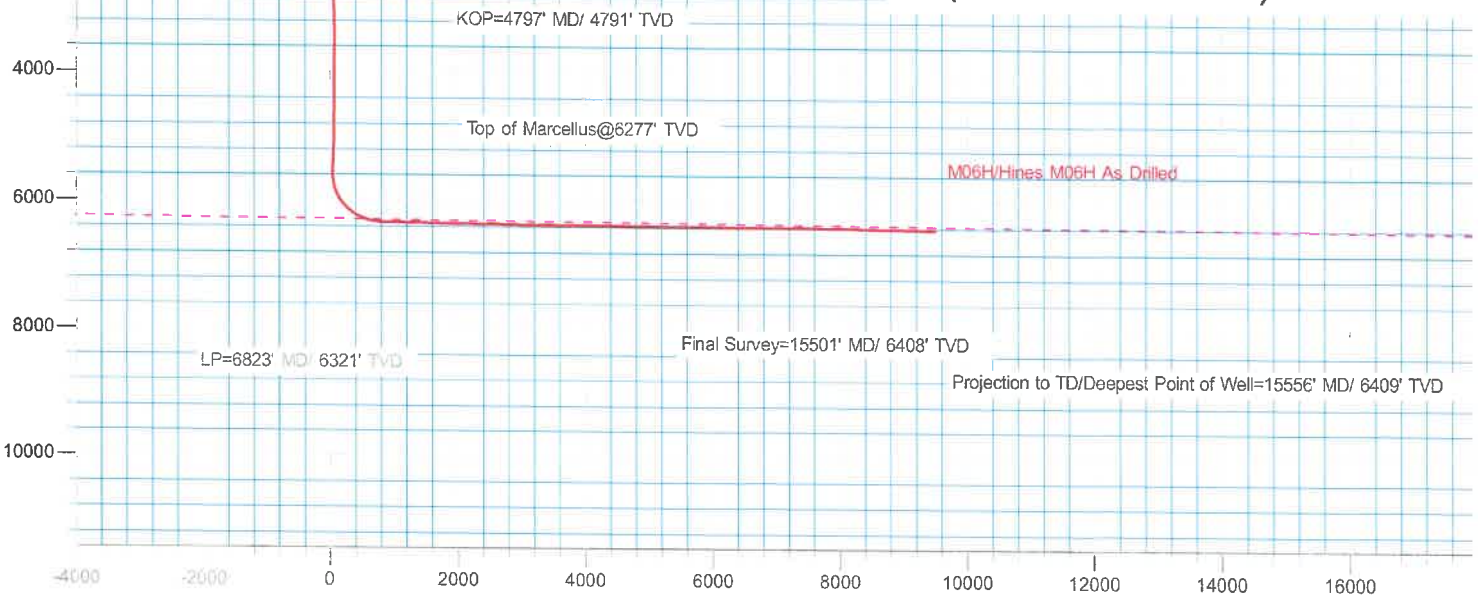

Surface Location: M06H							
+N/-S	+E/-W	Northing	Easting	Latitude	Longitude	Slot	
0.000	0.000	514422.018	1632054.071	39.9061758	80.6993461°W	M06H	
DESIGN TARGET DETAILS							
Name	TVD	Northing	Easting	Latitude	Longitude		
Hines 6H KOP	4790.720	514323.546	1631972.495	39.9059025	80.6996322°W		
Hines 6H LP	6320.982	513490.177	1631919.803	39.9036130	80.6997803°W		
Hines 6H BHL	6409.134	505501.714	1635354.186	39.8818096	80.6871632°W		

