


BHL is located on topo map 11,207 feet south of Latitude: 39° 55' 00"
 SHL is located on topo map 3,833 feet south of Latitude: 39° 55' 00"

SEE PAGE 2 FOR SURFACE OWNERS AND LESSORS

AS DRILLED PLAT

AS-DRILLED LOCATIONS UTM 17-WAD83(M)
SURFACE HOLE LOCATION (SHL)
N:4417391.37 E:525708.06
APPROX LANDING POINT (LP)
N:4417028.64 E:525409.90
BOTTOM HOLE LOCATION (BHL)
N:4415146.45 E:526273.15

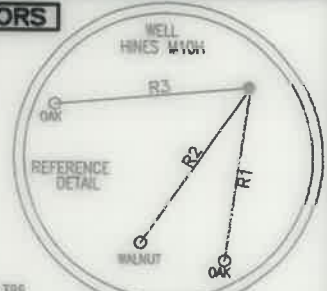

WELL HINES M10H			
M01H	M14H	U15H	U28H
M02H	M13H	U16H	U27H
M03H	M12H	U17H	U26H
M04H	M11H	U18H	U25H
M05H	M10H	U19H	U24H
M06H	M09H	U20H	U23H
M07H	M08H	U21H	U22H

LEGEND

- TOPO MAP POINT
- WELL
- ALL ARE POINTS UNLESS OTHERWISE NOTED
- MINERAL TRACT BOUNDARY
- PARCEL LINES
- WELL REFERENCE
- ROAD
- STREAM CENTER LINE
- LESSORS
- SURFACE OWNERS
- AS-DRILLED

GAS WELLS

- EXISTING WELLS
- PLUGGED WELLS

LINE	BEARING	DISTANCE
R1	S 08°22'13" W	167.79'
R2	S 34°52'17" W	181.81'
R3	S 84°53'03" W	185.06'
R4	N 78°04'19" E	2247.40'
R5	N 64°41'00" E	1811.48'
R6	N 81°12'34" W	924.10'

- NOTES:**
- There are no water wells or developed springs within 250' of proposed well.
 - Proposed well is greater than 100' from perennial stream, wetland, pond, reservoir or lake.
 - There are no native trout streams within 300' of proposed well.
 - Proposed well is greater than 1000' from surface groundwater intake or public water supply.
 - It is not the purpose or intention of this plat to represent surveyed locations of the surface or mineral parcels depicted hereon. The location of the boundary lines, as shown, are based on record deed descriptions, field evidence found and/or tax map position, unless otherwise noted.
 - There are no existing buildings within 625' of proposed well.

THRASHER
 THE THRASHER GROUP, INC.
 600 WHITE OAKS BLVD.
 BRIDGEPORT, WV 26330
 PHONE 304-624-4108

BHL is located on topo map 7,575 feet west of Longitude: 80° 40' 00"
 SHL is located on topo map 9,200 feet west of Longitude: 80° 40' 00"

FILE #: HINES M10H - AS DRILLED
 DRAWING #: HINES M10H - AS DRILLED
 SCALE: 1" = 2000'
 MINIMUM DEGREE OF ACCURACY: 1/2500
 PROVEN SOURCE OF ELEVATION: U.S.G.S. MONUMENT THOMAS 1498.81'

I, THE UNDERSIGNED, HEREBY CERTIFY THAT THIS PLAT IS CORRECT TO THE BEST OF MY KNOWLEDGE AND BELIEF AND SHOWS ALL THE INFORMATION REQUIRED BY LAW AND THE REGULATIONS ISSUED AND PRESCRIBED BY THE DEPARTMENT OF ENVIRONMENTAL PROTECTION.

Signed: *Joseph H. Lowther*
 R.P.E.: _____ L.L.S.: P.S. No. 2346



(+) DENOTES LOCATION OF WELL ON UNITED STATES TOPOGRAPHIC MAPS WVDEP
 OFFICE OF OIL & GAS
 601 57TH STREET
 CHARLESTON, WV 25304

Well Type: Oil Waste Disposal Production Deep Gas Liquid Injection Storage Shallow

WATERSHED: MIDDLE GRAVE CREEK-GRAVE CREEK ELEVATION: 1125.45'
 COUNTY/DISTRICT: MARSHALL / WASHINGTON QUADRANGLE: MOUNDSVILLE, WV 7.5'
 SURFACE OWNER: DONALD HINES ET UX ACREAGE: 114.934±
 OIL & GAS ROYALTY OWNER: DONALD HINES ET UX ACREAGE: 419.163± **05/27/2022**

DRILL CONVERT DRILL DEEPER REDRILL FRACTURE OR STIMULATE PLUG OFF OLD FORMATION
 PERFORATE NEW FORMATION PLUG & ABANDON CLEAN OUT & REPLUG OTHER CHANGE
 (SPECIFY): AS-DRILLED PLAT

TARGET FORMATION: MARCELLUS ESTIMATED DEPTH: TVD: 6,388'± TMD: 13,916'±
 WELL OPERATOR: EQT CHAP, LLC DESIGNATED AGENT: JOSEPH C. MALLOW
 Address: 400 WOODCLIFF DRIVE Address: 427 MIDSTATE DRIVE
 City: CANONSBURG State: PA Zip Code: 15317 City: CLARKSBURG State: WV Zip Code: 26301

DATE: DECEMBER 13, 2021
 OPERATOR'S WELL #: HINES M10H - AS DRILLED
 API WELL #: 47 51 01932
 STATE COUNTY PERMIT



HINES M10H PAGE 2 OF 2 AS DRILLED

	LESSOR	DIST-TM/PAR
A	DONALD HINES ET UX	14-12/30
B	WILLIAM F. RULONG	14-12/25
	CHARLES BURTON RULONG	
	HAROLD DEAN FURBEE	
	DALE FRANCIS FURBEE	
	ROBERT L. RULONG	
	DRU ELLA FOX	
	JOHN T. MORRIS	
	LYNN ELLEN COOK	
	ETHEL M. RULONG	
	TERRY LEE RULONG	
	RICHARD J. RULONG	
	TRACEY LYNN RULONG	
	GARY MORRISON	
	ELIZABETH Y. MORRISON	
ROGER GLEN RULONG		
TRUSTEES LIMESTONE PRESBYTERIAN CHURCH		
CLYDE DOWLER ET UX		
LAURA J. REYES		
C	ARNIE N. GOODNIGHT ET UX	14-12/66
D	MORGAN T. LACEFIELD	14-12/30.5
E	MORGAN T. LACEFIELD	14-12/30.1
F	DONALD M. BOSTON ET AL	14-12/33.2
G	ELIHU B. SERDA ET UX	14-12/45.1
H	SHANNETTE OMEAR	14-12/45
	SANDRA K. FULLER	
	DOUGLAS L. PARSONS	
	DONALD M. BOSTON ET UX	
	DAVID D. PARSONS ET UX	
	JAMES CRAIG PARSONS	
	ROBERT B. FULLER TEST TRUSTEE	
	GRACE I. SCARBOROUGH	
J	SHANNETTE OMEAR	14-12/33
	SANDRA K. FULLER	
	DOUGLAS L. PARSONS	
	DONALD M. BOSTON ET UX	
	DAVID D. PARSONS ET UX	
	JAMES CRAIG PARSONS	
	ROBERT B. FULLER TEST TRUSTEE	
GRACE I. SCARBOROUGH		
K	SHANNETTE OMEAR	14-12/34
	SANDRA K. FULLER	
	DOUGLAS L. PARSONS	
	DONALD M. BOSTON ET UX	
	DAVID D. PARSONS ET UX	
	JAMES CRAIG PARSONS	
ROBERT B. FULLER TEST TRUSTEE		
GRACE I. SCARBOROUGH		
L	RICHARD C. YOHO ET UX	14-13/41
M	TODD R. KETTLER ET UX	14-13/2
N	THOMAS AND EVELYN JOHNSON	14-13/22

	SURFACE OWNER	DIST-TM/PAR
1	DONALD HINES ET UX	14-12/30
2	TERRY L. DERROW ET UX	14-12/30.3
3	IRENE D. MILLER	14-12/25
4	ARNIE N. GOODNIGHT ET UX	14-12/66
5	MORGAN T. LACEFIELD	14-12/30.5
6	MORGAN LACEFIELD	14-12/30.1
7	DONALD M. BOSTON ET UX -- LIFE	14-12/33.2
8	ELIHU B. & MAILA L. SERDA	14-12/45.1
9	HENRY T. PARSONS EST ET AL	14-12/45
10	HENRY T. PARSONS EST ET AL	14-12/33
11	HENRY T. PARSONS EST ET AL	14-12/34
12	RICHARD C. & CARLA V. YOHO	14-13/41
13	TODD & DAWN R. KETTLER	14-13/2
14	EVELYN RUTH JOHNSON	14-13/22

AS-DRILLED LOCATIONS UTM 17-MAD83(M)
SURFACE HOLE LOCATION (SHL)
N:4417391.37 E:525708.06
APPROX LANDING POINT (LP)
N:4417028.64 E:525409.90
BOTTOM HOLE LOCATION (BHL)
N:4415146.45 E:526273.15

05/27/2022

THRASHER

THE THRASHER GROUP, INC.
600 WHITE OAKS BLVD.
BRIDGEPORT, WV 26330
PHONE 304-624-4108

DECEMBER 13, 2021