



west virginia department of environmental protection

Office of Oil and Gas
601 57th Street, S.E.
Charleston, WV 25304
(304) 926-0450
fax: (304) 926-0452

Harold D. Ward, Cabinet Secretary
www.dep.wv.gov

Wednesday, December 20, 2023
PERMIT MODIFICATION APPROVAL
Horizontal 6A / New Drill

EQT PRODUCTION COMPANY
400 WOODCLIFF DR.

CANONSBURG, PA 15317

Re: Permit Modification Approval for KNOB CREEK S-6HM
47-051-02281-00-00

Adding an AST to the pad

EQT PRODUCTION COMPANY

The Office of Oil and Gas has reviewed the attached permit modification for the above referenced permit. The attached modification has been approved and well work may begin. Please be reminded that the oil and gas inspector is to be notified twenty-four (24) hours before permitted well work is commenced.

If there are any questions, please feel free to contact me at (304) 926- 0450.



James A. Martin
Chief

Operator's Well Number: KNOB CREEK S-6HM
Farm Name: DAVID LEE FRANKLIN
U.S. WELL NUMBER: 47-051-02281-00-00
Horizontal 6A New Drill
Date Modification Issued: 12/20/2023

Promoting a healthy environment.

12/22/2023

WEST VIRGINIA COUNTY MAP



PROJECT LOCATION

APPROVED WVDEP OOG Modification 12/20/2023

Knob Creek 1 Site Site Design, Construction Plan, & Erosion and Sediment Control Plans Tug Hill Operating Marshall County Meade District Latitude 39.77005962° Longitude -80.70545789° Middle Fish Creek Watershed

Pertinent Site Information Knob Creek 1 Site Emergency Number: 304-845-1920 Meade District, Marshall County, WV Watershed: Middle Fish Creek Watershed Tug Hill Contact Number: 1-817-632-3400

Table with 10 columns: Owner, Acreage, etc. for Knob Creek 1 Site.

Exhibit A: As-Built



WV State Plane Coordinate System Zone 18N, NAD 83











811 Know what's below. Call before you dig.

Tag Hill Operating will obtain an Erosion/Sediment Permit (Form MS-100) from the WV Department of Transportation, Division of Highways...

Approach Route: From the intersection of WV Rt 2 and Co Rt 17 (12th Street) in Meadsville, WV...

Table with 3 columns: Station, Latitude (NAD 83), Longitude (NAD 83) for Site Locations.

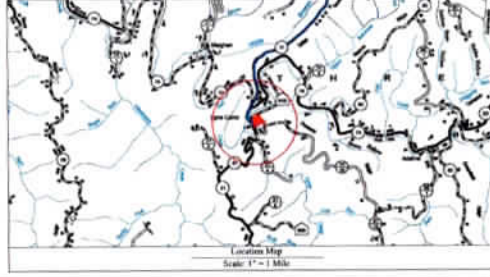

Well Location Restrictions: 40' Pad construction compliance with the following restrictions...

Professional Engineer Seal for Gregory C. Swannick, State of West Virginia, License No. 22714.

RECEIVED Office of Oil and Gas NOV 15 2023 WV Department of Environmental Protection

Table with 2 columns: Sheet, Description for project deliverables.

Vertical text on the right edge: TUG HILL OPERATING, Knob Creek 1 Site, Meade District, Marshall County, WV.

