



---

west virginia department of environmental protection

---

Office of Oil and Gas  
601 57<sup>th</sup> Street, S.E.  
Charleston, WV 25304  
(304) 926-0450  
fax: (304) 926-0452

Harold D. Ward, Cabinet Secretary  
[www.dep.wv.gov](http://www.dep.wv.gov)

Monday, April 1, 2024  
PERMIT MODIFICATION APPROVAL  
Horizontal 6A / New Drill

EQT PRODUCTION COMPANY  
400 WOODCLIFF DR.

CANONSBURG, PA 15317

Re: Permit Modification Approval for HUDSON S-9HM  
47-051-02380-00-00

**Adding an AST to the pad**

EQT PRODUCTION COMPANY

The Office of Oil and Gas has reviewed the attached permit modification for the above referenced permit. The attached modification has been approved and well work may begin. Please be reminded that the oil and gas inspector is to be notified twenty-four (24) hours before permitted well work is commenced.

If there are any questions, please feel free to contact me at (304) 926- 0450.

A handwritten signature in blue ink, appearing to read "James A. Martin", is written over a faint, larger version of the signature.

James A. Martin  
Chief

Operator's Well Number: HUDSON S-9HM  
Farm Name: 6922  
U.S. WELL NUMBER: 47-051-02380-00-00  
Horizontal 6A New Drill  
Date Modification Issued: 4/1/2024

Promoting a healthy environment.

04/05/2024




FEB 27 2024

WV Department of  
Environmental Protection

Hudson Well Site  
Tug Hill Operating  
Exhibit A: As-Built

APPROVED  
WVDEP OOG  
MODIFICATION  
4/1/2024

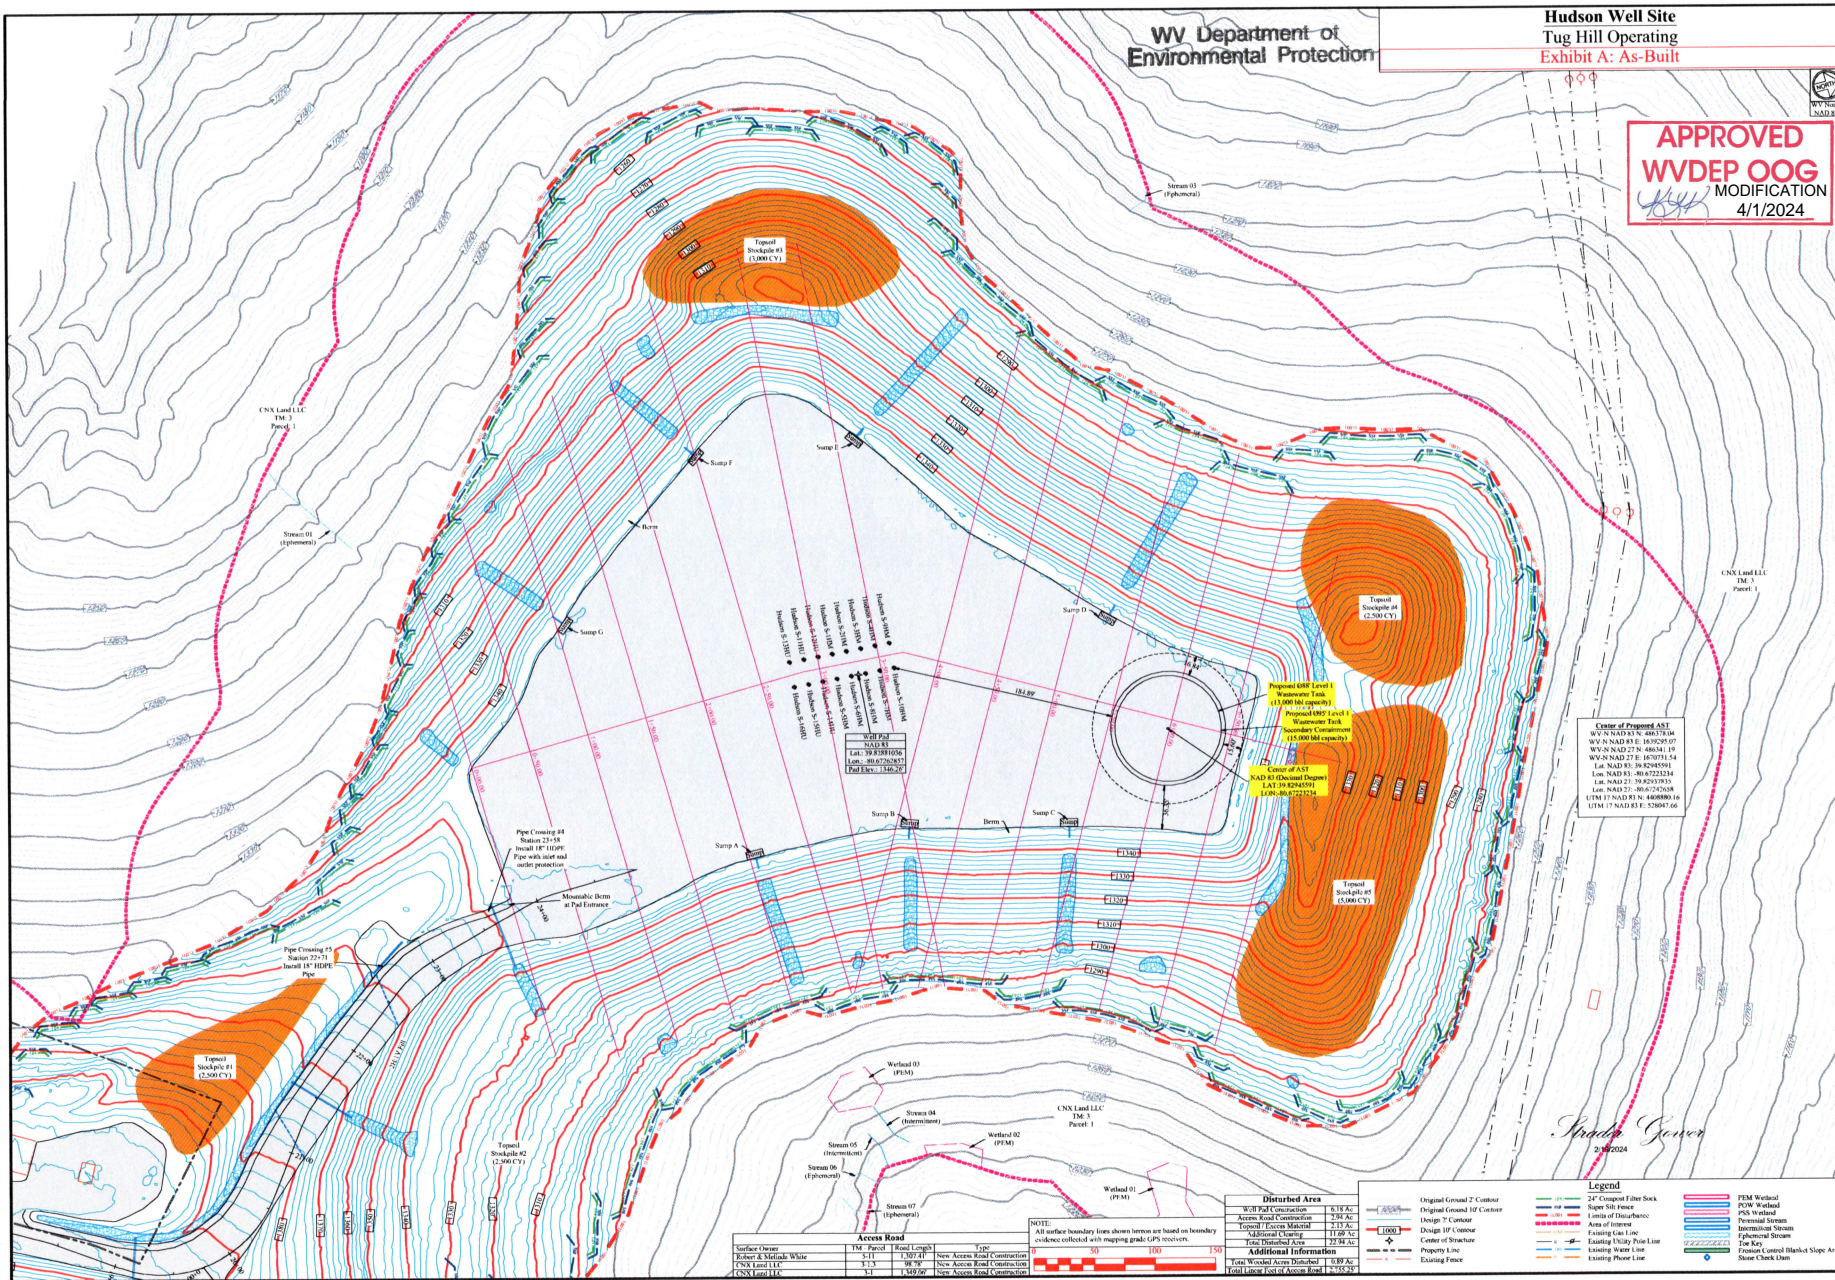

SECTION: AS-Built - Proposed ASST Location

DATE: 02/26/2024

**TUG HILL OPERATING**

THIS DOCUMENT PREPARED FOR TUG HILL OPERATING

**K-Surveying**

Site Plan  
Hudson Well Site  
Menafe District  
Marshall County, WV

DATE: 03/04/2021  
SCALE: AS SHOWN  
DESIGNED BY: ZS  
FILE NO.  
SHEET 7 OF 11