

Latitude: 40°00'00"

SURFACE HOLE 10,214'

Latitude: 40°05'00"

BOTTOM HOLE 6,229'

JACKSON SURVEYING INC.




2413 EAST PIKE ST. # 112
Clarksburg, WV 26302
304-623-5851

SURFACE HOLE LOCATION (SHL):
UTM (NAD83, ZONE 17, METERS): NORTHING: 4,427,015.781 EASTING: 528,901.161
LANDING POINT (LPL):
UTM (NAD83, ZONE 17, METERS): NORTHING: 4,426,969.990 EASTING: 528,663.252
BOTTOM HOLE LOCATION (BHL):
UTM (NAD83, ZONE 17, METERS): NORTHING: 4,433,148.759 EASTING: 526,530.831



LINE	BEARING	DISTANCE	DESCRIPTION	MONUMENT
L1	N 19°08'31" W	1,046.78'	SHL TO LANDMARK	FD. FENCE CORNER
L2	N 59°32'52" W	1,277.69'	SHL TO LANDMARK	FD. FENCE CORNER
LINE	BEARING	DISTANCE	CURVE LENGTH	DESCRIPTION
L3	S 80°18'08" W	791.26'	1,588.64'	SHL TO LP

GRID NORTH
UTM, NAD83 DATUM, ZONE 17, US FT

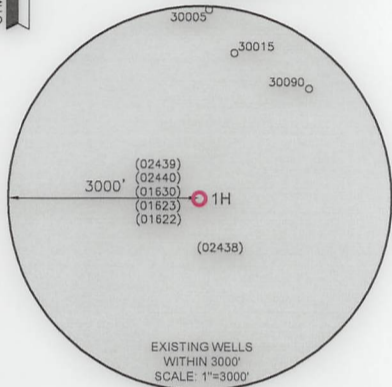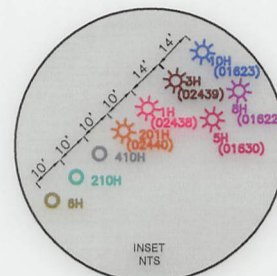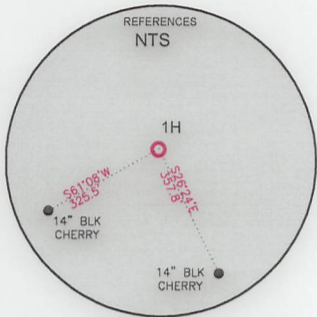

SURFACE HOLE LOCATION (SHL):
UTM (NAD83, ZONE 17, METERS): NORTHING: 4,427,015.707 EASTING: 528,901.097
LANDING POINT (LPL):
UTM (NAD83, ZONE 17, METERS): NORTHING: 4,426,975.081 EASTING: 528,663.368
BOTTOM HOLE LOCATION (BHL):
UTM (NAD83, ZONE 17, METERS): NORTHING: 4,433,152.734 EASTING: 526,534.552



WELL RESTRICTIONS

1. NO OCCUPIED DWELLINGS > 2500 SQ FT. WITHIN 625 FEET OF CENTER OF PAD.
2. NO AGRICULTURE BUILDINGS > 2500 SQ FT. WITHIN 625 FEET OF CENTER OF PAD.
3. NO WATER WELLS OR DEVELOPED SPRINGS ARE WITHIN 250 FEET OF PROPOSED WELL.
4. NO PERENNIAL STREAMS, LAKES, PONDS, OR RESERVOIRS WITHIN 100 FEET OF THE LIMITS OF DISTURBANCE.
5. NO NATURALLY PRODUCING TROUT STREAM WITHIN 300 FEET OF LIMITS OF DISTURBANCE.
6. NO GROUND INTAKE OR PUBLIC WATER SUPPLY WITHIN 1000 FEET OF WELL PAD, LIMITS OF DISTURBANCE, E & S CONTROLS OR PUBLIC WATER SUPPLY.


NOTES ON SURVEY

1. SURFACE AND ROYALTY OWNER INFORMATION AND THEIR BOUNDARIES SHOWN HEREON WERE PLOTTED FROM DEEDS AND/OR TAX PARCEL MAPS PROVIDED BY CLIENT AND/OR FIELD LOCATIONS.
2. THIS PLAT DOES NOT REPRESENT A BOUNDARY SURVEY OF THE PARCELS SHOWN HEREON.
4. ALL INSETS ARE GRID NORTH UNLESS OTHERWISE DEPICTED.

I, THE UNDERSIGNED, HEREBY CERTIFY THAT THIS PLAT IS CORRECT TO THE BEST OF MY KNOWLEDGE AND BELIEF AND SHOWS ALL THE INFORMATION REQUIRED BY LAW AND REGULATIONS ISSUED AND PRESCRIBED BY THE DEPARTMENT OF ENVIRONMENTAL PROTECTION.

P.S. 708

David L Jackson

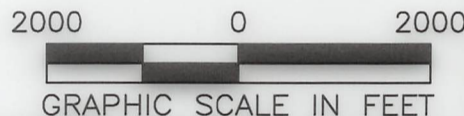

COMPANY: **SWN** Production Company, LLC



(+) DENOTES LOCATION OF WELL ON UNITED STATES TOPOGRAPHIC MAPS
WVDEP
OFFICE OF OIL & GAS
601 57TH STREET
CHARLESTON, WV 25034

MINIMUM DEGREE OF ACCURACY: 1/200
PROVEN SURVEY SOURCE OF GRADE GPS ELEVATION: (NAVD 88, US FT)

DAVID REINBEAU MSH
OPERATOR'S WELL #: 1H
API WELL #: 47 STATE 051 COUNTY 02438 PERMIT

WELL TYPE: OIL WASTE DISPOSAL PRODUCTION DEEP GAS LIQUID INJECTION STORAGE SHALLOW

WATERSHED: HOLLIDAYS RUN OF WHEELING CREEK (HUC-10) ELEVATION: 1,250.8'

DISTRICT: UNION COUNTY: MARSHALL QUADRANGLE: MOUNDSVILLE, WV

SURFACE OWNER: SHELLY A. & DAVID W. REINBEAU ACREAGE: ±50.88

OIL & GAS ROYALTY OWNER: SHELLY A. & DAVID W. REINBEAU ACREAGE: ±50.88

DRILL DRILL DEEPER REDRILL FRACTURE OR STIMULATE PLUG OFF OLD FORMATION PERFORATE NEW FORMATION

CONVERT PLUG & ABANDON CLEAN OUT & REPLUG OTHER CHANGE (SPECIFY) ASDRILLED 03/31/2023


TARGET FORMATION: MARCELLUS ESTIMATED DEPTH: 6,369 TVD 28,298 TMD

WELL OPERATOR: SWN PRODUCTION COMPANY, LLC ADDRESS: 1300 FORT PIERPONT ROAD, SUITE 200 CITY: MORGANTOWN STATE: WV ZIP CODE: 26508

DESIGNATED AGENT: BRITTANY WOODY ADDRESS: 1300 FORT PIERPONT ROAD, SUITE 200 CITY: MORGANTOWN STATE: WV ZIP CODE: 26508

LEGEND:	<ul style="list-style-type: none"> ○ PROPOSED SURFACE HOLE / BOTTOM HOLE ★ EXISTING / PRODUCING WELLHEAD LPL★ LANDING POINT LOCATION ⊙ EXISTING WATER WELL ⊙ EXISTING SPRING — SURVEYED BOUNDARY — DRILLING UNIT — LEASE BOUNDARY — ASDRILLED PATH — PROPOSED PATH 	REVISIONS: DATE: 09-28-2022 DRAWN BY: N. MANO SCALE: 1" = 2000' DRAWING NO: WELL LOCATION PLAT
----------------	--	--

JACKSON SURVEYING
 INC.
 2413 EAST PIKE ST. # 112
 Clarksburg, WV 26302
 304-623-5851

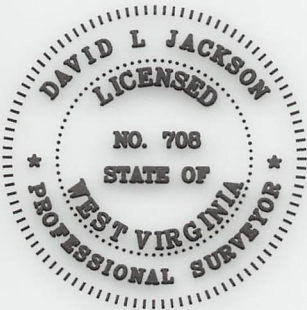

I, THE UNDERSIGNED, HEREBY CERTIFY THAT THIS PLAT IS CORRECT TO THE BEST OF MY KNOWLEDGE AND BELIEF AND SHOWS ALL THE INFORMATION REQUIRED BY LAW AND REGULATIONS ISSUED AND PRESCRIBED BY THE DEPARTMENT OF ENVIRONMENTAL PROTECTION.

P.S. 708 *David L Jackson*



03/31/2023

REVISIONS:	COMPANY:			
	OPERATOR'S	DAVID REINBEAU MSH	API #:	DATE: 09-28-2022
	WELL #:	1H	47-051-02438	DRAWN BY: N. MANO
	DISTRICT:	UNION	COUNTY:	SCALE: N/A
			STATE:	DRAWING NO:
			WV	WELL LOCATION PLAT 2

JACKSON SURVEYING
 INC.
 2413 EAST PIKE ST. # 112
 Clarksburg, WV 26302
 304-623-5851

WELL BORE TRACTS		
TRACT	SURFACE OWNER (S) / ROYALTY OWNER (R)	TAX PARCEL
1	REINBEAU SHELLY A & DAVID W (S/R)	13-8-29
TRACT	SURFACE OWNER (S)	TAX PARCEL
2	REINBEAU SHELLY A & DAVID W (S)	13-8-27
3	BOWMAN MICHAEL ET UX (S)	13-8-28
4	ALEXANDER LORRAINE (S)	13-7-20
5	ALEXANDER LORRAINE (S)	13-7-18.1
6	WARD CYNTHIA J & DALE P (S)	13-4-23.6
7	COULLING LOUISE S ET AL (S)	13-3-3
8	WALTON EARL RICHARD JR & BRANDICE C (S)	13-4-22.21
9	WALTON EARL RICHARD JR & BRANDICE C (S)	13-4-22.20
10	BRINKMEIER BRUCE & TAMARA (S)	13-4-22.14
11	HOFFMASTER KEVIN & CRYSTAL (S)	13-4-22.27
12	HILL CAROL LYNN & FORDYCE BRIAN W (S)	13-4-22.8
13	MANNING JOHN B & KIMBERLY R (S)	13-4-22.13
14	GAMES FRED & MARY V (S)	13-4-22.17
15	MCGUIRE PHILIP C (S)	13-4-21.4
16	MCGUIRE PHILIP C (S)	13-4-21.9
17	GARVIN CORRINE A EST (S)	13-2-101
18	GARVIN CORRINE A EST (S)	13-2-100
19	GARVIN CORRINE A EST (S)	13-2-98
20	GARVIN DOROTHY MAE EST (S)	13-2-81
21	BOWSER MARY ANNE (S)	13-2-76
22	GARVIN CORRINE A EST (S)	13-2-68
23	GARVIN CORRINE A EST (S)	13-2-38
24	POLLACK RICHARD J ET UX (S)	13-2-38.1
25	ROGERSON GEORGE C EST (S)	13-2-39
26	SEIDLER E DALE JR (S)	13-2-14.9
27	SEIDLER PATRICIA L IRREVOCABLE TRUST (S)	13-2-14.7
28	SHIVELY JOYCE (S)	13-2-14.6
29	WOLEN JOHN & MICHELLE (S)	13-2-102.3
30	FLANIGAN JAMES JR & MELISSA S (S)	p/o 13-2-102
31	BANE RYAN A & JULIE A (S)	13-2-102.2
32	RAHBAR AHMAD CREDIT SHELTER TRUST (S)	13-2-102
33	ANDREWS JANET M TRUSTEE (S)	1-RB2-32
34	SCHMIDT THOMAS (S)	1-RB2-28
35	GARVIN D CRAIG & EYDIE M (S)	1-RB2M-54.2
36	GARVIN DALE C & EYDIE (S)	1-RB2M-54.1
37	GARVIN D CRAIG & EYDIE M (S)	1-RB2M-27.1
38	CHERRY MICHAEL D (S)	1-RB2M-2
39	MANNING ASHLEY A ELDER CHARLOTTE A (S)	1-RB2M-3
40	CONRAD JOSHUA D & TRISHA J (S)	1-RB2-27.3
41	CONRAD JOSHUA D & TRISHA J (S)	1-RB2-24
42	SOMMERS BRUCE A & ANGELA R (S)	1-RB2G-58
43	HELMICK STEVEN S & BETSY J (S)	1-RB2G-55
44	WOODVIEW LLC (S)	1-RB2-14
45	WOODVIEW LLC (S)	1-RB2-14.2
46	WOODVIEW LLC (S)	1-RB2-14.1
47	VILLAGE OF BETHLEHEM (S)	1-RB2C-83
48	HAUGHT JONATHAN L & HAUGHT WILLIAM C (S)	1-RB2C-91
49	DONAHUE ANDREW J & POLA V (S)	1-RB2C-90
50	DONAHUE ANDREW J & POLA V (S)	1-RB2C-90.1
51	HAMRICK JUSTIN E & MCMURRAY KELLY L (S)	1-RB2C-89.1
52	HAMILTON KAREN S & HAMILTON JEFFREY D ESTATE (S)	1-RB2C-88
53	UZLIK SHAWN D (S)	1-RB2C-86
54	MIRANDY TIMOTHY D (S)	1-RB2C-98
55	WHITE DENISE L (S)	1-RB2C-97
56	SCHRIMP MARTHA A (S)	1-RB2C-96
57	TAYLOR JOSEPH WILLIAM (S)	1-RB2C-95
58	WHEELING PROPERTIES CO ADDI (S)	1-RB2-20

03/31/2023

REVISIONS:	COMPANY:		
			
	OPERATOR'S	DAVID REINBEAU MSH	API #:
	WELL #:	1H	47-051-02438
	DISTRICT:	COUNTY:	STATE:
	UNION	MARSHALL	WV
			DATE: 09-28-2022
			DRAWN BY: N. MANO
			SCALE: N/A
			DRAWING NO:
			WELL LOCATION PLAT 4



**JACKSON SURVEYING
INC.**

2413 EAST PIKE ST. # 112
Clarksburg, WV 26302
304-623-5851

ADJOINING OWNERS TABLE		
TRACT	SURFACE OWNER	TAX PARCEL
A	MCCOMBS JOHN A SR, THOMAS E & BETH	13-8-11
B	MCCOMBS JOHN A SR, THOMAS E & BETH	13-8-26
C	REINBEAU RONALD W & FRIEDA A - LIFE	13-7-22.2
D	MCCOMBS JOHN A SR & MARILYN S	13-7-22.1
E	REINBEAU DAVID W & SHELLEY A	13-7-22.3
F	REINBEAU DAVID W & SHELLEY A	13-7-21.1
G	BOWMAN MICHAEL J & CONSTANCE G	13-7-21
H	BOARD OF EDUCATION	13-7-17
I	BLANEY TIMOTHY O ET UX	13-4-24.5
J	WARD CYNTHIA J	13-4-23.16
K	SMITH JOANN H	13-4-23.2
L	DUNCAN ELMER E & SUSAN L	13-4-23.1
M	STAN TYLER P & CASEY K	13-4-23.5
N	OSER FREDERICK P & MALLORY A	13-4-23.10
O	OSER FREDERICK P & MALLORY A	13-4-23.15
P	BLANEY FARMS LLC	13-4-23
Q	WARD CYNTHIA J	13-4-23.14
R	BLANEY RODNEY A	13-4-23.13
S	SZELIGO RICHARD & ASHLEY	13-4-23.8
T	SZELIGO RICHARD L JR & ASHLEY E	13-4-23.11
U	ETZEL JAMIE P & ANTHONY EVICK II	13-4-23.12
V	ETZEL JAMIE P & ANTHONY EVICK II	13-4-23.7
W	FITZPATRICK BRYAN A & HEIDI A	13-4-23.4
X	WARD CYNTHIA J & DALE P	13-4-24
Y	ORLOFSKE SEAN A & JENNIFER L	13-4-22.11
Z	GAMES FREDERICK LOUIS II ET UX	13-4-22.10
A2	GARRISON ASHLEY	13-4-22.12
B2	FISHER DEBRA ANN GAMES & GALEN E	13-4-22.9
C2	WEST VALLIE JAMES ET AL	13-4-22
D2	FISHER GALEN E & DEBRA A	13-4-22.26
E2	FISHER DEBRA ANN GAMES & GALEN E	13-4-22.5
F2	FISHER DEBRA ANN GAMES & GALEN E	13-4-22.3
G2	GAMES MARY VIRGINIA - TOD	13-4-22.2
H2	GAMES MARY VIRGINIA - TOD	13-4-22.25
I2	WEST RICHARD D JR	13-4-22.24
J2	FISHER GALEN E & DEBRA A	13-4-21
K2	HILL CHARLES S ET UX	13-4-21.7
L2	WALTERS SAMANTHA J & RICHARDS JENNIFER L	13-4-21.1
M2	GARVIN CORRINE A EST	13-2-101.2
N2	GARVIN CORRINE A EST	13-2-101.1
O2	GARVIN CORRINE A EST	13-4-20
P2	GARVIN CORRINE A EST	13-2-70
Q2	GARVIN CORRINE A EST	13-2-99
R2	GARVIN CORRINE A EST	13-2-71
S2	MUSTACHIO EMILY A & GARVIN GRANT W	13-2-72
T2	GARVIN JOHN A & KAREN L	13-2-73
U2	GARVIN JOHN ARTHUR & KAREN L	13-2-74
V2	GARVIN JOHN ARTHUR & KAREN L	13-2-75
W2	GARVIN CORRINE A EST	13-2-69
X2	ST MYERS MICHAEL W	13-2-67
Y2	MEGALE GARNET JANE & VICKIE WALTERS	13-2-66.1
Z2	WALTERS VICKIE	13-2-65
A3	GREEN JAMES L	13-2-64
B3	WALTERS THOMAS C & KATRINA A	13-2-41.7
C3	TUCKER NATHAN JOSEPH & LINDSEY RENEE	13-2-42.5
D3	COOLEY CHARLES E & CAROL J	13-2-42
E3	RICHTER FAMILY TRUST	13-2-42.17
F3	BLATT JAMES E ET UX	13-2-42.7
G3	MAGERS GARY E ET UX	13-2-2.2
H3	SHIVELY JOYCE	13-2-14.1
I3	SHIVELY JOYCE	13-2-14.5
J3	BRADCOVICH JOSEPH EARL EST	13-2-14.4
K3	NUGENT LINDA S ET AL	13-2-14.8
L3	SEIDLER NETTIE	13-2-14
M3	SEIDLER E DALE JR ET UX	13-2-14.3
N3	SEIDLER TIMOTHY I ET UX	13-2-14.2
O3	COFFIELD RONALD J	13-2-39.5
P3	COFFIELD RONALD J	13-2-39.3

ADJOINING OWNERS TABLE		
TRACT	SURFACE OWNER	TAX PARCEL
Q3	SCARBRO JENNI M	13-2-39.2
R3	ROGERSON WAYNE R	13-2-39.1
S3	ROGERSON WAYNE R	13-2-39.4
T3	PYSH WAYNE ET UX	13-2-13.6
U3	PYSH WAYNE ET UX	13-2-13.8
V3	PASCOLI KENT A	13-2-13
W3	TURNER JASON & TIFFANY	13-2-102.1
X3	BRAUNLICH EARL FRITZ & JAMIE LYNN	13-2-104
Y3	WEISNER RANDY P	1-RB2-33.3
Z3	PINTER EUGENE M & JOAN	1-RB2-33.2
A4	PRASCIK LORI JEAN	1-RB2Q-33
B4	MULARCIK BRYAN & TIFFANY	1-RB2Q-32
C4	SHREVES HOLLIE L	1-RB2Q-31.1
D4	KNORR WILLIAM JOHN & KNORR ELIZABETH VIRGINIA	1-RB2L-81.1
E4	NEIMAN CHARLES AND MARK	1-RB2L-81
F4	ANDREWS JEREMY	1-RB2-32.1
G4	PAULEY SCOTT F & ECHEMANN CHRISTINA	1-RB2L-74
H4	YOHO PATRICK A	1-RB2L-73
I4	BECK SANDRA M	1-RB2L-72
J4	TROUTEN JENNA MICHELLE	1-RB2L-71
K4	STINGLE KEVIN W; GRAY FLORA L (RT TO OCC)	1-RB2L-70
L4	WEST VIRGINIA HOUSING DEV FUND	1-RB2L-69
M4	METZ BARBARA JANE	1-RB2L-69.1
N4	METZ BARBARA J	1-RB2L-68
O4	LLOYD JENNIFER L & DAVID A	1-RB2L-67
P4	VILLAGE OF BETHLEHEM	1-RB2L-66
Q4	SCHNUPP JAMES P & M A	1-RB2L-88
R4	PICKETT VALERIE & GARY B	1-RB2L-64
S4	MARTIN KIMBERLEE GEORGETTE	1-RB2L-62
T4	ARMSTRONG SHELLEE JEAN	1-RB2L-57
U4	SCHMIDT THOMAS L & L E	1-RB2L-55
V4	CLEGG L	1-RB2L-54
W4	TOWNSEND CARL A	1-RB2L-50
X4	SNYDER CHRISTINE LEE	1-RB2L-50.1
Y4	GARVIN DALE C & E	1-RB2L-49.1
Z4	GARVIN DALE CRAIG & EYDIE	1-RB2L-49.3
A5	CHERRY MICHAEL D	1-RB2M-1
B5	CKJ RENTALS	1-RB2L-49.2
C5	HUTCHISON N R & J (LIFE EST) CHURCH BETH H	1-RB2L-47.1
D5	HUTCHISON N R & J (LIFE EST) CHURCH BETH H	1-RB2L-47
E5	HOWORTH HELENA A	1-RB2L-46
F5	SCOTT STEPHEN A & LINDSEY A	1-RB2L-45
G5	PAULUS ANDREW T & S A YAHN	1-RB2L-45.2
H5	BLAZIER HOWARD T JR & S L	1-RB2L-45.1
I5	CLEGG AUBREI L	1-RB2L-112
J5	GARY MARK C & P S	1-RB2L-37
K5	BLAZIER BRIAN T	1-RB2G-78
L5	MURAD CHRIS R & TRACY	1-RB2G-77
M5	DESANTIS JAMES P & JANE V & DESANTIS MICHAEL V	1-RB2G-76
N5	VILLAGE OF BETHLEHEM	1-RB2G-75
O5	KONDRAD SCOTT F & DEVYN S	1-RB2G-74
P5	CUNNINGHAM WAYNE D & G K	1-RB2G-73
Q5	BLACK SUSAN O	1-RB2G-67
R5	FLETCHER TIM L SR	1-RB2G-66
S5	BLACK SHAUN M	1-RB2G-65
T5	BLACK SHAUN M	1-RB2G-64
U5	CCM PROPERTIES LLC	1-RB2G-63
V5	JASKO AARON M	1-RB2G-62
W5	HEUSEL LOUISE V & MATTHEW R	1-RB2G-61
X5	ALBERT JANE LEW	1-RB2G-60
Y5	WEISNER GARY	1-RB2G-59
Z5	MAZESKA CASSANDRA	1-RB2G-54
A6	CZYZEWSKI STELLA J (LIFE) WEISNER GARY A	1-RB2G-53
B6	WILBURN BRANDON M & WILBURN SHELLEY J	1-RB2G-52
C6	MARVIN JACK E	1-RB2G-51
D6	GUSSLER TROY R & SUSANNA E	1-RB2G-82
E6	WEISNER GEORGE A & JEAN - TOD	1-RB2G-46
F6	BECKETT G R & B L (LC-SLRS)	1-RB2G-35.1
G6	BETHLEHEM REALTY INC	1-RB2C-67.1
H6	GRACE EVANGELICAL TRUSTEES C/O SPENCE TIMOTHY	1-RB2C-67

03/31/2023

REVISIONS:	COMPANY:		
			
	OPERATOR'S	DAVID REINBEAU MSH	API #:
	WELL #:	1H	47-051-02438
	DISTRICT:	UNION	STATE:
		COUNTY:	WV
		MARSHALL	DATE: 09-28-2022
			DRAWN BY: N. MANO
			SCALE: N/A
			DRAWING NO:
			WELL LOCATION PLAT 5



**JACKSON SURVEYING
INC.**

2413 EAST PIKE ST. # 112
Clarksburg, WV 26302
304-623-5851

ADJOINING OWNERS TABLE		
TRACT	SURFACE OWNER	TAX PARCEL
I6	GOMPERS THOMAS L	1-RB2C-82
J6	ANDREWS BRETT A & CHRISTINE A	1-RB2C-85.2
K6	MEREDITH CHARLES R & P L	1-RB2C-85
L6	KIRBY CHARLES R & ASHLEY M	1-RB2C-84.1
M6	ROSEMEIER WILLIAM M JR	1-RB2C-80.3
N6	JANISZEWSKI CECELIA, STANLEY M JANISZEWSKI SP; JANISZEWSKI SA	1-RB2C-79
O6	BOARD OF EDUCATION	1-RB2C-94
P6	BETHLEHEM UNITED PRESBYTERIAN CHURCH TRUSTEES	1-RB2C-36
Q6	PRESBYTERY OF WHEELING (SYNOD OF WV)	1-RB1Q-36
R6	SCHEHL MICHAEL A & CHRISTINA L	1-RB1Q-39
S6	DIERINGER OLIVE JANE	1-RB1-17
T6	BANDI MARY DEE	1-RB1Q-107
U6	SASEEN MARK S & ALLISON M	1-RB1-18.1
V6	WHITE JONATHAN W & HEATHER	1-RB1-18
W6	WEESE JEFFREY	1-RB1Q-125
X6	RAPP DAVID A & TAMMY L	1-RB1Q-127
Y6	WHEELING PROPERTIES	10-W80-1
Z6	CITY OF WHEELING	10-W80-1.3
A7	CITY OF WHEELING	10-W80-1.1
B7	WILSON B E & S K	10-W80-1.4
C7	SWIGER JUSTIN A & STEPHANIE M	1-RB3-14
D7	MORRIS JAY R & TINA M	1-RB3-13
E7	RAMSEY BRYAN S & MICHELE A	1-RB3-7
F7	BAYHA DEBORAH S	1-RB3-6
G7	RAMOS SCOTT B & RAMOS AMY D	1-RB3-5
H7	BAKER MARK J & DAYNA M	1-RB3-4.1
I7	WARMAN JAMES J & CARRIE REDD	1-RB3-4
J7	WARMAN JAMES J & CARRIE REDD	1-RB3-3
K7	CORNELL CHARLES D & LINDA J	1-RB2J-152
L7	POLSINELLI FRANK & POLSINELLI KIMBERLY A - TOD	1-RB2J-151
M7	BREIDING DORENE	1-RB2J-149
N7	CHAMBERLAIN DONALD	1-RB2-20.4
O7	TURNER GEORGE E JR & PAULETTE	1-RB2J-134
P7	SITKO PAUL M JR & EDWINA	1-RB2J-133
Q7	KOWALSKI CHESTER J TAMA A	1-RB2J-132
R7	HUMPHRIES ELI THOMAS & BREANNA NICOLE	1-RB2J-131
S7	BAUERLE RALPH & VICKI L	1-RB2J-20.8
T7	GHAPHERY BRIAN A; GHAPHERY CHRISTINA W	1-RB2J-20.5
U7	NERNBERG A RICHARD TRUST 1/2 INT & NERNBERG SUSAN L 1/2 INT	1-RB2J-146
V7	VILLAGE OF BETHLEHEM	1-RB2-17.4
W7	JOSEPH MICHAEL A & V J	1-RB2D-35
X7	BLEIFUS LEO A JR	1-RB2-18.1
Y7	WHEELING PROPERTIES CO ADDI	1-RB2-18
Z7	TAYLOR JOSEPH WILLIAM	1-RB2-19
A8	TAYLOR JOSEPH WILLIAM	1-RB1-20
B8	BLEIFUS LEO	1-RB2C-109
C8	BLEIFUS LEO A JR	1-RB2C-108.1
D8	SULEK DONALD L & L	1-RB2C-107
E8	KLOSS ROBERT A & DONNA J	1-RB2C-101
F8	CUCHTA BEAU	1-RB2C-100
G8	ROGERS STEPHEN J	1-RB2C-99
H8	HAMRICK JUSTIN E & MCMURRAY KELLY L	1-RB2C-89
I8	MITEVSKI-MUSAP VERA	1-RB2C-102
J8	KLUSKEY ROBERT & BRENDA	1-RB2C-91.1
K8	KLENOWSKI P M & HAIGH J L; KLENOWSKI P E & J L - RTOCC	1-RB2C-92
L8	BONAR BRADLEY C	1-RB2C-142
M8	GREEN FORREST M	1-RB2C-143
N8	BREIDING BARBARA; BREIDING D W WALKER K L; BREIDING K M	1-RB2C-143.1
O8	HALLER MICHELLE M	1-RB2C-143.2
P8	DLESK ROSALIE J	1-RB2-21.6
Q8	DLESK ROSALIE J	1-RB2-21.5
R8	PANDELOS ERNEST M	1-RB2-21
S8	RCC PROPERTIES	1-RB2G-79
T8	PARSONS RONALD E & D M - TOD	1-RB2G-79.1
U8	PARSONS RONALD E & D M - TOD	1-RB2G-80
V8	MUSILLI A A JR & C A	1-RB2G-81
W8	GOLD JONATHAN M & C J	1-RB2G-56
X8	PAVLIC CHRISTOPHER S	1-RB2G-57
Y8	CONRAD JOSHUA D & TRISHA J	1-RB2-34.1
Z8	DLESK ROSALIE J	1-RB2-34.4

ADJOINING OWNERS TABLE		
TRACT	SURFACE OWNER	TAX PARCEL
A9	GALE JAMES ASSET MGMT LLC	1-RB2-24.1
B9	STRAUB JOSEPH H EST MARGARET STRAUB	1-RB2-31
C9	LONDON HELEN M	1-RB2M-12
D9	CUSTER WAYNE H	1-RB2M-11
E9	WARDLE HARVEY A & JANET C	1-RB2M-10
F9	WERNER ANTHONY I & JODY M	1-RB2M-9
G9	HABAK JOHN M & R S	1-RB2M-7
H9	THORN LOGAN & ALEXANDRA	1-RB2M-6
I9	TRABERT PAMELA S	1-RB2M-5
J9	ORR NANCY J - TOD	1-RB2M-4
K9	WESOLOWSKI JEFFREY J & KACEY L	1-RB2M-20
L9	AUTEN THOMAS HARRISON JR	1-RB2M-22
M9	NEWMAN BILLIE SUE	1-RB2M-24
O9	MATHIEU JENNIFER L	1-RB2M-24.1
P9	RICHTER ELWOOD F JR & CHRISTINE A	1-RB2M-54.3
Q9	RICHTER ELWOOD F JR & C A	1-RB2M-56.1
R9	RICHTER ELWOOD F JR	1-RB2M-56
S9	ASBURY RYAN & ANNE	1-RB2-31.5
T9	POTTS JOHN W & ROSE A	1-RB2-31.2
U9	BRAUNLICH EARL FRITZ & JAMIE LYNN	13-2-102.4
V9	RENFORTH GEORGE III	13-2-16.2
W9	PERONI CONSTRUCTION INC	10-W95-112
X9	LONG RICHARD E ET UX	13-2-35
Y9	LAUTER FRANK ET AL	13-2-36
Z9	LONG RICHARD E ET UX	13-2-37
A10	LONG RICHARD E ET UX	13-2-32
B10	WALKER MICHAEL A	13-2-31
C10	BURKE RICHARD & FITZPATRICK DEBRA	13-2-31.1
D10	BURKE RICHARD & FITZPATRICK DEBRA	13-2-31.2
E10	MILLER GEORGE W ET AL	13-2-79
F10	GARVIN JOHN A & KAREN L	13-2-78
G10	ROMINE WANDA KAY (S)	13-2-77
H10	RANSOM DAVID W & DONNA K	13-2-80
I10	GARVIN JOHN	13-2-81.2
J10	MERCER RICK	13-2-81.1
K10	GARVIN LEILA N & DONALD A	13-2-96
L10	GARVIN CORRIE A EST	13-2-97
M10	DAY JOHN U EST & CHRISTINE MERCER	13-2-95
N10	YOUNGER DONALD A & MOORE TERESA R	13-2-94
O10	WIEDEBUSCH ROBERT & CINDY	13-2-93.1
P10	WIEDEBUSCH ROBERT & CINDY	13-2-91
Q10	GAUGHAN MICHAEL WM	13-2-90.1
R10	GAUGHAN MICHAEL WILLIAM ET UX	13-2-90
S10	ABEL JAMES R & SHERI L	13-2-89
T10	ISER RONALD J ET UX	13-2-88
U10	WHITE HORSE FARM LLC	13-3-2
V10	COULLING LOUISE S ET AL	13-3-5.3
W10	COULLING LOUISE S	13-3-5
X10	BONACCI BRIAN F	13-3-5.1
Y10	OHIO COUNTY COAL RESOURCES INC	13-3-3.1
Z10	GEHO STANLEY R & BETH B	13-4-22.16
A11	GAMES FRED & MARY V	13-4-22.18
B11	GAMES FRED & MARY V	13-4-22.19
C11	WALTON EARL RICHARD JR & BRANDICE C	13-4-22.23
D11	BRINKMEIER BRUCE & TAMARA	13-4-22.15
E11	WALTON EARL RICHARD JR & BRANDICE C	13-4-22.22
F11	ALEXANDER LORRAINE	13-7-18
G11	SAMPSON EDITH VIRGINIA EST	13-7-19
H11	NARRISH KEVIN	13-8-30
I11	SOUTH CHRISTOPHER C	13-8-31
J11	KOSTELECKY JOSEPH J JR & CAROLYN - TOD	13-8-31.1
K11	FUNK CHARLES D ET UX	13-8-32
L11	LOY EUGENE EST ET AL	13-8-1
M11	LIBERTY JOHN ET UX	13-8-10

03/31/2023

REVISIONS:	COMPANY:	 	
	OPERATOR'S	DAVID REINBEAU MSH	API #:
	WELL #:	1H	47-051-02438
	DISTRICT:	UNION	STATE:
		COUNTY:	WV
			DATE: 09-28-2022
			DRAWN BY: N. MANO
			SCALE: N/A
			DRAWING NO:
			WELL LOCATION PLAT 6