

WW-7  
8-30-06



West Virginia Department of Environmental Protection  
Office of Oil and Gas

**WELL LOCATION FORM: GPS**

API: 47-051-70483 WELL NO.: M-1674

FARM NAME: FRANK CHAMBERS

RESPONSIBLE PARTY NAME: WEST VIRGINIA LAND RESOURCES INC.

COUNTY: MARSHALL DISTRICT: LIBERTY

QUADRANGLE: CAMERON WV, PA

SURFACE OWNER: JOHN D. CUMPSTON

ROYALTY OWNER: \_\_\_\_\_

UTM GPS NORTHING: 4,405,934 m (1174')

UTM GPS EASTING: 539,643 m GPS ELEVATION: 358 m

The Responsible Party named above has chosen to submit GPS coordinates in lieu of preparing a new well location plat for a plugging permit or assigned API number on the above well. The Office of Oil and Gas will not accept GPS coordinates that do not meet the following requirements:

- Datum: NAD 1983, Zone: 17 North, Coordinate Units: meters, Altitude: height above mean sea level (MSL) – meters.
- Accuracy to Datum – 3.05 meters
- Data Collection Method:

Survey grade GPS  : Post Processed Differential \_\_\_\_\_

Real-Time Differential

Mapping Grade GPS \_\_\_\_\_ : Post Processed Differential \_\_\_\_\_

Real-Time Differential \_\_\_\_\_

- Letter size copy of the topography map showing the well location.**

I the undersigned, hereby certify this data is correct to the best of my knowledge and belief and shows all the information required by law and the regulations issued and prescribed by the Office of Oil and Gas.

Signature

Professional Surveyor

Title

OCTOBER 1, 2022

Date


RECEIVED  
Office of Oil and Gas

OCT 13 2022

WV Department of  
Environmental Protection

12/16/2022

4705102475f

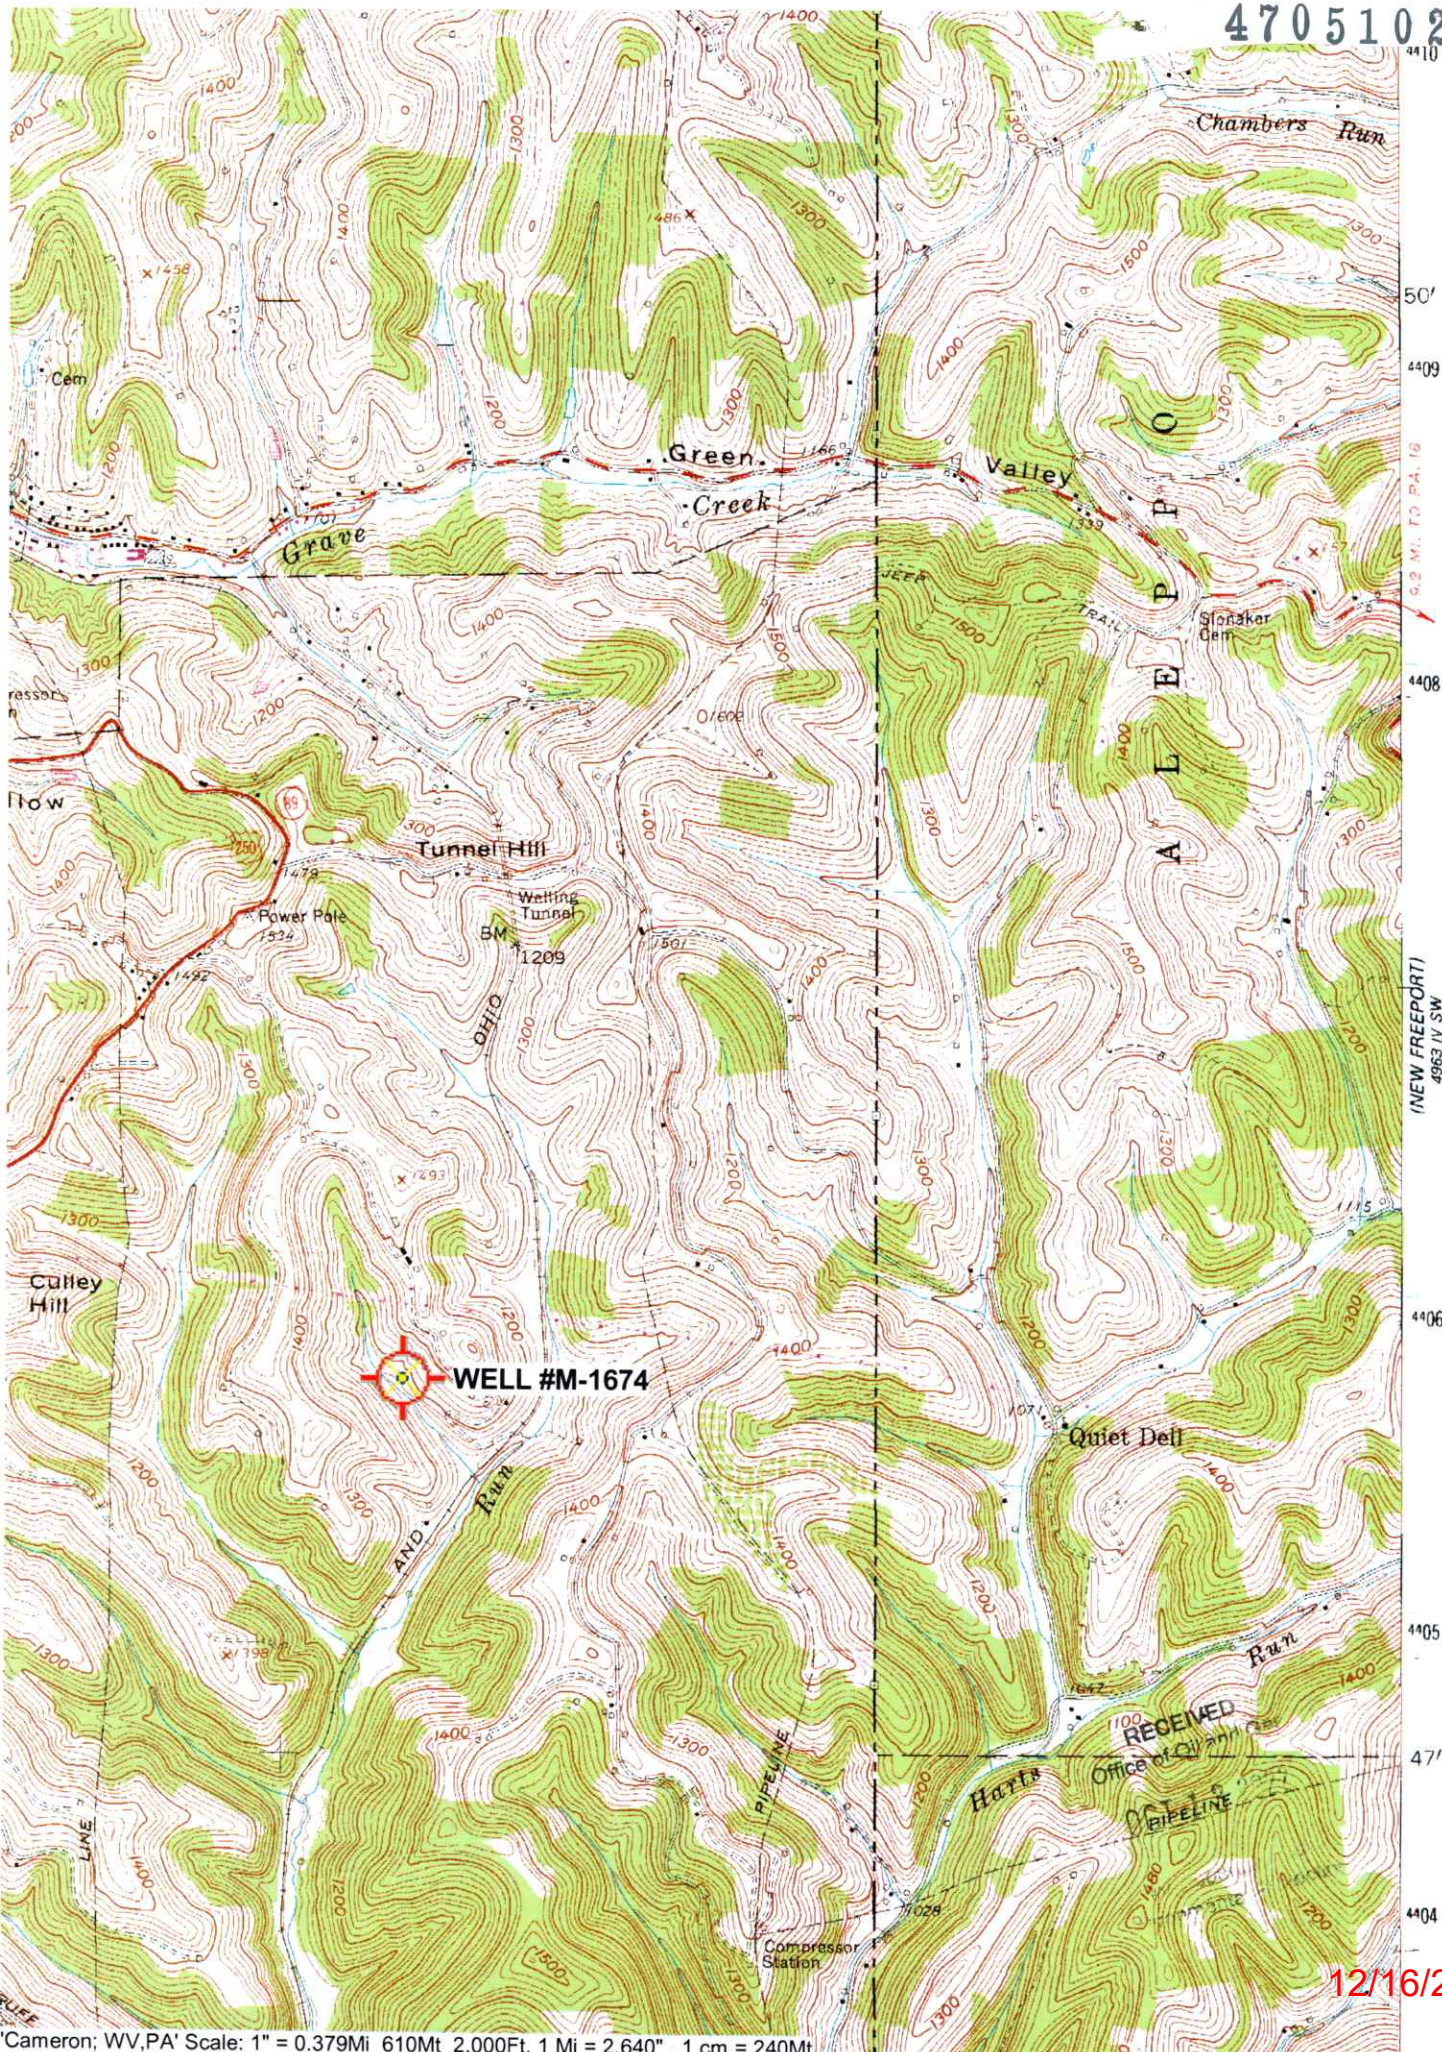

4410  
50'  
4409  
4408  
4406  
4405  
4404

9.2 Mi. TO PA. 18

(NEW FREEPORT)  
4963 IV SW

**WELL #M-1674**

RECEIVED  
Office of Oil and Gas

12/16/2022