





Diversified Gas & Oil Corporation
100 Diversified Way
Pikeville KY, 41051

47-061-01562

Well Plugging Map

Legend

- Well
- Access Road
- ▨ Pits
- ▭ Pad
- Public Roads

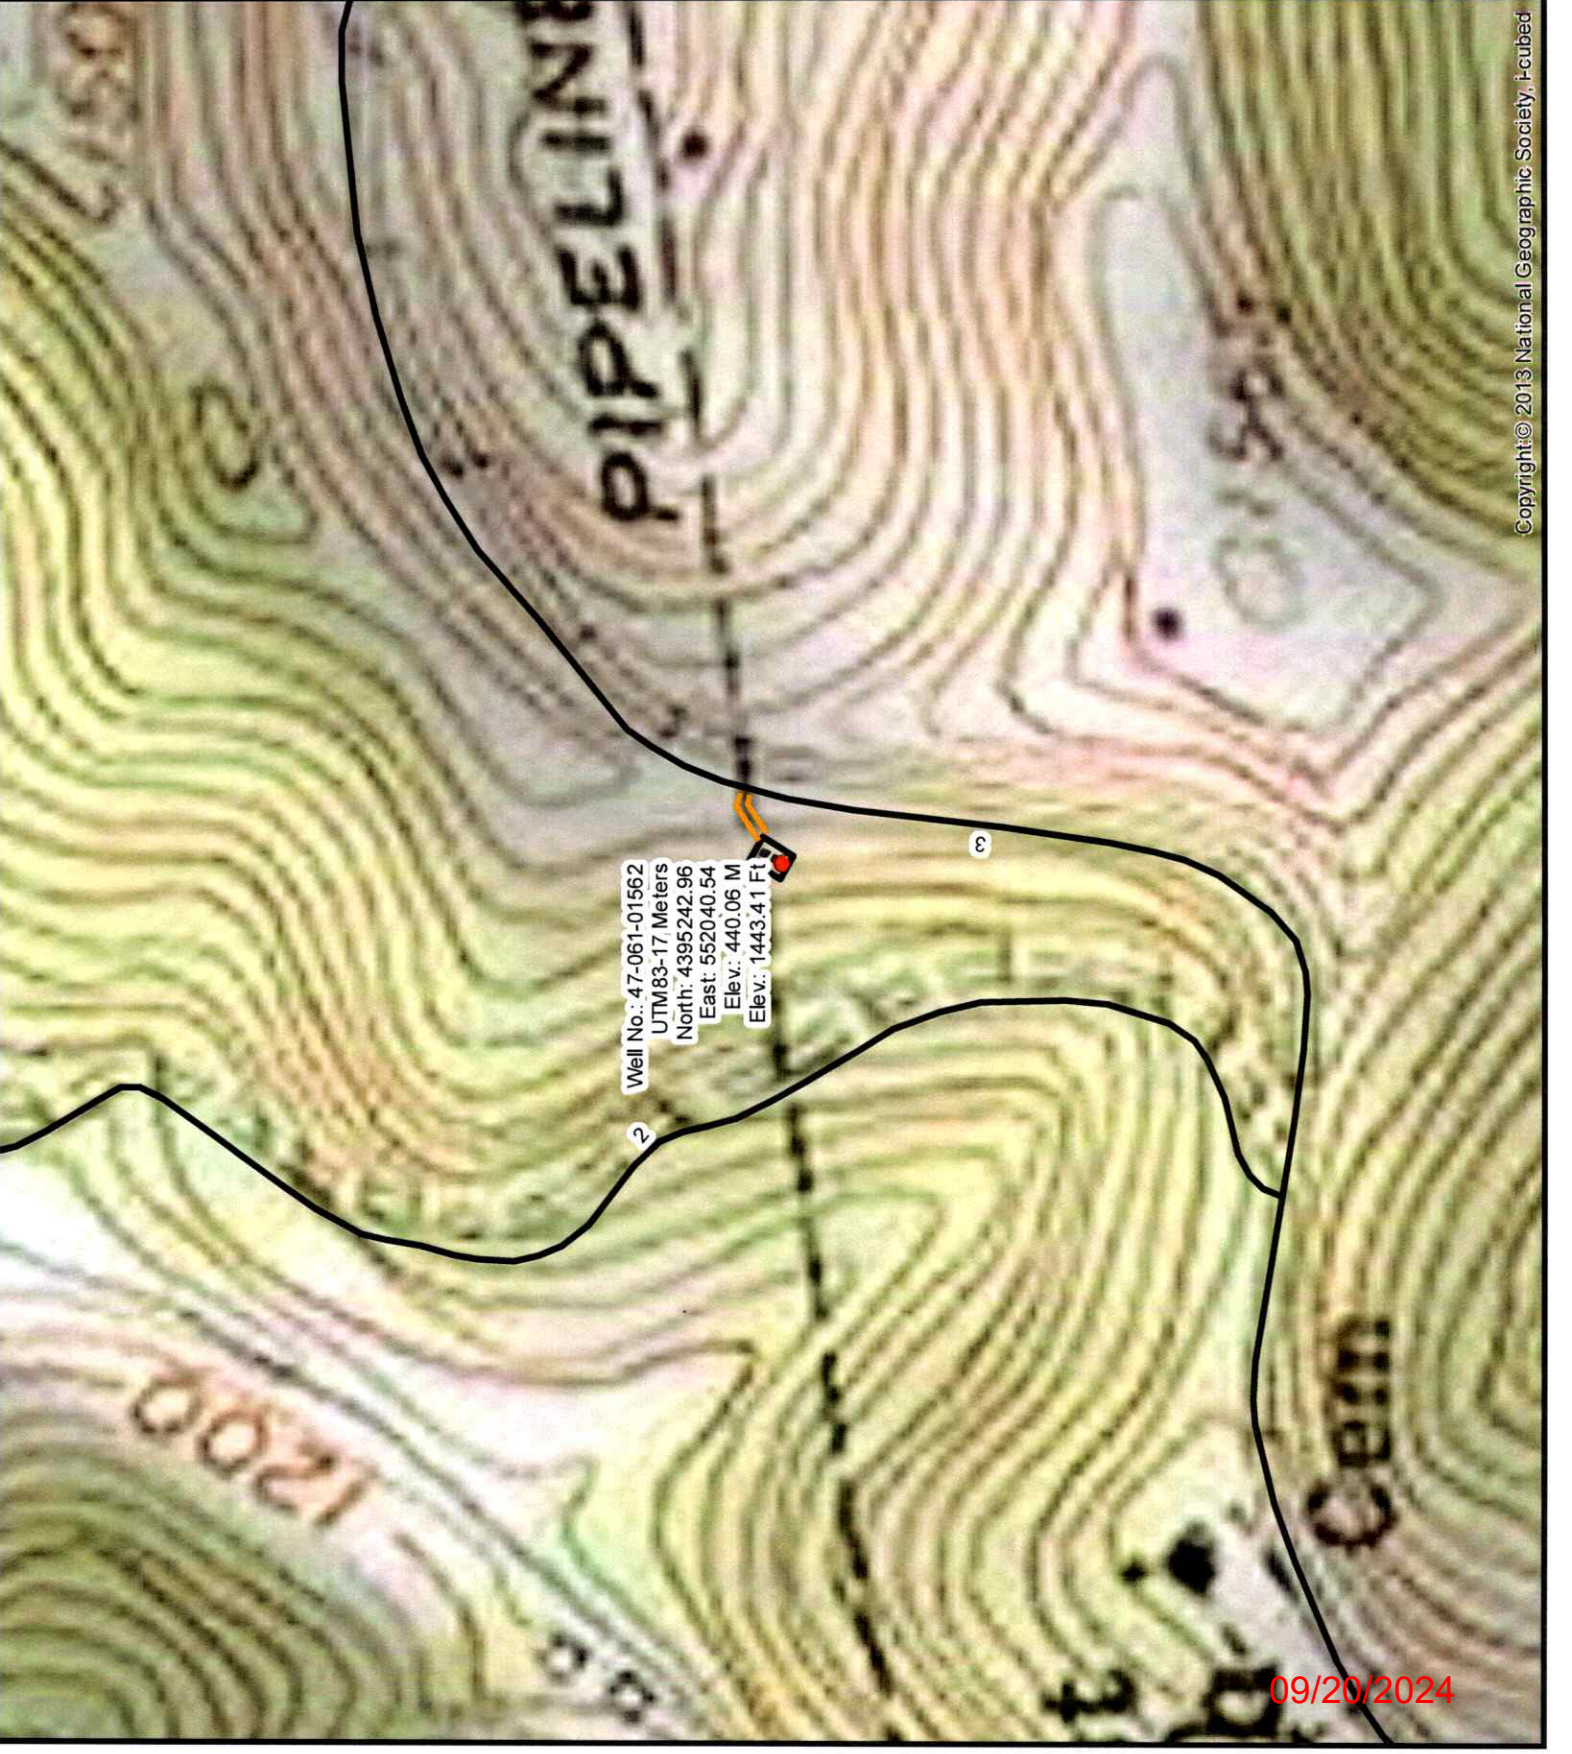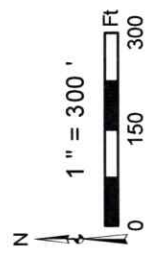

Well No.: 47-061-01562
UTM83-17, Meters
North: 4395242.96
East: 552040.54
Elev.: 440.06 M
Elev.: 1443.41 Ft

Copyright © 2013 National Geographic Society, i-cubed

09/20/2024




Diversified Gas & Oil
Corporation
100 Diversified Way
Pikeville KY, 41051

47-061-01562

Well Plugging Map

Legend

- Well
- Access Road
- Pits
- Pad
- Public Roads

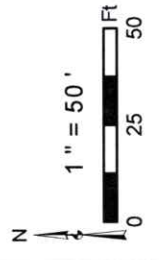

Source: Esri, Maxar, Earthstar Geographics, and the GIS User Community

09/20/2024

WW-7
8-30-06



West Virginia Department of Environmental Protection
Office of Oil and Gas
WELL LOCATION FORM: GPS

API: 4706101562 WELL NO.: SC11A

FARM NAME: David & Gail Henderson

RESPONSIBLE PARTY NAME: Diversified Production, LLC

COUNTY: Monongalia DISTRICT: Batelle

QUADRANGLE: Hundred 7.5'

SURFACE OWNER: David & Gail Henderson

ROYALTY OWNER: See Attached

UTM GPS NORTHING: 4395242.96

UTM GPS EASTING: 552040.54 GPS ELEVATION: 1443.41'

The Responsible Party named above has chosen to submit GPS coordinates in lieu of preparing a new well location plat for a plugging permit or assigned API number on the above well. The Office of Oil and Gas will not accept GPS coordinates that do not meet the following requirements:

- Datum: NAD 1983, Zone: 17 North, Coordinate Units: meters, Altitude: height above mean sea level (MSL) – meters.
- Accuracy to Datum – 3.05 meters
- Data Collection Method:
Survey grade GPS ____ : Post Processed Differential ____

Real-Time Differential ____

Mapping Grade GPS X : Post Processed Differential X


Real-Time Differential ____

- Letter size copy of the topography map showing the well location.**

I the undersigned, hereby certify this data is correct to the best of my knowledge and belief and shows all the information required by law and the regulations issued and prescribed by the Office of Oil and Gas.


Signature

Chris Veazey - Director of Administration
Title

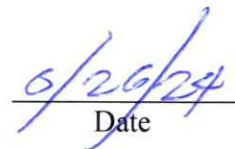
Date

RECEIVED
Office of Oil and Gas
JUL 08 2024
WV Department of
Environmental Protection

09/20/2024