

OWNER	PARCEL ID	ACRES	LEASE NUMBER
A PENNSYLVANIA LINES LLC	2-1-59	0.500	61-002927-001
B PENNSYLVANIA LINES LLC	2-1-58.1	0.080	61-002927-001
C PETER J. & TRISTA HOOSIER	2-1-58	0.200	61-002927-001
D KENNETH W. DEAN	2-1-42	0.300	61-002927-001
E JOHN C. SR. & JOHN C. JR. YANCE	2-1-43	0.220	61-002927-001
F JOHN C. SR. & JOHN C. JR. YANCE	2-1-40	0.220	61-002927-001
G JOHN C. SR. & JOHN C. JR. YANCE	2-1-39.1	0.220	61-002927-001
H JOHN C. SR. & JOHN C. JR. YANCE	2-1-39	0.220	61-002927-001
I WV DEPARTMENT OF HIGHWAYS	2-1-39.2	0.110	61-002927-001
J JOHN C. SR. & JOHN C. JR. YANCE	2-1-38	0.220	61-002927-002
K ALLEN & GLADYS WADE	2-1-44	0.220	61-002927-002
L SOUNDVIEW HOME LOAN TRUST	2-1-37.1	0.110	61-002927-002

WELL (LANDING POINT) COASTAL 3H WV-N (NAD 83)
N: 439995.1
E: 1769817.6
UTM (NAD 83)
N: 4395413.7
E: 568049.2


WELL (LANDING POINT) COASTAL 3H WV-N (NAD 83)
N: 439799.7
E: 1769957.9
UTM (NAD 83)
N: 4395354.9
E: 568092.9

WELL (SURFACE) COASTAL 3H WV-N (NAD 83)
N: 439897.7
E: 1770312.1
UTM (NAD 83)
N: 4395386.6
E: 568200.3

WELL (SURFACE) COASTAL 3H WV-N (NAD 83)
N: 439897.5
E: 1770312.5
UTM (NAD 83)
N: 4395386.5
E: 568200.5

FILE #: NNE12
DRAWING #: 2319
SCALE: PLAT: 1" = 1200'
TICK: 1" = 2000'
MINIMUM DEGREE OF ACCURACY: 1/200
PROVEN SOURCE OF ELEVATION: SUBMETER MAPPING GRADE GPS

I, THE UNDERSIGNED, HEREBY CERTIFY THAT THIS PLAT IS CORRECT TO THE BEST OF MY KNOWLEDGE AND BELIEF AND SHOWS ALL THE INFORMATION REQUIRED BY LAW AND THE REGULATIONS ISSUED AND PRESCRIBED BY THE DEPARTMENT OF ENVIRONMENTAL PROTECTION.
Signed: [Signature]
L.L.S. #2124 : Ernest J. Benchek III

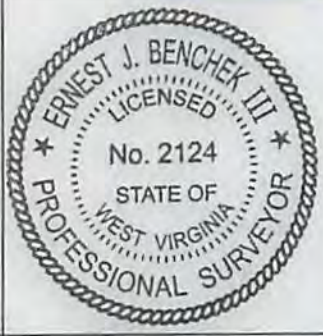

(+) DENOTES LOCATION OF WELL ON UNITED STATES TOPOGRAPHIC MAPS
WVDEP
OFFICE OF OIL & GAS
601 57TH STREET
CHARLESTON, WV 25304
Well Type: Oil Waste Diposal Production Deep
 Gas Liquid Injection Storage Shallow
WATERSHED: DUNKARD CREEK ELEVATION: 1,420'
COUNTY/DISTRICT: MONONGALIA / CLAY QUADRANGLE: BLACKSVILLE
SURFACE OWNER: COASTAL FOREST RESOURCES COMPANY ACREAGE: 63.8 +/- 10/30/2015
OIL & GAS ROYALTY OWNER: WACO OIL AND GAS, ET AL ACREAGE: 295.152 +/-
LEASE NUMBERS: _____
DRILL CONVERT DRILL DEEPER REDRILL FRACTURE OR STIMULATE
PLUG OFF FORMATION PERFORATE NEW FORMATION PLUG & ABANDON
CLEAN OUT & REPLUG OTHER CHANGE (SPECIFY): _____
TARGET FORMATION: MARCELLUS ESTIMATED DEPTH: TVD: 8,203.32' TMD: 15,665'
WELL OPERATOR: NORTHEAST NATURAL ENERGY LLC DESIGNATED AGENT: JOHN ADAMS
ADDRESS: 707 VIRGINIA STREET EAST, SUITE 1200 ADDRESS: 707 VIRGINIA STREET EAST, SUITE 1200
CITY: CHARLESTON STATE: WV ZIP CODE: 25301 CITY: CHARLESTON STATE: WV ZIP CODE: 25301