




# NORTHEAST NATURAL ENERGY, LLC

Location: Monongalia County, WV  
 Field: Monongalia  
 Facility: Cummins Pad

Slot: Slot #18  
 Well: Cummins 18H  
 Wellbore: Cummins 18H PWB

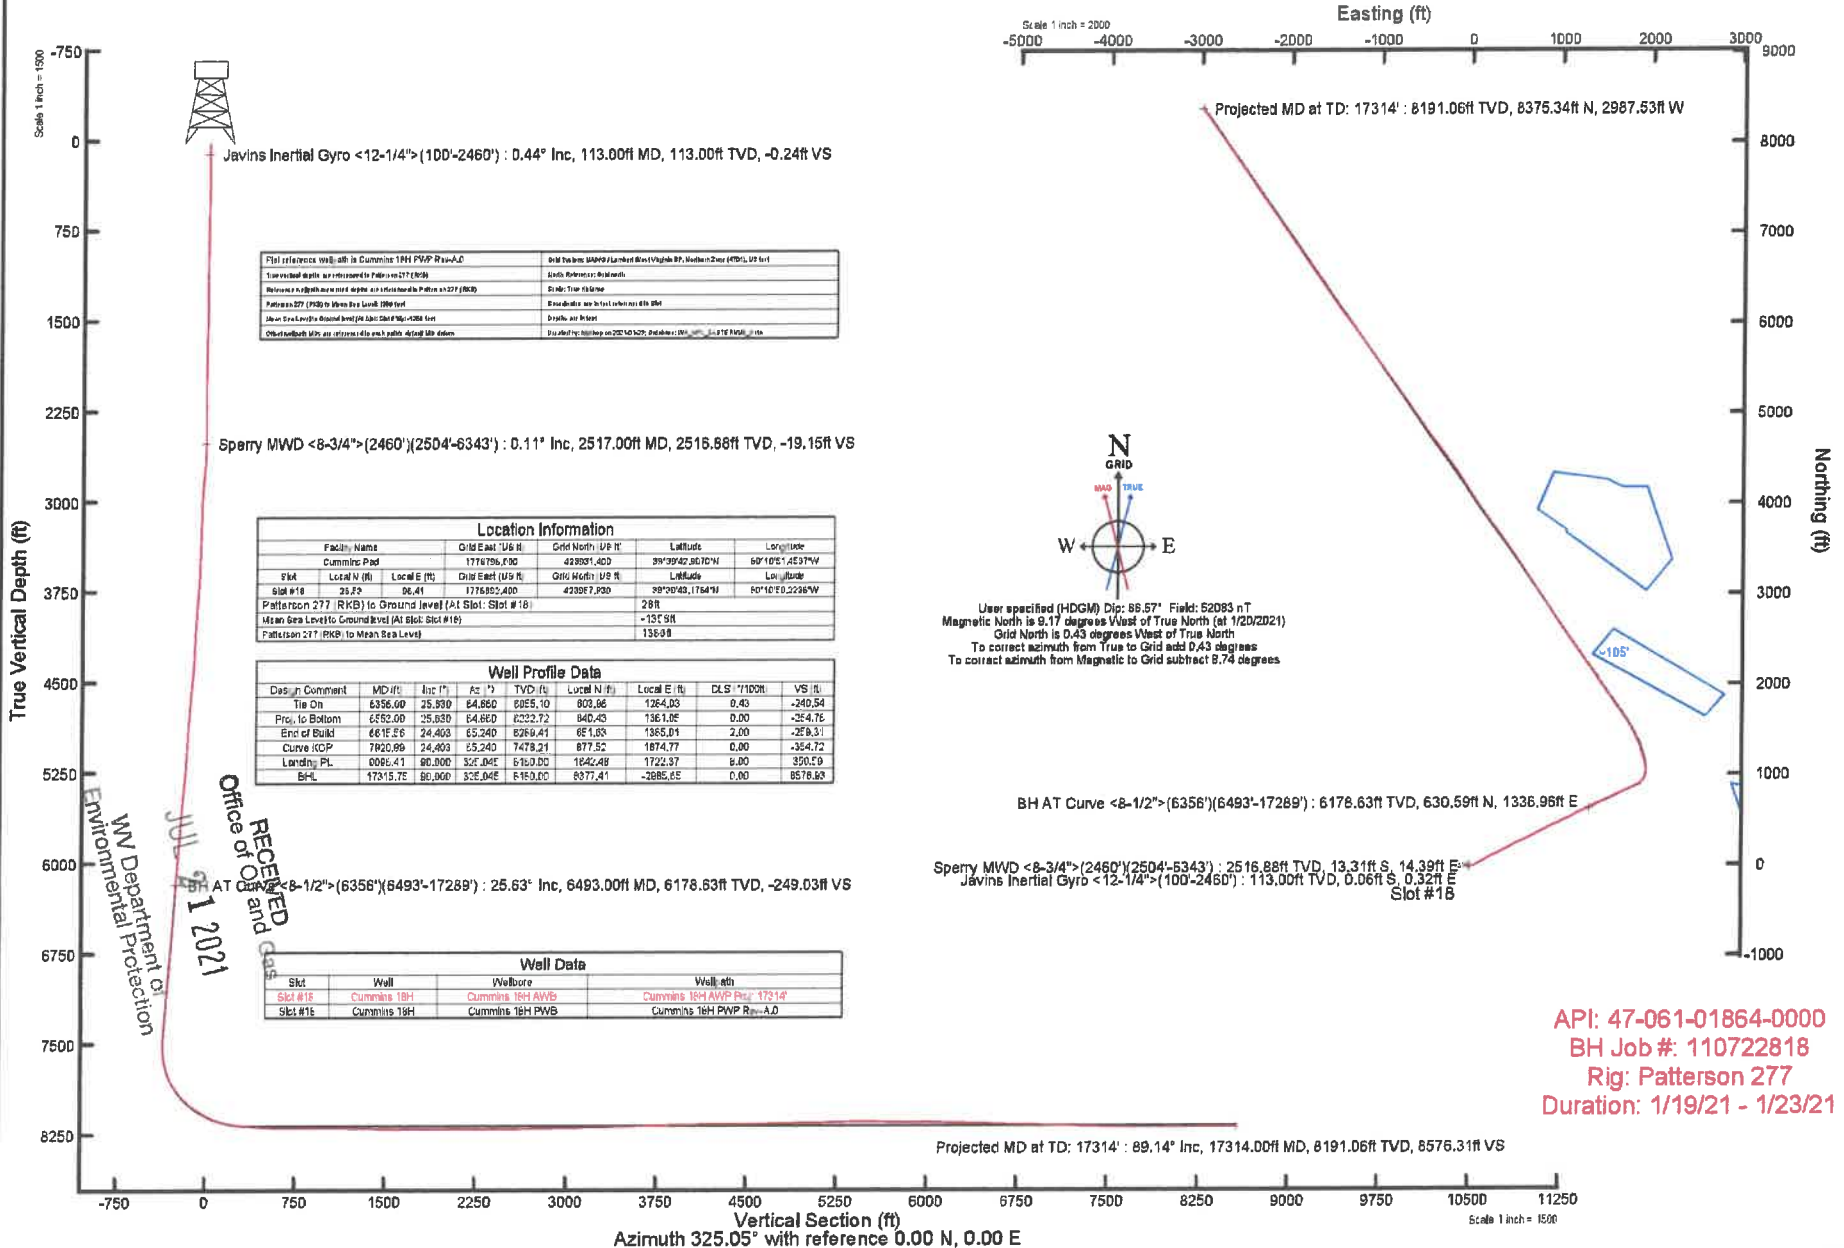

API: 47-061-01864-0000  
 BH Job #: 110722818  
 Rig: Patterson 277  
 Duration: 1/19/21 - 1/23/21