


LATITUDE 39° 42' 30" TH: 7,020'

LONGITUDE 80° 20' 00" TH: 6,285'

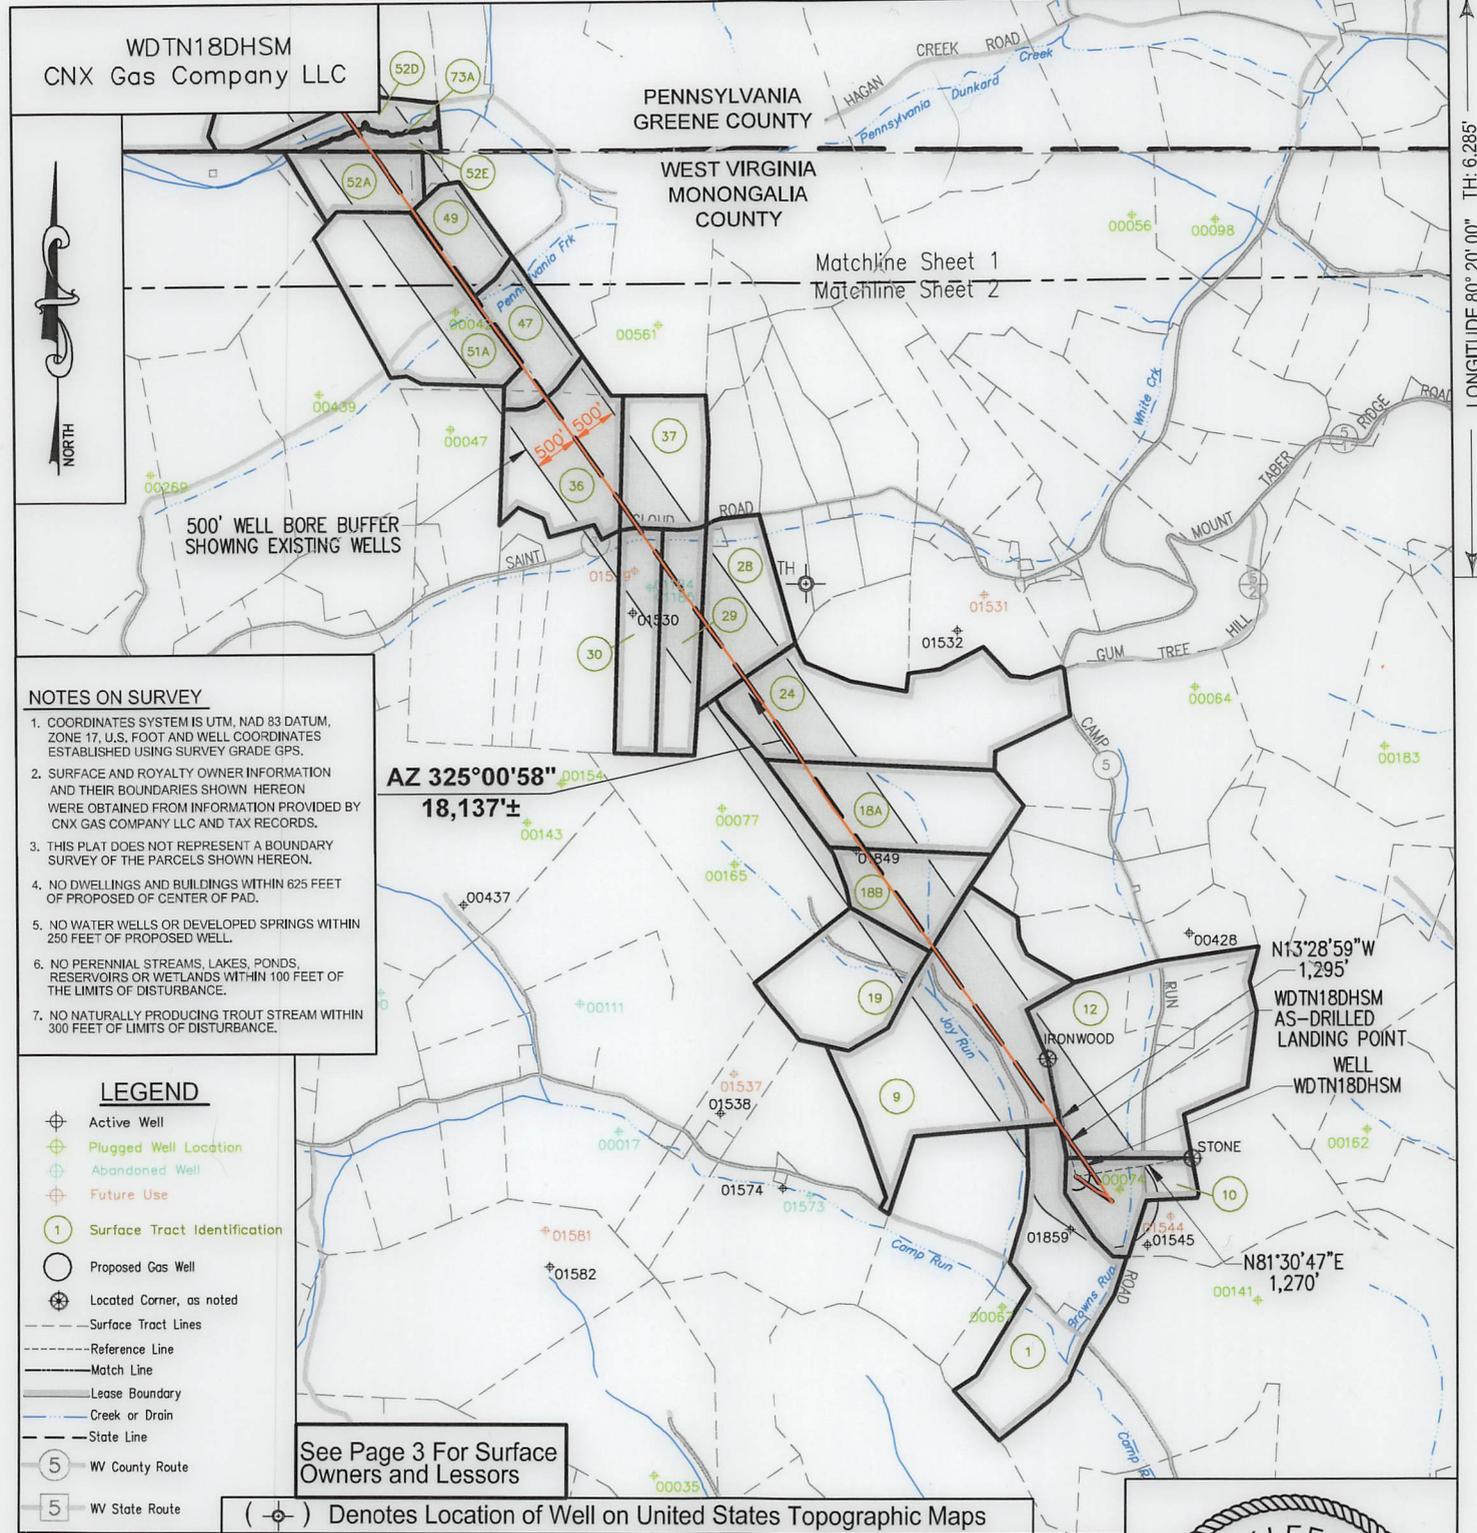

I, the undersigned, hereby certify that this plat is correct to the best of my knowledge and belief and shows all the information required by law and the regulations issued and prescribed by the Department of Environmental Protection.

L. L. S. 687
L. L. S. 687



FILE NO: _____
DRAWING NO: _____
SCALE: 1" = 2000'
MINIMUM DEGREE OF ACCURACY: 1:2500
PROVEN SOURCE OF ELEVATION: NGS CORS Station

STATE OF WEST VIRGINIA
DEPARTMENT OF ENVIRONMENTAL PROTECTION
OIL AND GAS DIVISION

DATE: OCTOBER 17 20 24
OPERATORS WELL NO: _____
API WELL NO: 47 - 061 - 01947
STATE COUNTY PERMIT

WELL TYPE: OIL GAS LIQUID INJECTION WASTE DISPOSAL
(IF GAS) PRODUCTION: STORAGE DEEP SHALLOW
LOCATION ELEVATION: 1199' WATERSHED: Dunkard Creek QUADRANGLE: Wadestown
DISTRICT: Battelle COUNTY: Monongalia
SURFACE OWNER: Consol Mining Company LLC ACREAGE: 46.75 ±
ROYALTY OWNER: Bounty Minerals, LLC LEASE NO: 189033000 ACREAGE: 59.02 ±
PROPOSED WORK: DRILL CONVERT DRILL DEEPER FRACTURE OR STIMULATE PLUG OFF OLD FORMATION
 PERFORATE NEW FORMATION OTHER PHYSICAL CHANGE IN WELL (SPECIFY)
 PLUG AND ABANDON CLEAN OUT AND REPLUG TARGET FORMATION: Marcellus ESTIMATED DEPTH: TVD: 7,848'

WELL OPERATOR: CNX Gas Company LLC DESIGNATED AGENT: Anthony Kendziora
ADDRESS: 1000 Horizon Vue Drive ADDRESS: 111 Avondale Road
Canonsburg, PA 15317 Fairmont, WV 26554

AS-DRILLED

LATITUDE 39° 45' 00" BH: 5.905'

LONGITUDE 80° 22' 30" BH: 6.335'

WDTN18DHSM
CNX Gas Company LLC



WDTN18DHSM
AS-DRILLED
BOTTOM HOLE

NOTES ON SURVEY

1. COORDINATES SYSTEM IS UTM, NAD 83 DATUM, ZONE 17, U.S. FOOT AND WELL COORDINATES ESTABLISHED USING SURVEY GRADE GPS.
2. SURFACE AND ROYALTY OWNER INFORMATION AND THEIR BOUNDARIES SHOWN HEREON WERE OBTAINED FROM INFORMATION PROVIDED BY CNX GAS COMPANY LLC AND TAX RECORDS.
3. THIS PLAT DOES NOT REPRESENT A BOUNDARY SURVEY OF THE PARCELS SHOWN HEREON.
4. NO DWELLINGS AND BUILDINGS WITHIN 625 FEET OF PROPOSED OF CENTER OF PAD.
5. NO WATER WELLS OR DEVELOPED SPRINGS WITHIN 250 FEET OF PROPOSED WELL.
6. NO PERENNIAL STREAMS, LAKES, PONDS, RESERVOIRS OR WETLANDS WITHIN 100 FEET OF THE LIMITS OF DISTURBANCE.
7. NO NATURALLY PRODUCING TROUT STREAM WITHIN 300 FEET OF LIMITS OF DISTURBANCE.

LEGEND

- Active Well
- Plugged Well Location
- Abandoned Well
- Future Use
- Surface Tract Identification
- Proposed Gas Well
- Located Corner, as noted
- Surface Tract Lines
- Reference Line
- Match Line
- Lease Boundary
- Creek or Drain
- State Line
- WV County Route
- WV State Route

See Page 3 For Surface Owners and Lessors

() Denotes Location of Well on United States Topographic Maps

500' WELL BORE BUFFER
SHOWING EXISTING WELLS

AZ 325°00'58"
18,137±

PENNSYLVANIA
GREENE COUNTY

WEST VIRGINIA
MONONGALIA
COUNTY

Matchline Sheet 1
Matchline Sheet 2



I, the undersigned, hereby certify that this plat is correct to the best of my knowledge and belief and shows all the information required by law and the regulations issued and prescribed by the Department of Environmental Protection.

L. L. S. 687
L. L. S. 687



FILE NO: _____
 DRAWING NO: _____
 SCALE: 1" = 2000'
 MINIMUM DEGREE OF ACCURACY: 1:2500
 PROVEN SOURCE OF ELEVATION: NGS CORS Station

STATE OF WEST VIRGINIA
 DEPARTMENT OF ENVIRONMENTAL PROTECTION
 OIL AND GAS DIVISION



DATE: OCTOBER 17 20 24
 OPERATORS WELL NO: _____
 API WELL NO
 47 - 061 - 01947
 STATE COUNTY PERMIT



WELL TYPE: OIL GAS LIQUID INJECTION WASTE DISPOSAL
 (IF GAS) PRODUCTION: STORAGE DEEP SHALLOW
 LOCATION ELEVATION: 1199' WATERSHED: Dunkard Creek QUADRANGLE: Wadestown
 DISTRICT: Battelle COUNTY: Monongalia
 SURFACE OWNER: Consol Mining Company LLC ACREAGE: 46.75 ±
 ROYALTY OWNER: Bounty Minerals, LLC LEASE NO: 189033000 ACREAGE: 59.02 ±
 PROPOSED WORK: DRILL CONVERT DRILL DEEPER FRACTURE OR STIMULATE PLUG OFF OLD FORMATION
 PERFORATE NEW FORMATION OTHER PHYSICAL CHANGE IN WELL (SPECIFY)
 PLUG AND ABANDON CLEAN OUT AND REPLUG TARGET FORMATION: Marcellus ESTIMATED DEPTH: TVD: 7,848'

WELL OPERATOR: CNX Gas Company LLC DESIGNATED AGENT: Anthony Kendziora
 ADDRESS: 1000 Horizon Vue Drive ADDRESS: 111 Avondale Road
 Canonsburg, PA 15317 Fairmont, WV 26554

03/14/2025

AS-DRILLED

TRACT ID	SURFACE OWNER	LESSOR	PIN		
1	Consol Mining Company LLC	Bounty Minerals, LLC	1-9-37		
		Bounty Minerals III Acquisitions, LLC	1-12-7		
		LOLA Drilling I, LLC			
		Rice Drilling B, LLC			
9	Consol Mining Company LLC	Paul Reeder, single and Doris L. Wenck, single	1-9-32		
		Consolidation Coal Company	1-9-33		
		CONSOL Mining Company LLC			
		CNX Resource Holdings LLC			
10	Consol Mining Company LLC	Eastern Associated Coal Corporation	1-9-37		
			1-9-38		
12	Consol Mining Company LLC, et al	Ralph Six	1-9-39		
			1-9-39.1		
			1-9-39.2		
			1-9-39.3		
			1-9-39.4		
			1-9-39.5		
			1-9-39.6		
		Antero Resources Corporation			
		Doris Margaret White			
		George Stephen Knight			
		18A	CNX RCPC LLC	Donna R. Hennen	1-9-20
				WOG Leasing, LLC	
		Milan W. Cikovich, Jr. and Susan K. Cikovich, husband and wife			
		EQT Production Company			
		Don Fordyce			
		Betty Short			
		Milan W. Cikovich, Jr. and Christine Michelle Park, individually and trustee of the Amended and Restated Milan W. Cikovich Testamentary Trust F/B/O Francine R. Cikovich			
		Melissa Ann Hennen Umbaugh			
		Linda S. Sansone			
		Mildred Louise Walton			
		Judy Kay Marshall, f/k/a Judy Kay Howard			
		Mary Virginia Davis			
		Karen S. Gray			
		Helene M. Muetzel			
		James R. Hennen, Jr.			
		Cecil Hennen			
		Roger L. Pratt			
		Nelson James Hennen, Jr.			
		Clark H. Hennen			
		Delores Ann Hennen Bryant			
		Francis J. Waldron Hennen			
		Ronald Fordyce			
		James Cox			
		Joseph Muto			
		Robert Morgan and Vickie Morgan			
		Terra Firma Company			
		CNX Land LLC			

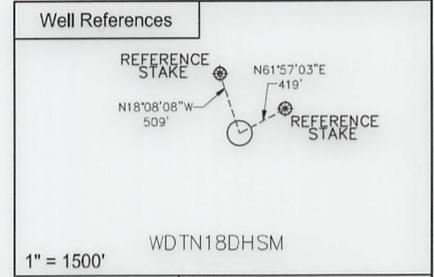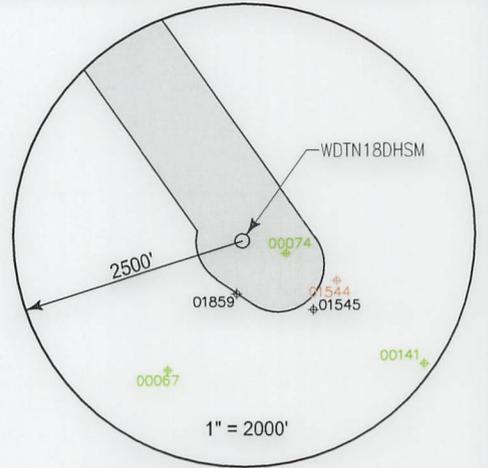

SURFACE HOLE LOCATION (SHL)	
UTM 17 NAD 83	
N: 4393667.261	
E: 555023.787	
NAD 83, WV NORTH	
N: 434978.542	
E: 1726981.076	
LAT/LON DATUM NAD 83	
LAT: 39°41'27.869"	
LON: 80°21'29.787"	
LANDING POINT	
UTM 17 NAD 83	
N: 4393780.739	
E: 555003.872	
NAD 83, WV NORTH	
N: 435351.998	
E: 1726921.948	
LAT/LON DATUM NAD 83	
LAT: 39°41'31.555"	
LON: 80°21'30.589"	
BOTTOM HOLE LOCATION (BHL)	
UTM 17 NAD 83	
N: 4398254.760	
E: 551760.539	
NAD 83, WV NORTH	
N: 450210.821	
E: 1716524.668	
LAT/LON DATUM NAD 83	
LAT: 39°43'57.400"	
LON: 80°23'45.492"	

WDTN18 WELL PAD	
WDTN18AHSM	WDTN18UHSM
WDTN18BHSM	WDTN18EHSM
WDTN18CHSM	WDTN18DHSM



I, the undersigned, hereby certify that this plat is correct to the best of my knowledge and belief and shows all the information required by law and the regulations issued and prescribed by the Department of Environmental Protection.

L. L. S. 687
L. L. S. 687



FILE NO: _____
DRAWING NO: _____
SCALE: 1" = 1000'
MINIMUM DEGREE OF ACCURACY: 1:2500
PROVEN SOURCE OF ELEVATION: NGS CORS Station



DATE: OCTOBER 17 20 24
OPERATORS WELL NO: _____
API WELL NO: 47 - 061 - 01947
STATE COUNTY PERMIT

WELL TYPE: OIL GAS LIQUID INJECTION WASTE DISPOSAL
(IF GAS) PRODUCTION: STORAGE DEEP SHALLOW

LOCATION ELEVATION: 1199' WATERSHED: Dunkard Creek QUADRANGLE: Wadestown
DISTRICT: Battelle COUNTY: Monongalia

SURFACE OWNER: Consol Mining Company LLC ACREAGE: 59.02 ±
ROYALTY OWNER: Bounty Minerals, LLC LEASE NO: 189033000 ACREAGE: 59.02 ±

PROPOSED WORK: DRILL CONVERT DRILL DEEPER FRACTURE OR STIMULATE PLUG OFF OLD FORMATION
 PERFORATE NEW FORMATION OTHER PHYSICAL CHANGE IN WELL (SPECIFY) _____
 PLUG AND ABANDON CLEAN OUT AND REPLUG TARGET FORMATION: Marcellus ESTIMATED DEPTH: TVD: 7,848'

WELL OPERATOR: CNX Gas Company LLC DESIGNATED AGENT: Anthony Kendziora
ADDRESS: 1000 Horizon Vue Drive ADDRESS: 111 Avondale Road
Canonsburg, PA 15317 Fairmont, WV 26554

TRACT ID	SURFACE OWNER	LESSOR	PIN
18B	CNX RCPC LLC	Kimeric and Company LLC	1-9-20
		Antero Resources Corporation	
19	Consol Mining Company LLC	Bounty Minerals, LLC	1-9-31
		John E. Stankola	
24	Consol Mining Company LLC	Bounty Minerals, LLC	1-9-19
28	Paul David Beck, et al	Bounty Minerals, LLC	1-9-6 1-9-6.1 1-9-6.2
29	Consol Mining Company LLC	Roger Goodwin and Ilene Goodwin, his wife	1-9-5
		Consolidation Coal Company	
		CONSOL Mining Company LLC	
		CNX Resource Holdings LLC	
30	Seth Allen Moore	Douglas A. Church	1-9-4
		Terra Firma Company	
		CNX Land LLC	
36	Wolfe Kids LLC	XTO Energy Inc.	1-2-6
		Shuman Inc.	
		Noumenon Corporation	
		O-Max Coal Company	
37	Mike J. Prendergast, et ux	Mike J. Prendergast and Thelma M. Prendergast	1-2-7
47	Consol Mining Company LLC	Shuman Inc.	1-2-5
		Noumenon Corporation	
		O-Max Coal Company	
		Flossie Kimble; Denzle Kimble and Olive Irene Wright Kimble	
		Consolidation Coal Company	
49	Consol Mining Company LLC	David L. McGowan and Brenda J. McGowan	1-2-3
		Barbara A. Berry	
		Rand L. Martin and Jeannetta I. Martin	
		Salvatore Veltri and Janis M. Veltri	
		Bessie Eden Wise	
		Consolidation Coal Company	
51A	Monongalia County Coal Resources Inc.	XTO Energy, Inc.	1-2-1
		Regina Schrimper	
		Latricia Estridge	
		Jon Walton	
		Ellis Shannon McCreadie	
		Anna Marie Boortz	
		Dora Irene Antel Six	
		Virginia L. Smalley	
		Judith Six	
		Alice Clara Conwell, a/k/a Alice Claire Conwell	
		Sarah E. Roark, f/k/a Sarah E. McCreadie	
		Clareen Frances Gomez	
		Gregory Joseph Kleinhenz	
		MP&G Legacy Holding LLC	
		Stanhagen Legal Limited Liability Company	
		Accord Land Services, LLC	
		Wild Thing Barnstormers, LLC	
		David M. McCallum	
		Marjorie Oakley	
		Timothy Michael Kleinhenz and Verallen M. Kleinhenz, h/w	
		Laura Lee Cook	
		William N. Richards, a/k/a William Nelson	
		Pamela Colleen Dillon	
		John C. Richards	
		Norita Hinerman	
		Phyllis Ann Richards	
		Douglas Grant Richards, a/k/a Grant Douglas Richards	
		Michael Stephen Kleinhenz	
		Mark Anthony Kleinhenz	
		Andrea Lee Chapman	
		Anthony Francis Kleinhenz	
		Carol Marie Murray	
		Barbara Ann Dillon	
		Linda Samuels	
		Jimmie Kyle Core	
		Donna DiPietrantonio, f/k/a Donna Romey	
		Wilma Arlene Coffey	
		Monongalia County Coal Company	

03/14/2025

TRACT ID	SURFACE OWNER	LESSOR	PIN
52A	Cucumber Tree Farm Inc.	Cucumber Tree Farm, Inc.	1-2-2.1
		Mountain V Oil & Gas, Inc.	
		Hayden Harper Energy Pennsylvania, LLC	
		Bluestone Energy Partners	
		Antero Resources Bluestone LLC	
		Antero Resources Appalachian Corporation	
		Energy Corporation of America	
		EQT Production Company	

03/14/2025