



RECEIVED
 Office of Oil and Gas
 FEB 03 2025
 WV Department of
 Environmental Protection

Well# 8162

HUNDRED WV, PA 7.5' Quad

Scale: 1" = 500'



Whister

Oil Well

1400

1300

Whister

Well# 8162

1300


e
Ch

Cem

RECEIVED
Office of Oil and Gas

FEB 03 2025

WV Department of
Environmental Protection

Access Road 

02/21/2025

Well# 8162

HUNDRED WV, PA 7.5' Quad

Scale 1" = 2000'


BATTELLE

Well# 8162

RECEIVED
Office of Oil and Gas
FEB 03 2025
10:00 AM
WV Department of
Environmental Protection

Access Road

02/21/2025

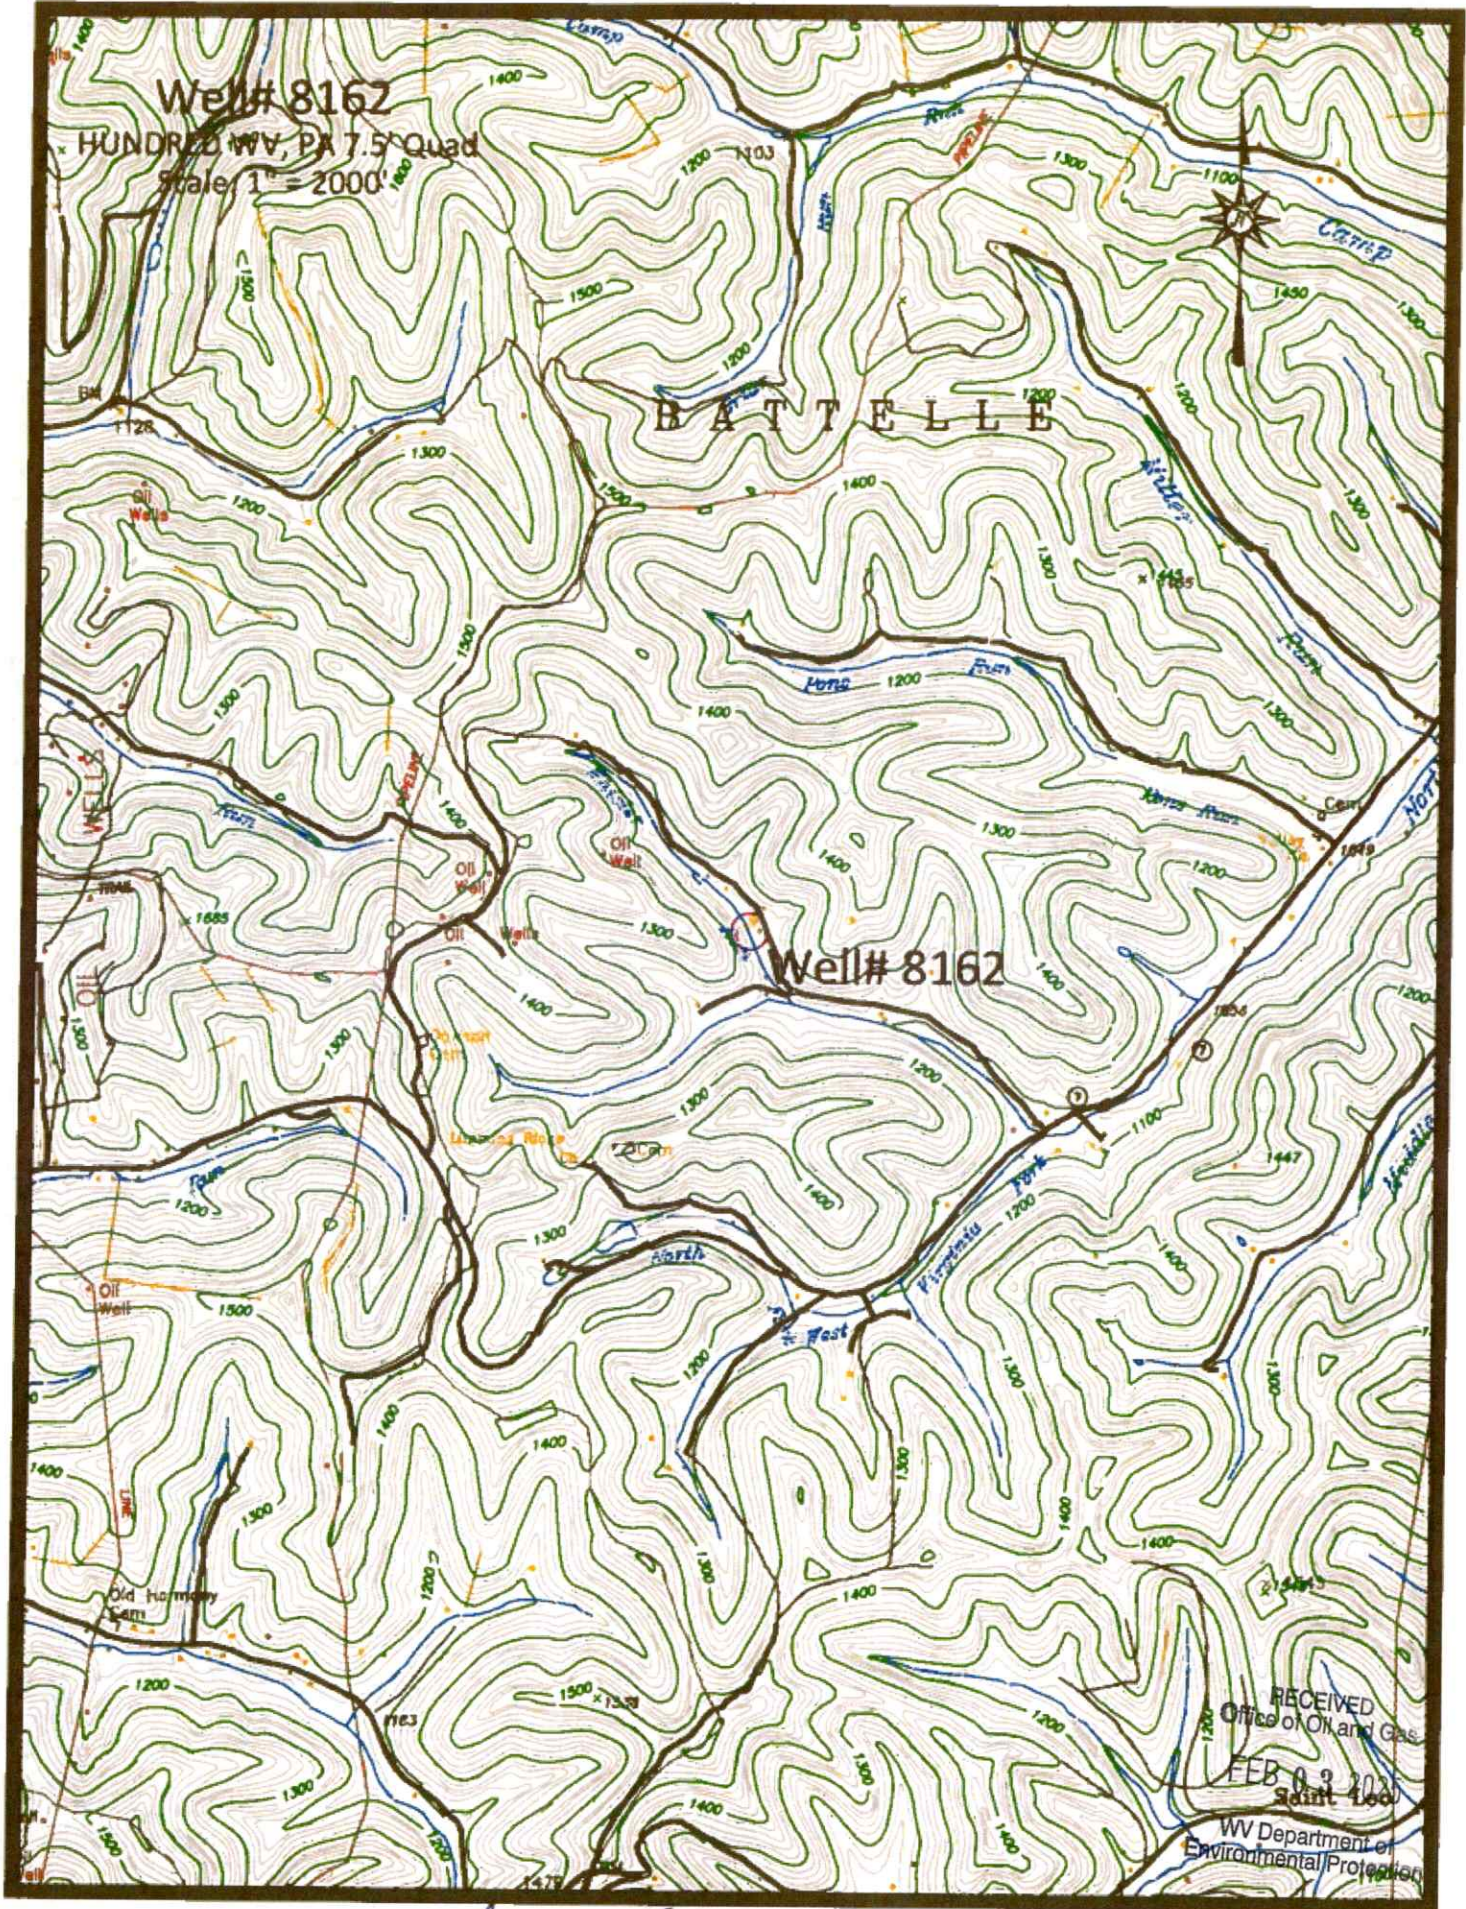



RECEIVED
Office of Oil and Gas

FEB 23 2025

WV Department of
Environmental Protection

02/21/2025

WW-7
8-30-06



West Virginia Department of Environmental Protection
Office of Oil and Gas

WELL LOCATION FORM: GPS

API: 47-061-70447 WELL NO.: 8162

FARM NAME: MASON S. HENDERSON

RESPONSIBLE PARTY NAME: WEST VIRGINIA LAND RESOURCES INC.

COUNTY: MONONGALIA DISTRICT: BATTELLE

QUADRANGLE: HUNDRED W.VA, PA

SURFACE OWNER: KANDY L. & RANDY L. EARL

ROYALTY OWNER: _____

UTM GPS NORTHING: 4,391,091 m

UTM GPS EASTING: 552,417 m GPS ELEVATION: 344 m

The Responsible Party named above has chosen to submit GPS coordinates in lieu of preparing a new well location plat for a plugging permit or assigned API number on the above well. The Office of Oil and Gas will not accept GPS coordinates that do not meet the following requirements:

1. Datum: NAD 1983, Zone: 17 North, Coordinate Units: meters, Altitude: height above mean sea level (MSL) – meters.
2. Accuracy to Datum – 3.05 meters
3. Data Collection Method:

Survey grade GPS : Post Processed Differential _____
Real-Time Differential

Mapping Grade GPS _____ : Post Processed Differential _____
Real-Time Differential _____

4. Letter size copy of the topography map showing the well location.

I the undersigned, hereby certify this data is correct to the best of my knowledge and belief and shows all the information required by law and the regulations issued and prescribed by the Office of Oil and Gas.


Signature

2025
Title

JANUARY 20, 2025
Date

RECEIVED
Office of Oil and Gas
FEB 03 2025
WV Department of
Environmental Protection