


WELL NAME: ERP 3H  
WADESTOWN, WV

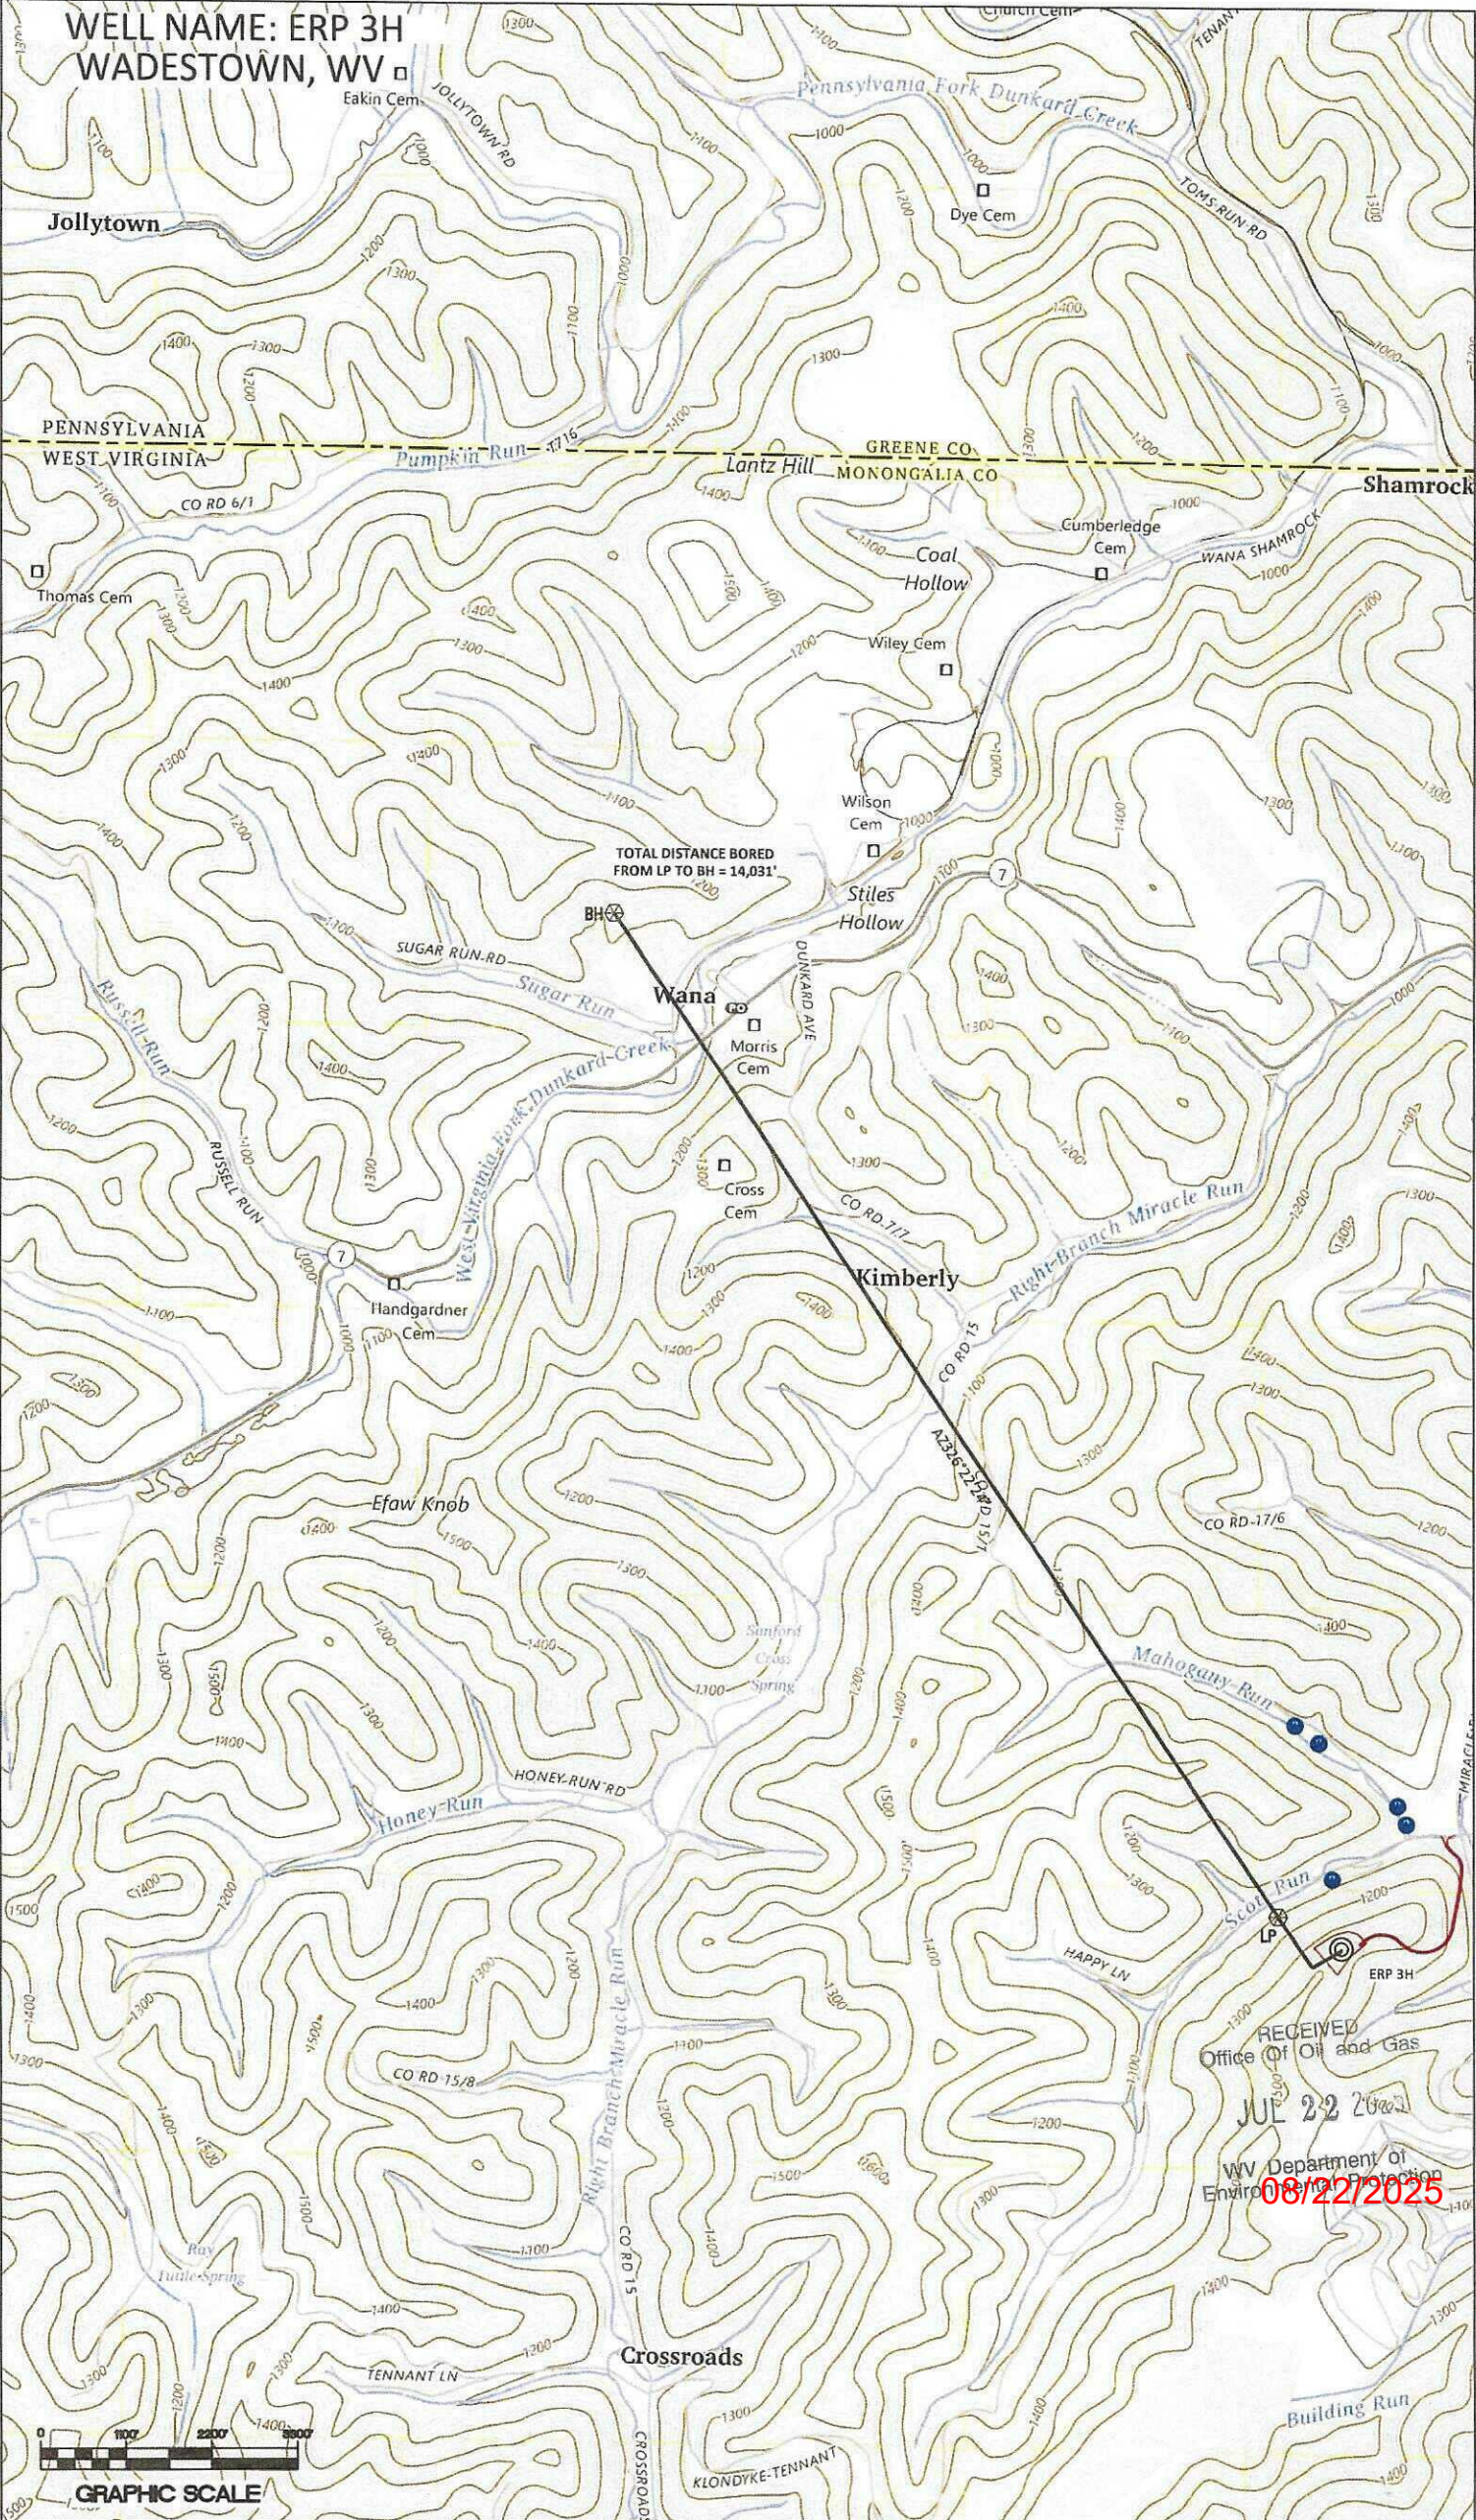

TOTAL DISTANCE BORED  
FROM LP TO BH = 14,031'

RECEIVED  
Office of Oil and Gas  
JUL 22 2025  
WV Department of  
Environment  
08/22/2025





| PROPERTY OWNER INDEX |                                                        |
|----------------------|--------------------------------------------------------|
| 1-7-6.1              | GRACE FELLOWSHIP S B C                                 |
| 1-7-7                | GRACE FELLOWSHIP S B C                                 |
| 1-7-7.1              | EAKIN-WANA CEMETERY                                    |
| 1-7-8.1              | RYAN & RACHEL LEMLEY                                   |
| 1-7-17               | RICHARD A & LINDA S WADE                               |
| 1-7-19               | WILLIAM C, REBECCA L CROSS; FRODELIUS & TAMELA D CROSS |
| 1-7-20               | RICKY LEE & KATHRYN CROSS                              |
| 1-7-20.1             | DEBORAH L SIMPSON                                      |
| 1-7-20.2             | DOUGLAS M CURRENCE                                     |
| 1-7-20.4             | DEBORAH LYNN SIMPSON                                   |
| 1-7-20.5             | KEITH A AMMONS                                         |
| 1-7-20.6             | KEITH A AMMONS                                         |
| 1-7-20.7             | KEITH A AMMONS                                         |
| 1-7-22               | RANDY A HENNEN                                         |
| 1-7-24               | RANDY STILES & KAREN CHURCH (LIFE RAYMOND O STILES)    |
| 1-7-24.1             | RANDY STILES & KAREN CHURCH (LIFE RAYMOND O STILES)    |
| 1-7-24.2             | JEFFREY W & AMBER J CROPPER                            |
| 1-7-24.3             | JON WILLIAM & SAVANNA FLEEMAN                          |
| 1-7-26               | RANDY A & BETH A STILES                                |
| 1-8-30               | CONSOL MINING COMPANY LLC                              |
| 1-14-13              | JOSEPH CARL & SUSAN E TOOTHMAN                         |
| 1-14-15              | EDWARD L TENNANT                                       |
| 1-14-17              | RANDELL LEE LANTZ                                      |
| 1-14-18              | NORMA J & FREDDIE WAYNE WILLIAMS                       |
| 1-14-19              | NORMA WILLIAMS                                         |
| 1-14-19.1            | PHOENIX FEDERAL MINING COMPLEX LLC                     |
| 1-17-14              | PHOENIX FEDERAL MINING COMPLEX LLC                     |

| LEASE INDEX |                       |   |                       |
|-------------|-----------------------|---|-----------------------|
| A           | WV-061-005667-001     | K | WV-061-005924-001     |
| B           | WV-061-005667-001     | L | WV-061-005925-001     |
| C           | WV-061-005697-001     | M | WV-061-005924-001     |
| D           | WV-061-006663-002     | N | WV-061-006307-001     |
| E           | WV-061-005843-009     | O | WV-061-006430-003     |
| F           | WV-061-005842-008     | P | WV-061-000195-001-JOA |
| G           | WV-061-005805-001     | Q | WV-061-000195-001-JOA |
| H           | WV-061-000195-001-JOA | R | WV-061-000195-001-JOA |
| I           | WV-061-006789-001     | S | WV-061-006689-001     |
| J           | WV-061-005947-001     |   |                       |

RECEIVED  
Office Of Oil and Gas  
JUL 22 2025  
WV Department of  
Environmental Protection

08/22/2025

|            |       |                    |               |
|------------|-------|--------------------|---------------|
| FILE #:    | NEE20 | DATE:              | JULY 8, 2025  |
| DRAWING #: | 3058  | OPERATOR'S WELL #: | ERP 3H        |
| SCALE:     | N/A   | API WELL #:        | 47 061 02011  |
|            |       | STATE              | COUNTY PERMIT |