


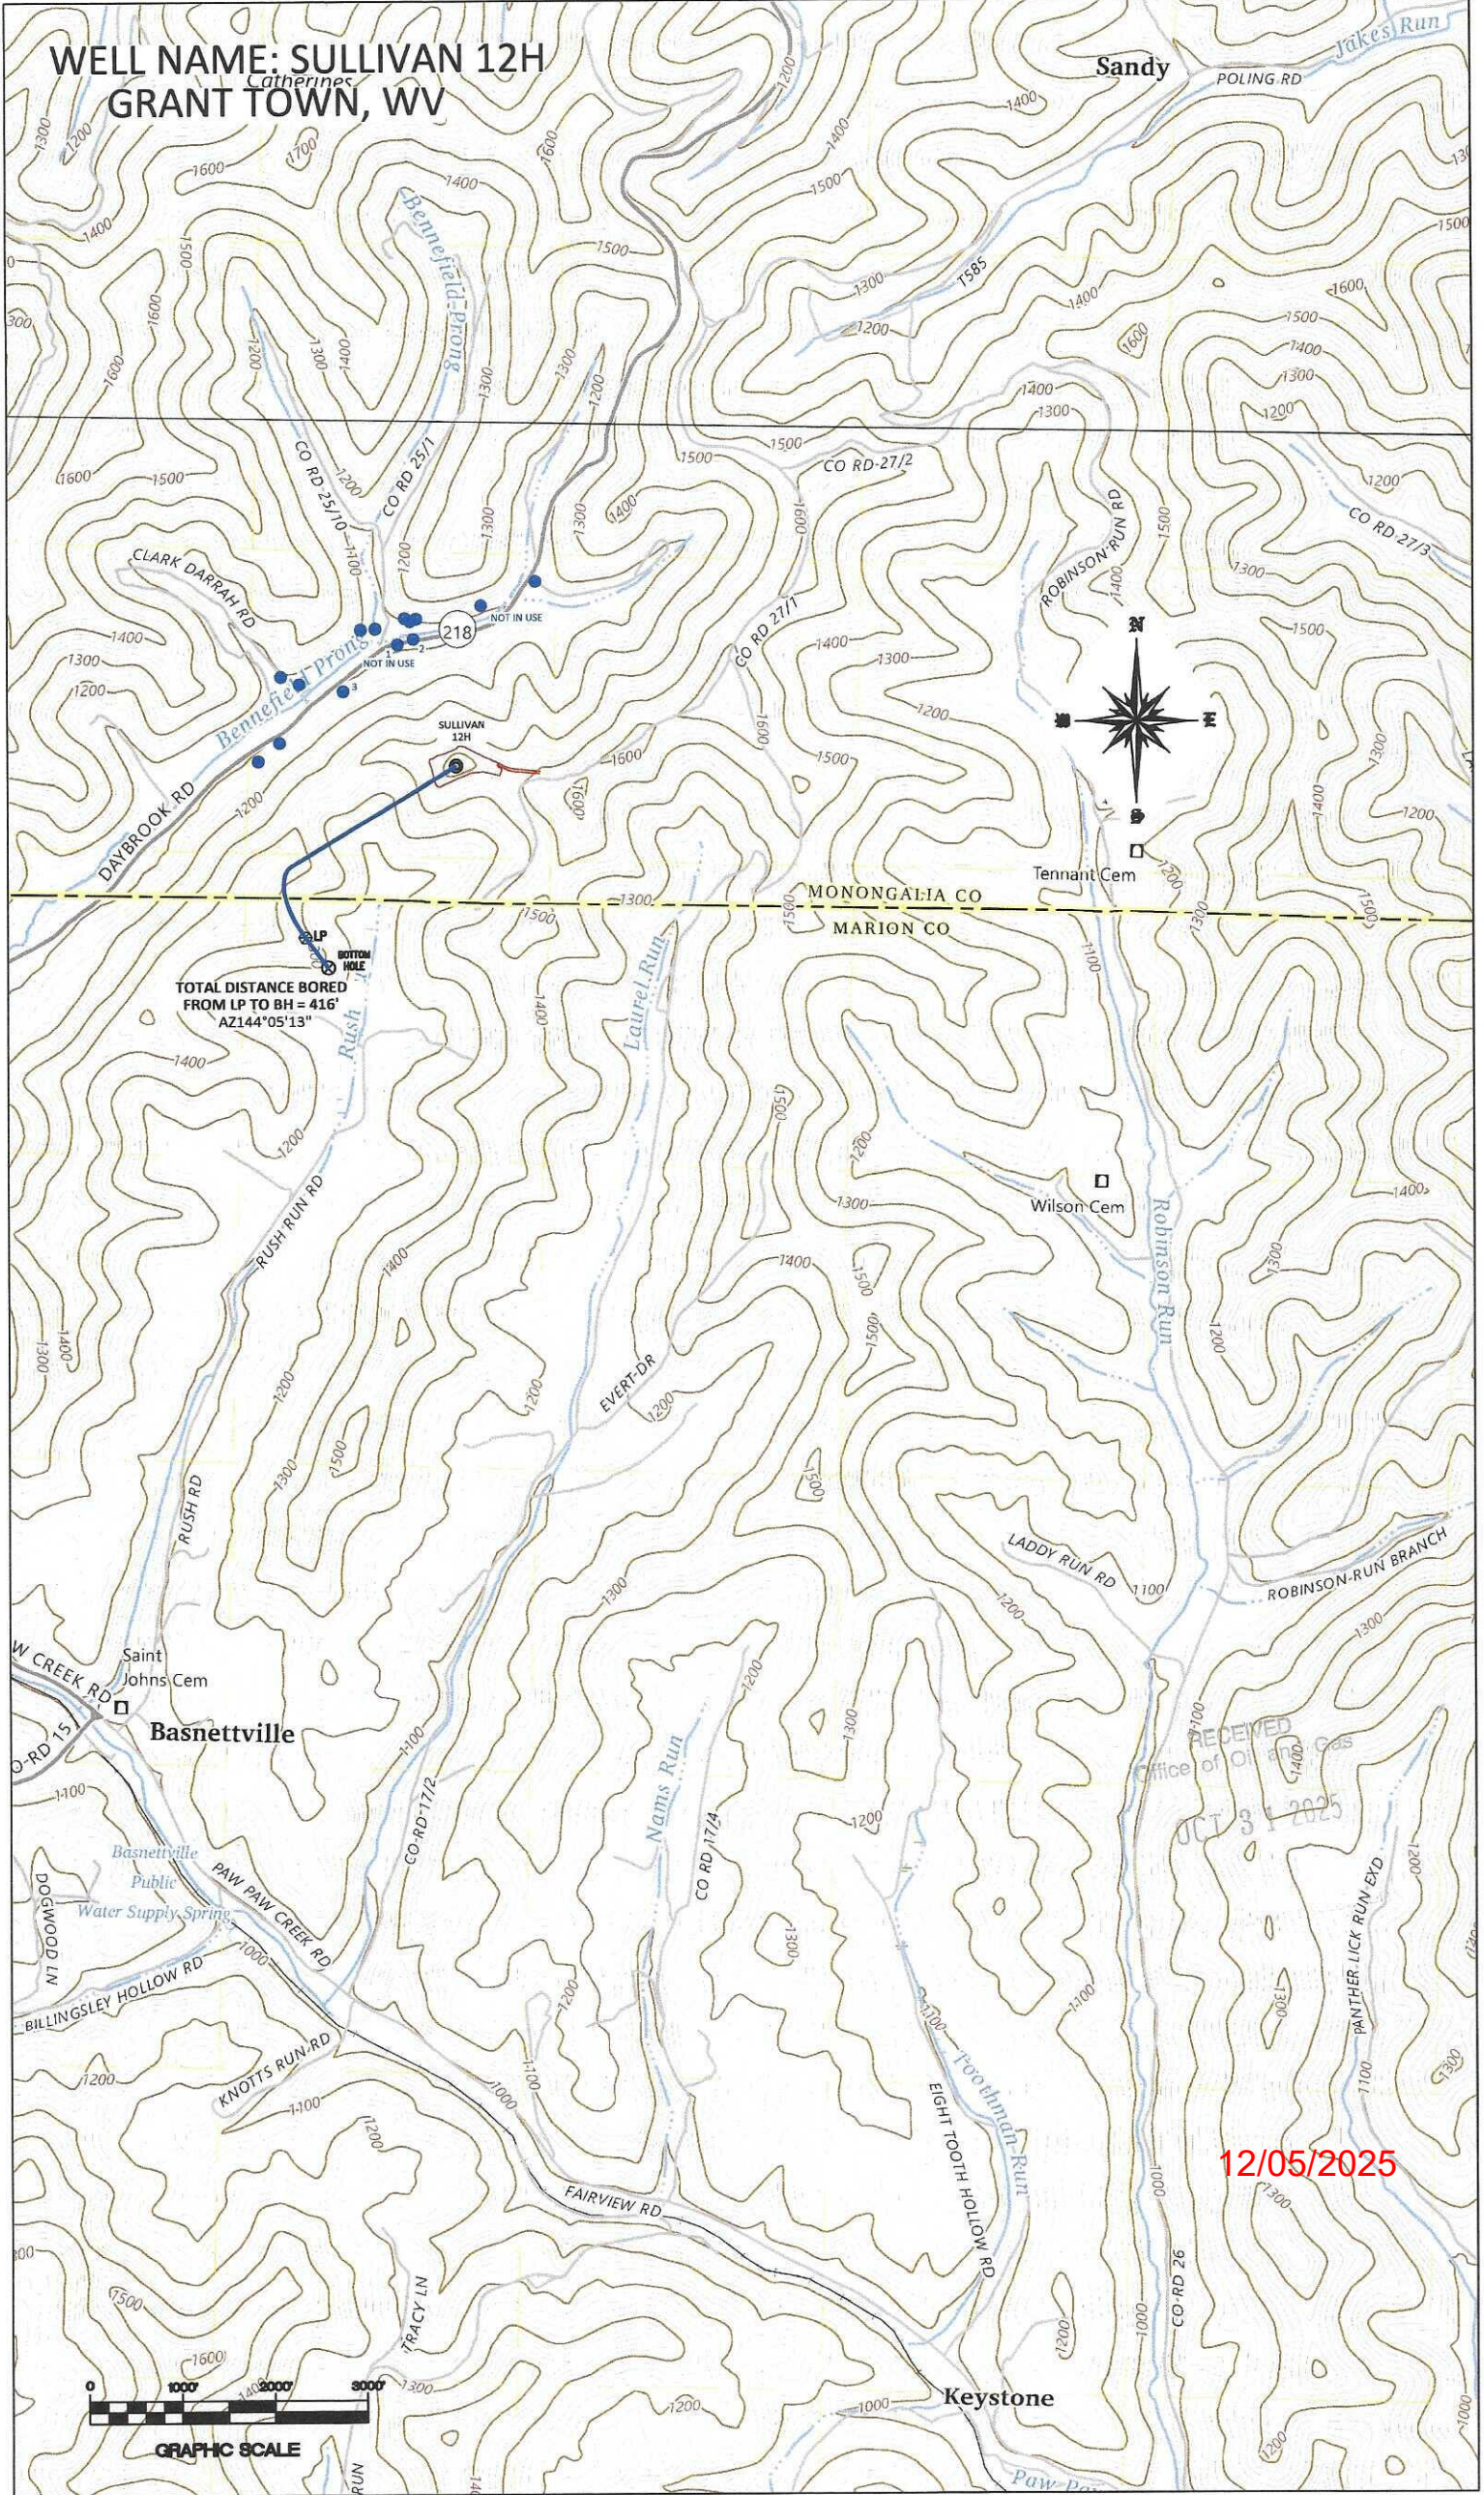

WELL NAME: SULLIVAN 12H
GRANT TOWN, WV



12/05/2025

RECEIVED
Office of Oil and Gas
OCT 31 2025

	PROPERTY OWNER INDEX
4-26-35.1	ALAN SULLIVAN
4-26-35	JAMES LOUIS DOUKAS
4-26-34	SHIRLEY J NEELY, DEANNA M FRAZIER, DONNA J WALDEN & DARRIN NEELY

	LEASE INDEX
A	WV-061-005448-002
B	WV-061-006176-001
C	WV-061-006238-004

12/05/2025

FILE #: <u> NNE25 </u> DRAWING #: <u> 4161 </u> SCALE: <u> N/A </u>	DATE: <u> OCTOBER 13, 2025 </u> OPERATOR'S WELL #: <u> SULLIVAN 12H </u> API WELL #: <u> 47 </u> <u> 061 </u> <u> 02021 </u> STATE COUNTY PERMIT
---	---