



WELL NAME: LAURITA 13H  
RIVESVILLE, WV

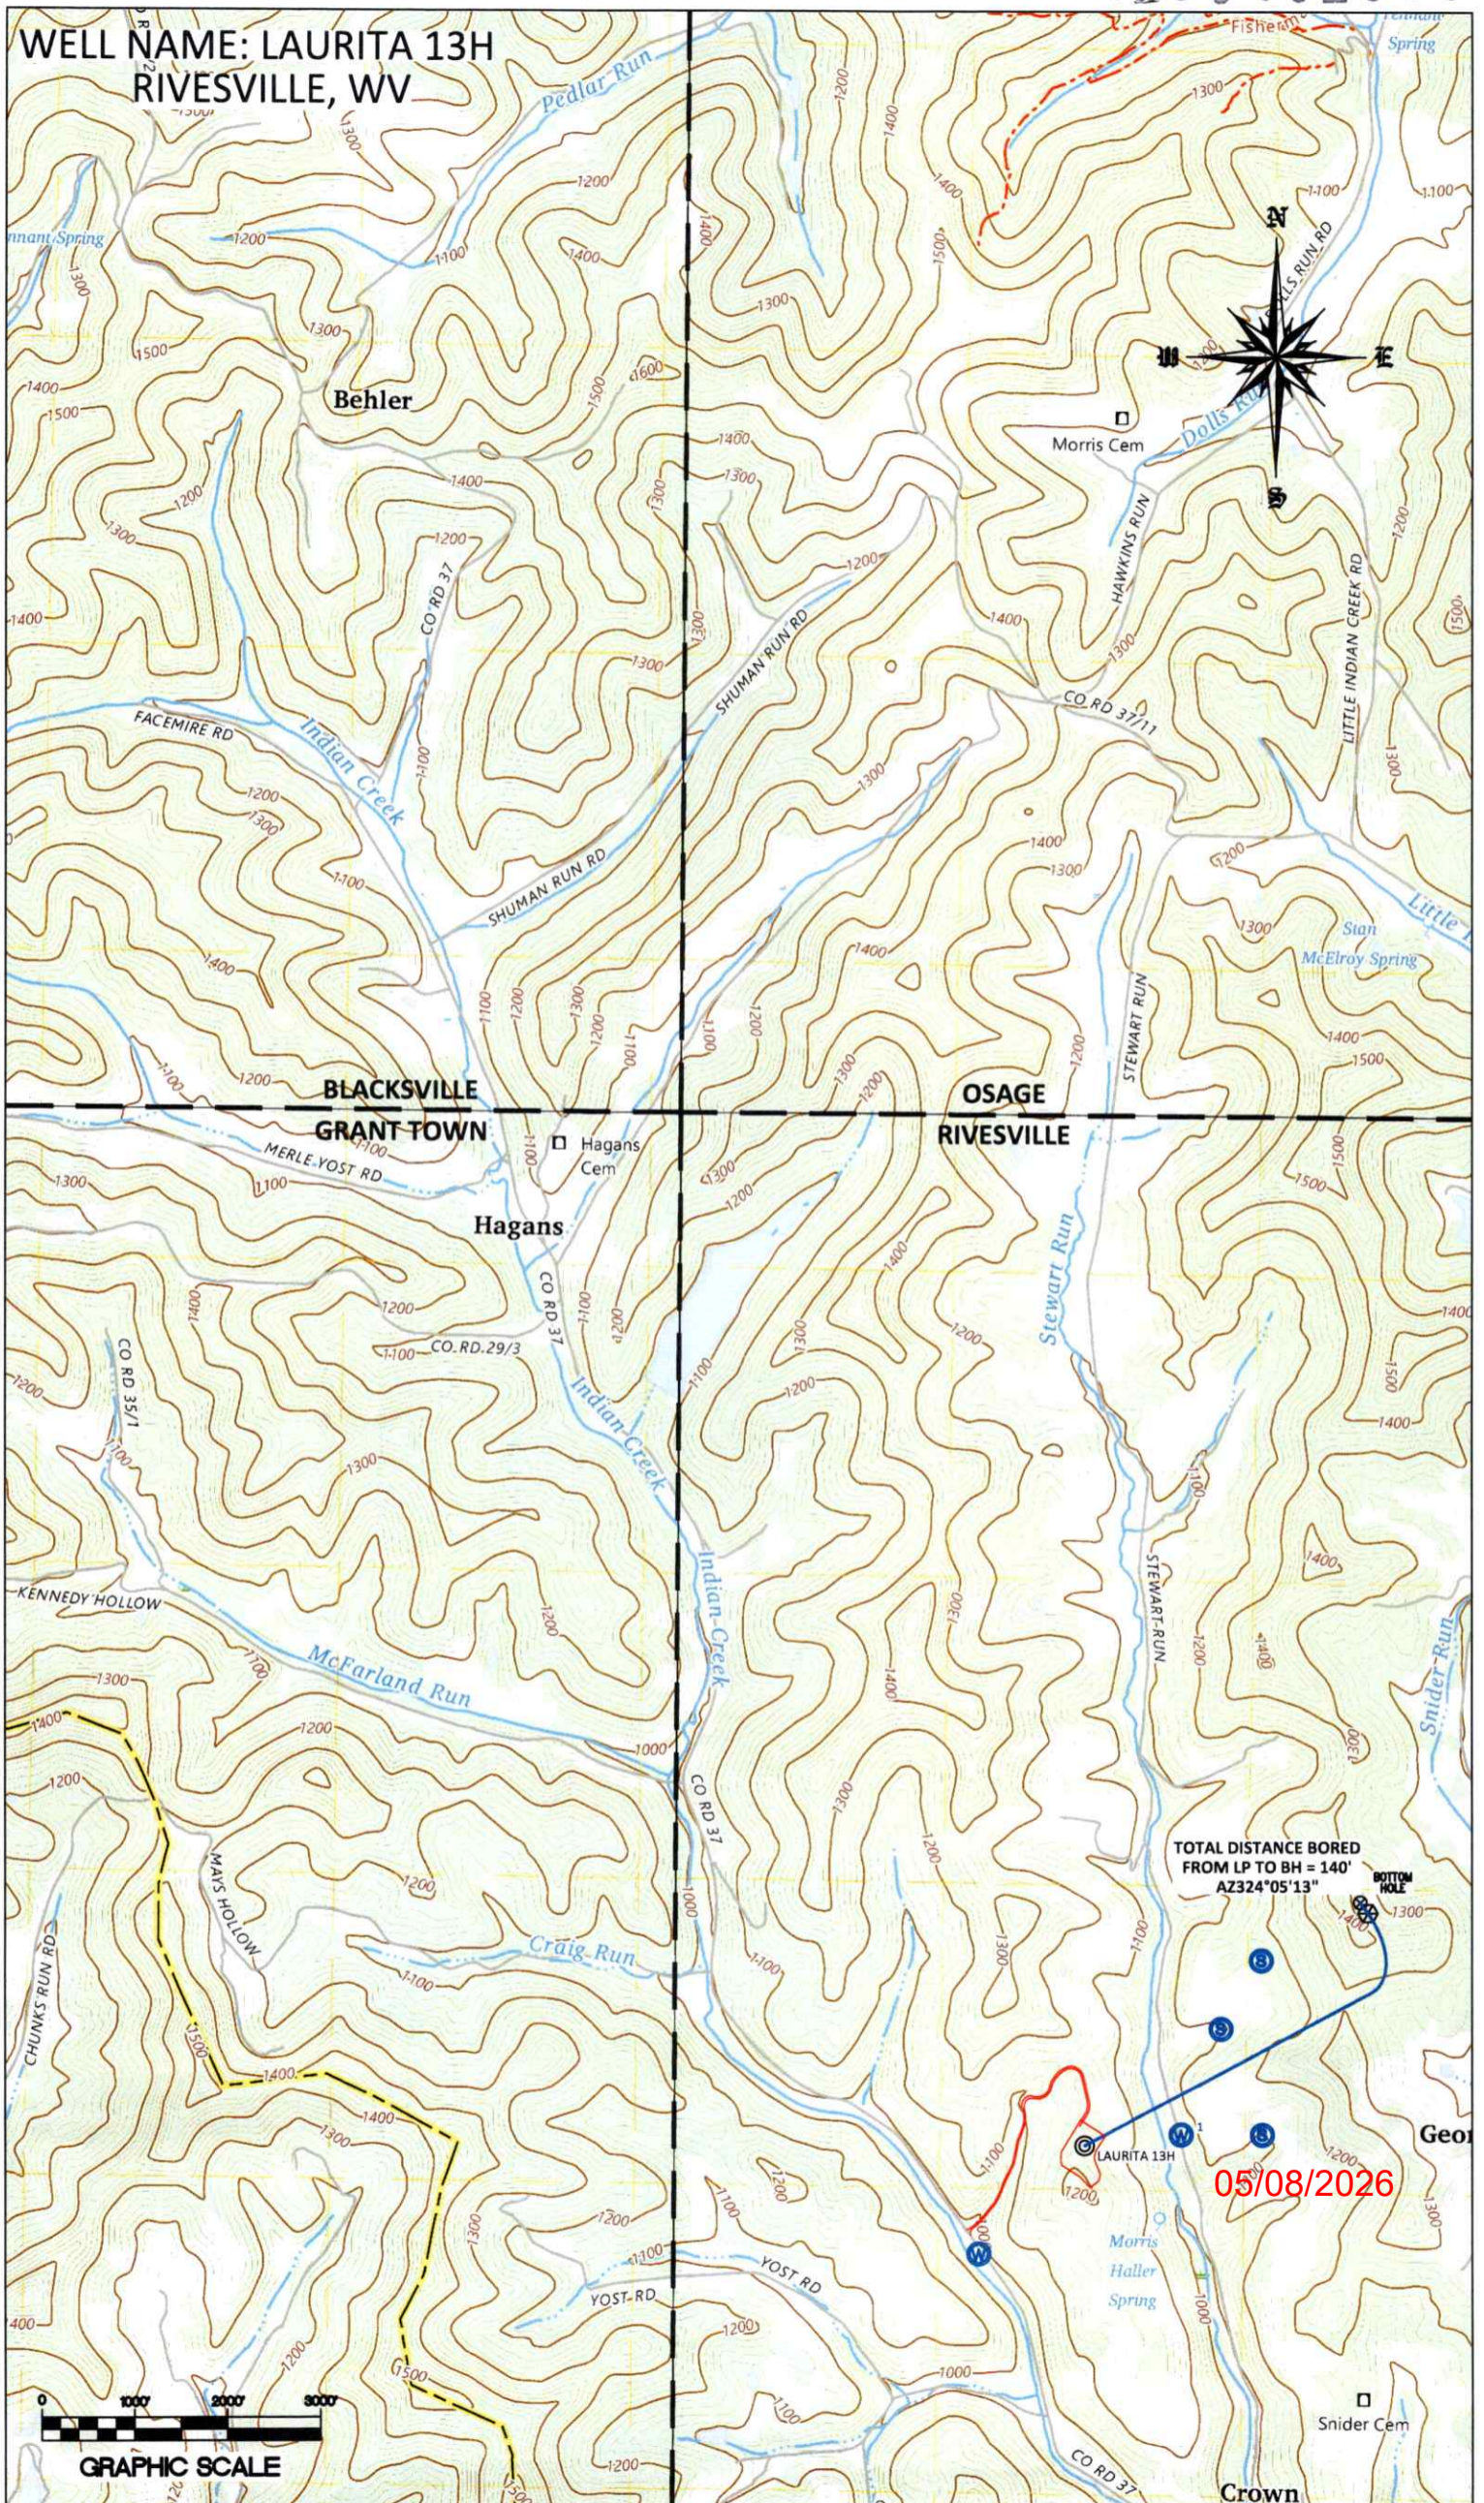

TOTAL DISTANCE BORED  
FROM LP TO BH = 140'  
AZ324°05'13"

05/08/2026

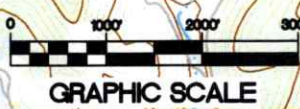

GRAPHIC SCALE



| PROPERTY OWNER INDEX |  |
|----------------------|--|
| 7-17-36              | NORTHEAST NATURAL ENERGY LLC                 |
| 7-17-38              | PATRICIA KELLY                               |
| 7-17-37              | ALFRED JUNIOR GLOVER                         |
| 7-17-57              | GORDON WAYNE & SHEILA M LAWSON               |
| 7-17-60              | GORDON WAYNE & SHEILA M LAWSON               |
| 7-10-25              | ROBERT & VIRGINIA RADCLIFF IRREVOCABLE TRUST |

| LEASE INDEX |                   |
|-------------|-------------------|
| A           | WV-061-00219-001  |
| B           | WV-061-107054-003 |
| C           | WV-061-006290-002 |
| D           | WV-061-086281-002 |

05/08/2026

FILE #:       NNE25      

DRAWING #:       4147      

SCALE:       N/A      

DATE:       MARCH 6, 2026      

OPERATOR'S WELL #:       LAURITA 13H      

API WELL #:       47             061             02034        
STATE COUNTY PERMIT