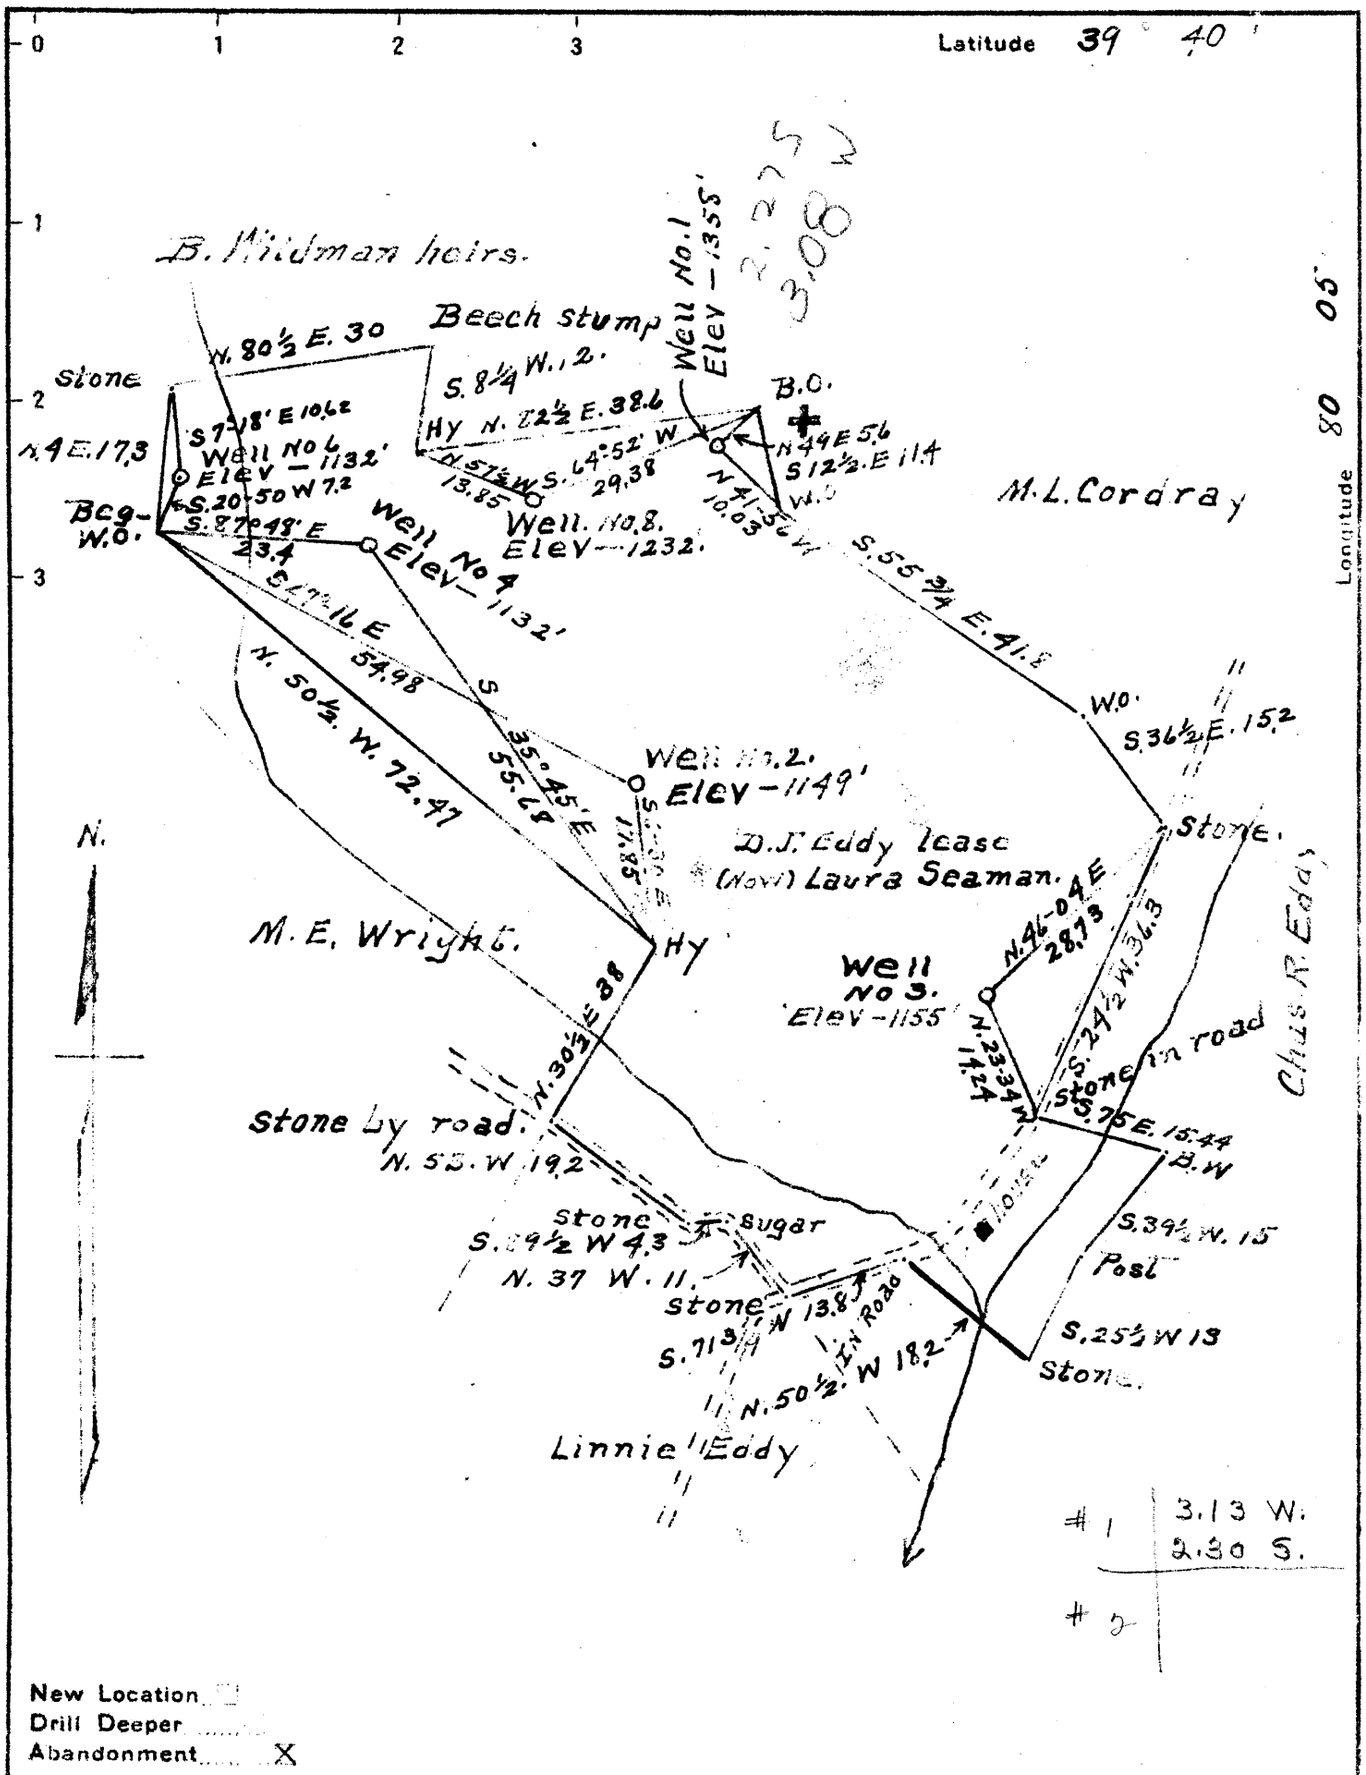

New Location ☐
Drill Deeper .....
Abandonment X

Company DUNN-MAR OIL & GAS Co.
Address Waynesburg Pa.
Farm Part of D.J. Eddy farm
Tract one Acres 39+ Lease No.
Well (Farm) No. 1-2-3-4-5-6-7-8 Serial No.
Elevation (Spirit Level) As shown Above
Quadrangle Blacksville
County Monongalia District Clay
Engineer A.L. Bradley
Engineer's Registration No.
File No. Drawing No.
Date May 20, 1941 Scale 1 inch = 20 poles

STATE OF WEST VIRGINIA
DEPARTMENT OF MINES
OIL AND GAS DIVISION
CHARLESTON

WELL LOCATION MAP

FILE NO. MON 228A #8

+ Denotes location of well on United States Topographic Maps, scale 1 to 62,500, latitude and longitude lines being represented by border lines as shown.

— Denotes one inch spaces on border line of original tracing.