

69 00038P

WW-7
8-30-06



West Virginia Department of Environmental Protection
Office of Oil and Gas
WELL LOCATION FORM: GPS

API: 47-069-00038 WELL NO.: 207-79-T

FARM NAME: Jack

RESPONSIBLE PARTY NAME: Edward Shultz

COUNTY: Ohio DISTRICT: 6-Triadelphia

QUADRANGLE: Valley Grove

SURFACE OWNER: AB Holding DE, LLC.

ROYALTY OWNER: Lois Jack

UTM GPS NORTHING: 4434319.60m

UTM GPS EASTING: 535650.69m GPS ELEVATION: 397.65m

(1304.3')

The Responsible Party named above has chosen to submit GPS coordinates in lieu of preparing a new well location plat for a plugging permit or assigned API number on the above well. The Office of Oil and Gas will not accept GPS coordinates that do not meet the following requirements:

1. Datum: NAD 1983, Zone: 17 North, Coordinate Units: meters, Altitude: height above mean sea level (MSL) – meters.
2. Accuracy to Datum – 3.05 meters
3. Data Collection Method:

Survey grade GPS : Post Processed Differential _____

Real-Time Differential

Mapping Grade GPS _____ : Post Processed Differential _____

Real-Time Differential _____

4. **Letter size copy of the topography map showing the well location.**

I the undersigned, hereby certify this data is correct to the best of my knowledge and belief and shows all the information required by law and the regulations issued and prescribed by the Office of Oil and Gas.

RECEIVED
Office of Oil and Gas


SEP 06 2016

West Virginia Department of
Environmental Protection

Jeffery A. Musgrove
Signature

WELL PERMITTING MANAGER 29 AUG 2016
Title Date


09/23/2016

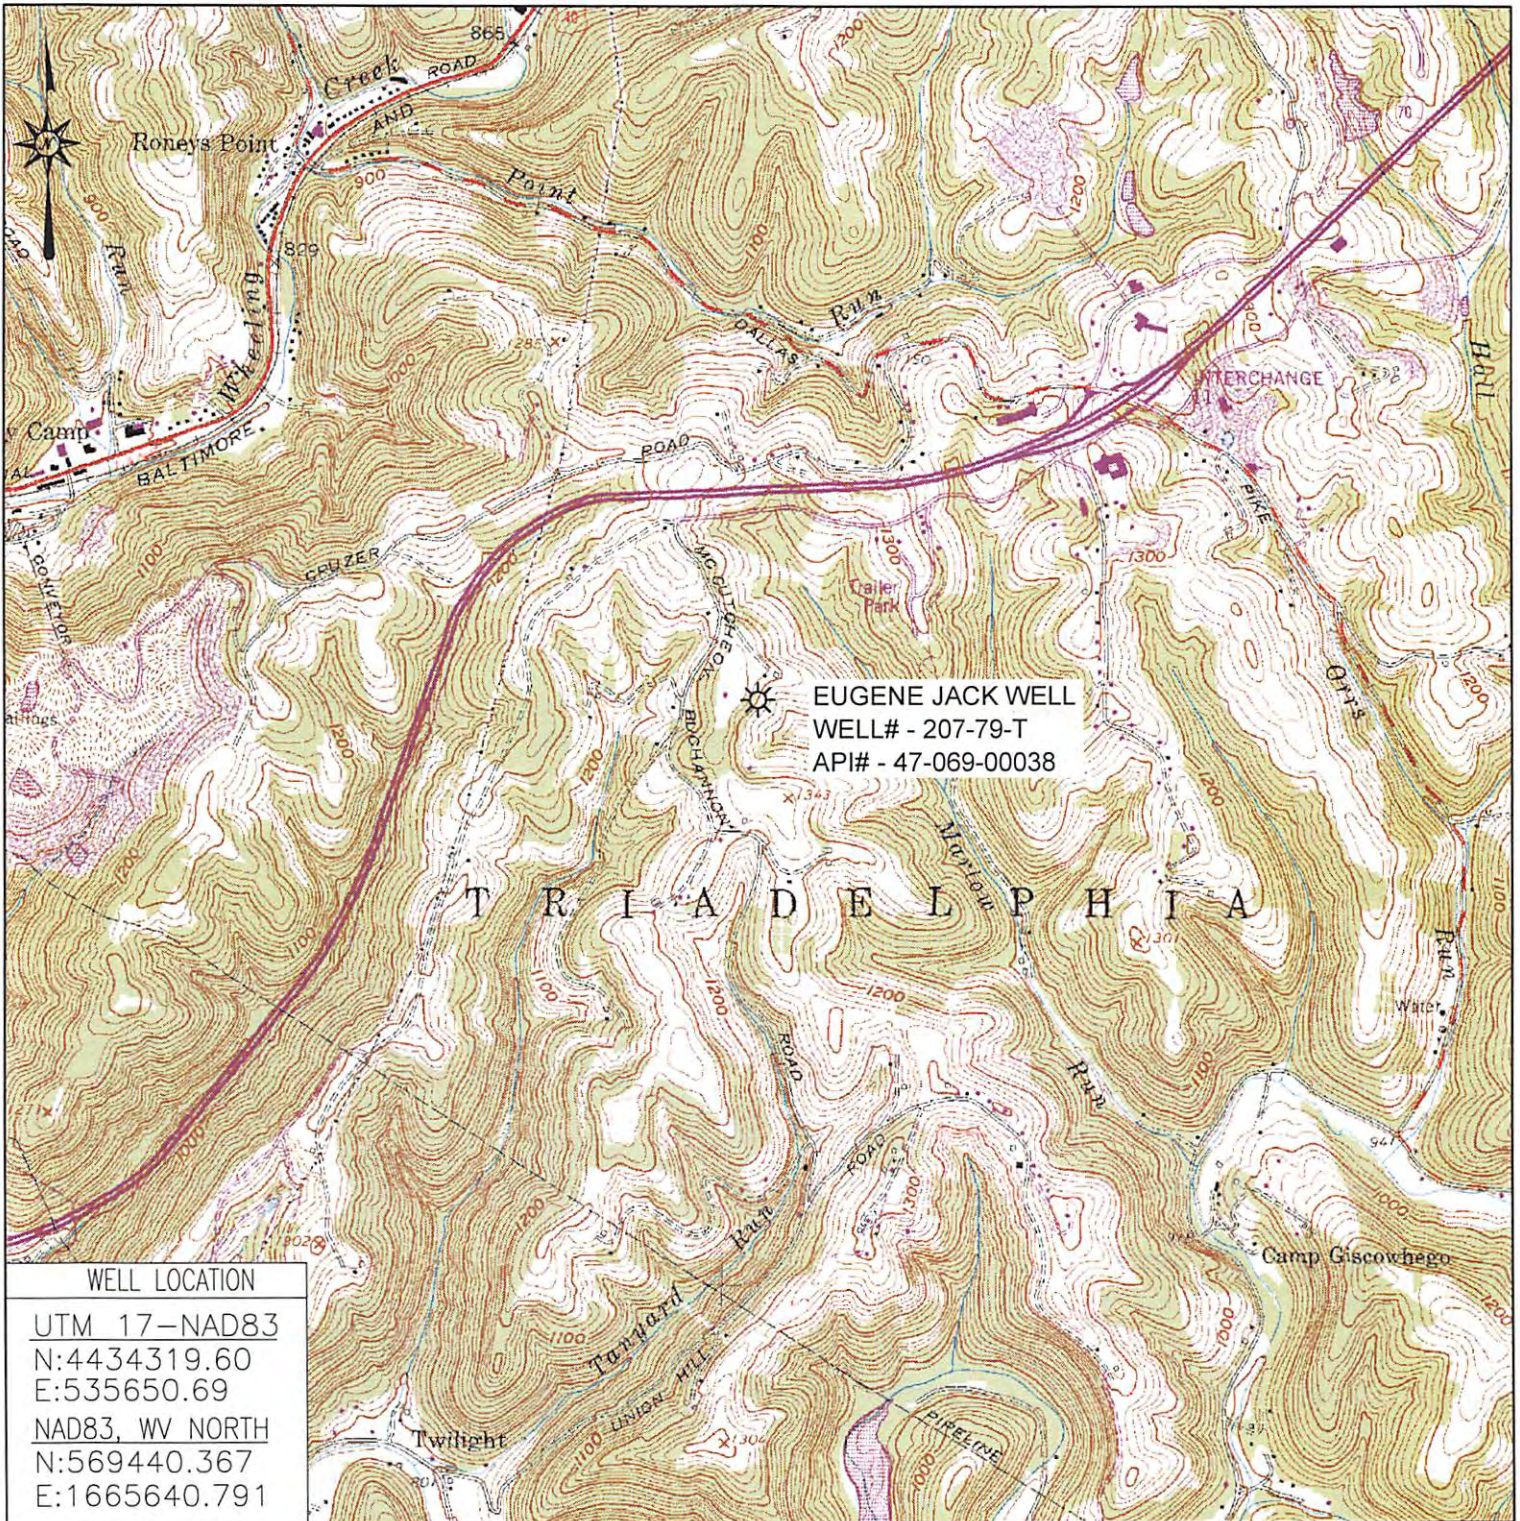

WELL LOCATION
UTM 17-NAD83
N:4434319.60
E:535650.69
NAD83, WV NORTH
N:569440.367
E:1665640.791

PREPARED FOR:
 EDWARD SHULTZ
 2364 OVERBROOK AVENUE
 WHEELING, WV 26003

EUGENE JACK WELL
WELL LOCATION MAP
OHIO COUNTY
TRIADELPHIA DISTRICT
WEST VIRGINIA

LEGEND
 - WELL LOCATION

TOPO QUAD: VALLEY GROVE, WV
 SCALE: 1" = 2000'
 DATE: AUGUST 29, 2016

