


NOTE:
 THIS MAP IS FOR WELL LOCATION ONLY. PROPERTY LINES, AS SHOWN, ARE BASED ON DEED RECORDS & DOSE NOT REPRESENT A COMPLETE PROPERTY LINE SURVEY.

(+) Denotes location of well on United States Topographic Maps.

FILE NO. 07-B-012
 DRAWING NO. 07-B-012-W3B
 SCALE: 1" = 600'
 MINIMUM DEGREE OF ACCURACY 1/2500
 PROVEN SOURCE OF ELEVATION USGS B.M. G121

I, the undersigned, hereby certify that this plat is correct to the best of my knowledge and belief and shows all the information required by law and the regulations issued and prescribed by The Department of Mines.

(Signed) Donald S. Kyer
 R.P.E. L.L.S. 891

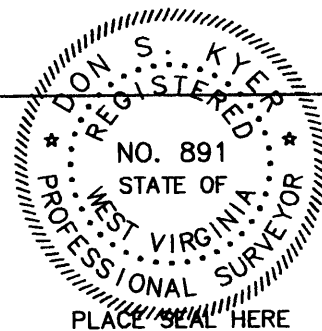

STATE OF WEST VIRGINIA
 DIVISION OF ENVIRONMENTAL PROTECTION
 SECTION OF OIL & GAS

DATE: JANUARY 14, 2008
 OPERATOR'S WELL NO. TRCBM-3
 API WELL NO.

WELL TYPE: OIL GAS LIQUID INJECTION WASTE DISPOSAL
 (IF "GAS") PRODUCTION STORAGE DEEP SHALLOW

47 069 00054-C
 STATE COUNTY PERMIT

LOCATION: ELEVATION: 919.08 WATERSHED: SHORT CREEK

DISTRICT: RICHLAND COUNTY: OHIO
 QUADRANGLE: TILTONSVILLE COORDINATES: LAT. 40°09'15.07" LONG. -80°39'40.63"

SURFACE OWNER: ALLIANCE RESOURCE GP, LLC ACREAGE: 147.5
 OIL & GAS ROYALTY OWNER: ALLIANCE RESOURCE GP, LLC LEASE ACREAGE: 80
 LEASE NO.

PROPOSED WORK: DRILL CONVERT DRILL DEEPER REDRILL FRACTURE OR STIMULATE
 PLUG OFF OLD FORMATION PERFORATE NEW FORMATION
 OTHER PHYSICAL CHANGE IN NEW WELL (SPECIFY) _____

PLUG AND ABANDON CLEAN OUT AND REPLUG
 TARGET FORMATION: LOWER KITTANNING COAL SEAM ESTIMATED DEPTH: 774'

WELL OPERATOR: JESMAR ENERGY, INC. DESIGNATED AGENT: JAMES TALKINGTON
 ADDRESS: 348 BLUFF RIDGE RD. ADDRESS: 1100 AVALON RD.
 HOLBROOK, PA. 15341 FAIRMONT, WV 26554

JAN 25 2008

OHIO 0054 C

WR-35
Rev (5-01)

DATE: 1/27/09
API #: 47-6900054

State of West Virginia
Department of Environmental Protection
Office of Oil and Gas

Well Operator's Report of Well Work

Farm name: Alliance Resource GP LLC

Operator Well No.: TRCBM-3

LOCATION: Elevation: 920

Quadrangle: Tiltonsville

District: Richland

County: Ohio

Latitude: 10,143 Feet South of 40 Deg. 10 Min. 0 Sec.

Longitude 4547 Feet West of 80 Deg. 37 Min. 30 Sec.

Company: Jesmar Energy, Inc.

	Casing & Tubing	Used in drilling	Left in well	Cement fill up Cu. Ft.
Address: 348 Bluff Ridge Road	13 3/8"	22'	22'	13
Holbrook, Pa. 15341	9 5/8"	120'	120'	54
Agent: James Talkington	7"	620'	620'	130
Inspector: Dave Cowan				
Date Permit Issued: 1/25/08				
Date Well Work Commenced: 5/01/08				
Date Well Work Completed: 5/14/08				
Verbal Plugging:				
Date Permission granted on:				
Rotary x Cable Rig				
Total Depth (feet): 896				
Fresh Water Depth (ft.): 85'				
Salt Water Depth (ft.): none				
Is coal being mined in area (N/Y)? Y				
Coal Depths (ft.): 85,661,735,759				

OPEN FLOW DATA

Producing formation Kittanning Coal Seam Pay zone depth (ft) 846-950

Gas: Initial open flow 5 MCF/d Oil: Initial open flow Bbl/d

Final open flow 30 MCF/d Final open flow Bbl/d

Time of open flow between initial and final tests Hours

Static rock Pressure 195 psig (surface pressure) after 48 Hours

Second producing formation Pay zone depth (ft)

Gas: Initial open flow MCF/d Oil: Initial open flow Bbl/d

Final open flow MCF/d Final open flow Bbl/d

Time of open flow between initial and final tests Hours

Static rock Pressure psig (surface pressure) after Hours

RECEIVED

Office of Oil & Gas

FEB 02 2009

WV Department of
Environmental Protection

NOTE: ON BACK OF THIS FORM PUT THE FOLLOWING: 1). DETAILS OF PERFORATED INTERVALS, FRACTURING OR STIMULATING, PHYSICAL CHANGE, ETC. 2). THE WELL LOG WHICH IS A SYSTEMATIC DETAILED GEOLOGICAL RECORD OF ALL FORMATIONS, INCLUDING COAL ENCOUNTERED BY THE WELLBORE.

Signed:

By: Mark V. Leidecker

Date: 1/27/09

FEB 27 2009

OHIO 00540

Completion Data: Date of Completion 11/14/08

1). Peforated Interval	Amount of Fluid	Amount of 20/40 Sand	Injection Rate	Pressure
760-762	331 BBls	126 sks	13.8 BPM	2997
734-735	235 BBls	31 sks	12.4	2587
661-666	512 BBls	335 sks	15.7	1752

2). Well Log

Targets	Sub Sea	Depth
Bottom of Fill Dirt		0
Bottom of Pitts Coal	835	84
Top of Red Rock	597	322
Bottom of Red Rock	350	569
Top of Brush Creek Coal	381	538
Top of Upper Kittanning	230	689
Bottom of Upper Kittanning	226	693
Top of Middle Kittanning	189	730
Bottom of Middle Kittanning	187	732
Top of Lower Kittanning	147	772
Bottom of Lower Kittanning	145	774
TD	90	896