


**JACKSON SURVEYING
INC.**


2413 EAST PIKE ST. # 112
Clarksburg, WV 26301
304-623-5851

GRID NORTH
UTM, NAD83 DATUM, ZONE 17, US FT.

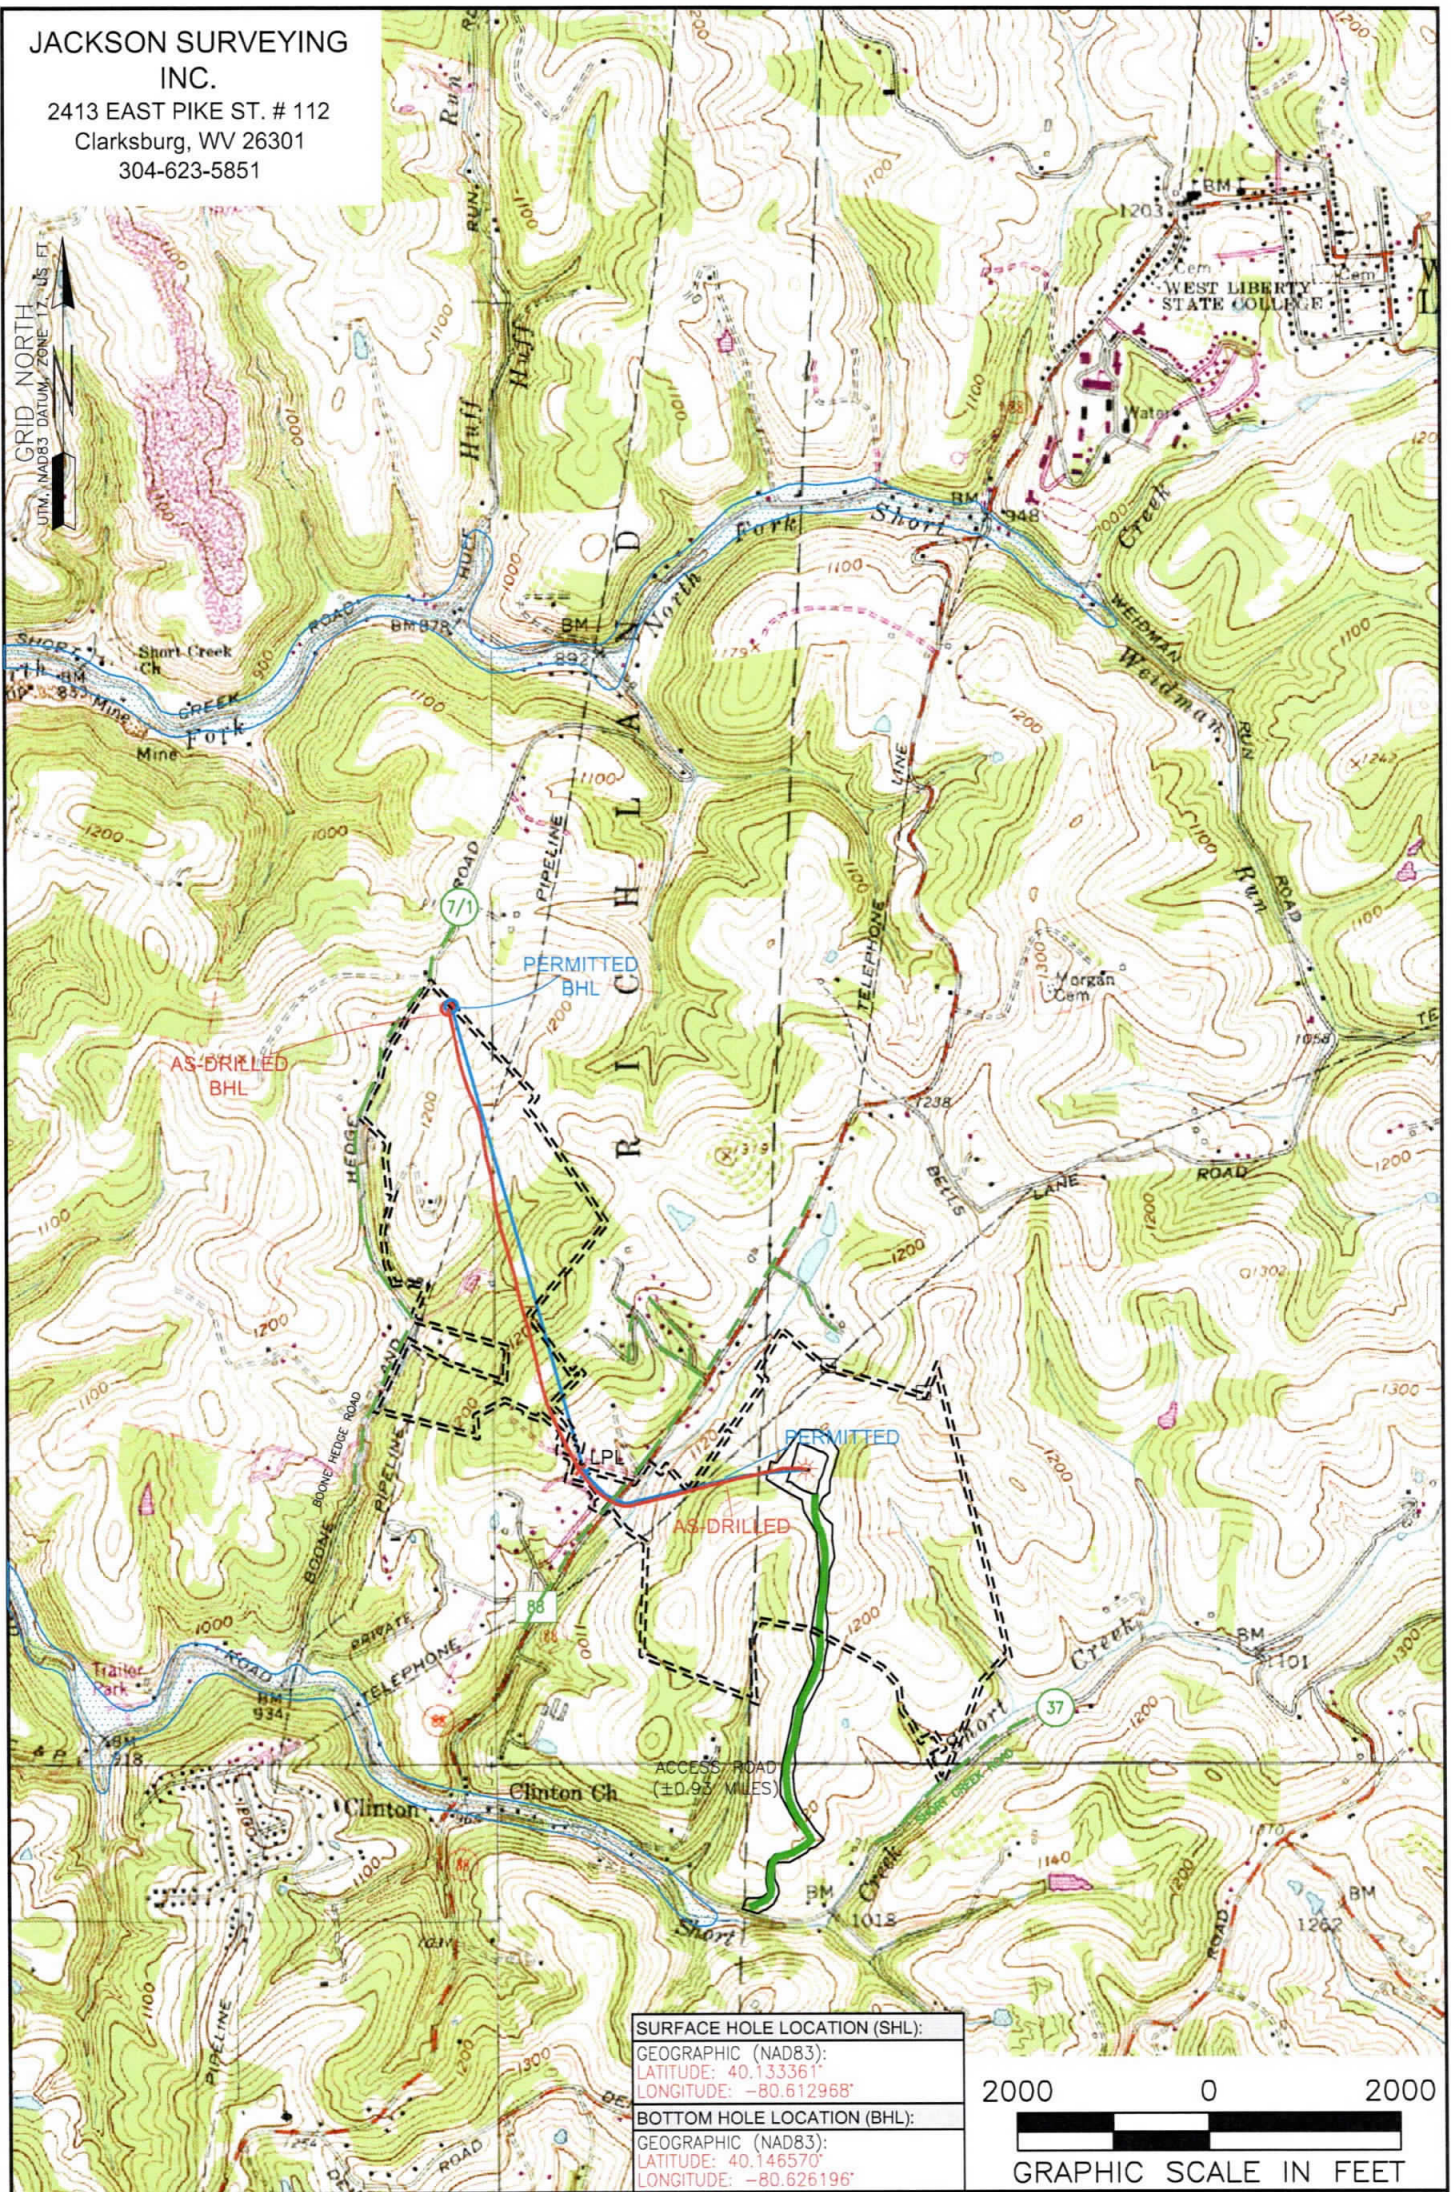

SURFACE HOLE LOCATION (SHL):
GEOGRAPHIC (NAD83):
LATITUDE: 40.133361°
LONGITUDE: -80.612968°

BOTTOM HOLE LOCATION (BHL):
GEOGRAPHIC (NAD83):
LATITUDE: 40.146570°
LONGITUDE: -80.626196°

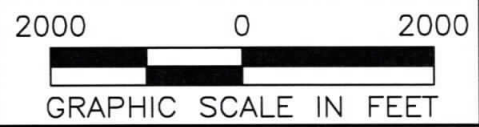

NOTES ON SURVEY

1. SURFACE AND ROYALTY OWNER INFORMATION AND THEIR BOUNDARIES SHOWN HEREON WERE PLOTTED FROM DEEDS AND/OR TAX PARCEL MAPS PROVIDED BY CLIENT AND/OR FIELD LOCATIONS.
2. THIS PLAT DOES NOT REPRESENT A BOUNDARY SURVEY OF THE PARCELS SHOWN HEREON.
4. ALL INSETS ARE GRID NORTH UNLESS OTHERWISE DEPICTED.

LEGEND:



- PROPOSED SURFACE HOLE / BOTTOM HOLE
- ⊗ EXISTING / PRODUCING WELLHEAD
- LPL* LANDING POINT LOCATION
- 🌊 FLOOD PLAIN
- ACCESS ROAD
- - - PUBLIC ROAD
- ACCESS ROAD TO PREV. SITE
- == LEASE BOUNDARY
- PROPOSED PATH
- ASDRILLED PATH

WELL OPERATOR: SWN PRODUCTION COMPANY, LLC	WELL (FARM) NAME: DALLAS HALL OHI	WELL # 201H	SERIAL #
ADDRESS: 1300 FORT PIERPONT RD. SUITE 200 MORGANTOWN, WV 26508	COUNTY - CODE OHIO - 069	DISTRICT; LIBERTY	
SURFACE OWNER: AGNES L. HALL	USGS 7 1/2 QUADRANGLE MAP NAME BETHANY, WV	API # 047-069-00283	

**JACKSON SURVEYING
INC.**

2413 EAST PIKE ST. # 112
Clarksburg, WV 26301
304-623-5851



REVISIONS:	COMPANY:		 	
	OPERATOR'S	DALLAS HALL OHI	API NUMBER:	DATE: 07-09-2019
	WELL #:	201H	47-069-00283	DRAWN BY: N. MANO
	DISTRICT:	COUNTY:	STATE:	SCALE: N/A
	LIBERTY	OHIO	WV	DRAWING NO: WELL LOCATION PLAT 2



**JACKSON SURVEYING
INC.**

2413 EAST PIKE ST. # 112
Clarksburg, WV 26301
304-623-5851

WELL BORE TABLE FOR SURFACE / ROYALTY OWNERS		
TRACT	SURFACE OWNER (S) / ROYALTY OWNER (R)	TAX PARCEL
1	AGNUS J. HALL (S/R)	03-L7-19
TRACT	SURFACE OWNER	TAX PARCEL
2	AGNUS J. HALL (S)	03-L7-21.1
3	KEITH D. CASTLE & AMANDA M. CASTLE (S)	04-R12B-1.9
4	DAVID N. CASTLE & RITE A. CASTLE (S)	04-R12B-1.3
5	MATTHEW M. WINE (S)	04-R12-19.19
6	THE DELORES M. FEDORKA TRUST 1993 (S)	04-R12-19.49
7	LUKA A. SHORT & JENNIFER L. KUCERA SHORT (S)	04-R12-19.20
8	SUSAN K. KUBOVICZ (S)	04-R12-19.23
9	JEFFREY M. KNIGHT & KRISTEN M. KNIGHT (S)	04-R12-19.26
10	VIRGINIA S. STERN (S)	04-R12B-10.8
11	VIRGINIA S. STERN (S)	04-R12B-10.9
12	ANDREW HOWARD (S)	04-R12B-10.10
13	GAVIN O. RICKETTS (S)	04-R12B-10.3
14	BRADFORD HARTLEY & NANNETTA HARTLEY	04-R9-1.3
15	RCK 2 GROUP, LLC	04-R9-01
16	RCK 2 GROUP, LLC	04-R9-27
17	LA DONNA MARTIN EVANS	04-R9-3.5
18	WESBANCO TRUST & INVESTMENT SERVICE	04-R9-16.1

ADJOINING OWNERS TABLE		
TRACT	SURFACE OWNER	TAX PARCEL
A	WHITAKER REVOCABLE FAMILY TRUST	03-L7-27
B	AGNES L. HALL	03-L7-20
C	AGNES L. HALL	03-L7-01
D	AGNES L. HALL	03-L7-21
E	MELISSA MEALY & JENNA FAUBER	04-R12-39
F	JOHN P. WETTY	04-R12-35
G	THE DELORES M. FEDORKA TRUST 1993	04-R12-19.48
H	THE DELORES M. FEDORKA TRUST 1993	04-R12-19.16
I	DEANA M. EDGMON	04-R12-19.18
J	ALEX J. GRUBER	04-R12-19.40
K	BRIAN S. BAKAITIS	04-R12-19.24
L	RALPH I. JAMES & CLARA L. JAMES	04-R12B-10.14
M	EUSEBIO ELVESTROM RODRIGUEZ	04-R12B-10.2
N	BRADFORD & NANNETTA HARTLEY	04-R9-1.4
O	BRADFORD & NANNETTA HARTLEY	04-R9-1.2
P	DOMINIC J. & SHERRIE D. COTTRELL	04-R12-19.34
Q	DOMINIC J. & SHERRIE D. COTTRELL	04-R12-19.30
R	TUNNEL RIDGE LLC	04-R8-61.4
S	GREGORY TAGGART	04-R9-50
T	WILLIAM H. & C. L. REUTHER	04-R9-2
U	BETH ANNE KENNEDY	04-R9-3.4
V	WILLIAM ISAAC KNIGHT & MEREDITH SERTICH	04-R9-3.7
W	LEWIS R. HOPKINS, JR & R. F. HOPKINS	04-R9-3.3
X	LEWIS R. HOPKINS, JR. & R. HOPKINS	04-R9-4
Y	LEWIS R. HOPKINS, JR. & ROSEANN HOPKINS	04-R9-8
Z	LOGAN E. HOPKINS	04-R9-5.2
AA	MARK W. & D. L. KETTLER	04-R9-7
BB	NICHOLAS P. KLAMUT	04-R9-12
CC	JORDAN & GAYLE WEBER	04-R9-9

ADJOINING OWNERS TABLE		
TRACT	SURFACE OWNER	TAX PARCEL
DD	CLAIRE M. CAENEY	04-R9-3
EE	LILLIAN W BROWN, TRUST	03-L4-1.1
FF	CLARK & SHARON L PAJAK	04-R9-28
GG	JUDY K JOHNSON	04-R9-29
HH	MARY ANN HART	04-R9-29.1
II	DONALD P & M E HUGHES	04-R9-32
JJ	WILLIAM J & SUSAN M GREATHOUSE	04-R12B-10.7
KK	JOSEPH R & KAY L CLAWSON	04-R12B-10.13
LL	RONALD J. FECCA & J L CHAMBERS	04-R12B-10.4
MM	JAMES & JOANNE CROFT	04-R12B-10.11
NN	JAMES E & J.J. CROFT	04-R12-36
OO	VIRGINIA S STERN	04-R12B-10.1
PP	JAMES B & B J STONEKING	04-R12B-10.5
QQ	FRANK A & C L B HOTLOSZ	04-R12B-10.6
RR	JOSEPH MICHAEL BAKER	04-R12-36.5
SS	JOSEPH S & S P CARTISANO	04-R12-36.4
TT	DOUGLAS J & JAMIE S ERNEST	04-R12B-1.2
UU	JOHN R. PYLE, SR. & T.A. PYLE	04-R12B-1.1
VV	STEVE KELLAS	04-R12B-1.5
WW	MATHEW H. GOSSETT	04-R12B-1
XX	GEORGE STROMATOS	03-L4-24
YY	GEORGE STROMATOS	03-L4-24.1
ZZ	GEORGE STROMATOS	03-L4-24.2
AAA	DAVID G. RUTHERS & LINDA F. RUTHERS	03-L4-22
BBB	YE M. HLA & EI E. MYINT	03-L4-20
CCC	DAVID M. WEAVER & BETH R. WEAVER	03-L4-15
DDD	CATHERINE EVANS & DAVID EVANS	03-L4-13.1
EEE	MARY HELEN CLISER, TRUSTEE	03-L7-02

REVISIONS:	COMPANY:	 		
	OPERATOR'S	DALLAS HALL OHI	API NUMBER:	DATE: 07-09-2019
	WELL #:	201H	47-069-00283	DRAWN BY: N. MANO
	DISTRICT:	LIBERTY	COUNTY:	SCALE: N/A
			STATE:	DRAWING NO:
			WV	WELL LOCATION PLAT 3