

State of West Virginia  
Department of Environmental Protection - Office of Oil and Gas  
Well Operator's Report of Well Work

API 47 - 069 - 00370 County Ohio District Richland  
Quad Tiltonsville Pad Name Franz Thoman Field/Pool Name Appalachia South  
Farm name Franz Thoman OHI Well Number 6H  
Operator (as registered with the OOG) SWN Production Company LLC  
Address PO Box 12359 City Spring State TX Zip 77391

As Drilled location NAD 83/UTM Attach an as-drilled plat, profile view, and deviation survey  
Top hole Northing 4,442,984.28 Easting 528,961.26  
Landing Point of Curve Northing 4,442,871.46 Easting 528,738.96  
Bottom Hole Northing 4,437,652.15 Easting 530,847.94

Elevation (ft) 1,137 GL Type of Well ☒ New ☐ Existing Type of Report ☐ Interim ☒ Final  
Permit Type ☐ Deviated ☒ Horizontal ☐ Horizontal 6A ☐ Vertical Depth Type ☐ Deep ☒ Shallow  
Type of Operation ☐ Convert ☐ Deepen ☒ Drill ☐ Plug Back ☐ Redrilling ☐ Rework ☒ Stimulate  
Well Type ☐ Brine Disposal ☐ CBM ☒ Gas ☐ Oil ☐ Secondary Recovery ☐ Solution Mining ☐ Storage ☐ Other \_\_\_\_\_  
Type of Completion ☒ Single ☐ Multiple Fluids Produced ☐ Brine ☒ Gas ☐ NGL ☐ Oil ☐ Other \_\_\_\_\_  
Drilled with ☐ Cable ☒ Rotary


Drilling Media Surface hole ☒ Air ☐ Mud ☒ Fresh Water Intermediate hole ☒ Air ☐ Mud ☐ Fresh Water ☐ Brine  
Production hole ☒ Air ☒ Mud ☐ Fresh Water ☐ Brine  
Mud Type(s) and Additive(s)  
SOBM

Date permit issued 2024-08-24 Date drilling commenced 2024-12-17 Date drilling ceased 2024-12-28  
Date completion activities began 2025-02-24 Date completion activities ceased 2025-03-18  
Verbal plugging (Y/N) N Date permission granted N/A Granted by N/A

Please note: Operator is required to submit a plugging application within 5 days of verbal permission to plug

Freshwater depth(s) ft 327 Open mine(s) (Y/N) depths N  
Salt water depth(s) ft 471 Void(s) encountered (Y/N) depths N  
Coal depth(s) ft 334 Cavern(s) encountered (Y/N) depths N  
Is coal being mined in area (Y/N) N

Reviewed by:

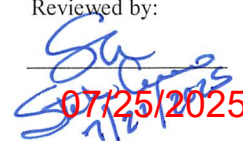  
07/25/2025

RECEIVED  
Office of Oil and Gas  
JUL 14 2025

APPROVED  
WV Department of  
Environmental Protection

API 47- 069 - 00370 Farm name Franz Thoman OHI Well number 6H

| CASING STRINGS            | Hole Size | Casing Size | Depth  | New or Used | Grade wt/ft | Basket Depth(s) | Did cement circulate (Y/ N)<br>* Provide details below* |
|---------------------------|-----------|-------------|--------|-------------|-------------|-----------------|---------------------------------------------------------|
| Conductor                 | 20.000    | 20.000      | 136    |             | J-55/94.00  |                 | Y                                                       |
| Surface                   | 17.500    | 13.375      | 424    |             | J-55/54.50  |                 | Y                                                       |
| Coal                      |           |             |        |             |             |                 |                                                         |
| Intermediate 1            | 12.250    | 9.625       | 1,758  |             | J-55/36.00  |                 | Y                                                       |
| Intermediate 2            |           |             |        |             |             |                 |                                                         |
| Intermediate 3            |           |             |        |             |             |                 |                                                         |
| Production                | 8.500     | 5.500       | 24,842 |             | P-110/20.00 |                 | Y                                                       |
| Tubing                    |           |             |        |             |             |                 |                                                         |
| Packer type and depth set |           |             |        |             |             |                 |                                                         |

Comment Details \_\_\_\_\_

| CEMENT DATA    | Class/Type of Cement | Number of Sacks  | Slurry wt (ppg) | Yield (ft <sup>3</sup> /sks) | Volume (ft <sup>3</sup> ) | Cement Top (MD) | WOC (hrs) |
|----------------|----------------------|------------------|-----------------|------------------------------|---------------------------|-----------------|-----------|
| Conductor      | Class A              | Grout to Surface |                 |                              |                           | Surface         | 24        |
| Surface        | Class A              | 189              | 15.6            | 1.19                         | 0                         | Surface         | 8         |
| Coal           |                      |                  |                 |                              |                           |                 |           |
| Intermediate 1 | Class A              | 721              | 15.6            | 1.18                         | 0                         | Surface         | 8         |
| Intermediate 2 |                      |                  |                 |                              |                           |                 |           |
| Intermediate 3 |                      |                  |                 |                              |                           |                 |           |
| Production     | Class A              | 4,801            | 14.5            | 1.26                         | 0                         | Surface         | 24        |
| Tubing         |                      |                  |                 |                              |                           |                 |           |

Drillers TD (ft) 24,842 Loggers TD (ft) 24,842

Deepest formation penetrated Marcellus Plug back to (ft) \_\_\_\_\_

Plug back procedure N/A

Kick off depth (ft) \_\_\_\_\_

Check all wireline logs run ☒ caliper ☒ density ☒ deviated/directional ☐ induction  
☒ neutron ☒ resistivity ☐ gamma ray ☒ temperature ☐ sonic

Well cored ☐ Yes ☒ No Conventional Sidewall Were cuttings collected ☐ Yes ☒ No

DESCRIBE THE CENTRALIZER PLACEMENT USED FOR EACH CASING STRING \_\_\_\_\_

SURFACE: CENTRALIZERS - EVERY THIRD JOINT OF CASING

INTERMEDIATE: CENTRALIZERS - EVERY THIRD JOINT OF CASING

PRODUCTION: CENTRALIZERS - EVERY THIRD JOINT FROM SURFACE TO TOP OF CURVE, THEN EVERY JOINT UNTIL TD

WAS WELL COMPLETED AS SHOT HOLE ☐ Yes ☒ No DETAILS \_\_\_\_\_

WAS WELL COMPLETED OPEN HOLE? ☐ Yes ☒ No DETAILS \_\_\_\_\_

WERE TRACERS USED ☐ Yes ☒ No TYPE OF TRACER(S) USED \_\_\_\_\_

07/25/2025

API 47- 069 - 00370 Farm name Franz Thoman OHI Well number 6H

## PERFORATION RECORD

[illegible]

Please insert additional pages as applicable.

### STIMULATION INFORMATION PER STAGE

Complete a separate record for each stimulation stage.

[illegible]

Please insert additional pages as applicable.

07/25/2025



LATITUDE: 40°10'00" SURFACE HOLE (2000' SCALE)

9791'



LATITUDE: 40°05'00" BOTTOM HOLE (2000' SCALE)

3674'



844-542-4757  
68011 VINEYARD RD  
ST. CLAIRSVILLE, OH 43950  
PA • OH • NY • WV • VA • MD

### WELL LAYOUT

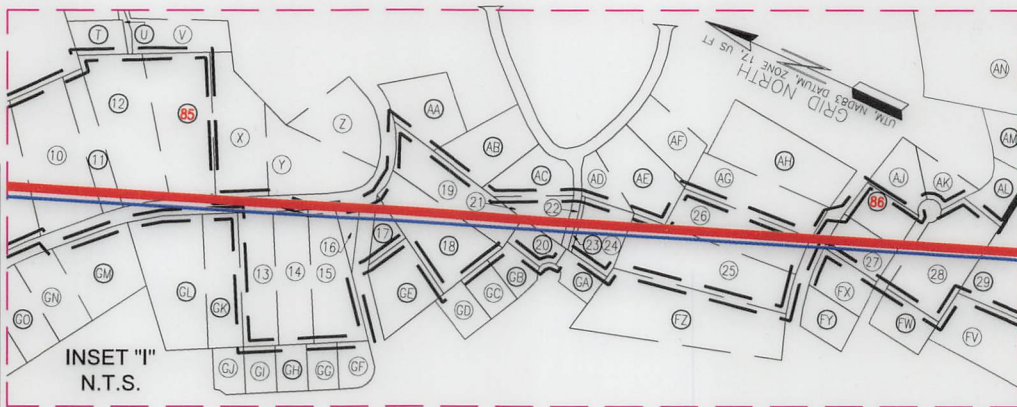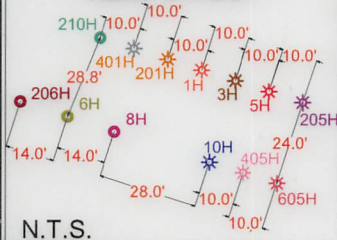


INSET "I"  
N.T.S.

### NOTES ON SURVEY

1. COORDINATE SYSTEM IS UTM NAD 83 DATUM, ZONE 17, U.S. FOOT AND WELL COORDINATES ESTABLISHED USING SURVEY GRADE GPS.
2. SURFACE AND ROYALTY OWNER INFORMATION AND THEIR BOUNDARIES SHOWN HEREON WERE PLOTTED FROM DEEDS AND/OR TAX PARCEL MAPS PROVIDED BY CLIENT AND/OR FIELD LOCATIONS.
3. THIS PLAT DOES NOT REPRESENT A BOUNDARY SURVEY OF THE PARCELS SHOWN HEREON.
4. NO DWELLINGS OR BUILDINGS WITHIN 625 FEET OF PROPOSED CENTER OF PAD.
5. NO PERENNIAL STREAMS, LAKES, PONDS, RESERVOIRS OR WETLANDS WITHIN 100 FEET OF THE LIMITS OF DISTURBANCE.
6. NO NATURALLY PRODUCING TROUT STREAM WITHIN 300 FEET OF THE LIMITS OF DISTURBANCE.
7. NO WATER WELLS OR DEVELOPED SPRINGS WITHIN 250 FEET OF PROPOSED WELL.

EXISTING WELLS  
WITHIN 3000'  
SCALE: 1"=3000'

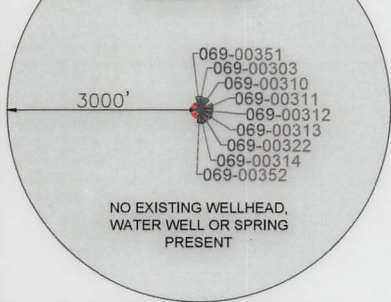

|                                      |
|--------------------------------------|
| <b>SURFACE HOLE LOCATION (SHL):</b>  |
| UTM (NAD83, ZONE 17, METERS):        |
| NORTHING: 4442984.28                 |
| EASTING: 528961.26                   |
| <b>LANDING POINT LOCATION (LPL):</b> |
| UTM (NAD83, ZONE 17, METERS):        |
| NORTHING: 4442871.46                 |
| EASTING: 528738.96                   |
| <b>BOTTOM HOLE LOCATION (BHL):</b>   |
| UTM (NAD83, ZONE 17, METERS):        |
| NORTHING: 4437652.15                 |
| EASTING: 530847.94                   |
| <b>SURFACE HOLE LOCATION (SHL):</b>  |
| UTM (NAD83, ZONE 17, METERS):        |
| NORTHING: 4442984.30                 |
| EASTING: 528961.30                   |
| <b>LANDING POINT LOCATION (LPL):</b> |
| UTM (NAD83, ZONE 17, METERS):        |
| NORTHING: 4442879.82                 |
| EASTING: 528734.95                   |
| <b>BOTTOM HOLE LOCATION (BHL):</b>   |
| UTM (NAD83, ZONE 17, METERS):        |
| NORTHING: 4437651.01                 |
| EASTING: 530845.48                   |

I, THE UNDERSIGNED, HEREBY CERTIFY THAT THIS PLAT IS CORRECT TO THE BEST OF MY KNOWLEDGE AND BELIEF AND SHOWS ALL THE INFORMATION REQUIRED BY LAW AND REGULATIONS ISSUED AND PRESCRIBED BY THE DEPARTMENT OF ENVIRONMENTAL PROTECTION.


P.E. 19809

(+) DENOTES LOCATION OF WELL ON UNITED STATES TOPOGRAPHIC MAPS

WVDEP  
OFFICE OF OIL & GAS  
601 57TH STREET  
CHARLESTON, WV 25034

MINIMUM  
DEGREE OF  
ACCURACY: 1/200

PROVEN SURVEY  
SOURCE OF GRADE GPS  
ELEVATION: (NAVD 88, US FT)

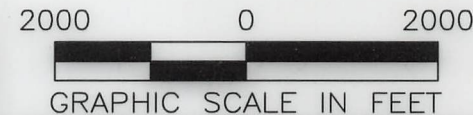

COMPANY: **SWN** **SWN** **SWN**  
Production Company, LLC Production Company™

FRANZ THOMAN OHI  
OPERATOR'S WELL #: 6H  
API WELL #: 47 069 00370  
STATE COUNTY PERMIT

WELL TYPE: OIL ☐ WASTE DISPOSAL ☐ PRODUCTION ☒ DEEP ☐ GAS ☒ LIQUID INJECTION ☐ STORAGE ☐ SHALLOW ☒  
WATERSHED: UPPER OHIO SOUTH  
DISTRICT: RICHLAND COUNTY: OHIO  
SURFACE OWNER: FRANZ THOMAN  
OIL & GAS ROYALTY OWNER: FRANZ THOMAN  
DRILL ☐ DRILL DEEPER ☐ REDRILL ☐ FRACTURE OR STIMULATE ☐ PLUG OFF OLD FORMATION ☐ PERFORATE NEW FORMATION ☐  
CONVERT ☐ PLUG & ABANDON ☐ CLEAN OUT & REPLUG ☐ OTHER CHANGE ☒ (SPECIFY) AS-DRILLED  
TARGET FORMATION: MARCELLUS  
ELEVATION: 1,137.2'  
QUADRANGLE: TILTONSVILLE & WHEELING, OH-WV  
ACREAGE: ±69.418  
ACREAGE: ±69.418  
ESTIMATED DEPTH: 6,082' TVD 24,842' TMD

WELL OPERATOR: SWN PRODUCTION COMPANY, LLC  
ADDRESS: 1300 FORT PIERPONT DRIVE, SUITE 201  
CITY: MORGANTOWN STATE: WV ZIP CODE: 26508  
DESIGNATED AGENT: BRITTANY WOODY  
ADDRESS: 1300 FORT PIERPONT DRIVE, SUITE 201  
CITY: MORGANTOWN STATE: WV ZIP CODE: 26508

|                                     |                   |                         |
|-------------------------------------|-------------------|-------------------------|
| <b>LEGEND:</b>                      | <b>REVISIONS:</b> | <b>DATE:</b> 02-24-2025 |
| EXISTING BOTTOM HOLE                | ACCESS ROAD       | API NO: 47-069-00370    |
| EXISTING / PRODUCING WELLHEAD       | PUBLIC ROAD       | DRAWN BY: Z.WOOD        |
| EXISTING LANDING POINT LOCATION     | FLOOD PLAIN       | SCALE: 1" = 2000'       |
| PROPOSED SURFACE HOLE / BOTTOM HOLE | LEASE BOUNDARY    | DRAWING NO: 2018-781    |
| PROPOSED LANDING POINT LOCATION     | AS-DRILLED PATH   | WELL LOCATION PLAT      |
|                                     | PROPOSED PATH     |                         |



10240  
13537

07/25/2025



LATITUDE: 40°10'00" SURFACE HOLE (2000' SCALE)

9791'


LATITUDE: 40°05'00" BOTTOM HOLE (2000' SCALE)

3674'




844-542-4757  
68011 VINEYARD RD  
ST. CLAIRSVILLE, OH 43950  
PA • OH • NY • WV • VA • MD

| LINE | BEARING     | DISTANCE |
|------|-------------|----------|
| L1   | N55°49'57"W | 1085.30' |
| L2   | N80°20'50"W | 1341.65' |

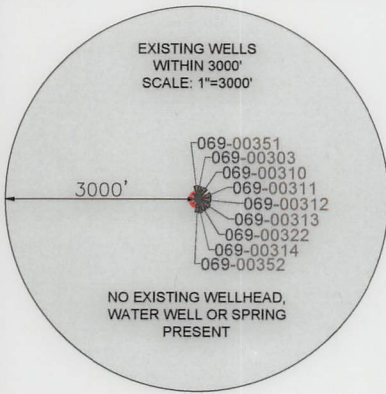


GRID NORTH  
UTM, NAD83 DATUM, ZONE 17, US FT

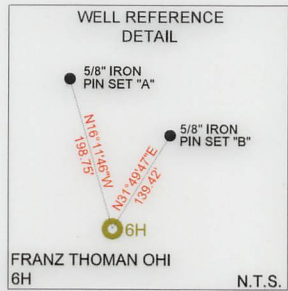

NOTES ON SURVEY

1. COORDINATE SYSTEM IS UTM NAD 83 DATUM, ZONE 17, U.S. FOOT AND WELL COORDINATES ESTABLISHED USING SURVEY GRADE GPS.
2. SURFACE AND ROYALTY OWNER INFORMATION AND THEIR BOUNDARIES SHOWN HEREON WERE PLOTTED FROM DEEDS AND/OR TAX PARCEL MAPS PROVIDED BY CLIENT AND/OR FIELD LOCATIONS.
3. THIS PLAT DOES NOT REPRESENT A BOUNDARY SURVEY OF THE PARCELS SHOWN HEREON.
4. NO DWELLINGS OR BUILDINGS WITHIN 625 FEET OF PROPOSED CENTER OF PAD.
5. NO PERENNIAL STREAMS, LAKES, PONDS, RESERVOIRS OR WETLANDS WITHIN 100 FEET OF THE LIMITS OF DISTURBANCE.
6. NO NATURALLY PRODUCING TROUT STREAM WITHIN 300 FEET OF THE LIMITS OF DISTURBANCE.
7. NO WATER WELLS OR DEVELOPED SPRINGS WITHIN 250 FEET OF PROPOSED WELL.

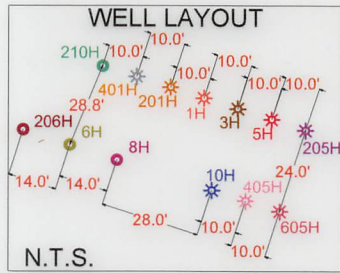

|   |
|---|
| <b>SURFACE HOLE LOCATION (SHL):</b><br>UTM (NAD83, ZONE 17, METERS):<br>NORTHING: 4442984.28<br>EASTING: 528961.26  |
| <b>LANDING POINT LOCATION (LPL):</b><br>UTM (NAD83, ZONE 17, METERS):<br>NORTHING: 4442871.46<br>EASTING: 528738.96 |
| <b>BOTTOM HOLE LOCATION (BHL):</b><br>UTM (NAD83, ZONE 17, METERS):<br>NORTHING: 4437652.15<br>EASTING: 530847.94   |
| <b>SURFACE HOLE LOCATION (SHL):</b><br>UTM (NAD83, ZONE 17, METERS):<br>NORTHING: 4442984.30<br>EASTING: 528961.30  |
| <b>LANDING POINT LOCATION (LPL):</b><br>UTM (NAD83, ZONE 17, METERS):<br>NORTHING: 4442879.82<br>EASTING: 528734.95 |
| <b>BOTTOM HOLE LOCATION (BHL):</b><br>UTM (NAD83, ZONE 17, METERS):<br>NORTHING: 4437651.01<br>EASTING: 530845.48   |

I, THE UNDERSIGNED, HEREBY CERTIFY THAT THIS PLAT IS CORRECT TO THE BEST OF MY KNOWLEDGE AND BELIEF AND SHOWS ALL THE INFORMATION REQUIRED BY LAW AND REGULATIONS ISSUED AND PRESCRIBED BY THE DEPARTMENT OF ENVIRONMENTAL PROTECTION.

P.E. 19809








2000 0 2000

GRAPHIC SCALE IN FEET

COMPANY: **SWN** **SWN** <sup>PA-V+O</sup>  
Production Company, LLC Production Company™

|   |   |                                                                                              |
|---|---|----------------------------------------------------------------------------------------------|
| <br>WVDEP<br>OFFICE OF OIL & GAS<br>601 57TH STREET<br>CHARLESTON, WV 25034 | MINIMUM DEGREE OF ACCURACY: 1/200<br>PROVEN SURVEY GRADE GPS ELEVATION: (NAVD 88, US FT)   | FRANZ THOMAN OHI<br>OPERATOR'S WELL #: 6H<br>API WELL #: 47 069 00370<br>STATE COUNTY PERMIT |
|   | WELL TYPE: OIL <input type="checkbox"/> WASTE DISPOSAL <input type="checkbox"/> PRODUCTION <input checked="" type="checkbox"/> DEEP <input type="checkbox"/> GAS <input checked="" type="checkbox"/> LIQUID INJECTION <input type="checkbox"/> STORAGE <input type="checkbox"/> SHALLOW <input checked="" type="checkbox"/><br>WATERSHED: UPPER OHIO SOUTH<br>DISTRICT: RICHLAND COUNTY: OHIO<br>SURFACE OWNER: FRANZ THOMAN<br>OIL & GAS ROYALTY OWNER: FRANZ THOMAN<br>ELEVATION: 1,137.2'<br>QUADRANGLE: TILTONSVILLE & WHEELING, OH-WV<br>ACREAGE: ±69.418<br>ACREAGE: ±69.418<br>DRILL <input type="checkbox"/> DRILL DEEPER <input type="checkbox"/> REDRILL <input type="checkbox"/> FRACTURE OR STIMULATE <input type="checkbox"/> PLUG OFF OLD FORMATION <input type="checkbox"/> PERFORATE NEW FORMATION <input type="checkbox"/><br>CONVERT <input type="checkbox"/> PLUG & ABANDON <input type="checkbox"/> CLEAN OUT & REPLUG <input type="checkbox"/> OTHER CHANGE <input checked="" type="checkbox"/> (SPECIFY) AS-DRILLED<br>TARGET FORMATION: MARCELLUS<br>ESTIMATED DEPTH: 6,082' TVD 24,842' TMD |                                                                                              |
     
|   |   |  |  |  |  |  |  |  |  |
|---|---|--|--|--|--|--|--|--|--|
| WELL OPERATOR: SWN PRODUCTION COMPANY, LLC<br>ADDRESS: 1300 FORT PIERPONT DRIVE, SUITE 201<br>CITY: MORGANTOWN STATE: WV ZIP CODE: 26508   | DESIGNATED AGENT: BRITTANY WOODY<br>ADDRESS: 1300 FORT PIERPONT DRIVE, SUITE 201<br>CITY: MORGANTOWN STATE: WV ZIP CODE: 26508   |  |  |  |  |  |  |  |  |
| <b>LEGEND:</b><br> EXISTING BOTTOM HOLE<br> EXISTING / PRODUCING WELLHEAD<br> EXISTING LANDING POINT LOCATION<br> PROPOSED SURFACE HOLE / BOTTOM HOLE<br> PROPOSED LANDING POINT LOCATION<br> ACCESS ROAD<br> PUBLIC ROAD<br> FLOOD PLAIN<br> LEASE BOUNDARY<br> AS-DRILLED PATH<br> PROPOSED PATH | <b>REVISIONS:</b><br><table><tr><td> </td><td> </td></tr><tr><td> </td><td> </td></tr><tr><td> </td><td> </td></tr><tr><td> </td><td> </td></tr></table><br>DATE: 02-24-2025<br>API NO: 47-069-00370<br>DRAWN BY: Z.WOOD<br>SCALE: 1" = 2000'<br>DRAWING NO: 2018-781<br>WELL LOCATION PLAT |  |  |  |  |  |  |  |  |
|   |   |  |  |  |  |  |  |  |  |
|   |   |  |  |  |  |  |  |  |  |
|   |   |  |  |  |  |  |  |  |  |
|   |   |  |  |  |  |  |  |  |  |


















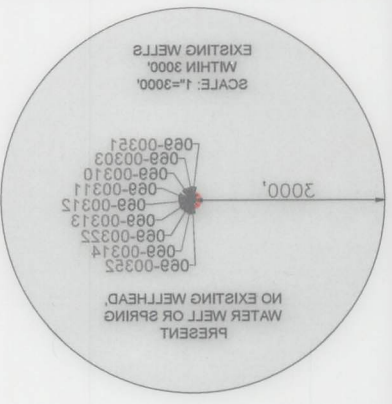

| LINE | BEARING     | DISTANCE |
|------|-------------|----------|

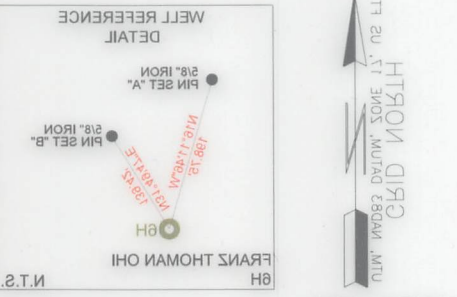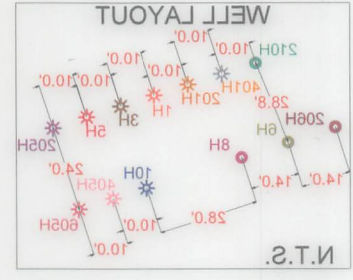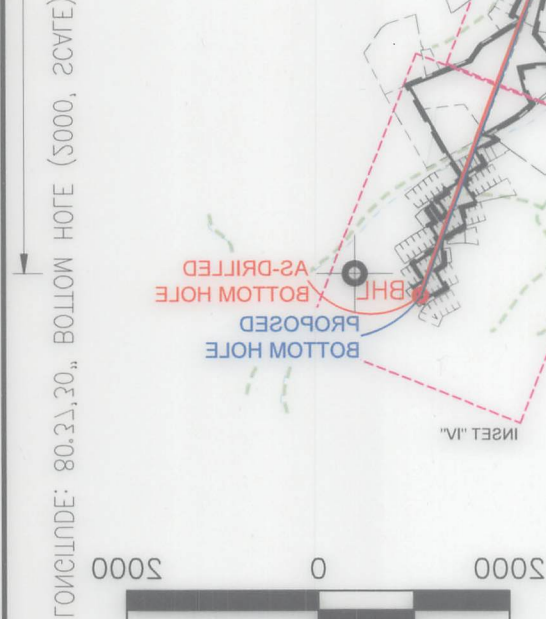







JHA  
ARCHITECTURE  
ENGINEERING  
SURVEYING  



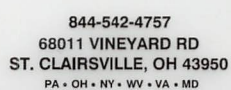

07/25/2025

REVISIONS:

COMPANY:

**SWN**  
Production Company, LLC

**SWN**  $\frac{R^2}{A} \rightarrow V^2$   
Production Company™

## OPERATOR'S

FRANZ THOMAN OHI

DATE: 02-24-2025

WELL #:

6H

API NO: 47-069-00370

DISTRICT:  
RICHLAND

COUNTY:  
OHIO

STATE:  
WV


DRAWN BY: Z.WOO  
SCALE: N/A

DRAWING NO:2018-781

WELL LOCATION PLAT




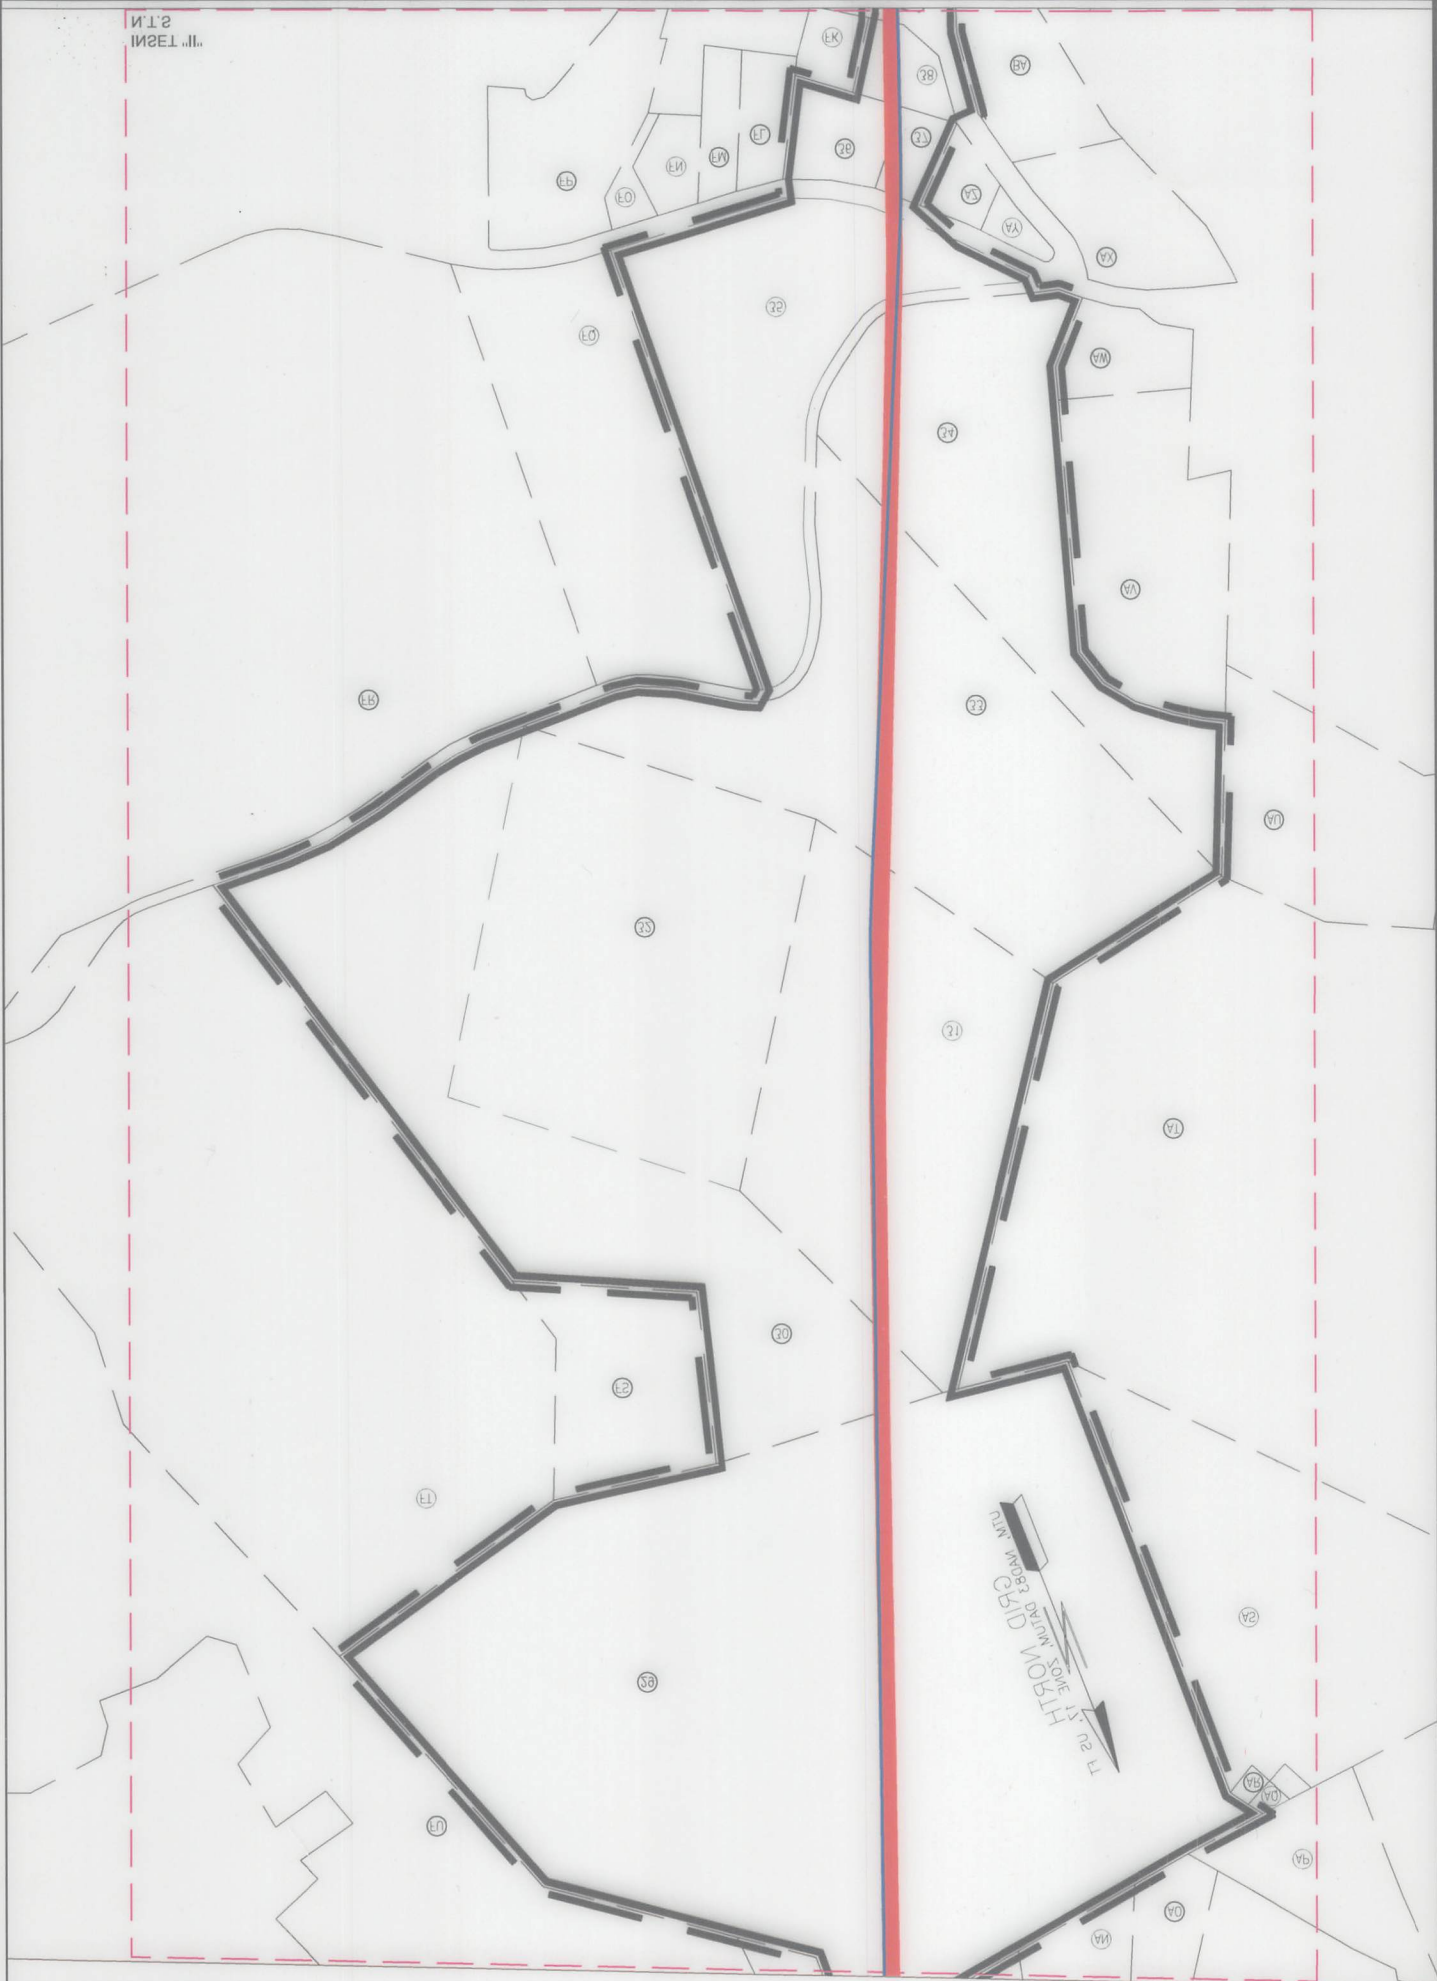

07/25/2025













844-542-4757  
68011 VINEYARD RD  
ST. CLAIRSVILLE, OH 43950  
PA • OH • NY • WV • VA • MD



07/25/2025

|            |                  |         |        |   |
|------------|------------------|---------|--------|---|
| REVISIONS: |                  |         |        | <div><div>SWN</div><div>Production Company, LLC</div></div> <div><div>SWN</div><div>Production Company™</div></div> <div><div><div><div></div><div>Rev</div><div>A</div></div><div><div></div><div>V</div><div>+</div></div><div><div></div><div>0</div><div></div></div></div></div> |
|            | COMPANY:         |         |        |   |
|            | OPERATOR'S       |         |        |   |
|            | WELL #:          |         |        |   |
|            | DISTRICT:        |         |        |   |
|            | FRANZ THOMAN OHI |         |        |   |
|            | 6H               |         |        |   |
|            | DISTRICT:        | COUNTY: | STATE: | DATE: 02-24-2025   |
|            | RICHLAND         | OHIO    | WV     | API NO: 47-069-00370   |
|            |                  |         |        | DRAWN BY: Z. WOOD   |
|            |                  |         |        | SCALE: N/A   |
|            |                  |         |        | DRAWING NO: 2018-781   |
|            |                  |         |        | WELL LOCATION PLAT   |



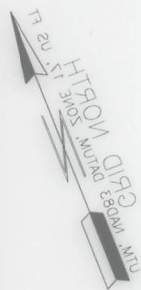

07/25/2025  
INSET III

REVISIONS:

COMPANY:

OPERATOR'S

WELL #:

DISTRICT:

FRANZ THOMAN OHI

OH

COUNTY:

STATE:

WV

SWN  
Production Company, LLC

Production Company, LLC




SCALE: N/A



DRAWING NO: 2018-781

WELL LOCATION PLAT





844-542-4757  
68011 VINEYARD RD  
ST. CLAIRSVILLE, OH 43950  
PA • OH • NY • WV • VA • MD

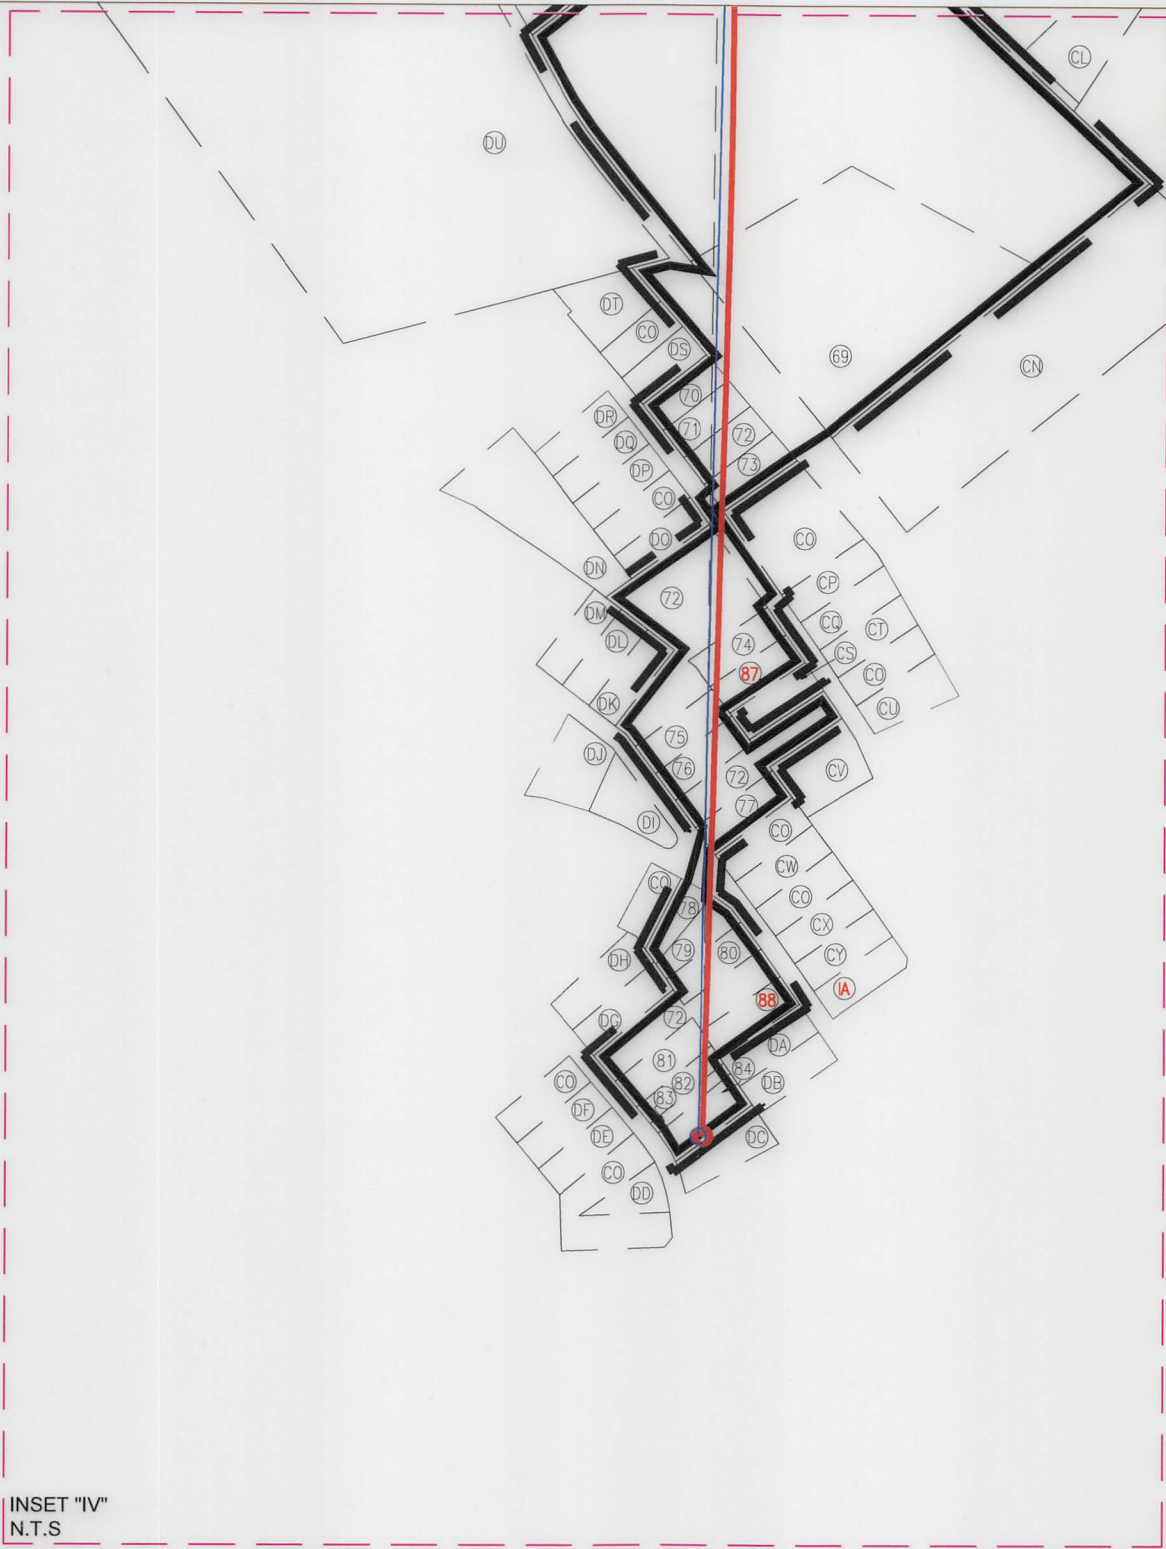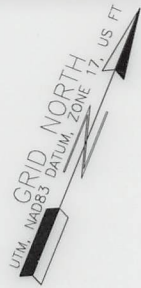


07/25/2025

|            |            |         |                      |                      |
|------------|------------|---------|----------------------|----------------------|
| REVISIONS: | COMPANY:   |         | DATE: 02-24-2025     |                      |
|            |            |         |                      |                      |
|            | OPERATOR'S |         | API NO: 47-069-00370 |                      |
|            |            |         |                      |                      |
|            | WELL #:    |         | DRAWN BY: Z.WOOD     |                      |
|            |            |         |                      |                      |
|            | DISTRICT:  |         | SCALE: N/A           |                      |
|            |            |         |                      |                      |
| RICHLAND   |            | COUNTY: | OHIO                 | STATE:               |
|            |            |         |                      | WV                   |
|            |            |         |                      | DRAWING NO: 2018-781 |
|            |            |         |                      | WELL LOCATION PLAT   |





844-845-4757  
68011 VINEYARD RD  
ST. CLAIRSVILLE, OH 43080  
PA • OH • NY • WV • VA • MD

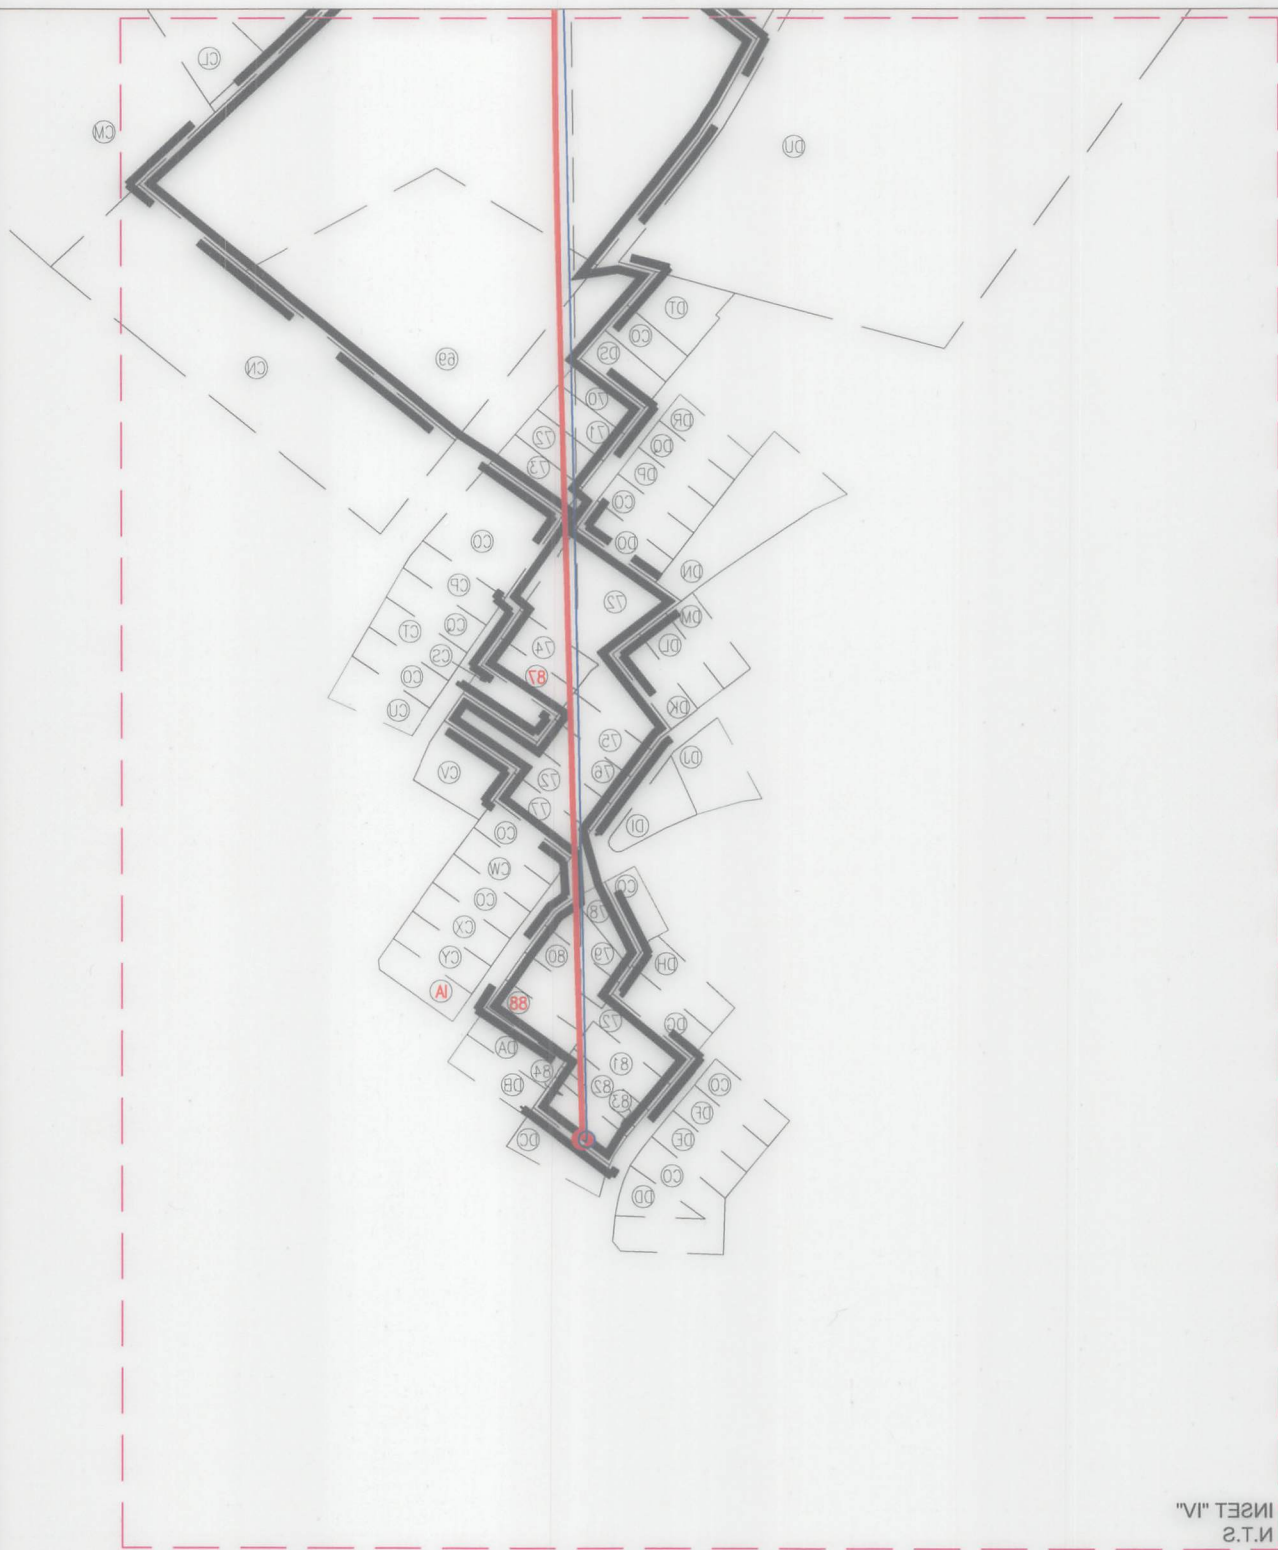

N.T.S.  
INSET "IV"

07/25/2025

REVISIONS:

COMPANY:

Production Company, LLC

swm

swm

Production Company, LLC

OPERATOR'S

FRANZ THOMAS OH

EN

WELL #:

DISTRICT:

RICHLAND

COUNTY:

OHIO

STATE:

WV



DRAWN BY: Z. WOOD

SCALE: N/A

DRAWING NO: 2018-781

WELL LOCATION PLAT



| WELL BORE TABLE FOR SURFACE/ROYALTY OWNERS |                                                            |             | TRACT                  | SURFACE OWNER                                          | TAX PARCEL  |
|--------------------------------------------|------------------------------------------------------------|-------------|------------------------|--------------------------------------------------------|-------------|
| TRACT                                      | SURFACE OWNER (S) / ROYALTY OWNER (R)                      | TAX PARCEL  | 66                     | RIDENHOUR LEA W                                        | 4-R14R-1.5  |
| 1                                          | THOMAN FRANZ (S) / (R)                                     | 4-R8-62     | 67                     | FELTON JOHN R & RHONDA                                 | 4-R14R-1.2  |
| TRACT                                      | SURFACE OWNER                                              | TAX PARCEL  | 68                     | OBRIEN SEAN P                                          | 4-R14-85    |
| 2                                          | TUNNEL RIDGE LLC                                           | 4-R8-62.4   | 69                     | OBRIEN FRANK & WHITNEY                                 | 4-R14-85.5  |
| 3                                          | TUNNEL RIDGE LLC                                           | 4-R8-62.5   | 70                     | FROHNAPFEL PATRICK A                                   | 4-R17D-132  |
| 4                                          | MOLNAR KRISTINE N                                          | 4-R11-13.1  | 71                     | ROBINSON RICHARD J                                     | 4-R17D-133  |
| 5                                          | MOLNAR KRISTINE N                                          | 4-R11-13.4  | 72                     | HUMWAY ROSE                                            | 4-R17D-81   |
| 6                                          | MOLNAR KRISTINE N                                          | 4-R11-16.4  | 73                     | NIZAMI SALEEM & DENITRA                                | 4-R17D-135  |
| 7                                          | STERN SHAWN G & AIMEE M                                    | 4-R11-16.13 | 74                     | CUNNINGHAM C S IRREV TRUST                             | 4-R17D-119  |
| 8                                          | KLOS MARIE A                                               | 4-R11-16    | 75                     | ADAMS FRANCES G II REVOCABLE TRUST                     | 4-R17D-88   |
| 9                                          | BONAWITZ PAMELA KORTH - TOD                                | 4-R11-16.16 | 76                     | ELBERT BREANNA                                         | 4-R17D-86   |
| 10                                         | SCHRAMM ALEXANDER M & ALESHIA M SCHRAMM                    | 4-R11-16.7  | 77                     | PALMER JORDAN V & MEGAN E                              | 4-R17D-84   |
| 11                                         | SCHRAMM ALEXANDER M & ALESHIA M SCHRAMM                    | 4-R11-16.17 | 78                     | WEST JEREMY                                            | 4-R17D-166  |
| 12                                         | PATTERSON MARY JANE - TOD                                  | 4-R11G-11   | 79                     | PAPPA LESLIE L; POCKL KIMBERLY & PAPPA GREGORY         | 4-R17D-165  |
| 13                                         | PORTER THOMAS E & LINDA A                                  | 4-R11G-8    | 80                     | PAPPA LESLIE L; POCKL KIMBERLY & PAPPA GREGORY         | 4-R17D-164  |
| 14                                         | JONES ROBERT C                                             | 4-R11G-7    | 81                     | BRYAN KATHLEEN J & BRYAN STELLA M                      | 4-R17D-199  |
| 15                                         | KOCHER LEWIS A & THERESA (LE); KOCHER DEREK L & JULIE KRON | 4-R11G-6    | 82                     | KAHLE GAIL W & ANN M                                   | 4-R17D-200  |
| 16                                         | KOCHER LEWIS A & THERESA (LE); KOCHER DEREK L & JULIE KRON | 4-R11G-6.1  | 83                     | THALMAN VICTORIA                                       | 4-R17D-201  |
| 17                                         | CUNNINGHAM ROBERT & JULIE                                  | 4-R11G-4.1  | 84                     | BRYAN KATHLEEN J & BRYAN STELLA M                      | 4-R17D-202  |
| 18                                         | CUNNINGHAM ROBERT W & JULIE D                              | 4-R11G-3    | 85                     | SCHRAMM ERIK A & S M                                   | 4-R11G-12   |
| 19                                         | CUPP ELI J & ASHLEY ELIZABETH                              | 4-R11G-2    | 86                     | KEEFER F JAY                                           | 4-R11L-43   |
| 20                                         | HUGHES JOSHUA KELLER                                       | 4-R11L-54   | 87                     | ULLOM REBECCA A                                        | 4-R17D-120  |
| 21                                         | HUGHES JOSHUA & KATIE                                      | 4-R11L-3.11 | 88                     | BRAUN EUGENE & M J                                     | 4-R17D-162  |
| 22                                         | DUSCI DAWN'RE                                              | 4-R11L-3.15 | ADJOINING OWNERS TABLE |                                                        |             |
| 23                                         | GLUSICH MARY ANN                                           | 4-R11L-3.17 | TRACT                  | SURFACE OWNER                                          | TAX PARCEL  |
| 24                                         | GLUSICH MARY ANN                                           | 4-R11L-3.9  | A                      | TAYLOR DELORA L - TOD                                  | 4-R8K-100   |
| 25                                         | PERRY CASEY PETERSON & IAN STEWART PERRY                   | 4-R11L-2    | B                      | SOBOTA SUSAN J                                         | 4-R8-62.3   |
| 26                                         | BURNSWORTH TIMOTHY J JR & T L                              | 4-R11L-4    | C                      | WRIGHT JOHN T & MELINDA L                              | 4-R8P-11    |
| 27                                         | HANNA JANE R - TOD                                         | 4-R11L-44   | D                      | SUTTON JACQUELINE M                                    | 4-R8Q-10    |
| 28                                         | KEEFER F JAY                                               | R11L-39     | E                      | DAGUE AMY D                                            | 4-R8Q-11    |
| 29                                         | WHEELING PARK COMMISSION                                   | 4-R11-21.5  | F                      | WHEELER JOLLY W JR & K M                               | 4-R8Q-14    |
| 30                                         | PARKS SYSTEM TRUST FUND OF WHEELING                        | R11-21.3    | G                      | TAROVISKY FRANK J & S R - TOD                          | 4-R8Q-28    |
| 31                                         | WHEELING PARK COMMISSION                                   | R11-21.4    | H                      | TOMASIK PAULA J & EDWARD C                             | 4-R8Q-3     |
| 32                                         | WHEELING PARK COMMISSION                                   | R14-91      | I                      | TERAMANA RUSSELL & ROSEANN                             | 4-R8Q-2     |
| 33                                         | WHEELING PARK COMMISSION                                   | R14-20.4    | J                      | HUFFMAN KENDRA L & RALPH J                             | 4-R8Q-60    |
| 34                                         | WHEELING PARK COMMISSION                                   | R14-20.2    | K                      | SANDCREST FOUNDATION INC                               | 4-R11-15    |
| 35                                         | WHEELING PARK COMMISSION                                   | R14-15.1    | L                      | SCHNEIDER CAROLYN JAN                                  | 4-R11G-30.1 |
| 36                                         | PARSONS SALLY W                                            | R14G-3      | M                      | WRIGHT TAMMY L                                         | 4-R11G-30   |
| 37                                         | HOSFELT WILLIAM J & PATRICIA HOSFELT ESTATES               | R14G-2      | N                      | FRANCIS CLAYTON M & HILARY B SMITH                     | 4-R11G-29   |
| 38                                         | VELLENOWETH WILLIAM O & LISA B                             | R14G-10.1   | O                      | CRUPE JUSTINE K & JOHN D                               | 4-R11G-28   |
| 39                                         | MCLAUGHLIN JEFFREY J & CAROL                               | R14G-12     | P                      | MILLER OLIVIA M                                        | 4-R11G-27   |
| 40                                         | ZELEK CHARLES & IRMA                                       | R14G-13     | Q                      | MYLES IVAN P JR & DEBORAH A                            | 4-R11G-25   |
| 41                                         | BANDI DANIEL A & B J                                       | R14G-14     | R                      | RAFA MATTHEW M                                         | 4-R11G-24   |
| 42                                         | WILSON SHAYNE & CLAIRE CARUSO                              | 4-R14H-33   | S                      | SCHRAMM ALEXANDER M & ALESHIA M SCHRAMM                | 4-R11-16.18 |
| 43                                         | WILSON SHAYNE & CLAIRE CARUSO                              | 4-R14-46.3  | T                      | MYLES IVAN P JR & D A                                  | 4-R11G-23   |
| 44                                         | NANNERS KENNETH C & S P                                    | 4-R14-46.14 | U                      | MYLES IVAN P JR & DEBORAH A                            | 4-R11G-26.1 |
| 45                                         | SCHREBE MATTHEW C & JORDEN L                               | 4-R14H-26   | V                      | PARSONS MATTHEW & REBECCA                              | 4-R11G-26.2 |
| 46                                         | MORANDO TYLER T & CAYLA S                                  | 4-R14H-25   | W                      | REMOVED                                                | REMOVED     |
| 47                                         | NANNERS STEPHANIE P                                        | 4-R14-46.5  | X                      | SUBIT ROGER B & E I                                    | 4-R11G-13   |
| 48                                         | NANNERS KENNETH C & S P                                    | 4-R14-46.2  | Y                      | CAMPBELL MATTHEW J & KATHLEEN; KASMIR A MAJEWSKI (RTO) | 4-R11G-15   |
| 49                                         | NANNERS BRADY CHARLES & TAYLOR STONER                      | 4-R14-46.23 | Z                      | CALDWELL WILLIAM K & P M                               | 4-R11G-14   |
| 50                                         | CHIU SERENA                                                | 4-R14H-16   | AA                     | JELLISON MYRON V & EMILY M                             | 4-R11G-37   |
| 51                                         | DIBARTOLOMEO CHAD M & BRANDY A MORGAN                      | 4-R14M-21   | AB                     | CAMILLETTI LOUISE                                      | 4-R11L-3.12 |
| 52                                         | AARON WAY IMPROVEMENT ASSN INC                             | 4-R14H-37   | AC                     | MCKEE ELIZABETH M                                      | 4-R11L-3.10 |
| 53                                         | DIBARTOLOMEO CHAD M & BRANDY A MORGAN                      | 4-R14M-34   | AD                     | HUGHES JOSHUA KELLER                                   | 4-R11L-3.14 |
| 54                                         | PETROPLUS WILLIAM G & S A                                  | 4-R14M-30   | AE                     | KURELAC JESSICA & PETER P III                          | 4-R11L-3.5  |
| 55                                         | PETROPLUS WILLIAM G & SHEREE A                             | 4-R14M-23   | AF                     | DODD CHARLES & ERIN                                    | 4-R11L-3.4  |
| 56                                         | BROWN JONATHAN D & CHRISTINA M                             | 4-R14M-27   | AG                     | GRUBER GEARY J                                         | 4-R11L-5    |
| 57                                         | BROWN JONATHAN D & CHRISTINA M                             | 4-R14M-32   | AH                     | ADAMS SHAYE L                                          | 4-R11L-6    |
| 58                                         | MARTINELLI ANTHONY W & MICHELLE R                          | 4-R14-46.10 | AI                     | REMOVED                                                | REMOVED     |
| 59                                         | GRIFFITH DOROTHY V                                         | 4-R14M-2    | AJ                     | KEEFER F JAY                                           | 4-R11L-42   |
| 60                                         | TIU CHRISTOPHER & DANA K                                   | 4-R14-46.18 | AK                     | KEEFER F JAY                                           | 4-R11L-41   |
| 61                                         | DAMANT VIRGINIA GRIFFITH & GRIFFITH BEVERLY LYNN           | 4-R14M-2.2  | AL                     | RICE BLAISE A                                          | 4-R11L-31   |
| 62                                         | DAMANT VIRGINIA GRIFFITH & GRIFFITH BEVERLY LYNN           | 4-R14M-7.1  | AM                     | SPIELVOGEL TODD J                                      | 4-R11L-32   |
| 63                                         | MILLER JAMES D JR & CAROLINE KUJAR MILLER                  | 4-R14M-6    | AN                     | RUCKMAN MARY ANN TRUST & K CUSTER & D BAUKNECHT TEES   | 4-R11L-29   |
| 64                                         | COLLEY DANIEL                                              | 4-R14M-5.1  | AO                     | RUCKMAN MARY ANN TRUST & K CUSTER & D BAUKNECHT TEES   | 4-R11L-28   |
| 65                                         | DEARTH KENNETH E                                           | 4-R14M-5    |                        |                                                        |             |

|            |   |                  |                      |  |
|------------|---|------------------|----------------------|--|
| REVISIONS: | <div>COMPANY:<div><div>SWN</div><div>Production Company, LLC</div></div><div><div>SWN</div><div>Production Company™</div></div></div> |                  |                      |  |
|            |   |                  |                      |  |
|            |   |                  |                      |  |
|            |   |                  |                      |  |
|            |   |                  |                      |  |
|            | OPERATOR'S   | FRANZ THOMAN OHI | DATE: 02-24-2025     |  |
|            | WELL #:   | 6H               | API NO: 47-069-00370 |  |
|            | DISTRICT:   | COUNTY:          | DRAWN BY:Z.WOOD      |  |
|            | RICHLAND   | OHIO             | SCALE: N/A           |  |
|            |   | STATE:           | DRAWING NO:2018-781  |  |
|            |   | WV               | WELL LOCATION PLAT   |  |

07/25/2025



| WELL BORE TABLE FOR SURFACE/ROYALTY OWNERS |                                                             |             | WELL BORE TABLE FOR SURFACE/ROYALTY OWNERS |                                                         |                   |
|--------------------------------------------|-------------------------------------------------------------|-------------|--------------------------------------------|---------------------------------------------------------|-------------------|
| TRACT                                      | SURFACE OWNER (S) \ ROYALTY OWNER (R)                       | TAX PARCEL  | TRACT                                      | SURFACE OWNER                                           | TAX PARCEL        |
| 1                                          | THOMAN FRANS (S) \ (R)                                      | 4-R8-62     | 66                                         | RIDENHOUR LEA W                                         | 4-R14R-12         |
| 2                                          |                                                             |             | 67                                         | FELTON JOHN R & RHONDA                                  | 4-R14R-12         |
| 3                                          |                                                             |             | 68                                         | OBRIEN SEAN P                                           | 4-R14-82          |
| 4                                          | MOLNAR KRISTINE N                                           | 4-R11-13.1  | 69                                         | OBRIEN FRANK & WHITNEY                                  | 4-R14-82.2        |
| 5                                          | MOLNAR KRISTINE N                                           | 4-R11-13.4  | 70                                         | FRONHAPFEL PATRICK A                                    | 4-R17D-132        |
| 6                                          | MOLNAR KRISTINE N                                           | 4-R11-16.4  | 71                                         | ROBINSON RICHARD J                                      | 4-R17D-133        |
| 7                                          | STERN SHAWN G & AIMEE M                                     | 4-R11-16.13 | 72                                         | HUMWAY ROSE                                             | 4-R17D-81         |
| 8                                          | KLOS MARIE A                                                | 4-R11-16    | 73                                         | NIZAMI SALEEM & DENITRA                                 | 4-R17D-132        |
| 9                                          | BONAWITZ PAMELA KORTH - TOD                                 | 4-R11-16.16 | 74                                         | CUNNINGHAM C J REV TRUST                                | 4-R17D-119        |
| 10                                         | SCHRAMM ALEXANDER M & ALESIA M SCHRAMM                      | 4-R11-16.7  | 75                                         | ADAMS FRANCES G II REVOCABLE TRUST                      | 4-R17D-88         |
| 11                                         | SCHRAMM ALEXANDER M & ALESIA M SCHRAMM                      | 4-R11-16.17 | 76                                         | ELBERT BREANNA                                          | 4-R17D-86         |
| 12                                         | PATTERSON MARY JANE - TOD                                   | 4-R11G-11   | 77                                         | PALMER JORDAN V & MEGAN E                               | 4-R17D-84         |
| 13                                         | PORTER THOMAS E & LINDA A                                   | 4-R11G-8    | 78                                         | WEST JEREMY                                             | 4-R17D-166        |
| 14                                         | JONES ROBERT C                                              | 4-R11G-7    | 79                                         | PAPPA LESLIE J, POKKL KIMBERLY & PAPPA GREGORY          | 4-R17D-162        |
| 15                                         | KOCHER LEWIS A & THERESA (L.E.) KOCHER DEREK J & JULIE KRON | 4-R11G-6    | 80                                         | PAPPA LESLIE J, POKKL KIMBERLY & PAPPA GREGORY          | 4-R17D-164        |
| 16                                         | KOCHER LEWIS A & THERESA (L.E.) KOCHER DEREK J & JULIE KRON | 4-R11G-6.1  | 81                                         | BRYAN KATHLEEN J & BRYAN STELLA M                       | 4-R17D-199        |
| 17                                         | CUNNINGHAM ROBERT & JULIE                                   | 4-R11G-4.1  | 82                                         | <b>SCHRAMM ERIK A &amp; S M</b>                         | <b>4-R11G-12</b>  |
| 18                                         | CUNNINGHAM ROBERT W & JULIE D                               | 4-R11G-3    | 86                                         | <b>KEEPER F JAY</b>                                     | <b>4-R11-43</b>   |
| 19                                         | CUPP ELI J & ASHLEY ELIZABETH                               | 4-R11G-2    | 87                                         | <b>ULLOM REBECCA A</b>                                  | <b>4-R17D-120</b> |
| 20                                         | HUGHES JOSHUA KELLER                                        | 4-R11-24    | 88                                         | <b>BRAUN EUGENE &amp; M J</b>                           | <b>4-R17D-162</b> |
| 21                                         | HUGHES JOSHUA & KATIE                                       | 4-R11-3.11  | ADJOINING OWNERS TABLE                     |                                                         |                   |
| 22                                         | DUSCI DAWN,RE                                               | 4-R11-3.12  | TRACT                                      | SURFACE OWNER                                           | TAX PARCEL        |
| 23                                         | GLUSICH MARY ANN                                            | 4-R11-3.17  | A                                          | TAYLOR DELORA J - TOD                                   | 4-R8K-100         |
| 24                                         | GLUSICH MARY ANN                                            | 4-R11-3.9   | B                                          | SOBOTA SUSAN J                                          | 4-R8-62.3         |
| 25                                         | PERRY CASEY PETERSON & IAN STEWART PERRY                    | 4-R11-2     | C                                          | WRIGHT JOHN T & MELINDA J                               | 4-R8P-11          |
| 26                                         | BURNSWORTH TIMOTHY J JR & T J                               | 4-R11-4     | D                                          | SUTTON JACQUELINE M                                     | 4-R8D-10          |
| 27                                         | HANNA JANE R - TOD                                          | 4-R11-44    | E                                          | DAGUE AMY D                                             | 4-R8D-11          |
| 28                                         | KEEPER F JAY                                                | R11-39      | F                                          | WHEELER JOLLY W JR & K M                                | 4-R8D-14          |
| 29                                         | WHEELING PARK COMMISSION                                    | 4-R11-21.2  | G                                          | TAROVISKY FRANK J & S R - TOD                           | 4-R8D-28          |
| 30                                         | PARKS 2525 TRUST FUND OF WHEELING                           | R11-21.3    | H                                          | TOMASIK PAULA J & EDWARD C                              | 4-R8D-3           |
| 31                                         | WHEELING PARK COMMISSION                                    | R11-21.4    | I                                          | TERAMANA RUSSELL & ROSEANN                              | 4-R8D-2           |
| 32                                         | WHEELING PARK COMMISSION                                    | R14-91      | J                                          | HUFFMAN KENDRA L & RALPH J                              | 4-R8D-60          |
| 33                                         | WHEELING PARK COMMISSION                                    | R14-20.4    | K                                          | SANDCREST FOUNDATION INC                                | 4-R11-12          |
| 34                                         | WHEELING PARK COMMISSION                                    | R14-20.2    | L                                          | SCHNEIDER CAROLYN JAN                                   | 4-R11G-30.1       |
| 35                                         | WHEELING PARK COMMISSION                                    | R14-12.1    | M                                          | WRIGHT TAMMY J                                          | 4-R11G-30         |
| 36                                         | PARSONS SALLY W                                             | R14G-3      | N                                          | FRANCIS CLAYTON M & HILARY B SMITH                      | 4-R11G-29         |
| 37                                         | HOSFELT WILLIAM J & PATRICIA HOSFELT ESTATES                | R14G-2      | O                                          | CRUPE JUSTINE K & JOHN D                                | 4-R11G-28         |
| 38                                         | VELLENOWETH WILLIAM O & LISA B                              | R14G-10.1   | P                                          | MILLER OLIVIA M                                         | 4-R11G-27         |
| 39                                         | MCLAUGHLIN JEFFREY J & CAROL                                | R14G-12     | Q                                          | MYLES IVAN P JR & DEBORAH A                             | 4-R11G-22         |
| 40                                         | ZELEK CHARLES & IRMA                                        | R14G-13     | R                                          | RAFA MATTHEW M                                          | 4-R11G-24         |
| 41                                         | BANDI DANIEL A & B J                                        | R14G-14     | S                                          | SCHRAMM ALEXANDER M & ALESIA M SCHRAMM                  | 4-R11-16.18       |
| 42                                         | WILSON SHAYNE & CLAIRE CARUSO                               | 4-R14H-33   | T                                          | MYLES IVAN P JR & D A                                   | 4-R11G-23         |
| 43                                         | WILSON SHAYNE & CLAIRE CARUSO                               | 4-R14-46.3  | U                                          | MYLES IVAN P JR & DEBORAH A                             | 4-R11G-26.1       |
| 44                                         | NAINERS KENNETH C & S P                                     | 4-R14-46.14 | V                                          | PARSONS MATTHEW & REBECCA                               | 4-R11G-26.2       |
| 45                                         | SCHREBE MATTHEW C & JORDEN J                                | 4-R14H-26   | <b>W</b>                                   | <b>REMOVED</b>                                          | <b>REMOVED</b>    |
| 46                                         | MORANDO TYLER T & CAYLA S                                   | 4-R14H-22   | X                                          | SUBIT ROGER B & E I                                     | 4-R11G-13         |
| 47                                         | NAINERS STEPHANIE P                                         | 4-R14-46.2  | Y                                          | CAMPBELL MATTHEW J & KATHLEEN; KASIMIR A MAJEWSKI (RTO) | 4-R11G-12         |
| 48                                         | NAINERS KENNETH C & S P                                     | 4-R14-46.2  | Z                                          | CADWELL WILLIAM K & P M                                 | 4-R11G-14         |
| 49                                         | NAINERS BRADY CHARLES & TAYLOR STONER                       | 4-R14-46.23 | AA                                         | JELISON MYRON V & EMILY M                               | 4-R11G-37         |
| 50                                         | CHIU SERENA                                                 | 4-R14H-16   | AB                                         | CAMILLETTI LOUISE                                       | 4-R11L-3.12       |
| 51                                         | DIBARTOLOMEO CHAD M & BRANDY A MORGAN                       | 4-R14M-21   | AC                                         | MCKEE ELIZABETH M                                       | 4-R11L-3.10       |
| 52                                         | AARON WAY IMPROVEMENT ASSN INC                              | 4-R14H-37   | AD                                         | HUGHES JOSHUA KELLER                                    | 4-R11L-3.14       |
| 53                                         | DIBARTOLOMEO CHAD M & BRANDY A MORGAN                       | 4-R14M-34   | AE                                         | KURELAC JESSICA & PETER P III                           | 4-R11L-3.2        |
| 54                                         | PETROPULUS WILLIAM G & S A                                  | 4-R14M-30   | AF                                         | DODD CHARLES & ERIN                                     | 4-R11L-3.4        |
| 55                                         | PETROPULUS WILLIAM G & SHEREE A                             | 4-R14M-23   | AG                                         | GRUBER GEARY J                                          | 4-R11L-2          |
| 56                                         | BROWN JONATHAN D & CHRISTINE M                              | 4-R14M-27   | AH                                         | ADAMS SHAYE J                                           | 4-R11L-6          |
| 57                                         | BROWN JONATHAN D & CHRISTINE M                              | 4-R14M-32   | <b>AI</b>                                  | <b>REMOVED</b>                                          | <b>REMOVED</b>    |
| 58                                         | MARTINELLI ANTHONY W & MICHELLE R                           | 4-R14-46.10 | AJ                                         | KEEPER F JAY                                            | 4-R11L-42         |
| 59                                         | GRIFFITH DOROTHY V                                          | 4-R14M-2    | AK                                         | KEEPER F JAY                                            | 4-R11L-41         |
| 60                                         | TIU CHRISTOPHER & DANA K                                    | 4-R14-46.18 | AL                                         | RICE BLAISE A                                           | 4-R11L-31         |
| 61                                         | DAMANI VIRGINIA GRIFFITH & GRIFFITH BEVERLY LYNN            | 4-R14M-2.2  | AM                                         | SPIELVOGEL TODD J                                       | 4-R11L-32         |
| 62                                         | DAMANI VIRGINIA GRIFFITH & GRIFFITH BEVERLY LYNN            | 4-R14M-7.1  | AN                                         | RUCKMAN MARY ANN TRUST & K CUSTER & D BAKNECHT TEES     | 4-R11L-29         |
| 63                                         | COLLEY DANIEL & CAROLINE KUHAH MILLER                       | 4-R14M-6    | AO                                         | RUCKMAN MARY ANN TRUST & K CUSTER & D BAKNECHT TEES     | 4-R11L-28         |
| 64                                         | COLLEY DANIEL                                               | 4-R14M-2.1  |                                            |                                                         |                   |
| 65                                         | DEARTH KENNETH E                                            | 4-R14M-2    |                                            |                                                         |                   |

07/25/2025

|         |  |             |  |          |        |                         |                  |                      |                  |  |
|---------|--|-------------|--|----------|--------|-------------------------|------------------|----------------------|------------------|--|
| RICHARD |  | DISTRICT:   |  | OHIO     | STATE: | WW                      | FRANS THOMAN OHI |                      | DATE: 02-24-2025 |  |
| WELL #: |  | OPERATOR'S: |  | COMPANY: |        | Production Company, LLC |                  | DRAWN BY: J.WOOD     |                  |  |
|         |  |             |  |          |        |                         |                  | API NO: 42-089-00370 |                  |  |
|         |  |             |  |          |        |                         |                  | SCALE: N/A           |                  |  |
|         |  |             |  |          |        |                         |                  | DRAWING NO: 2018-781 |                  |  |
|         |  |             |  |          |        |                         |                  | WELL LOCATION PLAT   |                  |  |



| ADJOINING OWNERS TABLE |                                                         |             | ADJOINING OWNERS TABLE |                                                                |              |
|------------------------|---------------------------------------------------------|-------------|------------------------|----------------------------------------------------------------|--------------|
| TRACT                  | SURFACE OWNER                                           | TAX PARCEL  | TRACT                  | SURFACE OWNER                                                  | TAX PARCEL   |
| AP                     | PASCOLI BARTLEY EDWARD & SEAN WYLIE PASCOLI             | 4-R11-23    | DE                     | FLUHARTY MICHAEL L                                             | 4-R17D-190   |
| AQ                     | OHIO COUNTY PUBLIC SERVICE DISTRICT                     | 4-R11-21.42 | DF                     | SUTTON PAUL E SR                                               | 4-R17D-189   |
| AR                     | PARKS SYSTEM TRUST                                      | 4-R11-21.43 | DG                     | JONES LINDA LOUISE                                             | 4-R17D-197   |
| AS                     | WHEELING PARK COMMISSION                                | 4-R11-21.7  | DH                     | NIZAMI SALEEM & DENITRA                                        | 4-R17D-196   |
| AT                     | WHEELING PARK COMMISSION                                | 4-R11-21.6  | DI                     | PALMER JORDAN V & MEGAN E                                      | 4-R17D-74    |
| AU                     | WHEELING PARK COMMISSION                                | 4-R11-21.2  | DJ                     | PALMER JORDAN V & MEGAN E                                      | 4-R17D-72    |
| AV                     | WHEELING PARK COMMISSION                                | 4-R14-20.5  | DK                     | SHIELDS HELEN LOUISE ESTATE                                    | 4-R17D-90    |
| AW                     | WHEELING PARK COMMISSION                                | 4-R14-20.1  | DL                     | NIZAMI SALEEM & DENITRA                                        | 4-R17D-91    |
| AX                     | TALENFELD FRANK LEBOW MYRA J                            | 4-R14-34    | DM                     | PALMER JORDAN V & MEGAN E                                      | 4-R17D-92    |
| AY                     | HUGHES MARY ELIZABETH                                   | 4-R14-36    | DN                     | MCCARDLE CRAIG                                                 | 4-R17D-105   |
| AZ                     | CARO GREGORY M                                          | 4-R14G-1    | DO                     | DVORAK GEO L & S H                                             | 4-R17D-115   |
| BA                     | DEGUZMAN CRISTINA L                                     | 4-R14-35    | DP                     | SNYDER LINDA                                                   | 4-R17D-113   |
| BB                     | GEYER ANTOINETTE C                                      | 4-R14H-30   | DQ                     | MCCARDLE CRAIG                                                 | 4-R17D-112   |
| BC                     | GEYER ANTOINETTE C                                      | 4-R14H-29   | DR                     | MCCARDLE CRAIG                                                 | 4-R17D-111   |
| BD                     | MARONEY KIMBERLY A                                      | 4-R14H-28   | DS                     | EMANE THOMAS C/O PUGMIRE JUDITH ANN                            | 4-R17D-131   |
| BE                     | DRAHOS MATTHEW J & EMILY J                              | 4-R14H-27   | DT                     | MCCARDLE DOUGLAS                                               | 4-R17D-128   |
| BF                     | KILPATRICK ERIC R                                       | 4-R14H-20   | DU                     | KRAMER JOHN N                                                  | 4-R14-82     |
| BG                     | CARUSO MICHAEL J & MEGAN N                              | 4-R14H-21   | DV                     | JONES LAMBERT T II & MARIAN D                                  | 4-R14-85.2   |
| BH                     | BOLDRICK MICHAEL P & M STELLA                           | 4-R14H-22   | DW                     | MARSHALL JENIFER ELAINE                                        | 4-R14-84     |
| BI                     | TORISEVA TERESA CLARK                                   | 4-R14H-13   | DX                     | SCHENERLEIN SCOTT M                                            | 4-R14-85.3   |
| BJ                     | CARO GREGORY M                                          | 4-R14H-39   | DY                     | SCHNERLEIN SCOTT M                                             | 4-R14-85.4   |
| BK                     | CARO GREGORY M                                          | 4-R14H-14   | DZ                     | PATRICK PATRICIA & STEPHEN                                     | 4-R14-85.1   |
| BL                     | FAHEY G MICHAEL & JANET L                               | 4-R14H-15   | EA                     | FELTON JOHN R JR AND RHONDA A                                  | 4-R14R-1.7   |
| BM                     | BERARDINELLI JON L & STEPHANIE                          | 4-R14H-38   | EB                     | FELTON JOHN R JR & RHONDA A                                    | 4-R14R-1     |
| BN                     | SPURLOCK DEAN E                                         | 4-R14M-22   | EC                     | RIDENHOUR LEA W                                                | 4-R14R-1.8   |
| BO                     | LOCKNEY GARY W & NEISHA E                               | 4-R14M-29   | ED                     | FREISMUTH THOMAS & PATRICIA IRREVOC TRUST                      | 4-R14R-1.9   |
| BP                     | BERARDINELLI JON L & STEPHANIE                          | 4-R14M-26   | EE                     | FREISMUTH THOMAS & PATRICIA IRREVOC TRUST                      | 4-R14R-1.4   |
| BQ                     | JESSEN PETER F & ELIZABETH H                            | 4-R14M-24   | EF                     | TARR J LANCE & DANA L                                          | 4-R14M-3     |
| BR                     | BLALOCK LARRY W & JANE R                                | 4-R14M-25   | EG                     | TARR J LANCE & DANA L                                          | 4-R14M-33    |
| BS                     | GRIFFITH DOROTHY V                                      | 4-R14M-2.3  | EH                     | BRUNER CHRISTOPHER JAMES                                       | 4-R14M-3.1   |
| BT                     | GRIFFITH DOROTHY V                                      | 4-R14M-2.6  | EI                     | WHEELING PARK COMMISSION                                       | 10-W17D-7    |
| BU                     | GRIFFITH RITA L & VINCENT A JR, TRUSTEE                 | 4-R14M-2.10 | EJ                     | JACKSON JEFFREY HUGH & RONNA RENEE JACKSON                     | 4-R14-46.12  |
| BV                     | GRIFFITH VINCENT A & RITA L                             | 4-R14M-2.9  | EK                     | COYNE KEVIN P                                                  | 4-R14-46.1   |
| BW                     | OGLEBAY FOUNDATION PROPERTIES INC                       | 4-R14M-2.4  | EL                     | BROWN JONATHAN D & CHRISTINA M                                 | 4-R14M-28    |
| BX                     | FORTUNA ALEX C JR                                       | 4-R14M-4    | EM                     | WRIGHT LAWRENCE E JR & V                                       | 4-R14M-20    |
| BY                     | FORTUNA ALEX C JR                                       | 4-R14M-9    | EN                     | WRIGHT LAWRENCE E JR & V                                       | 4-R14M-16    |
| BZ                     | GRIFFITH DOROTHY V                                      | 4-R14M-10   | EO                     | ALEXANDER SPIRO G & CARLA                                      | 4-R14H-17    |
| CA                     | CLEMENS SCOTT P & D K TRUST                             | 4-R14M-8    | EP                     | MCDERMOTT R GREGORY & L D                                      | 4-R14M-13    |
| CB                     | HASTINGS THOMAS JUSTIN & MYERS ELIZABETH A              | 4-R14M-3    | EQ                     | HERNDON RICHARD G JR                                           | 4-R14L-1     |
| CC                     | TEMPLIN GEORGE K                                        | 4-R14R-17   | ER                     | KLUG DAVID R & P B                                             | 4-R14L-2     |
| CD                     | LOWTHER BROCKRICK & REKA                                | 4-R14R-18   | ES                     | PIZARRO CESAR D & E C                                          | 4-R14L-3     |
| CE                     | DORSEY JOHN & RUTH                                      | 4-R14R-19   | ET                     | REED DAVID F & C M                                             | 4-R14L-4     |
| CF                     | PERKS MATTHEW D & JENNIFER A                            | 4-R14R-20   | EU                     | SANTINI FEDERICO & ELENA DANVELO                               | 4-R14L-5     |
| CG                     | AIVALOTIS RONALD W BRTHR & SEIFERTH LARUE LINDA SIS     | 4-R14R-21   | EV                     | BURKLAND C DAVID & LESLIE                                      | 4-R14L-6     |
| CH                     | TUCKER CLAY & GABRIELLE                                 | 4-R14R-22   | EW                     | WAYT MICHAEL T & HEATHER A                                     | 4-R14L-16.3  |
| CI                     | DALBY JOHN C D & K L                                    | 4-R14R-23   | EX                     | WAYT MICHAEL T & HEATHER OSHEA                                 | 4-R14L-17    |
| CJ                     | SHULTZ KATHLEEN F                                       | 4-R14R-24   | EY                     | GRIFFITH MATTHEW B                                             | 10-W17D-1    |
| CK                     | VERCELLOTTI CELESTINA S/S 1996                          | 4-R14R-33   | EZ                     | JACOVETTY GERALD - TOD                                         | 10-W14D-58   |
| CL                     | HEMPELMANN FRIEDRICH ERNST & DEBORAH COLLEEN HEMPELMANN | 4-R14R-32   | FA                     | CAMPBELL RICHARD W & MARY J                                    | 10-W14D-59.1 |
| CM                     | DAMANT VIRGINIA                                         | 4-R14R-34   | FB                     | WHEELER CHARLES FRANKLIN & WHEELER CORRINE N                   | 10-W14D-59   |
| CN                     | CHLIPLINSKI JUNE A                                      | 4-R14-87    | FC                     | WHEELER FRANK W & LINDA S TRST; FRANK W & LINDA S WHEELER TEES | 10-W14D-60   |
| CO                     | HUMWAY ROSE                                             | 4-R17D-81   | FD                     | CARROLL CAROL A                                                | 10-W14D-61   |
| CP                     | CUNNINGHAM C S                                          | 4-R17D-139  | FE                     | NANNERS KENNETH C & STEPHANIE P                                | 4-R14G-15.12 |
| CQ                     | ULLOM REBECCA A                                         | 4-R17D-140  | FF                     | TURAK, CHRISTOPHER M & SHAWN R                                 | 4-R14G-15    |
| CR                     | REMOVED                                                 | REMOVED     | FG                     | KRALL MARGARET A                                               | 4-R14G-15.7  |
| CS                     | SMITH SANDRA E                                          | 4-R17D-121  | FH                     | KRALL MARGARET A                                               | 4-R14G-15.5  |
| CT                     | SMITH SANDRA E                                          | 4-R17D-141  | FI                     | BRADSHAW DAVID R & CRYSTAL-DAWN L BRADSHAW                     | 4-R14G-15.8  |
| CU                     | MARLING JASON A                                         | 4-R17D-143  | FJ                     | BERTRAM HOWARD J & TANYA R                                     | 4-R14G-11    |
| CV                     | FLUHARTY MICHAEL L                                      | 4-R17D-123  | FK                     | VELLENOWETH WILLIAM O & LISA B                                 | 4-R14G-10    |
| CW                     | PALMER JORDAN V & MEGAN E                               | 4-R17D-82   | FL                     | HERYFORD CRAIG S & ANGELA CURFMAN                              | 4-R14G-5     |
| CX                     | JONES LINDA LOUISE                                      | 4-R17D-80   | FM                     | CALVERT GROVE ANTHONY & PAULA L CALVERT                        | 4-R14G-6     |
| CY                     | CONCONI CAROLE A                                        | 4-R17D-79   | FN                     | PAPPAS JOHN T & L R                                            | 4-R14G-7     |
| CZ                     | REMOVED                                                 | REMOVED     | FO                     | JACKSON PHILIP J & CATHY M                                     | 4-R14G-8     |
| DA                     | MCCARDLE DOUGLAS                                        | 4-R17D-161  | FP                     | RECCHIO RONALD & AMANDA                                        | 4-R14G-15.10 |
| DB                     | BITZER HEATHER LYNN DONDA                               | 4-R17D-160  | FQ                     | WHEELING PARK COMMISSION                                       | 4-R14G-15.11 |
| DC                     | ROBINSON RICHARD J                                      | 4-R17D-203  | FR                     | CITY OF WHEELING                                               | 4-R14-15     |
| DD                     | FLUHARTY MICHAEL L                                      | 4-R17D-192  | FS                     | WHEELING PARK COMMISSION                                       | 4-R11-20.1   |

|            |   |         |                  |                      |
|------------|---|---------|------------------|----------------------|
| REVISIONS: | <div>COMPANY:<div><div>SWN</div><div>Production Company, LLC</div></div><div><div>SWN</div><div>Production Company™</div></div></div> |         |                  | DATE: 02-24-2025     |
|            |   |         |                  |                      |
|            | OPERATOR'S   |         | FRANZ THOMAN OHI | API NO: 47-069-00370 |
|            | WELL #:   |         | 6H               | DRAWN BY:Z.WOOD      |
|            | DISTRICT:   | COUNTY: | STATE:           | SCALE:               |
|            | RICHLAND   | OHIO    | WV               | DRAWING NO:2018-781  |
|            |   |         |                  | WELL LOCATION PLAT   |



| ADJOINING OWNERS TABLE |                                                         |              | ADJOINING OWNERS TABLE |                                                                |              |
|------------------------|---------------------------------------------------------|--------------|------------------------|----------------------------------------------------------------|--------------|
| TRACT                  | SURFACE OWNER                                           | TAX PARCEL   | TRACT                  | SURFACE OWNER                                                  | TAX PARCEL   |
| AP                     | PASCOLI BARTLEY EDWARD & SEAN WYLYE PASCOLI             | 4-R1-23      | DE                     | FLUHARTY MICHAEL J                                             | 4-R1D-190    |
| AQ                     | OHIO COUNTY PUBLIC SERVICE DISTRICT                     | 4-R1-21-42   | DF                     | STUTTON PAUL E SR                                              | 4-R1D-189    |
| AR                     | PARKS SYSTEM TRUST                                      | 4-R1-21-43   | DG                     | JONES LINDA LOUISE                                             | 4-R1D-192    |
| AS                     | WHEELING PARK COMMISSION                                | 4-R1-21-7    | DH                     | NIZAMI SALEEM & DENITRA                                        | 4-R1D-196    |
| AT                     | WHEELING PARK COMMISSION                                | 4-R1-21-6    | DI                     | PALMER JORDAN V & MEGAN E                                      | 4-R1D-74     |
| AU                     | WHEELING PARK COMMISSION                                | 4-R1-21-5    | DJ                     | PALMER JORDAN V & MEGAN E                                      | 4-R1D-75     |
| AV                     | WHEELING PARK COMMISSION                                | 4-R14-20-2   | DK                     | SHIELDS HELEN LOUISE ESTATE                                    | 4-R1D-90     |
| AW                     | WHEELING PARK COMMISSION                                | 4-R14-20-1   | DL                     | NIZAMI SALEEM & DENITRA                                        | 4-R1D-91     |
| AX                     | TATEFIELD FRANK LEBOW MYRA J                            | 4-R14-34     | DM                     | PALMER JORDAN V & MEGAN E                                      | 4-R1D-95     |
| AY                     | HUGHES MARY ELIZABETH                                   | 4-R14-36     | DN                     | MCCARDLE CRAIG                                                 | 4-R1D-102    |
| AZ                     | CARO GREGORY M                                          | 4-R14G-1     | DO                     | DVORAK GEO L & S H                                             | 4-R1D-112    |
| BA                     | DEGUZMAN CRISTINA J                                     | 4-R14-32     | DP                     | SNYDER LINDA                                                   | 4-R1D-113    |
| BB                     | GEYER ANTOINETTE C                                      | 4-R14H-30    | DQ                     | MCCARDLE CRAIG                                                 | 4-R1D-115    |
| BC                     | GEYER ANTOINETTE C                                      | 4-R14H-29    | DR                     | MCCARDLE CRAIG                                                 | 4-R1D-111    |
| BD                     | MARONEY KIMBERLY A                                      | 4-R14H-28    | DS                     | EMANE THOMAS C/O PUGMIRE JUDITH ANN                            | 4-R1D-131    |
| BE                     | DRAHOS MATTHEW J & EMILY J                              | 4-R14H-27    | DT                     | MCCARDLE DOUGLAS                                               | 4-R1D-128    |
| BF                     | KILPATRICK ERIC R                                       | 4-R14H-20    | DU                     | KRAMER JOHN N                                                  | 4-R14-85     |
| BG                     | CARUSO MICHAEL J & MEGAN N                              | 4-R14H-21    | DV                     | JONES LAMBERT T II & MARIAN D                                  | 4-R14-82-5   |
| BH                     | BOLDRICK MICHAEL P & M STELLA                           | 4-R14H-25    | DW                     | MARSHALL JENNIFER ELAINE                                       | 4-R14-84     |
| BI                     | TORISEVA TEREZA CLARK                                   | 4-R14H-13    | DX                     | SCHNEIERLEIN SCOTT M                                           | 4-R14-82-3   |
| BJ                     | CARO GREGORY M                                          | 4-R14H-39    | DY                     | SCHNEIERLEIN SCOTT M                                           | 4-R14-82-4   |
| BK                     | CARO GREGORY M                                          | 4-R14H-14    | DZ                     | PATRICK PATRICIA & STEPHEN                                     | 4-R14-82-1   |
| BL                     | FAHEY G MICHAEL & JANET J                               | 4-R14H-12    | EA                     | FELTON JOHN R JR AND RHONDA A                                  | 4-R14R-17    |
| BM                     | BERARDINELLI JON J & STEPHANIE                          | 4-R14H-38    | EB                     | FELTON JOHN R JR & RHONDA A                                    | 4-R14R-1     |
| BN                     | SPURLOCK DEAN E                                         | 4-R14M-25    | EC                     | RIDENHOUR LEA W                                                | 4-R14R-18    |
| BO                     | LOCKNEY GARY W & NEISHA E                               | 4-R14M-29    | ED                     | FREISMUTH THOMAS & PATRICIA IRREVOC TRUST                      | 4-R14R-19    |
| BP                     | BERARDINELLI JON J & STEPHANIE                          | 4-R14M-26    | EE                     | FREISMUTH THOMAS & PATRICIA IRREVOC TRUST                      | 4-R14R-14    |
| BQ                     | JESSEN PETER F & ELIZABETH H                            | 4-R14M-24    | EF                     | TARR J LANCE & DANA J                                          | 4-R14M-3     |
| BR                     | BLAOCK LARRY W & JANE R                                 | 4-R14M-22    | EG                     | TARR J LANCE & DANA J                                          | 4-R14M-33    |
| BS                     | GRIFFITH DOROTHY V                                      | 4-R14M-23    | EH                     | BRUNER CHRISTOPHER JAMES                                       | 4-R14M-3-1   |
| BT                     | GRIFFITH DOROTHY V                                      | 4-R14M-26    | EI                     | WHEELING PARK COMMISSION                                       | 10-W1D-7     |
| BU                     | GRIFFITH RITA J & VINCENT A JR, TRUSTEE                 | 4-R14M-25-10 | EJ                     | JACKSON JEFFREY HUGH & RONNA RENEE JACKSON                     | 4-R14-46-15  |
| BV                     | GRIFFITH VINCENT A & RITA J                             | 4-R14M-29    | EK                     | COYNE KEVIN P                                                  | 4-R14-46-1   |
| BW                     | OGLEBAY FOUNDATION PROPERTIES INC                       | 4-R14M-24    | EL                     | BROWN JONATHAN D & CHRISTIAN M                                 | 4-R14M-28    |
| BX                     | FORTUNA ALEX C JR                                       | 4-R14M-4     | EM                     | WRIGHT LAWRENCE E JR & V                                       | 4-R14M-20    |
| BY                     | FORTUNA ALEX C JR                                       | 4-R14M-9     | EN                     | WRIGHT LAWRENCE E JR & V                                       | 4-R14M-16    |
| BZ                     | GRIFFITH DOROTHY V                                      | 4-R14M-10    | EO                     | ALEXANDER SPIRO G & CARLA                                      | 4-R14H-17    |
| CA                     | CLEMENS SCOTT P & D K TRUST                             | 4-R14M-8     | EP                     | MCDERMOTT R GREGORY & L D                                      | 4-R14M-13    |
| CB                     | HASTINGS THOMAS JUSTIN & MYERS ELIZABETH A              | 4-R14M-3     | EQ                     | HERNDON RICHARD G JR                                           | 4-R14L-1     |
| CC                     | TEMPLIN GEORGE K                                        | 4-R14R-17    | ER                     | KLUG DAVID R & P B                                             | 4-R14L-5     |
| CD                     | LOWTHER BROCKRICK & REKA                                | 4-R14R-18    | ES                     | PIZARRO CESAR D & E C                                          | 4-R14L-3     |
| CE                     | DORSEY JOHN & RUTH                                      | 4-R14R-19    | ET                     | REED DAVID F & C M                                             | 4-R14L-4     |
| CF                     | PERKS MATTHEW D & JENNIFER A                            | 4-R14R-20    | EU                     | SANTINI FEDERICO & ELENA DANGELO                               | 4-R14L-2     |
| CG                     | AVALOTIS RONALD W BRYTH & SEIFERTH LARUE LINDA SIZ      | 4-R14R-21    | EV                     | BURKLAND C DAVID & LESLIE                                      | 4-R14L-6     |
| CH                     | TUCKER CLAY & GABRIELLE                                 | 4-R14R-25    | EW                     | WAYT MICHAEL T & HEATHER A                                     | 4-R14L-16-3  |
| CI                     | DALBY JOHN C D & K J                                    | 4-R14R-23    | EX                     | WAYT MICHAEL T & HEATHER OSHEA                                 | 4-R14L-17    |
| CJ                     | SHULTZ KATHLEEN F                                       | 4-R14R-24    | EY                     | GRIFFITH MATTHEW B                                             | 10-W1D-1     |
| CK                     | VERCELLOTTI CELESTINA S/S 1996                          | 4-R14R-33    | EZ                     | JACOVETTY GERALD - TOD                                         | 10-W14D-28   |
| CL                     | HEMPELMANN FRIEDRICH ERNST & DEBORAH COLLEEN HEMPELMANN | 4-R14R-35    | FA                     | CAMPBELL RICHARD W & MARY J                                    | 10-W14D-29-1 |
| CM                     | DAMANT VIRGINIA                                         | 4-R14R-34    | FB                     | WHEELER CHARLES FRANKLIN & WHEELER CORRIE N                    | 10-W14D-29   |
| CN                     | CHIPILSKI JUNE A                                        | 4-R14-87     | FC                     | WHEELER FRANK W & LINDA S TRST; FRANK W & LINDA S WHEELER TEES | 10-W14D-60   |
| CO                     | HUMWAY ROSE                                             | 4-R1D-81     | FD                     | CARROLL CAROL A                                                | 10-W14D-61   |
| CP                     | CUNNINGHAM C S                                          | 4-R1D-139    | FE                     | NANNERS KENNETH C & STEPHANIE P                                | 4-R14G-12-15 |
| CQ                     | ULLOM REBECCA A                                         | 4-R1D-140    | FF                     | TURAK, CHRISTOPHER M & SHAWN R                                 | 4-R14G-12    |
| CR                     | REMOVED                                                 | REMOVED      | FG                     | KRALL MARGARET A                                               | 4-R14G-12-7  |
| CS                     | SMITH SANDRA E                                          | 4-R1D-151    | FH                     | KRALL MARGARET A                                               | 4-R14G-12-2  |
| CT                     | SMITH SANDRA E                                          | 4-R1D-141    | FI                     | BRADSHAW DAVID R & CRYSTAL-DAWN L BRADSHAW                     | 4-R14G-12-8  |
| CU                     | MARLING JASON A                                         | 4-R1D-143    | FJ                     | BERTRAM HOWARD J & TANYA R                                     | 4-R14G-11    |
| CV                     | FLUHARTY MICHAEL J                                      | 4-R1D-153    | FK                     | VELLENOWETH WILLIAM O & LISA B                                 | 4-R14G-10    |
| CW                     | PALMER JORDAN V & MEGAN E                               | 4-R1D-85     | FL                     | HERYFORD CRAIG S & ANGELA CURFMAN                              | 4-R14G-2     |
| CX                     | JONES LINDA LOUISE                                      | 4-R1D-80     | FM                     | CALVERT GROVE ANTHONY & PAULA J CALVERT                        | 4-R14G-6     |
| CY                     | CONCONI CAROLE A                                        | 4-R1D-79     | FN                     | PAPPAS JOHN T & L R                                            | 4-R14G-7     |
| CZ                     | REMOVED                                                 | REMOVED      | FO                     | JACKSON PHILIP J & CATHY M                                     | 4-R14G-8     |
| DA                     | MCCARDLE DOUGLAS                                        | 4-R1D-161    | FP                     | RECCHIO RONALD & AMANDA                                        | 4-R14G-12-10 |
| DB                     | FLUHARTY MICHAEL J                                      | 4-R1D-160    | FQ                     | WHEELING PARK COMMISSION                                       | 4-R14-12-5   |
| DC                     | ROBINSON RICHARD J                                      | 4-R1D-203    | FR                     | CITY OF WHEELING                                               | 4-R14-12     |
| DD                     | FLUHARTY MICHAEL J                                      | 4-R1D-192    | FS                     | WHEELING PARK COMMISSION                                       | 4-R11-20-1   |

07/25/2025

|            |  |             |  |                   |  |                      |  |
|------------|--|-------------|--|-------------------|--|----------------------|--|
| REVISIONS: |  | COMPANY:    |  | FRANZ THOMAN OHIO |  | DATE: 02-24-2025     |  |
|            |  |             |  | EN                |  | DRAWN BY: J. WOOD    |  |
|            |  | OPERATOR'S: |  |                   |  | API NO: 43-088-00370 |  |
|            |  | WELL #:     |  |                   |  | SCALE: N/A           |  |
|            |  | DISTRICT:   |  | OHIO              |  | DRAWING NO: 2018-781 |  |
|            |  | RICHARD     |  | STATE:            |  | WELL LOCATION PLAT   |  |
|            |  |             |  | WV                |  |                      |  |



| ADJOINING OWNERS TABLE |                                                              |             |
|------------------------|--------------------------------------------------------------|-------------|
| TRACT                  | SURFACE OWNER                                                | TAX PARCEL  |
| FT                     | SISTERS OF ST JOSEPH OF WHG                                  | 4-R11-20    |
| FU                     | SISTERS OF ST JOSEPH OF WHEELING INC                         | 4-R11-21    |
| FV                     | KEEFER FRANK JAY - TOD                                       | 4-R11-21.28 |
| FW                     | POTTBERG ROBERT & ERIN K                                     | 4-R11L-37   |
| FX                     | HANNA JANE R- TOD                                            | 4-R11L-45   |
| FY                     | HANNA JANE R - TOD                                           | 4-R11L-46   |
| FZ                     | DAGUE DAVID A & MELISSA A                                    | 4-R11L-1    |
| GA                     | MCFARLAND CHRISTOPHER AND ERIN                               | 4-R11L-55   |
| GB                     | WARNER STEPHANIE R & SCOTT A WADFORD                         | 4-R11L-53   |
| GC                     | BROTHERS ADAM J & JAMIE L                                    | 4-R11L-52   |
| GD                     | MULL QUAY II TRUST                                           | 4-R11L-51   |
| GE                     | BLOSSER NANCY K                                              | 4-R11G-4    |
| GF                     | GONGOLA LAWRENCE K JR & JE                                   | 4-R11F-11   |
| GG                     | MUSILLI DONNA & CHRISTINE K                                  | 4-R11F-12   |
| GH                     | KIDD MICHAEL J                                               | 4-R11F-13   |
| GI                     | WHITE DONALD L & DEBORAH                                     | 4-R11F-14   |
| GJ                     | CORAM SANDRA L                                               | 4-R11F-15   |
| GK                     | PORTER THOMAS EARL                                           | 4-R11G-9    |
| GL                     | NIXON RONALD E & MONICA L                                    | 4-R11G-10   |
| GM                     | LAMBERT FREDERICK A & JULIE L                                | 4-R11F-1    |
| GN                     | TAYLOR BRIAN K AND LISA E                                    | 4-R11F-2    |
| GO                     | ZOLADZ DAVID L AND MELINDA SUE                               | 4-R11F-3    |
| GP                     | DUNKIN RUSSELL W & CHRISTINE E                               | 4-R11F-4    |
| GQ                     | KLOS MARIE A                                                 | 4-R11-41    |
| GR                     | PROTESTANT EPISCOPAL CHURCH DIOCESE OF WV TRUSTEES           | 4-R11-16.2  |
| GS                     | PROTESTANT EPISCOPAL CHURCH DIOCESE OF WV TRUSTEES           | 4-R11-16.1  |
| GT                     | LAWRENCEFIELD CHAPEL TRUSTEES                                | 4-R11-16.8  |
| GU                     | LOUGH DONALD H JR & A L                                      | 4-R11-16.12 |
| GV                     | LOUGH DONALD H & A L                                         | 4-R11-16.9  |
| GW                     | MARY ANN HESS REALTY LLC C/O HANNIG & ASSOCIATES PLLC        | 4-R11-12    |
| GX                     | KING JOHN W & LINDA A - TOD                                  | 4-R11B-38   |
| GY                     | LEMLEY STEPHEN J & E                                         | 4-R11B-37   |
| GZ                     | TRABERT JEFFREY A & T L                                      | 4-R11B-20   |
| HA                     | MOLNAR KRISTINE N & D A                                      | 4-R11B-45   |
| HB                     | GUTHRIE JEREMY L & GUTHRIE ANNE N MOLNAR                     | 4-R11-13.3  |
| HC                     | NEUMANN KURT ROBERT                                          | 4-R11-13    |
| HD                     | WEST WINSTON W JR                                            | 4-R8P-7     |
| HE                     | WEST WINSTON W JR                                            | 4-R8P-6     |
| HF                     | STOLLAR HEATHER D                                            | 4-R8P-5     |
| HG                     | IVERSON DERRICK H & BARBARA A                                | 4-R8P-4     |
| HH                     | COTTRELL CLARA M                                             | 4-R8P-3     |
| HI                     | TUNNEL RIDGE LLC                                             | 4-R8P-1     |
| HJ                     | TUNNEL RIDGE LLC                                             | 4-R8P-15    |
| HK                     | TUNNEL RIDGE LLC                                             | 4-R8P-14    |
| HL                     | WEAVER SHIRLEY M                                             | 4-R8P-2     |
| HM                     | TUNNEL RIDGE LLC                                             | 4-R8P-16    |
| HN                     | CRAFT JOSEPH W III FOUNDATION                                | 4-R8-51     |
| HO                     | MCGEE JOHN M                                                 | 4-R8P-17    |
| HP                     | GAYDA DONALD P                                               | 4-R8P-18    |
| HQ                     | BOND CHARLES R                                               | 4-R8K-110   |
| HR                     | SCHWERTFEGER TYLER S                                         | 4-R8K-111   |
| HS                     | SCHWERTFEGER TYLER S                                         | 4-R8K-112   |
| HT                     | REED ELMER & JOY                                             | 4-R8K-105   |
| HU                     | BOZENSKE B H AND OKELLEY K J                                 | 4-R8K-104   |
| HV                     | WILSON RAY B & ANN M                                         | 4-R8-62.7   |
| HW                     | MILLARD BRITTANY LYNN                                        | 4-R8-62.6   |
| HX                     | MULDREW DAVID R & KAREN                                      | 4-R8K-101   |
| HY                     | MAJEWSKI KASMIR & MAJEWSKI EDWARD A                          | 4-R8-62.2   |
| HZ                     | MAJEWSKI KASMIR & MAJEWSKI EDWARD A                          | 4-R8-62.8   |
| IA                     | PERLIC MELVIN J; PERLIC AGNES PERLIC FAMILY REVOC LIVING TRU | 4-R17D-78   |

07/25/2025

|            |   |         |        |                                                                                         |
|------------|---|---------|--------|-----------------------------------------------------------------------------------------|
| REVISIONS: | <div>COMPANY:</div> <div><div>SWN</div><div>Production Company, LLC</div></div> <div><div>SWN</div><div>Production Company™</div></div> |         |        | <div>DATE: 02-24-2025</div> <div>API NO: 47-069-00370</div> <div>DRAWN BY: Z.WOOD</div> |
|            |   |         |        |                                                                                         |
|            | OPERATOR'S FRANZ THOMAN OHI   |         |        |                                                                                         |
|            | WELL #: 6H   |         |        |                                                                                         |
|            | DISTRICT:   | COUNTY: | STATE: | SCALE:                                                                                  |
|            | RICHLAND   | OHIO    | WV     | N/A                                                                                     |
|            |   |         |        | DRAWING NO: 2018-781                                                                    |
|            |   |         |        | WELL LOCATION PLAT                                                                      |




07/25/2025

|            |  |                                                |  |                      |  |
|------------|--|------------------------------------------------|--|----------------------|--|
| REVISIONS: |  | COMPANY: <b>swm</b><br>Production Company, LLC |  | DATE: 05-24-2025     |  |
| WELL #:    |  | OPERATOR'S: FRANK THOMAS OHI                   |  | API NO: 43-088-00320 |  |
| DISTRICT:  |  | COUNTY:                                        |  | DRAWN BY: J. WOOD    |  |
| RICHARD    |  | OHIO                                           |  | SCALE: 1"=40'        |  |
|            |  | STATE:                                         |  | DRAWING NO: 2018-281 |  |
|            |  | WV                                             |  | WELL LOCATION PLAT   |  |

| ADJOINING OWNERS TABLE |                                                              |            |
|------------------------|--------------------------------------------------------------|------------|
| TRACT                  | SURFACE OWNER                                                | TAX PARCEL |
| IA                     | PERLIC MELVIN J; PERLIC AGNES PERLIC FAMILY REVOC LIVING TRU | 4-R1D-78   |
| HZ                     | MAJEWSKI KAZMIR & MAJEWSKI EDWARD A                          | 4-R8-88    |
| HY                     | MAJEWSKI KAZMIR & MAJEWSKI EDWARD A                          | 4-R8-85    |
| HX                     | MULBREW DAVID R & KAREN                                      | 4-R8K-101  |
| HW                     | MILLARD BRITANNY LYNN                                        | 4-R8-85    |
| HV                     | WILSON RAY B & ANN M                                         | 4-R8-85    |
| HU                     | BOZENSKE B H AND OKELLEY K J                                 | 4-R8K-104  |
| HT                     | REED ELMER & JOY                                             | 4-R8K-102  |
| H2                     | SCHWERTFEGGER TYLER S                                        | 4-R8K-112  |
| HR                     | SCHWERTFEGGER TYLER S                                        | 4-R8K-111  |
| HQ                     | BOND CHARLES R                                               | 4-R8K-110  |
| HP                     | GAYDA DONALD P                                               | 4-R8P-18   |
| HO                     | MCCEE JOHN M                                                 | 4-R8P-17   |
| HI                     | CRAFT JOSEPH W III FOUNDATION                                | 4-R8-21    |
| HM                     | TUNNEL RIDGE LLC                                             | 4-R8P-16   |
| HL                     | WEAVER SHIRLEY M                                             | 4-R8P-5    |
| HK                     | TUNNEL RIDGE LLC                                             | 4-R8P-14   |
| HJ                     | TUNNEL RIDGE LLC                                             | 4-R8P-12   |
| HI                     | TUNNEL RIDGE LLC                                             | 4-R8P-1    |
| HH                     | COTTRELL CLARA M                                             | 4-R8P-3    |
| HG                     | IVERSON DERRICK H & BARBARA A                                | 4-R8P-4    |
| HF                     | STOLAR HEATHER D                                             | 4-R8P-2    |
| HE                     | WEST WINSTON W JR                                            | 4-R8P-6    |
| HD                     | WEST WINSTON W JR                                            | 4-R8P-7    |
| HC                     | NEUMANN KURT ROBERT                                          | 4-R11-13   |
| HB                     | GUTHRIE JEREMY L & GUTHRIE ANNE N MOLNAR                     | 4-R11-13   |
| HA                     | MOLNAR KRISTINE N & D A                                      | 4-R11B-42  |
| HZ                     | TRABERT JEFFREY A & T J                                      | 4-R11B-50  |
| GY                     | LEMLEY STEPHEN J & E                                         | 4-R11B-37  |
| GX                     | KING JOHN W & LINDA A - TOD                                  | 4-R11B-38  |
| GW                     | MARY ANN HESS REALTY LLC C/O HANNING & ASSOCIATES PLLC       | 4-R11-12   |
| GV                     | LOUGH DONALD H & A J                                         | 4-R11-16   |
| GU                     | LOUGH DONALD H JR & A J                                      | 4-R11-16   |
| GT                     | LAWRENCEFIELD CHAPEL TRUSTEES                                | 4-R11-16   |
| G2                     | PROTESTANT EPISCOPAL CHURCH DIOCESE OF WV TRUSTEES           | 4-R11-16   |
| GR                     | PROTESTANT EPISCOPAL CHURCH DIOCESE OF WV TRUSTEES           | 4-R11-16   |
| GQ                     | KLOS MARIE A                                                 | 4-R11-41   |
| GP                     | DUNKIN RUSSELL W & CHRISTINE E                               | 4-R11F-4   |
| GO                     | ZOLAS DAVID L AND MELINDA SUE                                | 4-R11F-3   |
| GN                     | TAYLOR BRIAN K AND LISA E                                    | 4-R11F-5   |
| GM                     | LAMBERT FREDERICK A & JULIE L                                | 4-R11F-1   |
| GL                     | NIXON RONALD E & MONICA J                                    | 4-R11G-10  |
| GK                     | PORTER THOMAS EARL                                           | 4-R11G-9   |
| GI                     | CORAM SANDRA J                                               | 4-R11F-12  |
| GJ                     | WHITE DONALD J & DEBORAH                                     | 4-R11F-14  |
| GH                     | KIDD MICHAEL J                                               | 4-R11F-13  |
| GD                     | MUSILL DONNA & CHRISTINE K                                   | 4-R11F-15  |
| GF                     | GONGOLA LAWRENCE K JR & JE                                   | 4-R11F-11  |
| GE                     | BLOSSER NANCY K                                              | 4-R11G-4   |
| GD                     | MULL QUAY II TRUST                                           | 4-R11F-21  |
| GC                     | BROTHERS ADAM J & JAMIE L                                    | 4-R11F-25  |
| GB                     | WARNER STEPHANIE R & SCOTT A WADFORD                         | 4-R11F-23  |
| GA                     | MCFARLAND CHRISTOPHER AND ERIN                               | 4-R11F-22  |
| FZ                     | DAGUE DAVID A & MELISSA A                                    | 4-R11F-1   |
| FY                     | HANNA JANE R - TOD                                           | 4-R11F-46  |
| FX                     | HANNA JANE R - TOD                                           | 4-R11F-42  |
| FW                     | POTTERBERG ROBERT & ERIN K                                   | 4-R11F-37  |
| FV                     | KEEFER FRANK JAY - TOD                                       | 4-R11F-21  |
| FU                     | SISTERS OF ST JOSEPH OF WHEELING INC                         | 4-R11F-21  |
| FT                     | SISTERS OF ST JOSEPH OF WHG                                  | 4-R11F-50  |



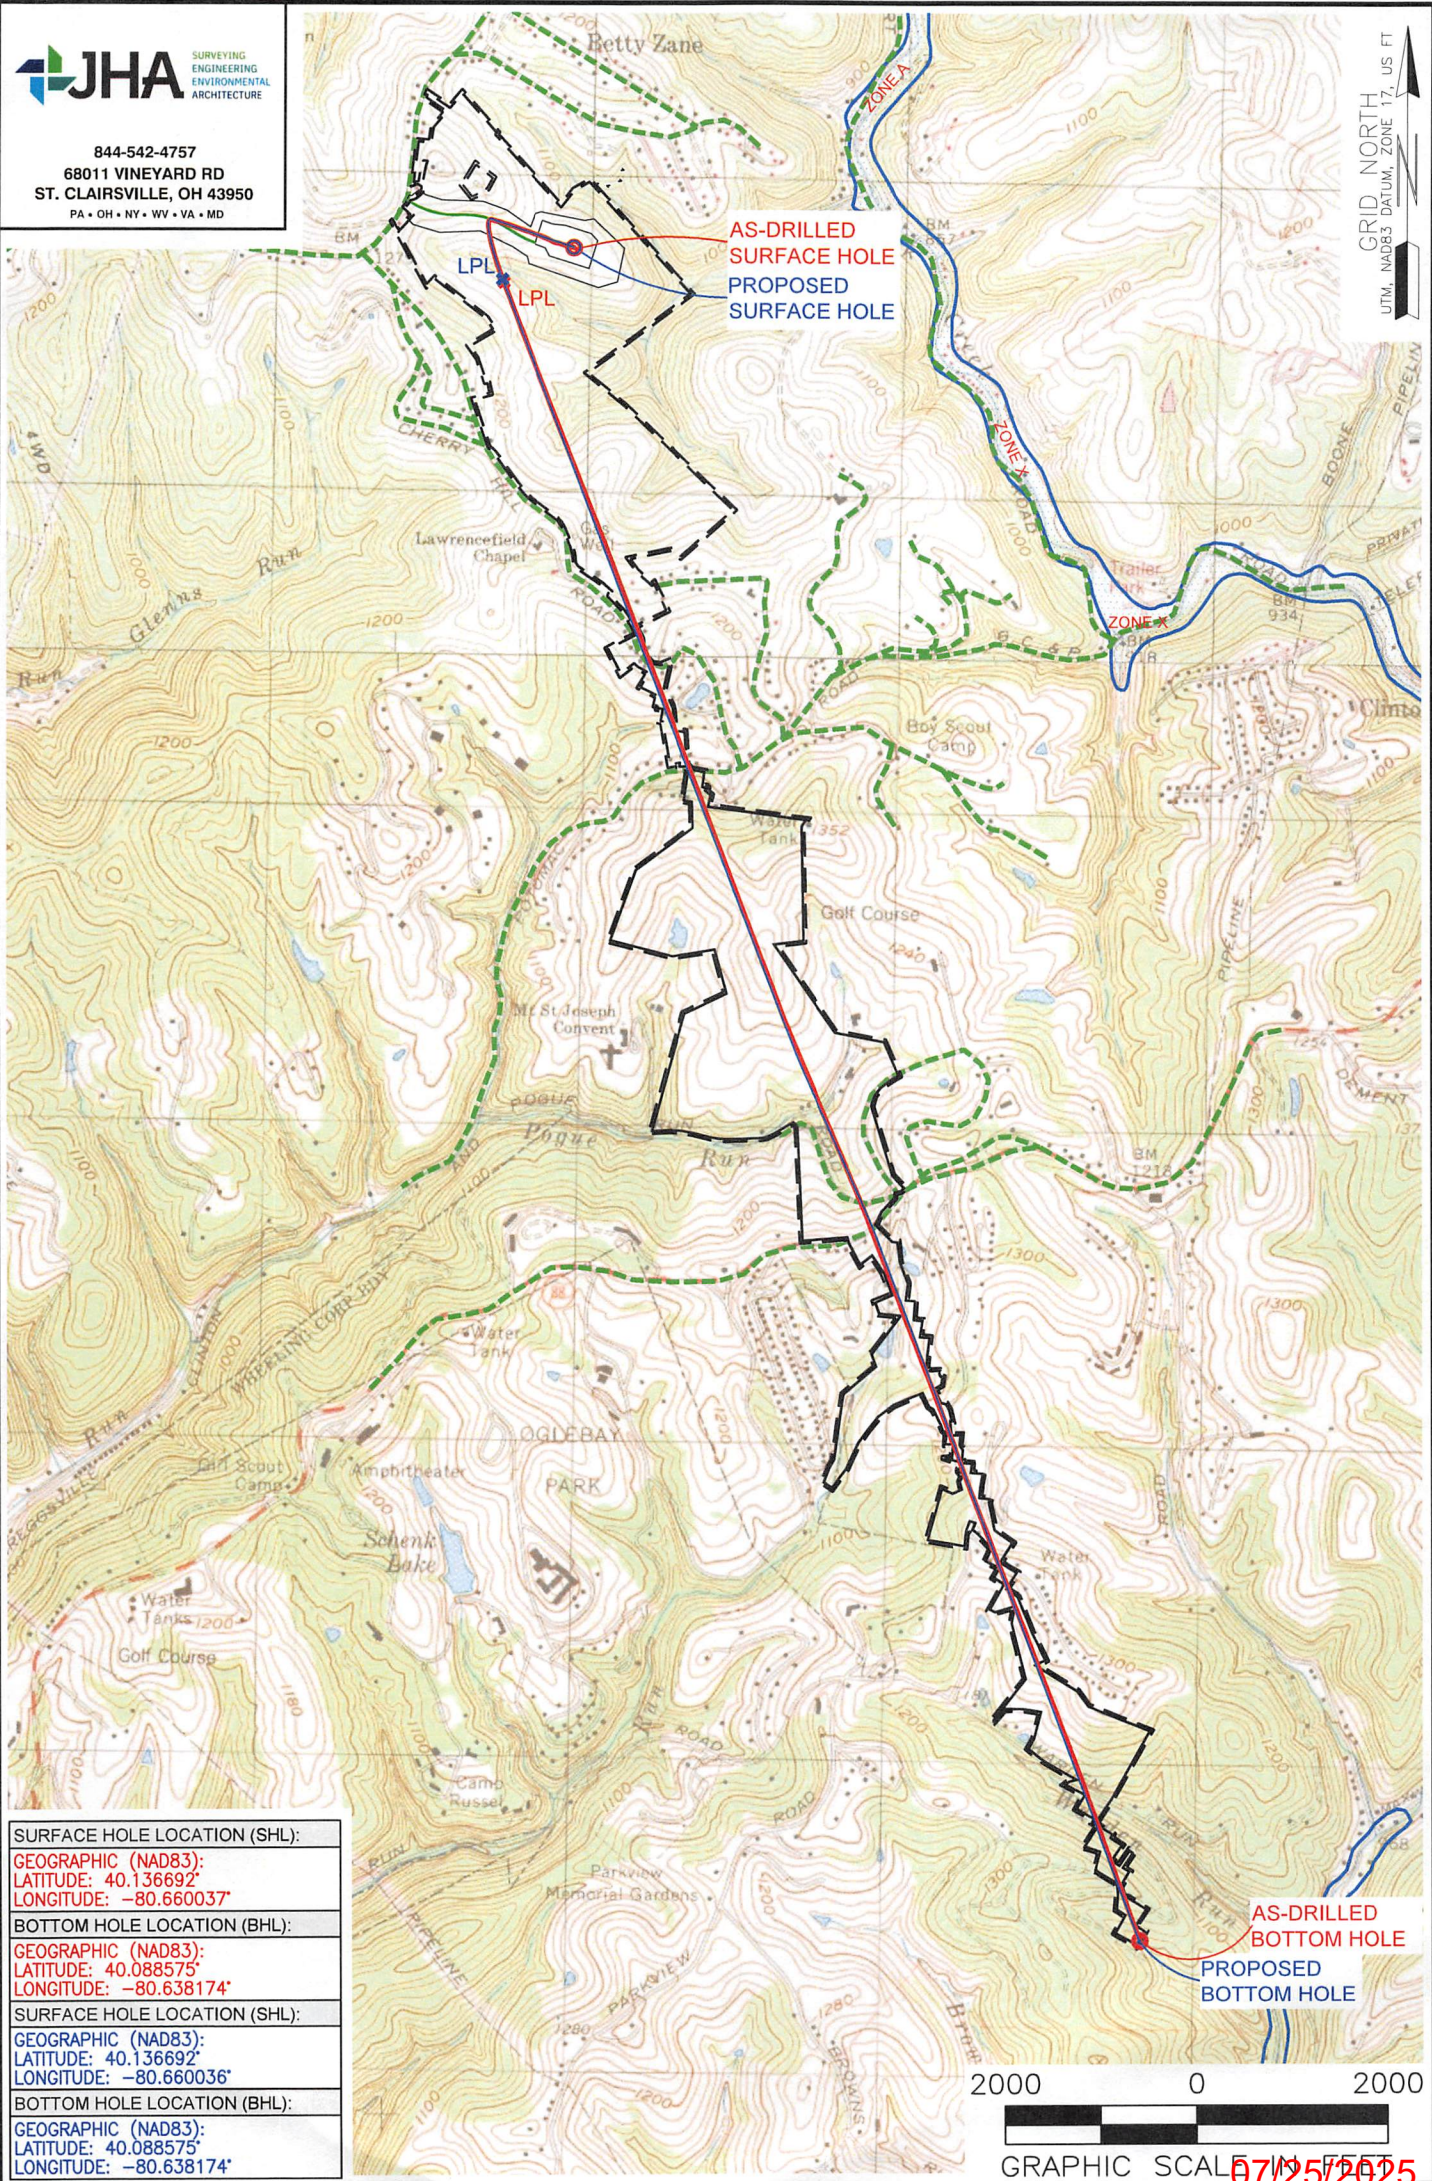

|                              |
|------------------------------|
| SURFACE HOLE LOCATION (SHL): |
| GEOGRAPHIC (NAD83):          |
| LATITUDE: 40.136692°         |
| LONGITUDE: -80.660037°       |
| BOTTOM HOLE LOCATION (BHL):  |
| GEOGRAPHIC (NAD83):          |
| LATITUDE: 40.088575°         |
| LONGITUDE: -80.638174°       |
| SURFACE HOLE LOCATION (SHL): |
| GEOGRAPHIC (NAD83):          |
| LATITUDE: 40.136692°         |
| LONGITUDE: -80.660036°       |
| BOTTOM HOLE LOCATION (BHL):  |
| GEOGRAPHIC (NAD83):          |
| LATITUDE: 40.088575°         |
| LONGITUDE: -80.638174°       |

NOTES ON SURVEY

1. SURFACE AND ROYALTY OWNER INFORMATION AND THEIR BOUNDARIES SHOWN HEREON WERE PLOTTED FROM DEEDS AND/OR TAX PARCEL MAPS PROVIDED BY CLIENT AND/OR FIELD LOCATIONS.
2. THIS PLAT DOES NOT REPRESENT A BOUNDARY SURVEY OF THE PARCELS SHOWN HEREON.
3. ALL INSETS ARE GRID NORTH UNLESS OTHERWISE DEPICTED.

LEGEND:

- EXISTING BOTTOM HOLE
- EXISTING / PRODUCING WELLHEAD
- LPL EXISTING LANDING POINT LOCATION
- PROPOSED SURFACE HOLE / BOTTOM HOLE
- LPL PROPOSED LANDING POINT LOCATION
- ACCESS ROAD
- PUBLIC ROAD
- FLOOD PLAIN
- LEASE BOUNDARY
- ASDRILLED PATH
- PROPOSED PATH

|                                                                       |                                                       |              |                       |
|-----------------------------------------------------------------------|-------------------------------------------------------|--------------|-----------------------|
| WELL OPERATOR:<br>SWN PRODUCTION COMPANY, LLC                         | WELL (FARM) NAME:<br>FRANZ THOMAN OHI                 | WELL #<br>6H | SERIAL #<br>XXXX      |
| ADDRESS:<br>1300 FORT PIERPONT DRIVE, SUITE 201, MORGANTOWN, WV 26508 | COUNTY:<br>OHIO                                       | CODE:<br>069 | API #<br>47-069-00370 |
| SURFACE OWNER:<br>FRANZ THOMAN                                        | USGS 7 1/2 QUADRANGLE MAP NAME:<br>TILTONVILLE, OH-WV |              |                       |