

LATITUDE: 40°10'00" SURFACE HOLE (2000' SCALE)

9805'

7652'



844-542-4757
68011 VINEYARD RD
ST. CLAIRSVILLE, OH 43950
PA • OH • NY • WV • VA • MD

LATITUDE: 40°05'00" BOTTOM HOLE (2000' SCALE)

GRID NORTH
UTM, NAD83 DATUM, ZONE 17, US FT



5956'

10942'

LONGITUDE: 80°37'30" BOTTOM HOLE (2000' SCALE)

LONGITUDE: 80°37'30" SURFACE HOLE (2000' SCALE)

LINE	BEARING	DISTANCE
L1	N55°36'47"W	1071.93'
L2	N80°25'32"W	1327.77'

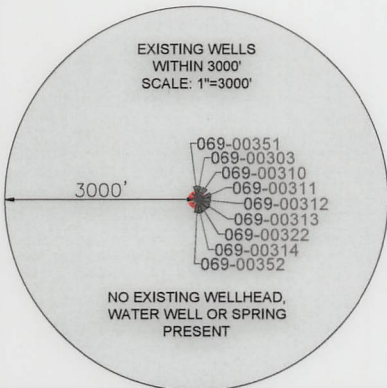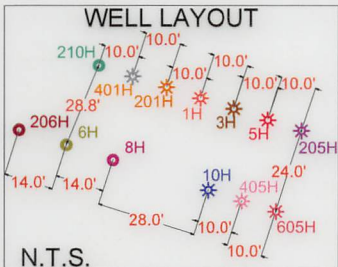

SURFACE HOLE LOCATION (SHL):	SURFACE HOLE LOCATION (SHL):
UTM (NAD83, ZONE 17, METERS): NORTHING: 4442985.53 EASTING: 528957.21	UTM (NAD83, ZONE 17, METERS): NORTHING: 4442985.47 EASTING: 528957.17
LANDING POINT LOCATION (LPL):	LANDING POINT LOCATION (LPL):
UTM (NAD83, ZONE 17, METERS): NORTHING: 4443160.48 EASTING: 528317.74	UTM (NAD83, ZONE 17, METERS): NORTHING: 4443177.26 EASTING: 528315.38
BOTTOM HOLE LOCATION (BHL):	BOTTOM HOLE LOCATION (BHL):
UTM (NAD83, ZONE 17, METERS): NORTHING: 4439865.87 EASTING: 529622.85	UTM (NAD83, ZONE 17, METERS): NORTHING: 4439867.51 EASTING: 529626.41

NOTES ON SURVEY

- COORDINATE SYSTEM IS UTM NAD 83 DATUM, ZONE 17, U.S. FOOT AND WELL COORDINATES ESTABLISHED USING SURVEY GRADE GPS.
- SURFACE AND ROYALTY OWNER INFORMATION AND THEIR BOUNDARIES SHOWN HEREON WERE PLOTTED FROM DEEDS AND/OR TAX PARCEL MAPS PROVIDED BY CLIENT AND/OR FIELD LOCATIONS.
- THIS PLAT DOES NOT REPRESENT A BOUNDARY SURVEY OF THE PARCELS SHOWN HEREON.
- NO DWELLINGS OR BUILDINGS WITHIN 625 FEET OF PROPOSED CENTER OF PAD.
- NO PERENNIAL STREAMS, LAKES, PONDS, RESERVOIRS OR WETLANDS WITHIN 100 FEET OF THE LIMITS OF DISTURBANCE.
- NO NATURALLY PRODUCING TROUT STREAM WITHIN 300 FEET OF THE LIMITS OF DISTURBANCE.
- NO WATER WELLS OR DEVELOPED SPRINGS WITHIN 250 FEET OF PROPOSED WELL.

I, THE UNDERSIGNED, HEREBY CERTIFY THAT THIS PLAT IS CORRECT TO THE BEST OF MY KNOWLEDGE AND BELIEF AND SHOWS ALL THE INFORMATION REQUIRED BY LAW AND REGULATIONS ISSUED AND PRESCRIBED BY THE DEPARTMENT OF ENVIRONMENTAL PROTECTION.

P.E. 19809



2000 0 2000

GRAPHIC SCALE IN FEET

COMPANY: **SWN** **SWN** ^{P-V+}
Production Company, LLC Production Company™

	(+) DENOTES LOCATION OF WELL ON UNITED STATES TOPOGRAPHIC MAPS	MINIMUM DEGREE OF ACCURACY: 1/200	FRANZ THOMAN OHI		
	WVDEP OFFICE OF OIL & GAS 601 57TH STREET CHARLESTON, WV 25034	PROVEN SOURCE OF ELEVATION: SURVEY GRADE GPS (NAVD 88, US FT)	OPERATOR'S WELL #:	206H	
			API WELL #:	47	069 00371
			STATE	COUNTY	PERMIT

WELL TYPE: OIL ☐ WASTE DISPOSAL ☐ PRODUCTION ☒ DEEP ☐ GAS ☒ LIQUID INJECTION ☐ STORAGE ☐ SHALLOW ☒	ELEVATION: 1,137.0'
WATERSHED: UPPER OHIO SOUTH	QUADRANGLE: TILTONSVILLE & WHEELING, OH-WV
DISTRICT: RICHLAND	COUNTY: OHIO
SURFACE OWNER: FRANZ THOMAN	ACREAGE: ±69.418
OIL & GAS ROYALTY OWNER: FRANZ THOMAN	ACREAGE: ±69.418
DRILL ☐ DRILL DEEPER ☐ REDRILL ☐ FRACTURE OR STIMULATE ☐ PLUG OFF OLD FORMATION ☐ PERFORATE NEW FORMATION ☐	09/26/2025
CONVERT ☐ PLUG & ABANDON ☐ CLEAN OUT & REPLUG ☐ OTHER CHANGE ☒ (SPECIFY) AS-DRILLED	ESTIMATED DEPTH: 5,966' TVD 18,624' TMD
TARGET FORMATION: MARCELLUS	

WELL OPERATOR: SWN PRODUCTION COMPANY, LLC	DESIGNATED AGENT: BRITTANY WOODY
ADDRESS: 1300 FORT PIERPONT DRIVE, SUITE 201	ADDRESS: 1300 FORT PIERPONT DRIVE, SUITE 201
CITY: MORGANTOWN	CITY: MORGANTOWN
STATE: WV	STATE: WV
ZIP CODE: 26508	ZIP CODE: 26508
LEGEND:	REVISIONS:
EXISTING BOTTOM HOLE	ACCESS ROAD
EXISTING / PRODUCING WELLHEAD	PUBLIC ROAD
EXISTING LANDING POINT LOCATION	FLOOD PLAIN
PROPOSED SURFACE HOLE / BOTTOM HOLE	LEASE BOUNDARY
PROPOSED LANDING POINT LOCATION	ASDRILLED PATH
	PROPOSED PATH
	DATE: 02-21-2025
	API NO: 47-069-00371
	DRAWN BY: Z.WOOD
	SCALE: 1" = 2000'
	DRAWING NO: 2018-781
	WELL LOCATION PLAT

LATITUDE: 40°10'00" SURFACE HOLE (2000' SCALE)

9805'




7652'

LATITUDE: 40°05'00" BOTTOM HOLE (2000' SCALE)



844-542-4757
68011 VINEYARD RD
ST. CLAIRSVILLE, OH 43950
PA • OH • NY • WV • VA • MD

LINE	BEARING	DISTANCE
L1	N55°36'47"W	1071.93'
L2	N80°25'32"W	1327.77'

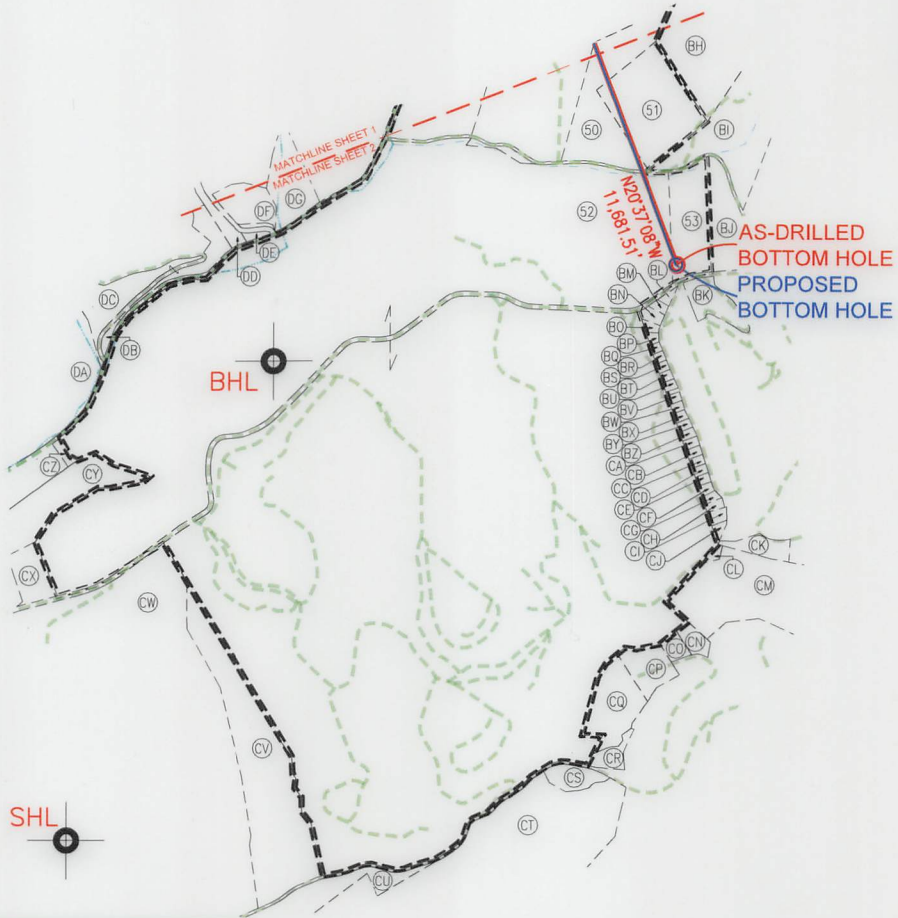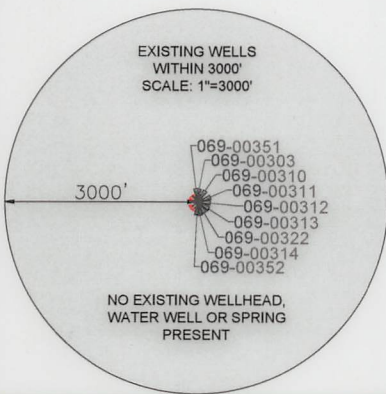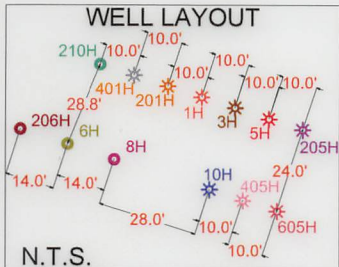

GRID NORTH
UTM, NAD83 DATUM, ZONE 17, US FT


5956'

10942'

LONGITUDE: 80°37'30" BOTTOM HOLE (2000' SCALE)

LONGITUDE: 80°37'30" SURFACE HOLE (2000' SCALE)

SURFACE HOLE LOCATION (SHL): UTM (NAD83, ZONE 17, METERS): NORTHING: 4442985.53 EASTING: 528957.21	SURFACE HOLE LOCATION (SHL): UTM (NAD83, ZONE 17, METERS): NORTHING: 4442985.47 EASTING: 528957.17
LANDING POINT LOCATION (LPL): UTM (NAD83, ZONE 17, METERS): NORTHING: 4443160.48 EASTING: 528317.74	LANDING POINT LOCATION (LPL): UTM (NAD83, ZONE 17, METERS): NORTHING: 4443177.26 EASTING: 528315.38
BOTTOM HOLE LOCATION (BHL): UTM (NAD83, ZONE 17, METERS): NORTHING: 4439865.87 EASTING: 529622.85	BOTTOM HOLE LOCATION (BHL): UTM (NAD83, ZONE 17, METERS): NORTHING: 4439867.51 EASTING: 529626.41

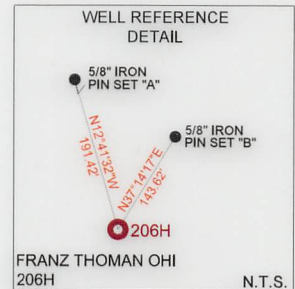

NOTES ON SURVEY

- COORDINATE SYSTEM IS UTM NAD 83 DATUM, ZONE 17, U.S. FOOT AND WELL COORDINATES ESTABLISHED USING SURVEY GRADE GPS.
- SURFACE AND ROYALTY OWNER INFORMATION AND THEIR BOUNDARIES SHOWN HEREON WERE PLOTTED FROM DEEDS AND/OR TAX PARCEL MAPS PROVIDED BY CLIENT AND/OR FIELD LOCATIONS.
- THIS PLAT DOES NOT REPRESENT A BOUNDARY SURVEY OF THE PARCELS SHOWN HEREON.
- NO DWELLINGS OR BUILDINGS WITHIN 625 FEET OF PROPOSED CENTER OF PAD.
- NO PERENNIAL STREAMS, LAKES, PONDS, RESERVOIRS OR WETLANDS WITHIN 100 FEET OF THE LIMITS OF DISTURBANCE.
- NO NATURALLY PRODUCING TROUT STREAM WITHIN 300 FEET OF THE LIMITS OF DISTURBANCE.
- NO WATER WELLS OR DEVELOPED SPRINGS WITHIN 250 FEET OF PROPOSED WELL.

I, THE UNDERSIGNED, HEREBY CERTIFY THAT THIS PLAT IS CORRECT TO THE BEST OF MY KNOWLEDGE AND BELIEF AND SHOWS ALL THE INFORMATION REQUIRED BY LAW AND REGULATIONS ISSUED AND PRESCRIBED BY THE DEPARTMENT OF ENVIRONMENTAL PROTECTION.

P.E. 19809



2000 0 2000

GRAPHIC SCALE IN FEET

COMPANY:



SWN

SWN


Production Company, LLC Production Company™

	(+) DENOTES LOCATION OF WELL ON UNITED STATES TOPOGRAPHIC MAPS	MINIMUM DEGREE OF ACCURACY: 1/200	FRANZ THOMAN OHI		
	WVDEP OFFICE OF OIL & GAS 601 57TH STREET CHARLESTON, WV 25034	PROVEN SOURCE OF ELEVATION: SURVEY GRADE GPS (NAVD 88, US FT)	OPERATOR'S WELL #:	206H	
			API WELL #:	47	069 00371
			STATE	COUNTY	PERMIT
WELL TYPE: OIL ☐ WASTE DISPOSAL ☐ PRODUCTION ☒ DEEP ☐ GAS ☒ LIQUID INJECTION ☐ STORAGE ☐ SHALLOW ☒					
WATERSHED: UPPER OHIO SOUTH			ELEVATION: 1,137.0'		
DISTRICT: RICHLAND COUNTY: OHIO			QUADRANGLE: TILTONSVILLE & WHEELING, OH-WV		
SURFACE OWNER: FRANZ THOMAN			ACREAGE: ±69.418		
OIL & GAS ROYALTY OWNER: FRANZ THOMAN			ACREAGE: ±69.418		
DRILL ☐ DRILL DEEPER ☐ REDRILL ☐ FRACTURE OR STIMULATE ☐ PLUG OFF OLD FORMATION ☐ PERFORATE NEW FORMATION ☐					
CONVERT ☐ PLUG & ABANDON ☐ CLEAN OUT & REPLUG ☐ OTHER CHANGE ☒ (SPECIFY) AS-DRILLED			09/26/2025		
TARGET FORMATION: MARCELLUS			ESTIMATED DEPTH: 5,966' TVD 18,624' TMD		
WELL OPERATOR: SWN PRODUCTION COMPANY, LLC			DESIGNATED AGENT: BRITTANY WOODY		
ADDRESS: 1300 FORT PIERPONT DRIVE, SUITE 201			ADDRESS: 1300 FORT PIERPONT DRIVE, SUITE 201		
CITY: MORGANTOWN STATE: WV ZIP CODE: 26508			CITY: MORGANTOWN STATE: WV ZIP CODE: 26508		
LEGEND: ● EXISTING BOTTOM HOLE ★ EXISTING / PRODUCING WELLHEAD LPL ★ EXISTING LANDING POINT LOCATION ● PROPOSED SURFACE HOLE / BOTTOM HOLE LPL ★ PROPOSED LANDING POINT LOCATION			REVISIONS: DATE: 02-21-2025 API NO: 47-069-00371 DRAWN BY: Z.WOOD SCALE: 1" = 2000' DRAWING NO: 2018-781 WELL LOCATION PLAT		
— ACCESS ROAD — PUBLIC ROAD — FLOOD PLAIN — LEASE BOUNDARY — AS-DRILLED PATH — PROPOSED PATH					

INSET "I"
N.T.S.

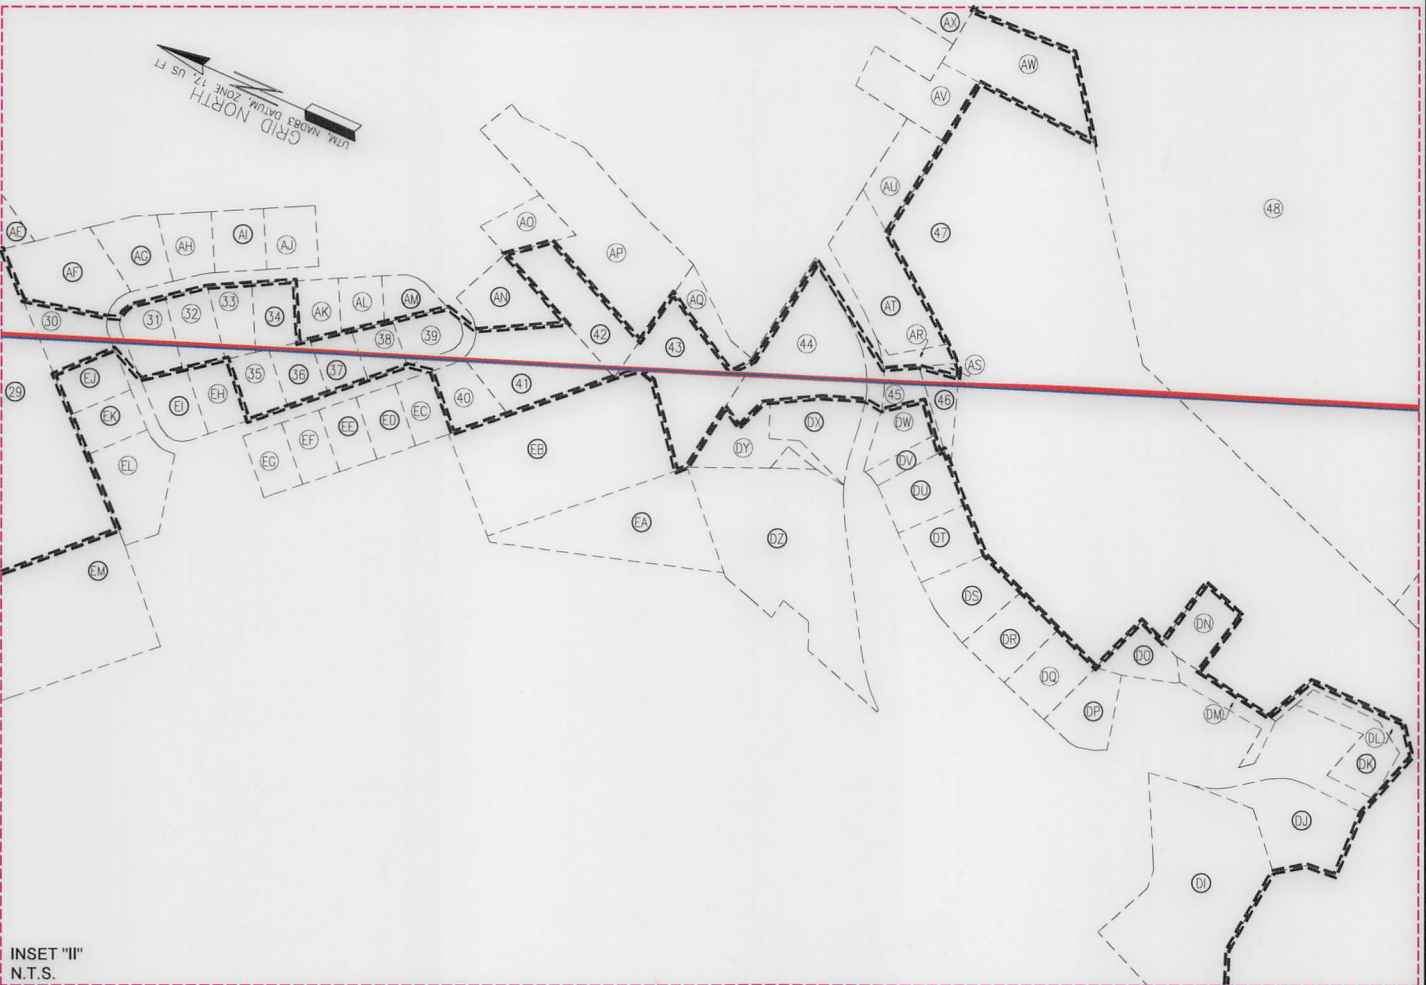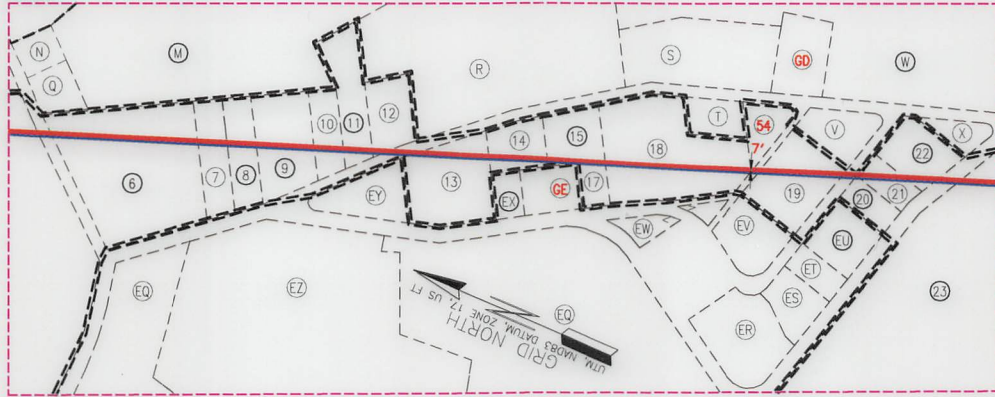

INSET "II"
N.T.S.

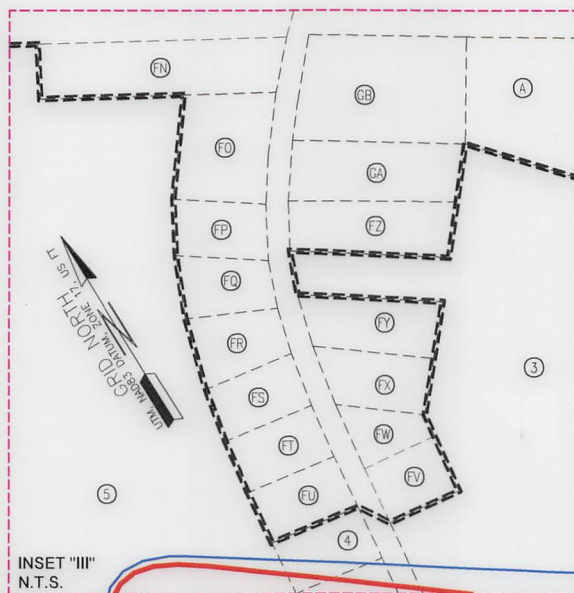

INSET "III"
N.T.S.

09/26/2025

REVISIONS:

COMPANY:

SWN
Production Company, LLC

SWN ^{R-V+}
Production Company™

OPERATOR'S

FRANZ THOMAN OHI

WELL #:

206H

DISTRICT:
RICHLAND

COUNTY:
OHIO

STATE:
WV

DATE: 02-21-2025

API NO: 47-069-00371

DRAWN BY: Z.WOOD

SCALE: N/A

DRAWING NO: 2018-781

WELL LOCATION PLAT

WELL BORE TABLE FOR SURFACE/ROYALTY OWNERS			ADJOINING OWNERS TABLE		
TRACT	SURFACE OWNER (S) / ROYALTY OWNER (R)	TAX PARCEL	TRACT	SURFACE OWNER	TAX PARCEL
1	THOMAN FRANZ (S) / (R)	4-R8-62	K	SANDCREST FOUNDATION INC	4-R11-15
TRACT	SURFACE OWNER	TAX PARCEL	L	TUNNEL RIDGE LLC	4-R8-62.5
2	MAJEWSKI KASMIR MAJEWSKI EDWARD A	4-R8-62.2	M	TUNNEL RIDGE LLC	4-R8-62.4
3	MAJEWSKI KASMIR MAJEWSKI EDWARD A	4-R8-62.8	N	TUNNEL RIDGE LLC	4-R8P-14
4	MCGEE JOHN M	4-R8P-17	O	TUNNEL RIDGE LLC	4-R8P-16
5	CRAFT JOSEPH W III FOUNDATION	4-R8-51	P	WEAVER SHIRLEY M	4-R8P-2
6	TUNNEL RIDGE LLC	4-R8P-1	Q	TUNNEL RIDGE LLC	4-R8P-15
7	COTTRELL CLARA M	4-R8P-3	R	NEUMANN KURT ROBERT	4-R11-13
8	IVERSON DERRICK H & BARBARA A	4-R8P-4	S	GUTHRIE JEREMY L & GUTHRIE ANNE N MOLNAR	4-R11-13.3
9	STOLLAR HEATHER D	4-R8P-5	T	MOLNAR KRISTINE N	4-R11B-16.1
10	WEST WINSTON W JR	4-R8P-6	U	REMOVED	REMOVED
11	WEST WINSTON W JR	4-R8P-7	V	TRABERT JEFFREY A & T L	4-R11B-20
12	METZ MATTHEW R	4-R8P-8	W	MOLNAR KRISTINE N	4-R11-13.4
13	LINTON MARK D & CHERYL A BROZOVICH	4-R11B-2	X	KING JOHN W & LINDA A - TOD	4-R11B-38
14	BROTHERS TASHINA M	4-R11B-7	Y	MOLNAR KRISTINE N	4-R11-16.4
15	SEAMON RUTH E	4-R11B-9	Z	STERN SHAWN G & AIMEE M	4-R11-16.13
16	REMOVED	REMOVED	AA	PROTESTANT EPISCOPAL CHURCH DIOCESE OF WV TRUSTEES	4-R11-16.2
17	BURNS WILLIAM D & JILL R	4-R11B-10	AB	GILL RONNIE AND GRETCHEN	4-R11-16.6
18	SEAMON JEFFREY	4-R11B-11	AC	LAFLAM DAVID T & BRANDY JO	4-R11F-5
19	SEAMON RUTH E	4-R11B-23	AD	DUNKIN RUSSELL W & CHRISTINE E	4-R11F-4
20	ZANE TIMOTHY D	4-R11B-35	AE	NICKERSON DAVID M & NORMA J	4-R11F-9
21	VARGO RONALD J	4-R11B-36	AF	KLUG MATTHEW F & ANNE J	4-R11F-24
22	LEMLEY STEPHEN J & E	4-R11B-37	AG	ROBBINS DIANE L	4-R11F-23
23	MARY ANN HESS REALTY LLC C/O HANNIG & ASSOCIATES PLLC	4-R11-12	AH	MEDOVIC TY A	4-R11F-22
24	LOUGH DONALD H JR & A L	4-R11-16.12	AI	GIANNANGELI ERIC & MOLLY	4-R11F-21
25	LOUGH DONALD H & A L	4-R11-16.9	AJ	HIGH MATTHEW C & TINA M	4-R11K-66
26	LAWRENCEFIELD CHAPEL TRUSTEES	4-R11-16.8	AK	CARP MICHAEL R & PAIGE L	4-R11K-63
27	SEBULSKY RONALD J	4-R11-16.15	AL	GOODRICH WILLIAM T & CHERYL L	4-R11K-62
28	MOORE SARAH & ERIC MILHOAN	4-R11F-10	AM	PHILLIPS KEITH R AND TERRY L	4-R11K-61
29	JONES ROBERT E MD INC	4-R11-17	AN	ECKMAN JUSTIN D & EMILY F	4-R11K-45
30	LYONS KEITH J & REDESSA	4-R11F-25	AO	PARKER THOMAS W & JACQUELINE	4-R11L-48.5
31	ROBBINS DOUGLAS L & KELLIE A	4-R11F-30	AP	GAUDINO THOMAS R & THERESA M	4-R11L-48.10
32	GESSLER JENNA A	4-R11F-29	AQ	GRAY DEBORAH J - TOD	4-R11L-48.12
33	LEWIS KENT J & HEATHER R	4-R11K-65	AR	SISTERS OF SAINT JOSEPH OF WHEELING INC	4-R11-21.39
34	BERARDINELLI JON & JAN IRREVOCABLE TRUST	4-R11K-64	AS	MURRAY WILLIAM M JR & SHELLY L	4-R11-21.41
35	SCHNARR BRAD & RASHELLE	4-R11K-56	AT	WAYNE GEORGANN R & HOWARD N JR	4-R11-21.11
36	WHITE AARON L & KRISTEN A	4-R11K-57	AU	KUCHINSKI KELLY A & SHANNON M	4-R11-21.12
37	CUNNINGHAM BRIAN S & PENNY L	4-R11K-58	AV	TENNANT BRANDON M	4-R11L-36
38	SLATER ELISABETH A	4-R11K-59	AW	KEEFER FRANK JAY - TOD	4-R11-21.28
39	MYERS STEVEN J & ELIZABETH A	4-R11K-60	AX	KEEFER F JAY	4-R11L-39
40	CAMPBELL RUSSELL B & JESSICA A	4-R11K-47.1	AY	RICE BLAISE A	4-R11L-31
41	PAJAK WILLIAM J JR	4-R11K-46	AZ	SPIELVOGEL TODD J	4-R11L-32
42	PAJAK WILIAM J JR	4-R11L-48.11	BA	RUCKMAN MARY ANN TRUST K CUSTER & D BAUKNECHT TEES	4-R11L-29
43	STEWART F HOWARD & STEWART MARY CATHERINE	4-R11L-48	BB	RUCKMAN MARY ANN TRUST K CUSTER & D BAUKNECHT TEES	4-R11L-28
44	STEWART F HOWARD & M C	4-R11K-31	BC	PASCOLI BARTLEY EDWARD & SEAN WYLIE PASCOLI	4-R11-23
45	MURRAY WILLIAM M JR & SHELLY L	4-R11-21.40	BD	OHIO COUNTY PUBLIC SERVICE DISTRICT	4-R11-21.42
46	MURRAY WILLIAM M JR & SHELLY L	4-R11-21.35	BE	PARKS SYSTEM TRUST	4-R11-21.43
47	SISTERS OF ST JOSEPH OF WHEELING INC	4-R11-21	BF	WHEELING PARK COMMISSION	4-R11-21.7
48	WHEELING PARK COMMISSION	4-R11-21.5	BG	WHEELING PARK COMMISSION	4-R11-21.6
49	SISTERS OF ST JOSEPH OF WHG	4-R11-20	BH	WHEELING PARK COMMISSION	4-R11-21.4
50	PARKS SYSTEM TRUST FUND OF WHEELING	4-R11-21.3	BI	WHEELING PARK COMMISSION	4-R14-20.4
51	WHEELING PARK COMMISSION	4-R14-91	BJ	WHEELING PARK COMMISSION	4-R14-15.1
52	CITY OF WHEELING	4-R14-15	BK	RECCHIO RONALD & AMANDA	4-R14G-15.10
53	WHEELING PARK COMMISSION	4-R14-15.2	BL	HOSFELT WILLIAM J & PATRICIA HOSFELT ESTATES	10-W12D-2
54	MOLNAR KRISTINE N	4-R11B-16	BM	RANSOM CHARLES M & CRYSTAL G	10-W12D-1
ADJOINING OWNERS TABLE			BN	DIVINEY MARY F & TOMMY S JR	10-W14D-1
TRACT	SURFACE OWNER	TAX PARCEL	BO	SATTERFIELD DOROTHY & MARY KAY FAHEY	10-W14D-2
A	TAYLOR DELORA L - TOD	4-R8K-100	BP	TUCKER ROBERT A & R	10-W14D-3
B	SOBOTA SUSAN J	4-R8-62.3	BQ	MCKINLEY BETTY J	10-W14D-4
C	WRIGHT JOHN T & MELINDA L	4-R8P-11	BR	WORKMAN WHITNEY SAMARA	10-W14D-5
D	SUTTON JACQUELINE M	4-R8Q-10	BS	QUEEN THOMAS R & CYNTHIA A	10-W14D-6
E	DAGUE AMY D	4-R8Q-11	BT	RIGGS DAVID V & KERRIE L	10-W14D-7
F	WHEELER JOLLY W JR & K M	4-R8Q-14	BU	ROBINSON TONY A	10-W14D-8
G	TAROVISKY FRANK J & S R - TOD	4-R8Q-28	BV	BTCT RENTALS LLC	10-W14D-9
H	TOMASIK PAULA J & EDWARD C	4-R8Q-3	BW	KUHAR DOROTHY RES'V L/E KUHAU CHRISTINE	10-W14D-10
I	TERAMANA RUSSELL & ROSEANN	4-R8Q-2	BX	BASSI ALBERTO & THAIANE N LIMA	10-W14D-11
J	HUFFMAN KENDRA L & RALPH J	4-R8Q-60			

REVISIONS:	COMPANY: SWN Production Company, LLC SWN Production Company™			DATE: 02-21-2025	
				API NO: 47-069-00371	
				DRAWN BY:Z.WOOD	
				SCALE: N/A	
				DRAWING NO:2018-781	
	OPERATOR'S	FRANZ THOMAN OHI			
	WELL #:	206H			
	DISTRICT:	COUNTY:	STATE:		
	RICHLAND	OHIO	WV		
				WELL LOCATION PLAT	


09/26/2025

ADJOINING OWNERS TABLE		
TRACT	SURFACE OWNER	TAX PARCEL
BY	PEARCE CRAGO PAULA	10-W14D-12
BZ	SMITH CODY A	10-W14D-13
CA	WHITE CHARLES T & SUSAN B	10-W14D-14
CB	DOEPKEN DAVID W & CHRISTINE B	10-W14D-15
CC	BAUER JESSICA L & CHAD	10-W14D-16
CD	NEUMAN CHARLES & B J WOTRING	10-W14D-17
CE	YOUNG MARK K & SAMANTHA	10-W14D-18
CF	PETRI DANIEL S & D	10-W14D-19
CG	WATSON STEVEN A & SHERI	10-W17D-2
CH	HANNA STEPHEN L & C H	10-W17D-3
CI	MILLER DAVID W & JUNKERSFELD PETER J	10-W17D-4
CJ	MILLER DAVID W & JUNKERSFELD P	10-W17D-5
CK	FITZSIMMONS CLAYTON J	4-R14-46.13
CL	MCBANE DANIEL & CLARE FAMILY TRUST	10-W17D-6
CM	WHEELING PARK COMMISSION	10-W17D-7
CN	LAPP SAMUEL J II & HEATHER A	4-R14-50.1
CO	GOMPERS KATHLEEN M	4-R14-50.3
CP	GOMPERS KATHLEEN M	4-R14-50.2
CQ	FRIEND HARRIETTE E FRIEND L EDWARD II	4-R14-51
CR	HITCHMAN HELEN G	4-R14-53
CS	BURGE EDWARD LEE JR	4-R17-8.1
CT	PARK VIEW MEMORIAL GARDENS INC	4-R17-8
CU	GACS LP	10-W27A-1
CV	WHEELING PARK COMMISSION	4-R14-14.1
CW	ELM HILL HOLDINGS LLC	4-R14-14
CX	SCHULTZ JEFFREY S	4-R14-13
CY	WHEELING PARK COMMISSION	10-W17A-1
CZ	PELUCETTE JOHN M & C L	4-R14J-1
DA	POLACK EDWARD P	4-R14-95
DB	ALLEN AMY & THOMAS E JR (BYRS) ALLEN THOMAS E (LC-SLR)	4-R14E-4
DC	SUNSHINE STATE INV GROUP LLC	4-R14A-53
DD	SCHMITT JAMES A	4-R14-4.6
DE	SCHMITT JAMES A	4-R14-4.5
DF	CALVERT GROVE ANDREW	4-R14-6.1
DG	LONG RUN PET HOSPITAL INC	4-R14-6
DH	JONES WILBUR S JR JEFFERSON JOYCE P	4-R14-90
DI	CARPENTER DAVID & KATHERINE R	4-R11-21.9
DJ	GERLING MILDRED ET AL	4-R11-21.22
DK	KLUG ELEANOR L	4-R11-21.29
DL	KLUG ELEANOR L	4-R11-21.31
DM	FRASNELLI ROBERT V & R A	4-R11-21.23
DN	FRASNELLI ROBERT V & R A	4-R11-21.34
DO	DURDINES JOHN MICHAEL JR	4-R11-21.25
DP	DURDINES JOHN MICHAEL JR	4-R11-21.10
DQ	RANDOLPH ROBERT A & B A	4-R11-21.17
DR	WOJCIK FRANK B & F A	4-R11-21.19
DS	BALLARD RICHARD W & S M	4-R11-21.18
DT	VALPUT JEFFREY J	4-R11-21.14
DU	MEACHAM BRETT W & REBECCA W	4-R11-21.16
DV	MURRAY WILLIAM H JR & S L	4-R11-21.15
DW	MURRAY WM H JR & S L	4-R11-21.8
DX	KALB HEATHER J	4-R11K-30.2
DY	MORGAN SHARON - TOD	4-R11K-30
DZ	MORGAN SHARON - TOD	4-R11K-32
EA	FARMER MARK S AND ILDIKO K	4-R11K-28.5
EB	FARMER MARK S AND ILDIKO K	4-R11K-28.3
EC	CAMPBELL RUSSELL B & JESSICA A	4-R11K-47
ED	TEACHOUT RICHARD M & ELAINE	4-R11K-49
EE	LAFLAM THOMAS M & STEPHANIE A	4-R11K-50
EF	MORRELL FAMILY TRUST	4-R11K-51
EG	MCDONALD ETHAN & JO LYN	4-R11K-52
EH	COMBS ADAM E & KATHLEEN R	4-R11K-55
EI	TODD PHILIP L & PEGGY E	4-R11F-31
EJ	MCCONNELL CRAIG A & LAVINA J	4-R11F-26
EK	BLANTON BRETT M & BLANTON AMELIA K	4-R11F-27
EL	PARKER JASON & STACY	4-R11F-28
EM	KENAMOND PENNY J	4-R11-17.1

ADJOINING OWNERS TABLE		
TRACT	SURFACE OWNER	TAX PARCEL
EN	JONES ROBERT E MD INC	4-R11-16.10
EO	SEBULSKY RONALD J	4-R11-16.5
EP	JONES ROBERT E MD INC	4-R11-16.3
EQ	MARY ANN HESS REALTY LLC C/O HANNIG & ASSOCIATES PLLC	4-R8-53
ER	PATERNO JOSEPH III	4-R11B-29
ES	MAXWELL MARY ANN	4-R11B-31
ET	MAXWELL MARY ANN	4-R11B-32
EU	ZANE TIMOTHY D	4-R11B-33
EV	SEAMON RUTH E	4-R11B-24
EW	NAEGELE ALAN SANDSTORM MARY ANN	4-R11B-26
EX	DESTEFANO BART & NANCY E	4-R11B-5
EY	TEUFEL ERNESTINE M	4-R8P-9
EZ	MATUSIC KAREN P & ALAN D GEORGE	4-R8-53.1
FA	MARY ANN HESS REALTY LLC C/O HANNIG & ASSOCIATES PLLC	4-R8-53
FB	MARY ANN HESS REALTY LLC C/O HANNIG & ASSOCIATES PLLC	4-R8N-10
FC	LITTEN PATRICIA J	4-R8N-8
FD	MURRAY JOSEPH B & SYLVIA J	4-R8N-7
FE	ORKOSKEY JANET K	4-R8N-11
FF	SHELL HOLLY L	4-R8N-12
FG	SHELL HOLLY L	4-R8N-13
FH	SMITH W EVERETT & JOLINDA STEINER	4-R8N-14
FI	TUNNELL RIDGE LLC	4-R8-67
FJ	TUNNEL RIDGE LLC	4-R8-79
FK	CRAFT JOSEPH W III FOUNDATION	4-R8-63.2
FL	CRAFT JOSEPH W III FOUNDATION	4-R8-4.13
FM	CRAFT JOSEPH W III FOUNDATION	4-R8-5
FN	HERCULES PATSY G	4-R8K-113
FO	HERCULES PATSY G	4-R8K-103
FP	BOZENSKE B H AND OKELLEY K J	4-R8K-104
FQ	REED ELMER & JOY	4-R8K-105
FR	REED ELMER K & J D	4-R8K-106
FS	FRAGALE ELAINE & SPEAKER KURT	4-R8K-107
FT	OCHAP EUGENE F & DENISE R	4-R8K-108
FU	OCHAP EUGENE F & D R	4-R8K-109
FV	GAYDA DONALD P	4-R8P-18
FW	BOND CHARLES R	4-R8K-110
FX	SCHWERTFEGER TYLER S	4-R8K-111
FY	SCHWERTFEGER TYLER S	4-R8K-112
FZ	WILSON RAY B & ANN M	4-R8-62.7
GA	MILLARD BRITTANY LYNN	4-R8-62.6
GB	MULDREW DAVID R & KAREN	4-R8K-101
GC	WHEELING PARK COMMISSION	4-R11-20.1
GD	MOLNAR KRISTINE N & D A	4-R11B-45
GE	WHEELING PARK COMMISSION	4-R11-20.1

09/26/2025

REVISIONS:	COMPANY: SWN Production Company, LLC SWN Production Company™			
	OPERATOR'S			DATE: 02-21-2025
	WELL #:			API NO: 47-069-00371
	DISTRICT:			DRAWN BY:Z.WOOD
	RICHLAND			SCALE: N/A
	COUNTY:	STATE:	DRAWING NO:2018-781	
	OHIO	WV	WELL LOCATION PLAT	

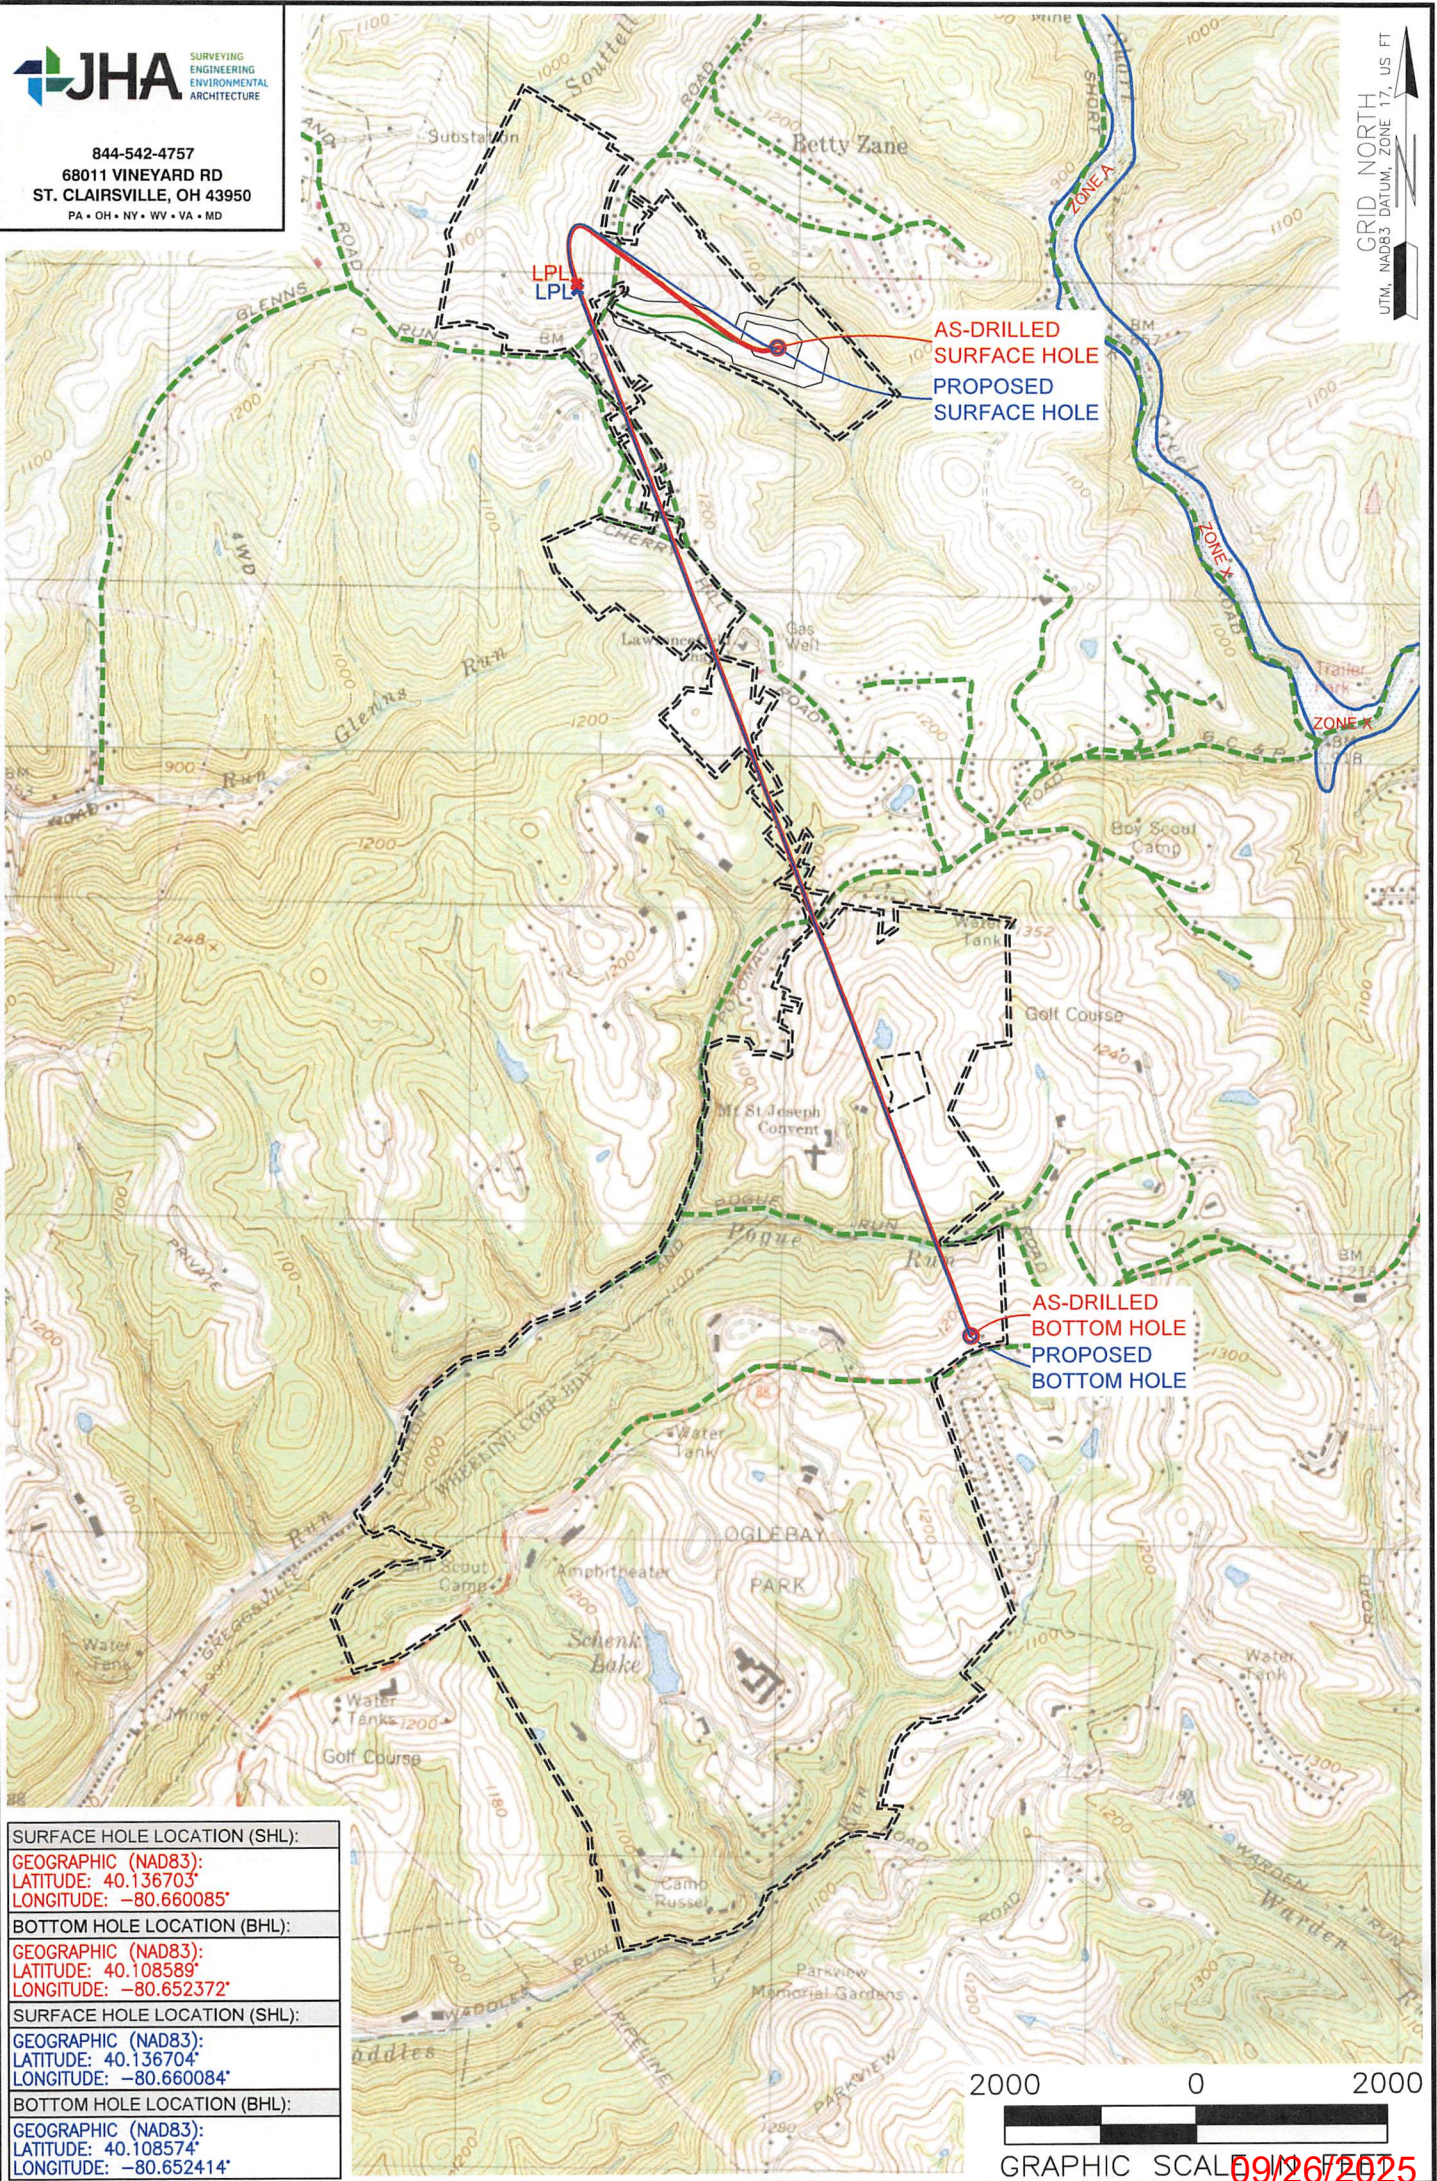

NOTES ON SURVEY

1. SURFACE AND ROYALTY OWNER INFORMATION AND THEIR BOUNDARIES SHOWN HEREON WERE PLOTTED FROM DEEDS AND/OR TAX PARCEL MAPS PROVIDED BY CLIENT AND/OR FIELD LOCATIONS.
2. THIS PLAT DOES NOT REPRESENT A BOUNDARY SURVEY OF THE PARCELS SHOWN HEREON.
3. ALL INSETS ARE GRID NORTH UNLESS OTHERWISE DEPICTED.

WELL OPERATOR:
SWN PRODUCTION COMPANY, LLC

ADDRESS:
1300 FORT PIERPONT DRIVE, SUITE 201, MORGANTOWN, WV 26508

SURFACE OWNER:
FRANZ THOMAN

WELL (FARM) NAME:
FRANZ THOMAN OHI

COUNTY:
OHIO

CODE:
069

DISTRICT:
RICHLAND

WELL #
206H

SERIAL #
XXXX

API #

47-069-00371

USGS 7 1/2 QUADRANGLE MAP NAME:
TILTONVILLE, OH-WV