

LEGEND: ● EXISTING / PRODUCING WELLHEAD ● EXISTING LANDING POINT LOCATION ● PROPOSED SURFACE HOLE / BOTTOM HOLE ● PROPOSED LANDING POINT LOCATION — ACCESS ROAD — PUBLIC ROAD — FLOOD PLAIN — LEASE BOUNDARY — AS-DRILED PATH — PROPOSED PATH		REVISIONS: DATE: 02-06-2025 DRAWN BY: Z. WOOD SCALE: 1" = 2000' DRAWING NO: 2018-781 WELL LOCATION PLAT	
WELL OPERATOR: SWN PRODUCTION COMPANY, LLC ADDRESS: 1300 FORT PIERPONT DRIVE, SUITE 201 CITY: MORGANTOWN STATE: WV ZIP CODE: 26508		DESIGNATED AGENT: BRITANNY WOODY ADDRESS: 1300 FORT PIERPONT DRIVE, SUITE 201 CITY: MORGANTOWN STATE: WV ZIP CODE: 26508	

WELL TYPE: OIL ☐ WASTE DISPOSAL ☐ PRODUCTION ☒ DEEP ☐ GAS ☒ LIQUID INJECTION ☐ STORAGE ☐ SHALLOW ☒		WATERSHED: UPPER OHIO SOUTH DISTRICT: RICHLAND SURFACE OWNER: FRANZ THOMAN OIL & GAS ROYALTY OWNER: FRANZ THOMAN	
DRILL ☐ DRILL DEEPER ☐ REDRILL ☐ FRACTURE OR STIMULATE ☐ PLUG OFF OLD FORMATION ☐ PERFORATE NEW FORMATION ☐		CONVERT ☐ PLUG & ABANDON ☐ CLEAN OUT & REPLUG ☐ OTHER CHANGE ☒ (SPECIFY) AS-DRILED	
ESTIMATED DEPTH: 6131' TVD 25509' TMD		TARGET FORMATION: MARCELLUS	
WELL OPERATOR: SWN PRODUCTION COMPANY, LLC ADDRESS: 1300 FORT PIERPONT DRIVE, SUITE 201 CITY: MORGANTOWN STATE: WV ZIP CODE: 26508		DESIGNATED AGENT: BRITANNY WOODY ADDRESS: 1300 FORT PIERPONT DRIVE, SUITE 201 CITY: MORGANTOWN STATE: WV ZIP CODE: 26508	

WVDP OFFICE OF OIL & GAS 601 57TH STREET CHARLESTON, WV 25034		UNITED STATES TOPOGRAPHIC MAPS DEGREE OF ACCURACY: 1/200	
FRANZ THOMAN OHI		OPERATOR'S WELL #:	

CORRECT TO THE BEST OF MY KNOWLEDGE AND BELIEF AND SHOWS ALL INFORMATION REQUIRED BY LAW AND REGULATIONS ISSUED AND PRESCRIBED BY THE DEPARTMENT OF ENVIRONMENTAL PROTECTION.		P.E. 19809	
I, THE UNDERSIGNED, HEREBY CERTIFY THAT THIS PLAT IS		JOSEPH J. HUNT REGISTERED PROFESSIONAL ENGINEER STATE OF WEST VIRGINIA 19809	

SURFACE HOLE LOCATION (SHL): UTM (NAD83, ZONE 17, METERS): NORTHING: 4442983.08 EASTING: 529865.47		LANDING POINT LOCATION (LPL): UTM (NAD83, ZONE 17, METERS): NORTHING: 4442883.17 EASTING: 529013.18	
SURFACE HOLE LOCATION (SHL): UTM (NAD83, ZONE 17, METERS): NORTHING: 4437633.00 EASTING: 531524.97		LANDING POINT LOCATION (LPL): UTM (NAD83, ZONE 17, METERS): NORTHING: 4442983.07 EASTING: 529865.38	

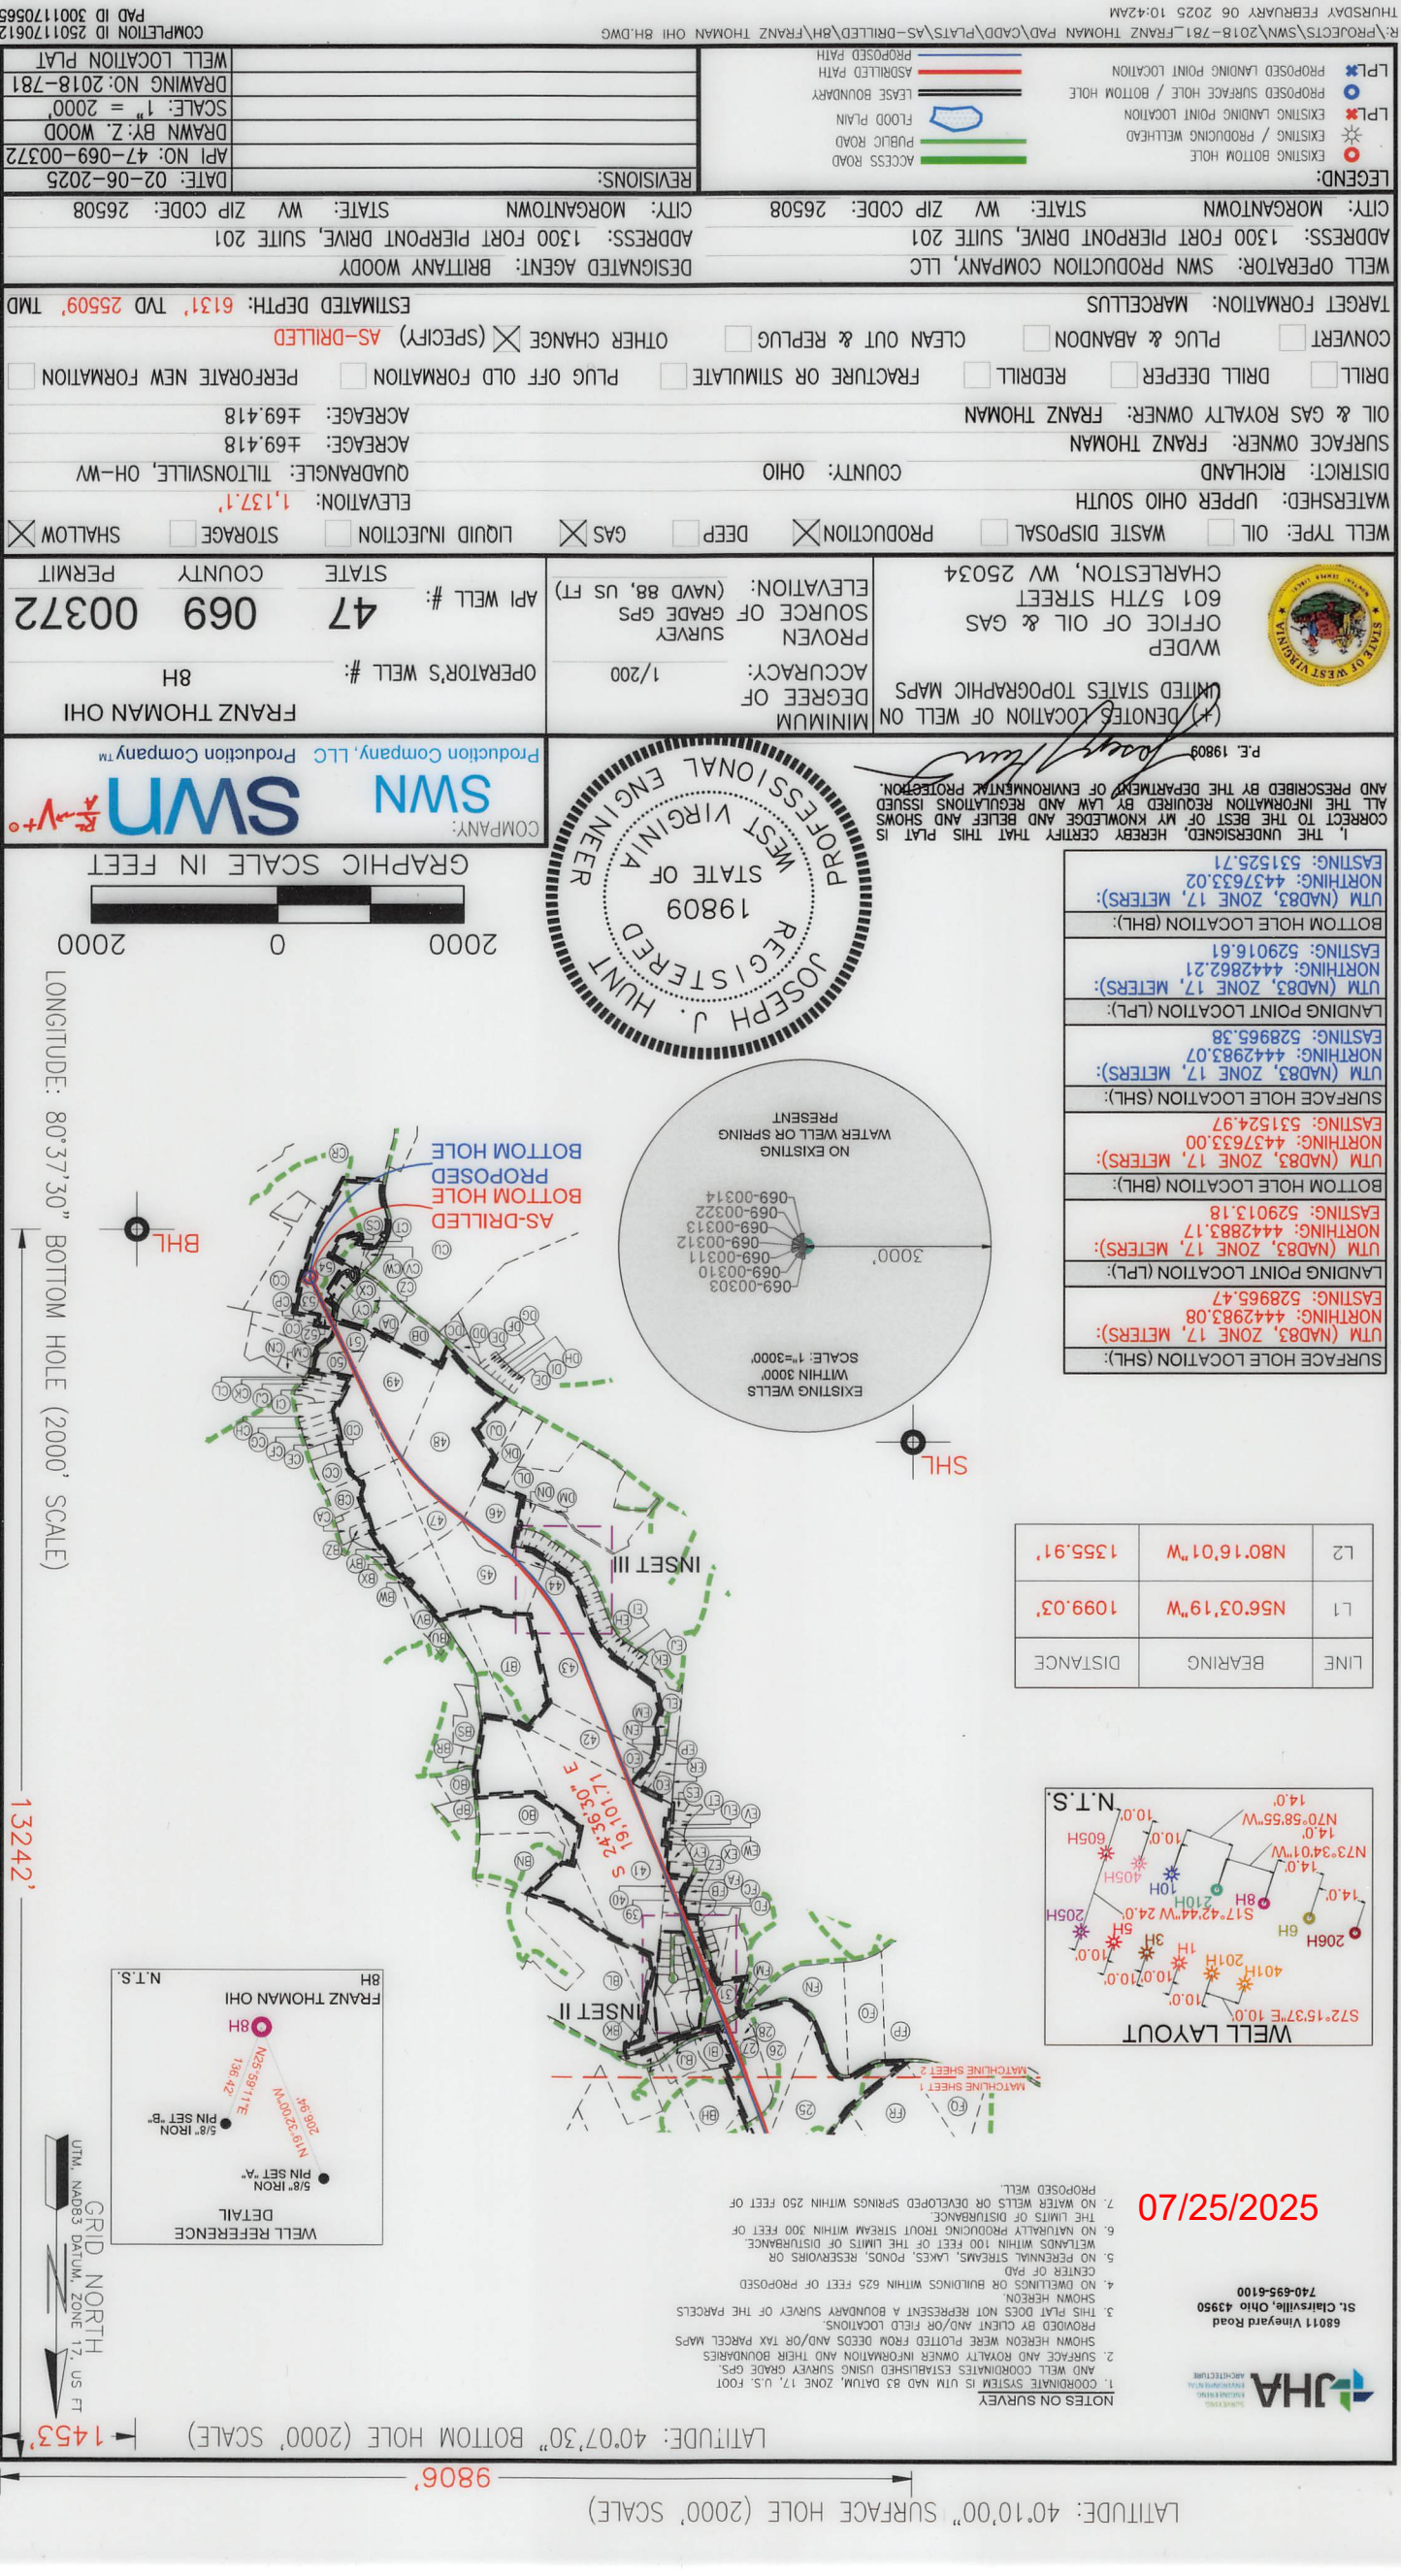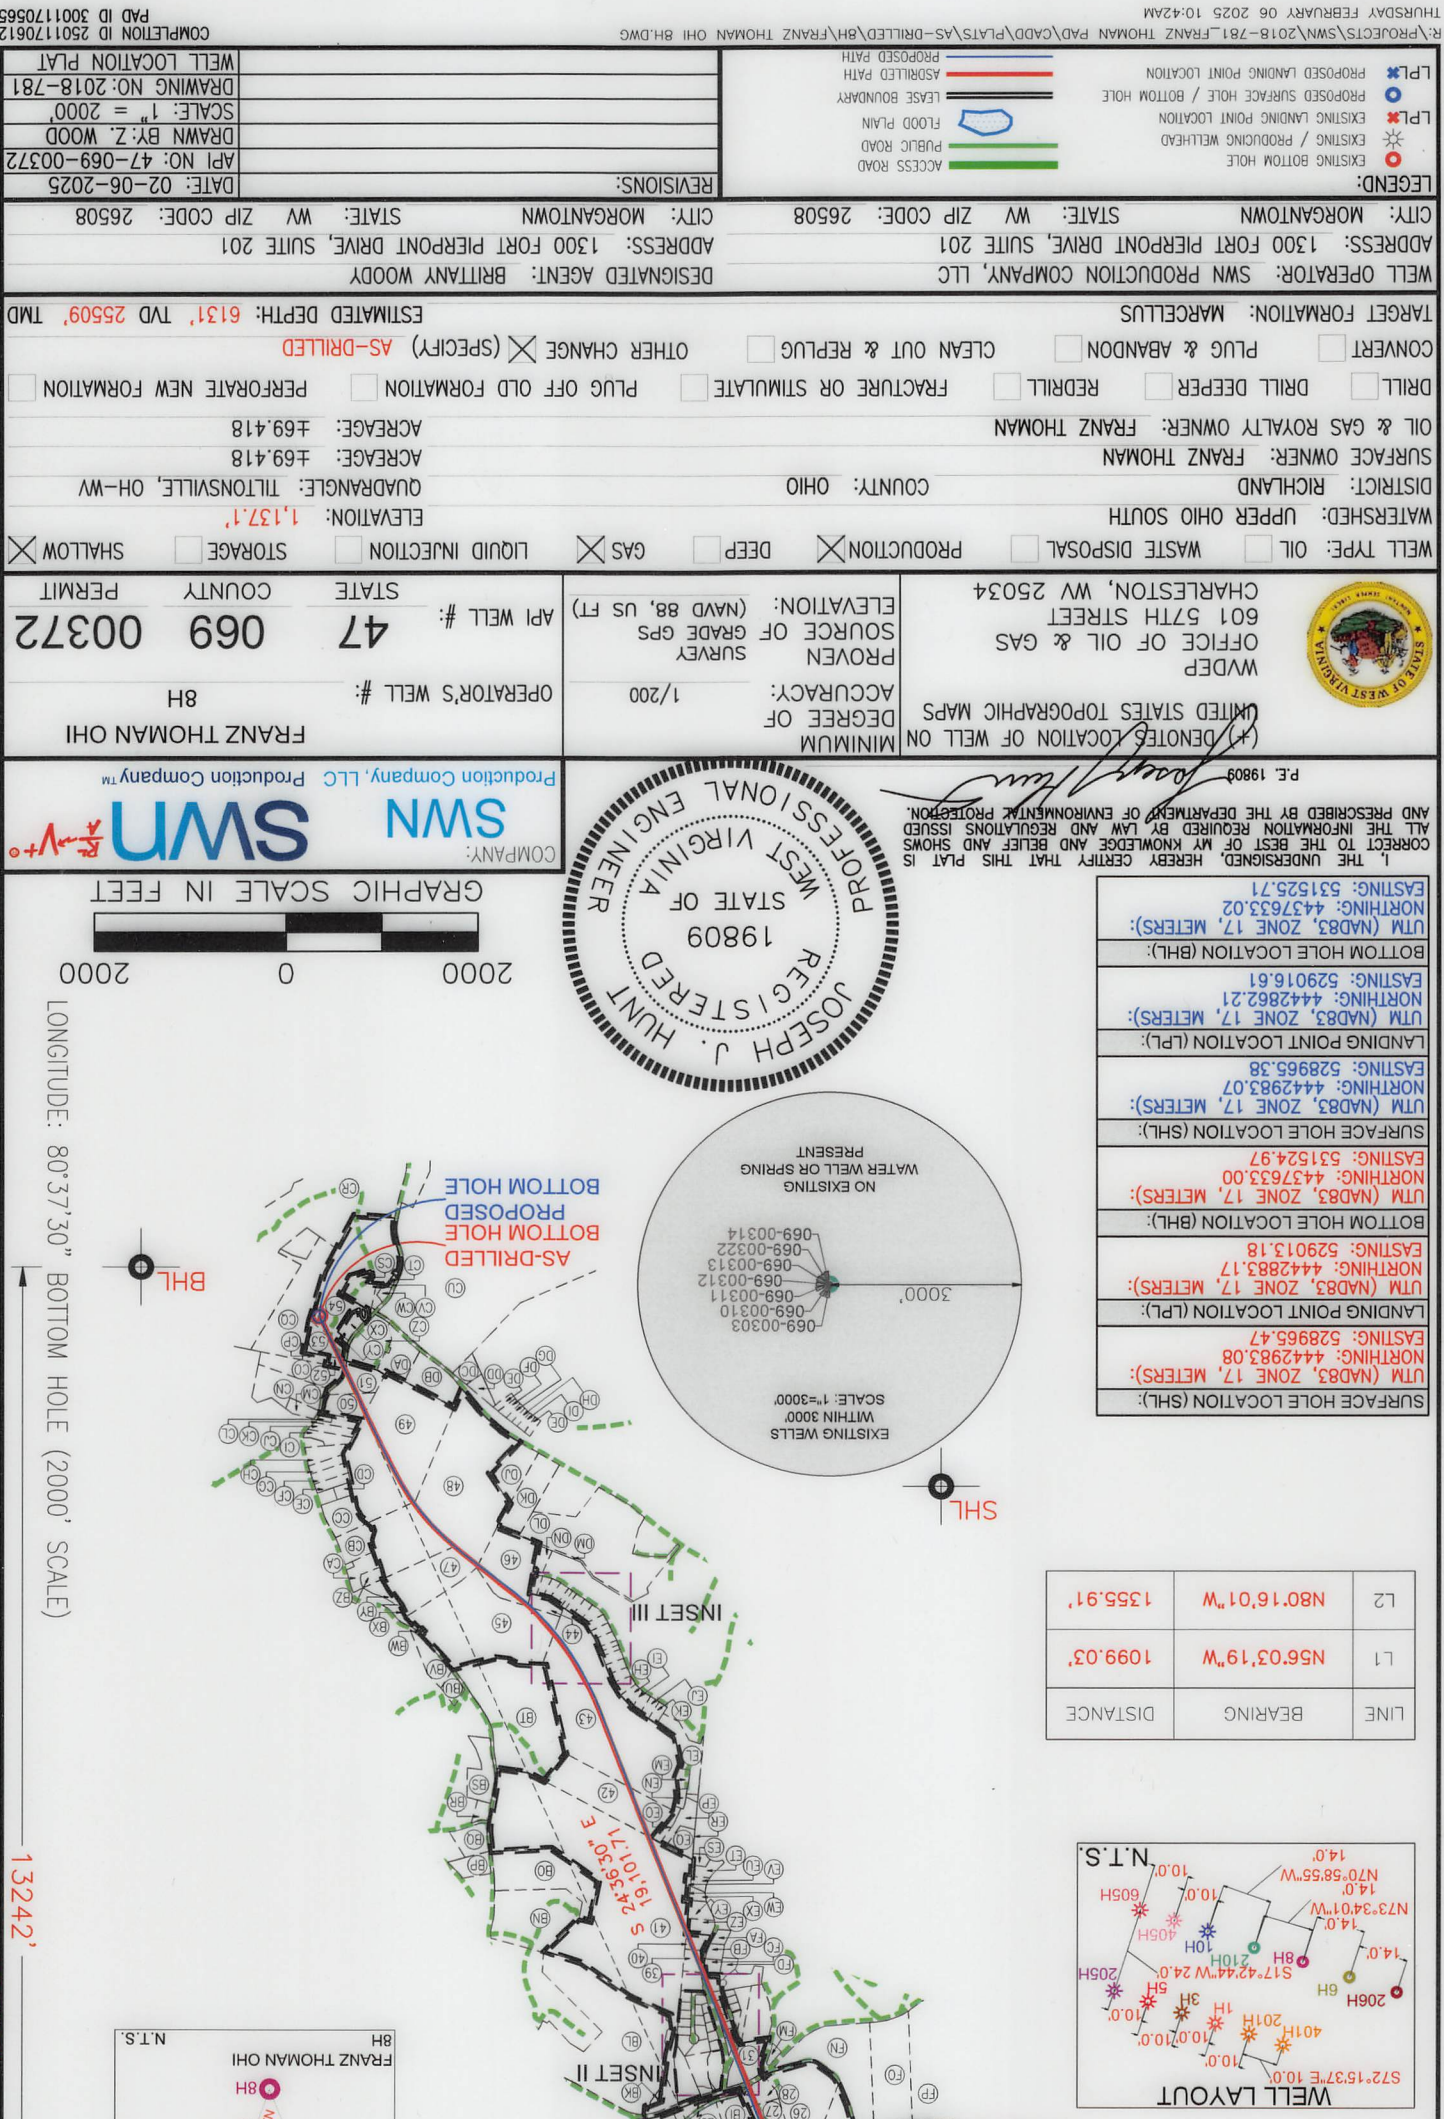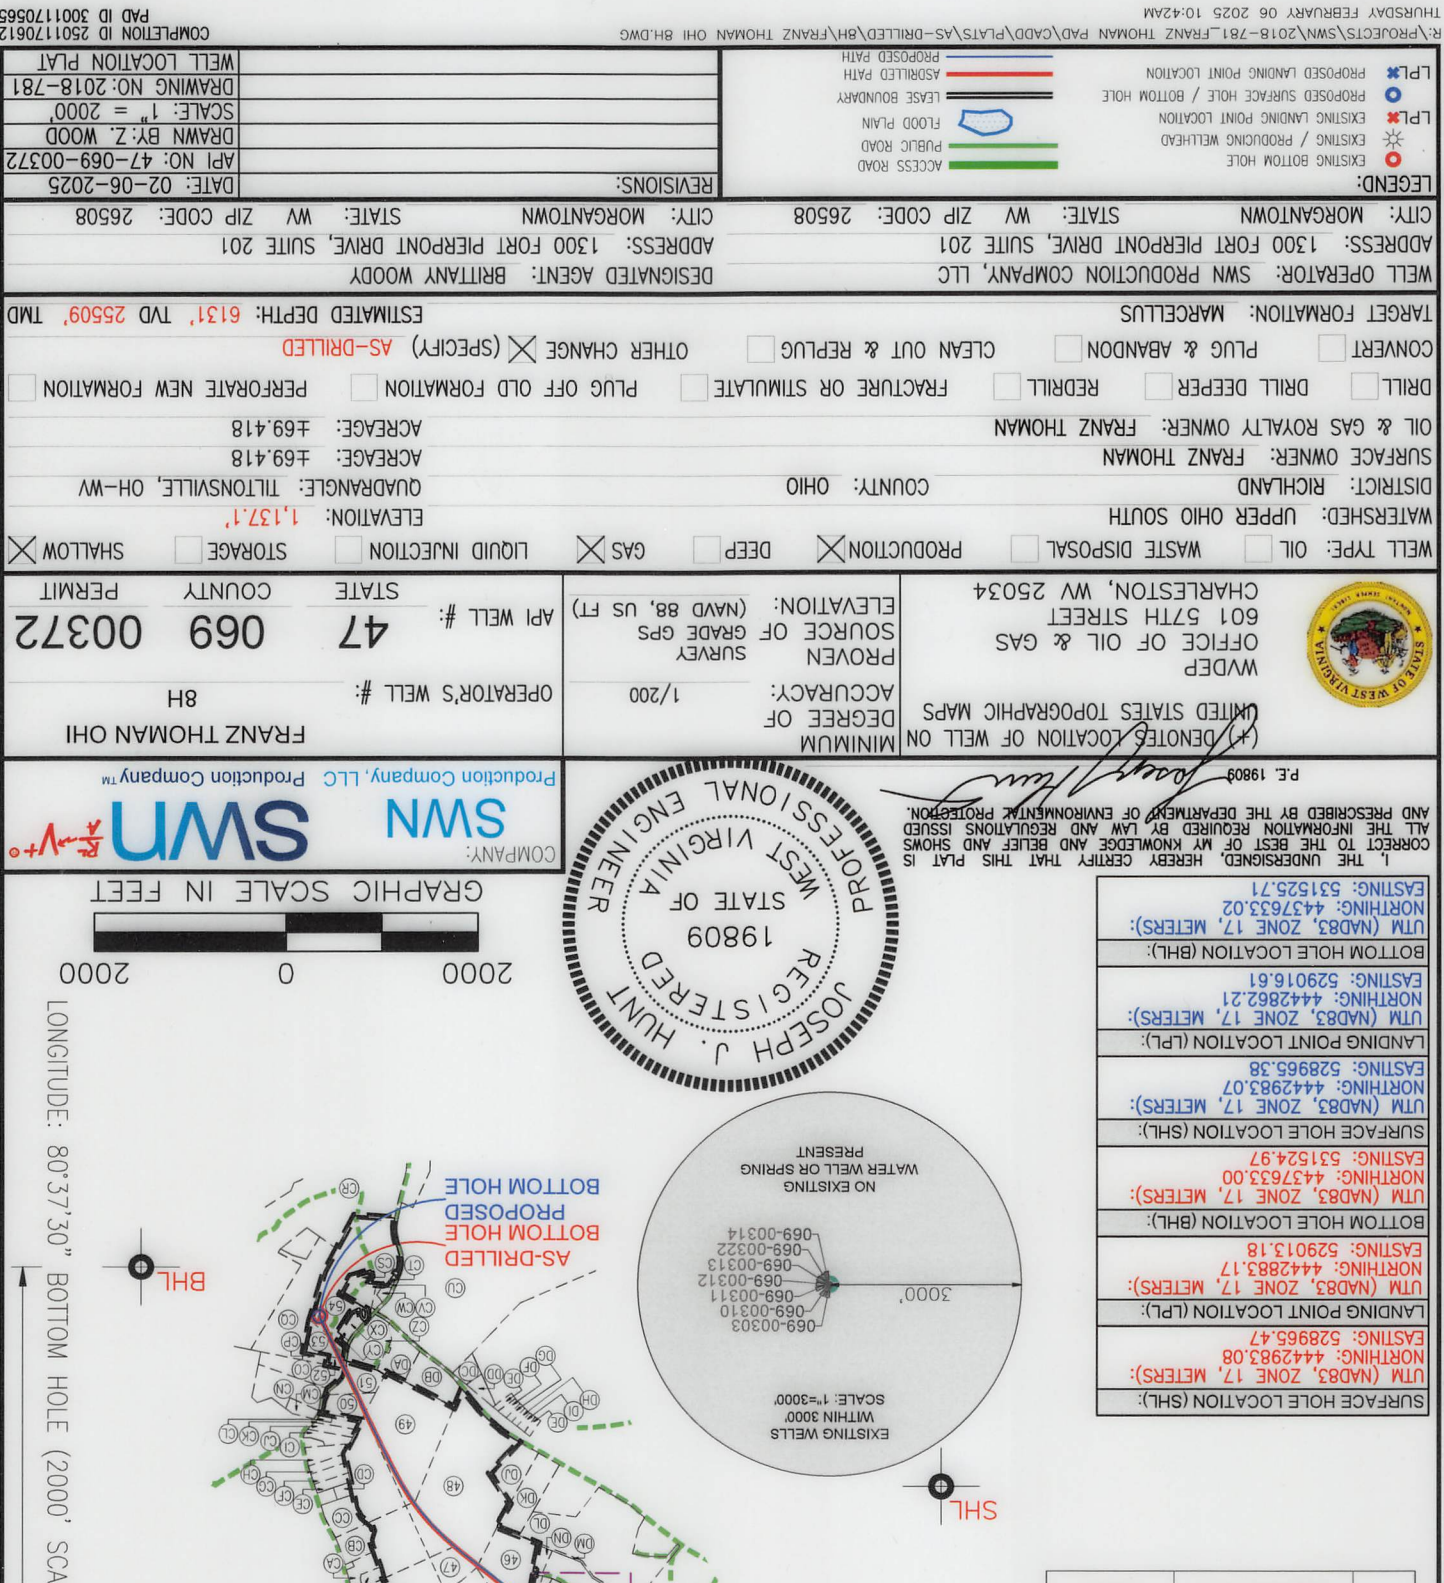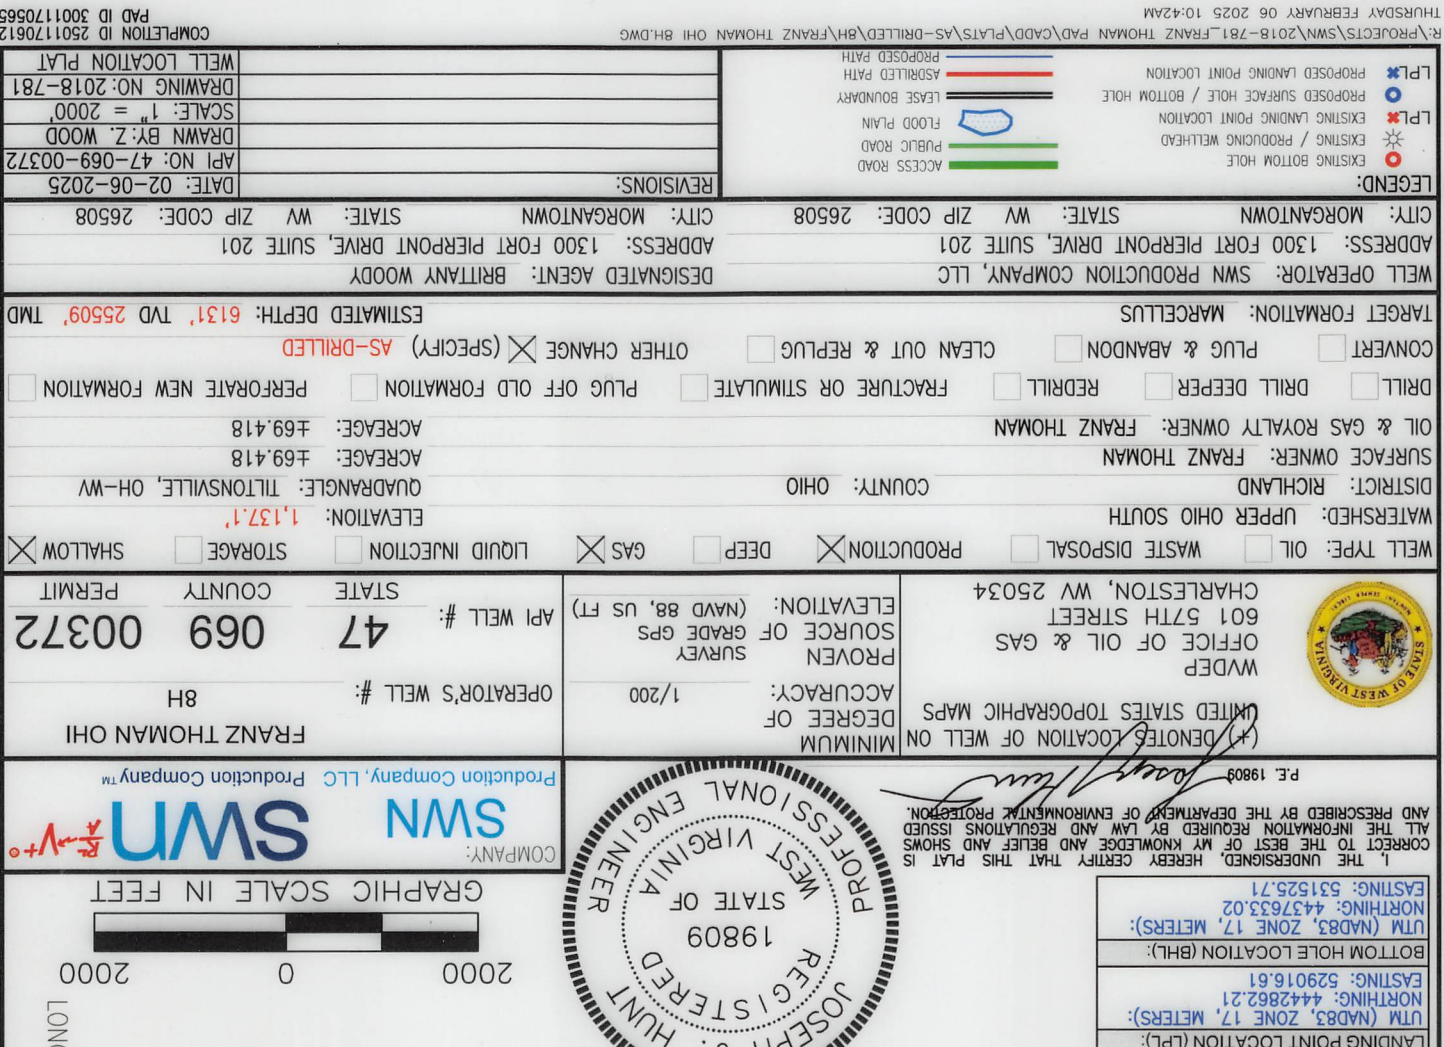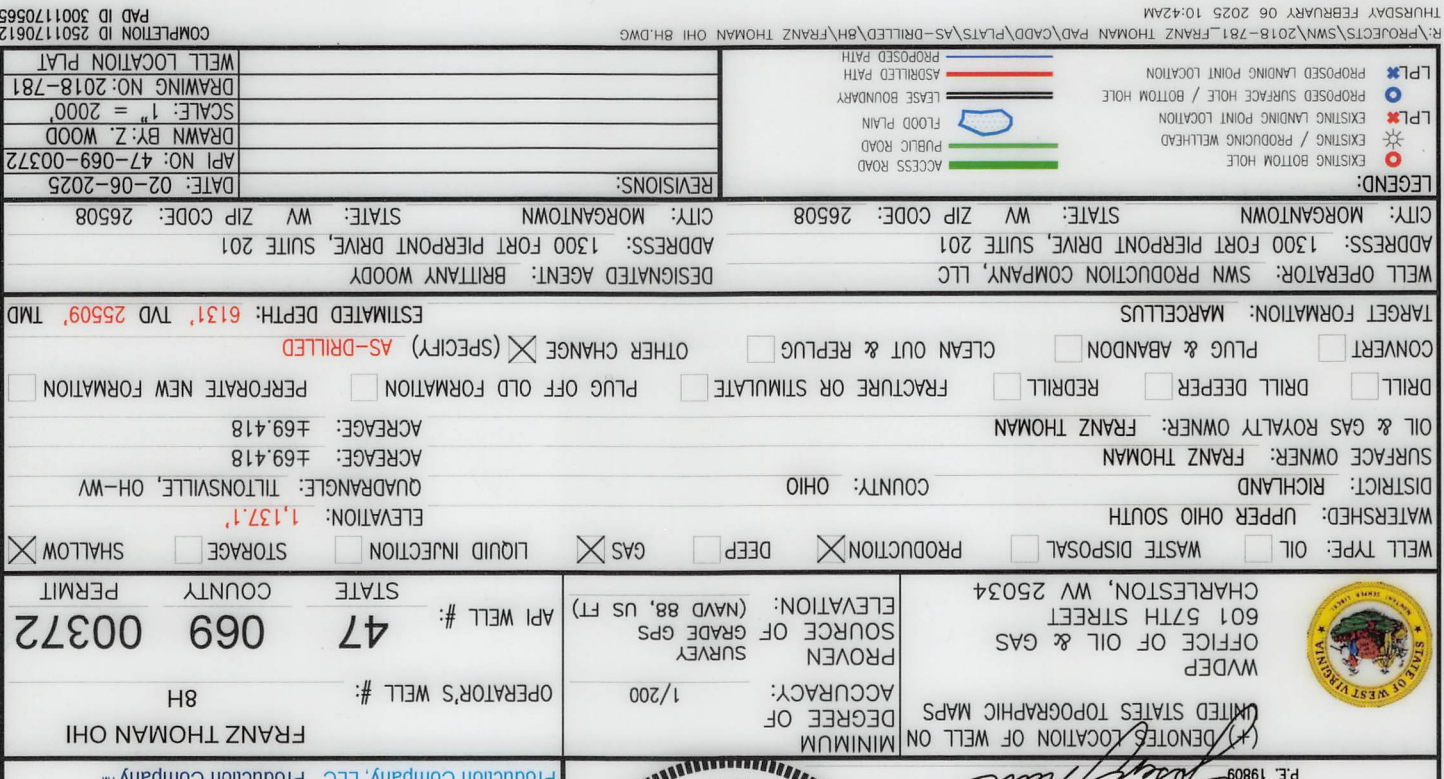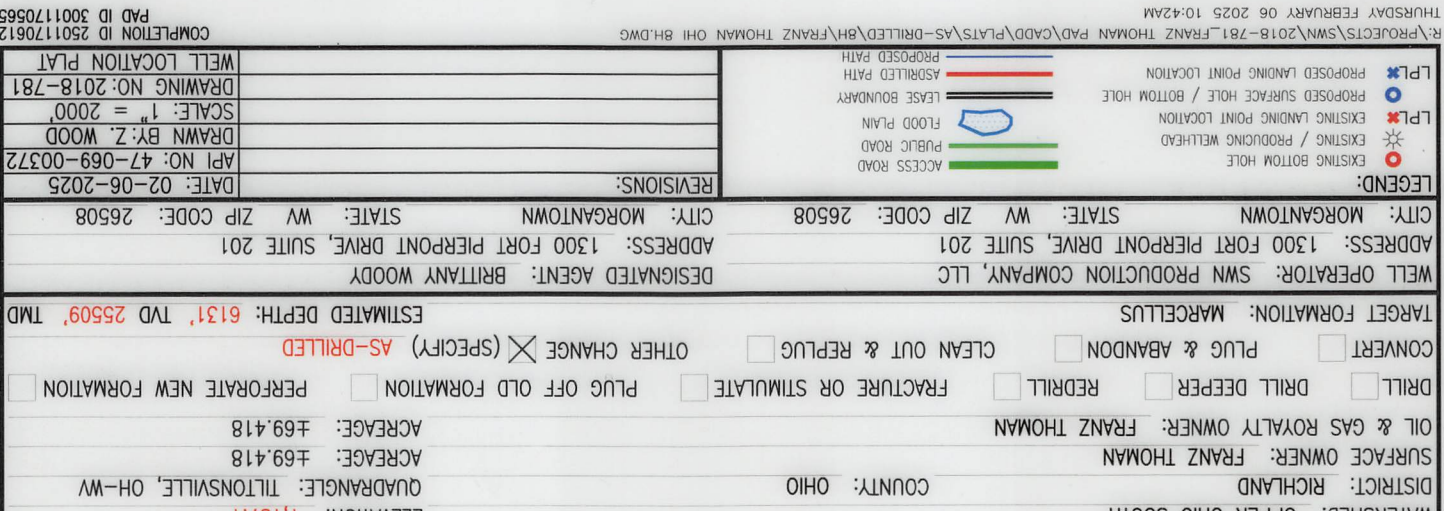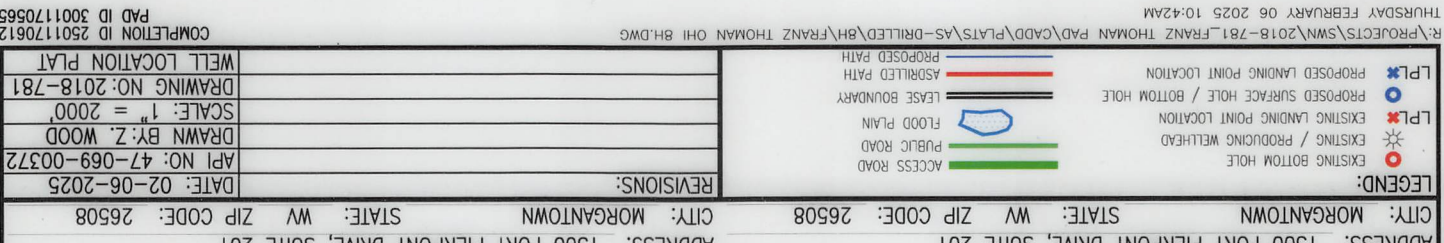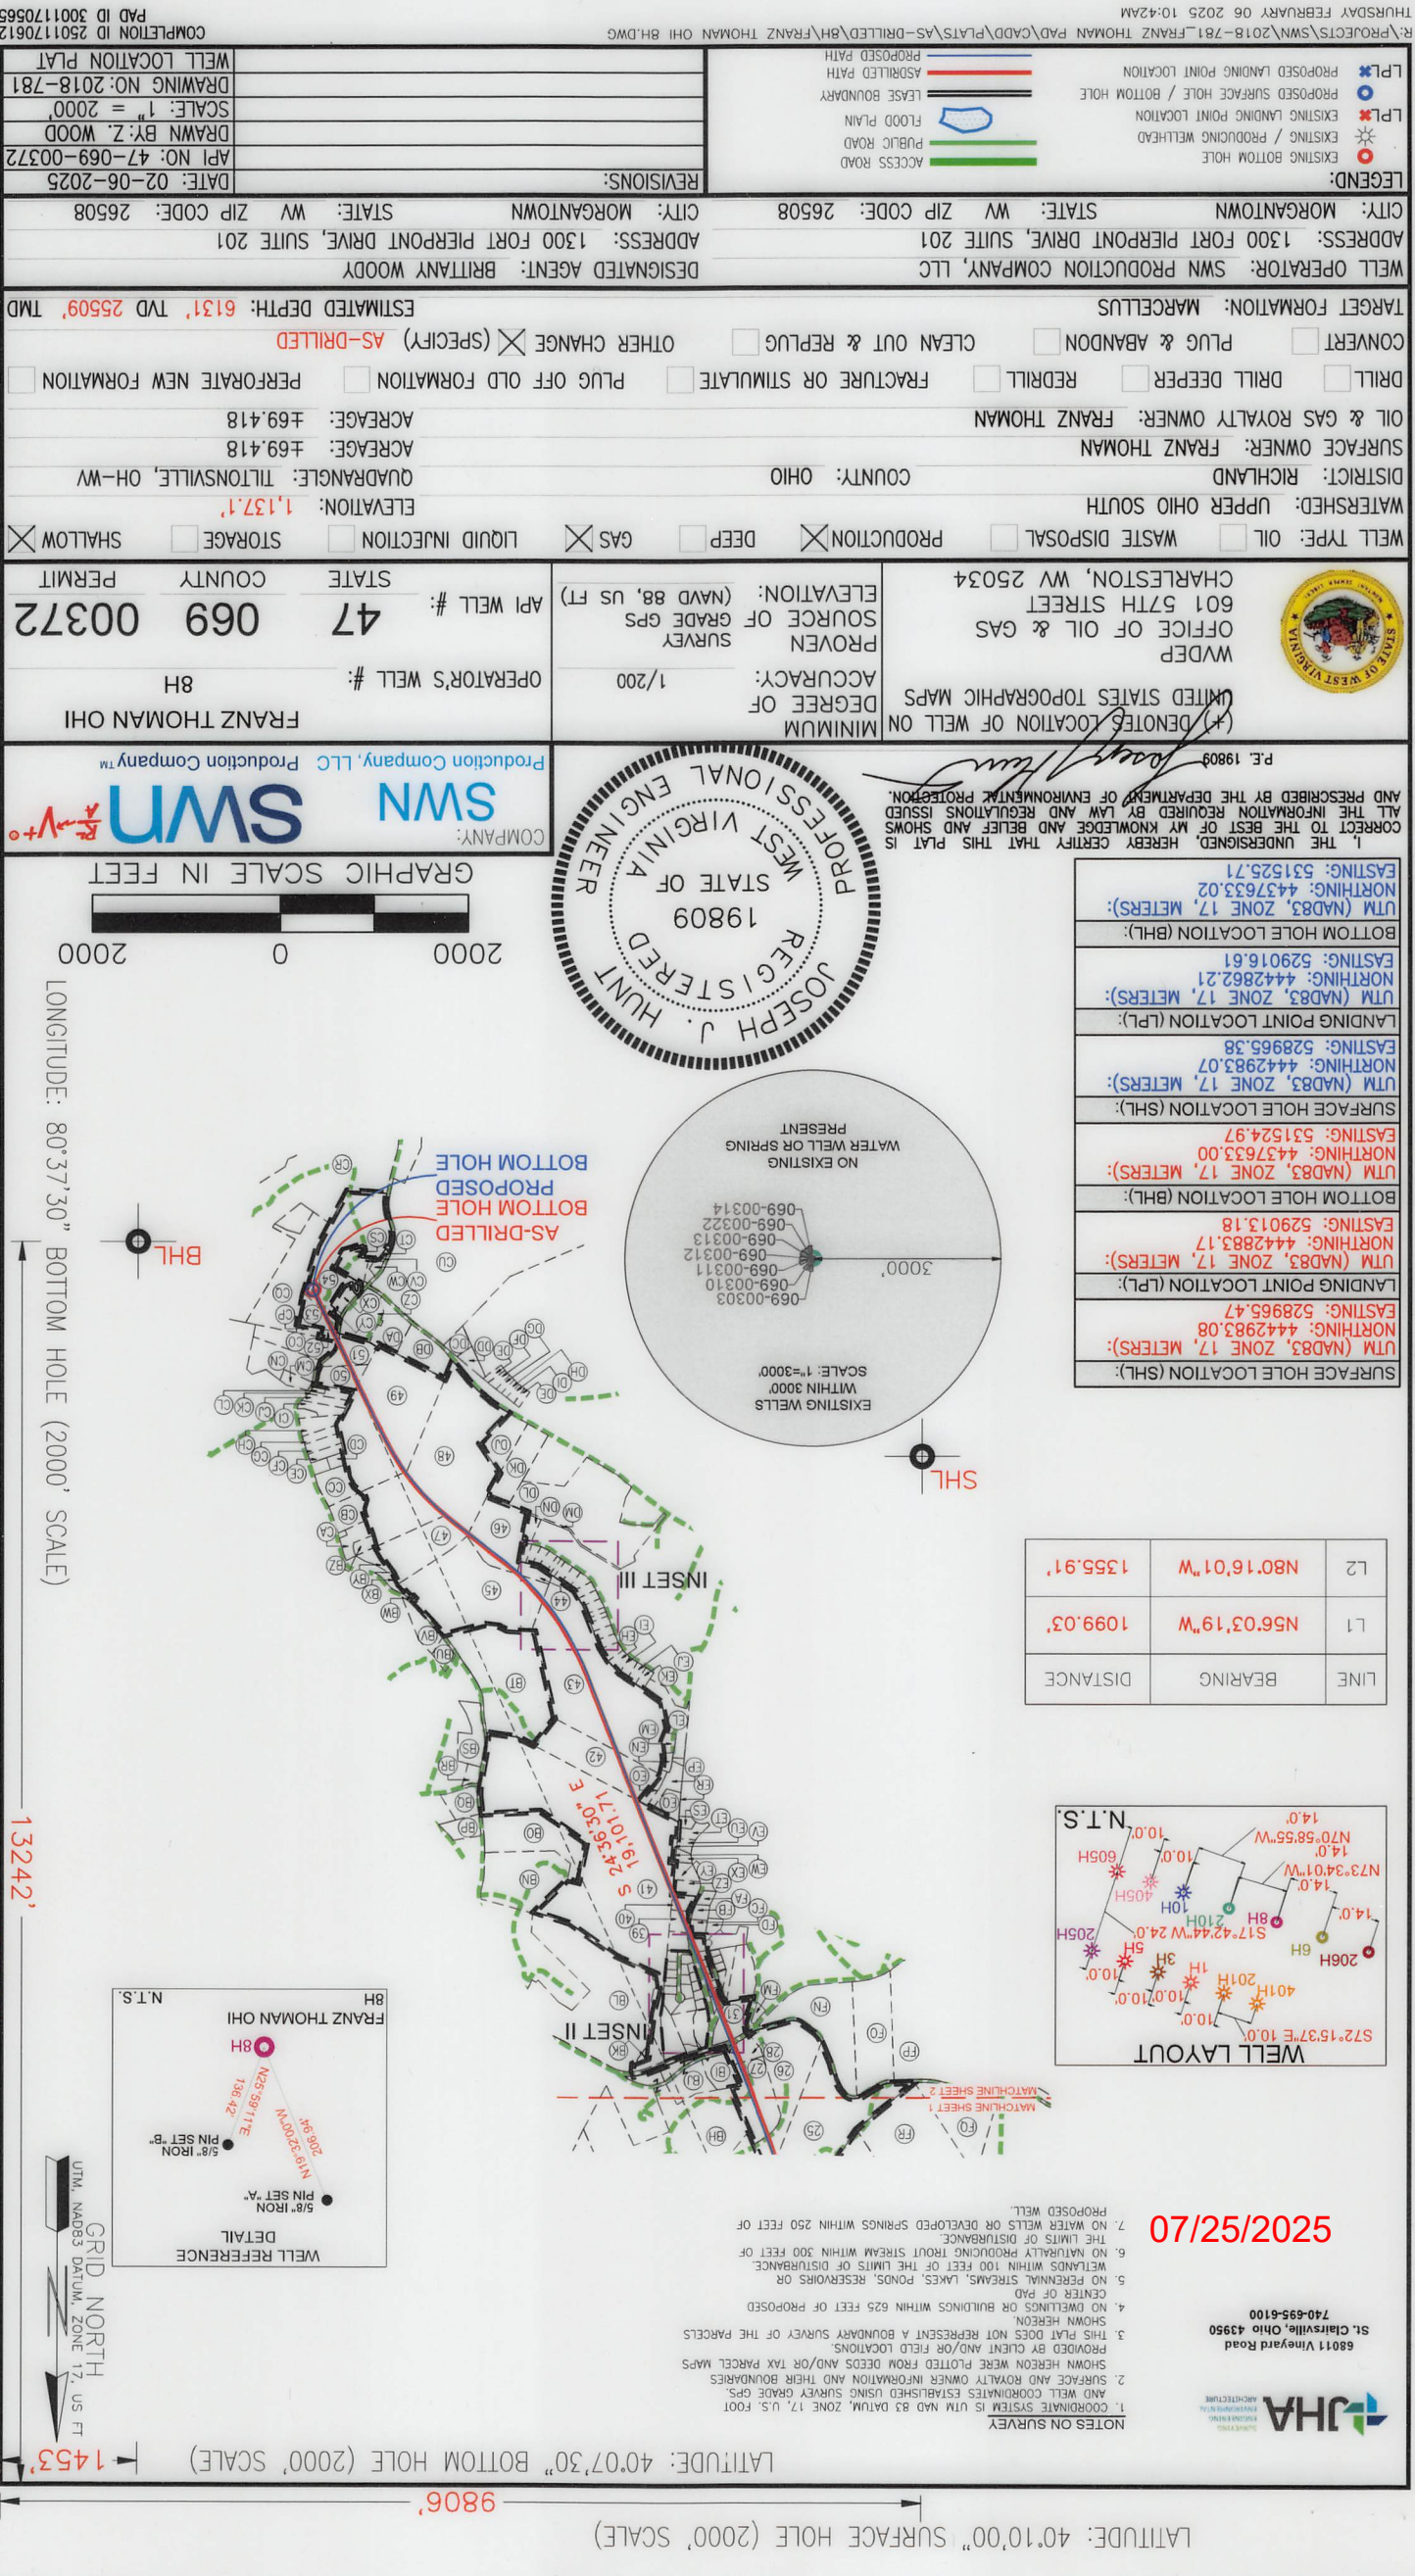

LEGEND:	
	EXISTING BOTTOM HOLE
	EXISTING \ PRODUCING WELLHEAD
	EXISTING LANDING POINT LOCATION
	PROPOSED SURFACE HOLE \ BOTTOM HOLE
	PROPOSED LANDING POINT LOCATION
	PROPOSED PATH
	ASDRILLED PATH
	LEASE BOUNDARY
	FLOOD PLAIN
	PUBLIC ROAD
	ACCESS ROAD

CITY: MORGANTOWN	STATE: WV	ZIP CODE: 26508
CITY: MORGANTOWN	STATE: WV	ZIP CODE: 26508
ADDRESS: 1300 FORT PIERPONT DRIVE, SUITE 201		
DESIGNATED AGENT: BRITANNY WOODY		
OIL & GAS ROYALTY OWNER: FRANZ THOMAN		
SURFACE OWNER: FRANZ THOMAN		
DISTRICT: RICHLAND		
WATERSHED: UPPER OHIO SOUTH		
WELL TYPE: OIL		
☐ WASTE DISPOSAL ☒ PRODUCTION ☐ DEEP ☒ GAS ☐ LIQUID INJECTION ☐ STORAGE ☒ SHALLOW		

WELL OPERATOR: SWN PRODUCTION COMPANY, LLC		CITY: MORGANTOWN		STATE: WV	ZIP CODE: 26508
ADDRESS: 1300 FORT PIERPONT DRIVE, SUITE 201		CITY: MORGANTOWN		STATE: WV	ZIP CODE: 26508
DESIGNATED AGENT: BRITANNY WOODY		CITY: MORGANTOWN		STATE: WV	ZIP CODE: 26508
DRAWN BY: Z. WOOD		SCALE: 1" = 2000'		DRAWING NO: 2018-781	
WELL LOCATION PLAT		WELL LOCATION PLAT			
OPERATOR'S WELL #:		8H		FRANZ THOMAN OHI	

THE UNDERSIGNED, HEREBY CERTIFY THAT THIS PLAT IS CORRECT TO THE BEST OF MY KNOWLEDGE AND BELIEF AND SHOWS ALL THE INFORMATION REQUIRED BY LAW AND REGULATIONS ISSUED AND PRESCRIBED BY THE DEPARTMENT OF ENVIRONMENTAL PROTECTION.

P.E. 19809

SURFACE HOLE LOCATION (SHL):	
INSET I
N.T.S.




INSET II
N.T.S.

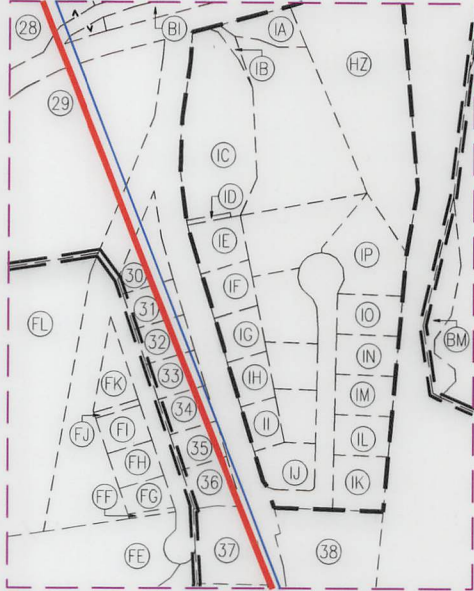

INSET IV
N.T.S.

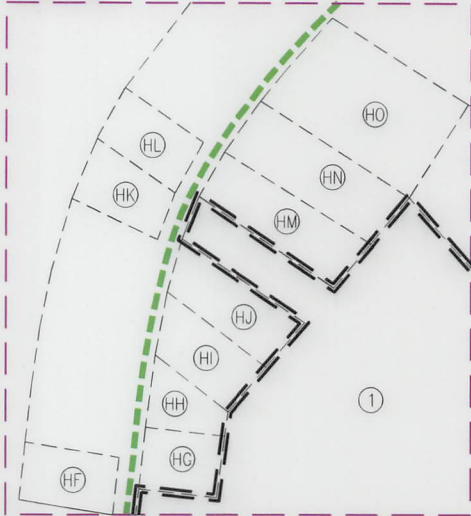

INSET III
N.T.S.

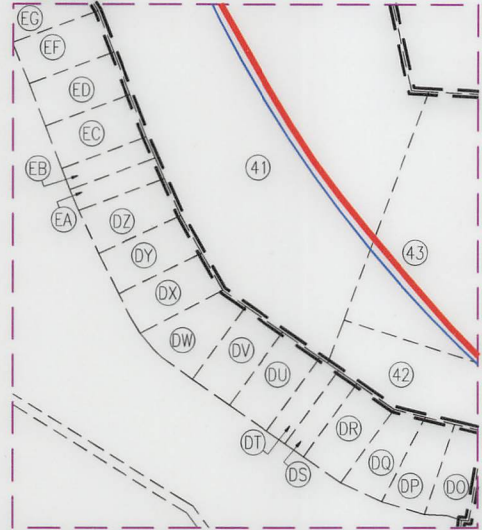

WELL BORE TABLE FOR SURFACE/ROYALTY OWNERS		
TRACT	SURFACE OWNER (S) / ROYALTY OWNER (R)	TAX PARCEL
1	THOMAN FRANZ (S) / (R)	4-R8-62
TRACT	SURFACE OWNER	TAX PARCEL
2	TUNNEL RIDGE LLC	4-R8-62.5
3	SANDCREST FOUNDATION INC	4-R11-15
4	STERN SHAWN G & AIMEE M	4-R11-16.13
5	CRUPE JUSTINE K & JOHN D	4-R11G-28
6	FRANCIS CLAYTON M & HILARY B SMITH	4-R11G-29
7	TURNER MADELYN BELLE	4-R11G-33
8	SOBRAY J TRUST; SOBRAY JANICE C TRUSTEE	4-R11G-34.1
9	LAWSON JOYCE A - TOD	4-R11G-22
10	TRABERT TONY P & PETROS A D	4-R11G-21
11	DUNAWAY DONALD R - TOD	4-R11G-20.1
12	JOHNSON JACOB T & KATELYNN M	4-R11G-20.2
13	EDDY JOSEPH C & DEBRA A	4-R11L-13
14	MCFADDEN CHARLES S & PATRICIA	4-R11L-14
15	PADDEN BETH ANN; KARGE LINDA S	4-R11L-9.2

WELL BORE TABLE FOR SURFACE/ROYALTY OWNERS		
TRACT	SURFACE OWNER	TAX PARCEL
16	VISNIC PAUL D	4-R11L-18.3
17	VISNIC MARY SUE F & D P	4-R11L-18.2
18	VISNIC MARY SUE F & DAVID PAUL	4-R11L-18.1
19	BONAR PAUL BRADLEY	4-R11L-26
20	EDGE MARK C & M A	4-R11L-27
21	RUCKMAN MARY ANN TRUST; K CUSTER & D BAUKNECHT TEES	4-R11L-28
22	WHEELING PARK COMMISSION	4-R11-21.5
23	WHEELING PARK COMMISSION	4-R11-21.7
24	WHEELING PARK COMMISSION	4-R11-21.6
25	WHEELING PARK COMMISSION	4-R14-20.4
26	WHEELING PARK COMMISSION	4-R14-20.2
27	WHEELING PARK COMMISSION	4-R14-20.5
28	WHEELING PARK COMMISSION	4-R14-20.1
29	TALENFELD FRANK, LEBOW MYRA J	4-R14-34
30	MERRIMAN DOUGLAS J AND J L	10-W14H-6
31	SHAFFER PAMELA S	10-W14H-7
32	ZUK GREGORY A	10-W14H-8
33	BURRESS JAMES JR & BULKA CHELSEA	10-W14H-9
34	THOMAS LUKE A & ASHLEY N	10-W14H-10
35	THOMAS LUKE A & ASHLEY N	10-R14H-11
36	GILLISPIE JOYCE A	10-W14H-12
37	CATER MARYANN N	4-W14H-8
38	VAWTER ROBERT L & CATER MARYANN M	4-R14H-1
39	CLATTERBUCK DOUGLAS W & CRYSTAL L CLATTERBUCK	4-R14H-2
40	CONTRAGUERRO MICHAEL J & PEGGY A	4-R14H-3
41	OGLEBAY FOUNDATION PROPERTIES INC	4-R14-31.30
42	OGLEBAY FOUNDATION PROPERTIES INC	4-R14-31.30

07/25/2025


REVISIONS:

COMPANY:		FRANZ THOMAN OHI		DATE: 02-06-2025	
OPERATOR'S		8H		API NO: 47-069-00372	
WELL #:				DRAWN BY: Z. WOOD	
DISTRICT:		COUNTY:		SCALE: N/A	
RICHLAND		OHIO		DRAWING NO: 2018-781	
		STATE:		WELL LOCATION PLAT	
		WV			

REVISIONS:				



TRACT	SURFACE OWNER	TAX PARCEL
WELL BORE TABLE FOR SURFACE/ROYALTY OWNERS		

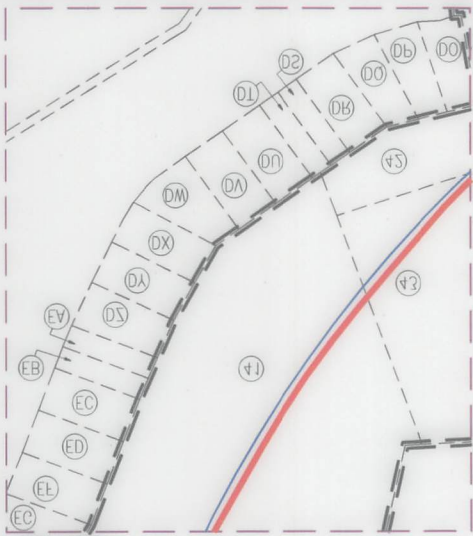


N.T.S.
INSET III



N.T.S.
INSET I

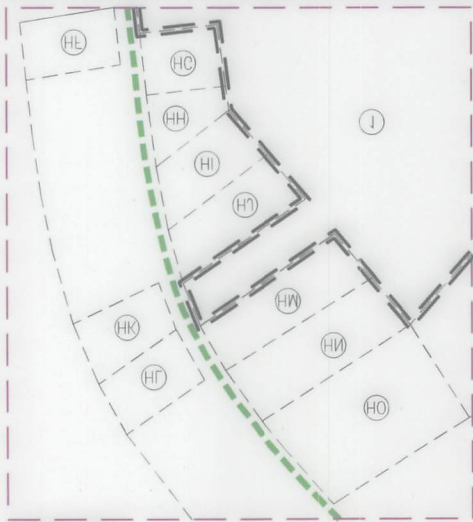

N.T.S.
INSET IV

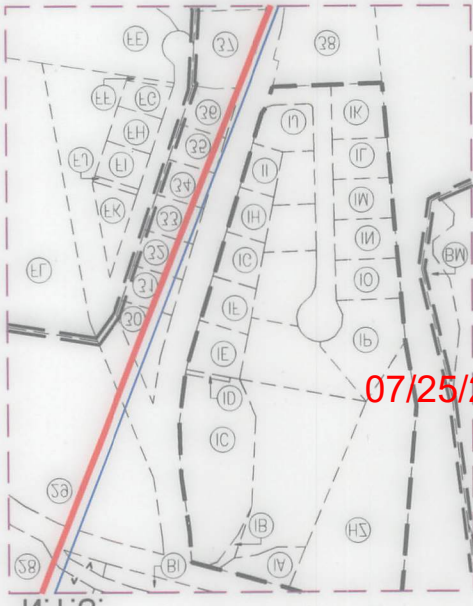

N.T.S.
INSET II

07/25/2025

DATE: 02-06-2025		API NO: 47-069-00372		DRAWN BY: Z. WOOD		SCALE: N/A		DRAWING NO: 2018-781		WELL LOCATION PLAT	
OPERATOR'S		FRANZ THOMAN OHI		WELL #:		COUNTY:		STATE:		WV	
COMPANY:		Production Company, LLC		Production Company™		SWM		SWM		SWM	
REVIEWS:											
DISTRICT:		OHIO		RICHLAND							

WELL BORE TABLE FOR SURFACE/ROYALTY OWNERS		ADJOINING OWNERS TABLE	
TRACT	SURFACE OWNER	ADJOINING OWNERS TABLE	SURFACE OWNER
43	OGLEBAY FOUNDATION PROPERTIES INC	4-R14M-2.4	
44	DAMANT VIRGINIA	4-R14M-2.7	
45	WITT CHARLES R & BRENDA K	4-R15-15	
46	DAMANT VIRGINIA	4-R14R-34	
47	HARMON KIMBERLY S & HARMOM DAVID L JR	4-R15-13	
48	MCLAUGHLIN ALICE K TRUST; WESBANCO TRUST & INVESTMENT	4-R18-4	
49	MCLAUGHLIN A LEE JR & K A	4-R18-4.1	
50	KULL AUSTIN J & SARA R	4-R18-20	
51	BRITTON KAYLA MARIE 1/2 INT & LAFOLLETT CHRISTOPHER 1/2 INT	4-R18-21.3	
52	HOFFMAN JOHN G, RONALD L & HEATHER ANN ROSS	4-R18-24	
53	715 PETERS RUN LLC	4-R18-27.2	
54	HOFFMAN FAMILY IRREVOCABLE TRUST	4-R18-27.1	
TRACT	TAX PARCEL		
43	OGLEBAY FOUNDATION PROPERTIES INC	4-R14M-2.4	
44	DAMANT VIRGINIA	4-R14M-2.7	
45	WITT CHARLES R & BRENDA K	4-R15-15	
46	DAMANT VIRGINIA	4-R14R-34	
47	HARMON KIMBERLY S & HARMOM DAVID L JR	4-R15-13	
48	MCLAUGHLIN ALICE K TRUST; WESBANCO TRUST & INVESTMENT	4-R18-4	
49	MCLAUGHLIN A LEE JR & K A	4-R18-4.1	
50	KULL AUSTIN J & SARA R	4-R18-20	
51	BRITTON KAYLA MARIE 1/2 INT & LAFOLLETT CHRISTOPHER 1/2 INT	4-R18-21.3	
52	HOFFMAN JOHN G, RONALD L & HEATHER ANN ROSS	4-R18-24	
53	715 PETERS RUN LLC	4-R18-27.2	
54	HOFFMAN FAMILY IRREVOCABLE TRUST	4-R18-27.1	
TRACT	TAX PARCEL		
BA	OHIO COUNY PUBLIC SERVICE DIST	4-R11-21.44	
BB	WILHELM GEO T & C M	4-R11-39	
BC	DANISON DENISE L	4-R11-24.1	
BD	CUSTER ROBERT R & K A	4-R11-24.2	
BE	WHEELING PARK COMMISSION	4-R11-38	
BF	WHEELING PARK COMMISSION	4-R11-21.37	
BG	WHEELING PARK COMMISSION	4-R11-21.2	
BH	WHEELING PARK COMMISSION	4-R14-20.3	
BI	WHEELING PARK COMMISSION	4-R14-20.6	
BJ	WHEELING PARK COMMISSION	4-R14-20	
BK	OGLEBAY FOUNDATION PROPERTIES INC	4-R14-31.6	
BL	KONTOGIANNIS GEORGE J	4-R14-31	
BM	OGLEBAY FOUNDATION PROPERTIES INC	4-R14-31.7	
BN	WHEELING STATION LTD; C/O RED MORTGAGE CAPITOL INC	4-R14-31.3	
BO	OGLEBAY FOUNDATION PROPERTIES INC	4-R14-31.31	
BP	DIERKES JEANNINE & GLENN W	4-R15-16.8	
BQ	HOPKINS LEWIS R & ROSEMARY-TOD	4-R15-16.6	
BR	ARCHER BRUCE A AND SHEILA M	4-R15-17	
BS	DAVIS JEREMY MICHAEL & LACEY	4-R15-16.2	
BT	OGLEBAY FOUNDATION PROPERTIES INC	4-R14-88	
BU	BAKER VENEIDA K	4-R15-16.16	
BV	BAKER VENEIDA K	4-R15-16.15	
BW	COLUMBIA GAS TRANSMISSION CORP	4-R15-14	
BX	TRANK PATRICIA	4-R15-16.17	
BY	HARMON DAVID L JR & KIMBERLY S	4-R15-12	
BZ	CLOUSTON RAYMOND & HYDEE D	4-R15-9	
CA	CLOUSTON RAYMOND & HYDEE D	4-R15-7	
CB	KNOLLINGER DOUGLAS W & WILLA W	4-R15-5	
CC	MCLAUGHLIN A LEE & KATHLEEN A	4-R15-2	
CD	MCLAUGHLIN A LEE & KATHLEEN A	4-R18-6.1	
CE	JOZWICK RICHARD J & CRYSTAL	4-R18-5	
CF	SIMMONS CHRISTOPHER L	4-R18-16	
CG	MCCONNELL ROBERT J JR	4-R18-15	
CH	MCKENNEE REBECCA J	4-R18-17	
CI	THOMPSON DONALD T & MELISSA A	4-R18-18	
CJ	THOMPSON DONALD T & MELISSA A	4-R18-19	
CK	NELSON RONALD D JR	4-R18-19.2	
CL	NELSON RONALD D JR	4-R18-19.1	
CM	HESS KEVIN & STACEE L	4-R18-22.2	
CN	HORVAT COX LINDA JO ESTATE	4-R18-22	
CO	HOFFMAN JOHN GEORGE & SHIRLEY LAYA HOFFMAN - TOD	4-R18-23.1	
CP	HOFFMAN JOHN GEORGE & SHIRLEY LAYA HOFFMAN - TOD	4-R18-24.1	
CQ	WEISENBORN ERIC P	4-R18-27.5	
CR	HOFFMAN ROBERT LEE JR & BIERKORETTE BERNADINE	4-R18-27	
CS	NIZAMI SALEEM & DENITRA	4-R18-3	
CT	HOFFMAN FAMILY IRREVOCABLE TRUST	4-R18-21.2	
CU	MILLER D JOSHUA & TERESA C TORISEVA	4-R18-21.1	
CV	MILLER D JOSHUA & TERESA C TORISEVA	4-R18-21.5	
CW	HOFFMAN FAMILY IRREVOCABLE TRUST	4-R18-25	
CX	TEMPLETON JOHN J DR & LISA J CO-TRUSTEES	4-R18-27.4	
CY	HOFFMAN FAMILY IRREVOCABLE TRUST	4-R18-27.3	
CZ	LAFOLLETT MARY BETH & LAFOLLETT CHRISTOPHER NEAL	4-R18-21	
DA	CRONIN AMY PERKO & CRONIN CHEYENNE WILLIAM	4-R18-21.4	
DB	MCLAUGHLIN A LEE & KATHLEEN	4-R18-4.2	
DC	ROBINSON RICHARD J	4-R18A-2	
DD	ROBINSON RICHARD J	4-R18A-1	
DE	HUNWAY ROSE	4-R17D-81	
DF	HARE SARAH ELLEN & SWICK ELIZABETH ANN	4-R17D-145	
DG	BRYAN KATHLEEN J & BRYAN STELLA M	4-R17D-144	
DH	MARLING JASON A	4-R17D-143	
DI	SMITH SANDRA E	4-R17D-141	
DJ	RINE DAVID R & TAMMY K	4-R18-4.3	
DK	CHIPILINSKI JUNE A	4-R14-87	
DL	O'BRIEN SEAN P	4-R14-85	
DM	VERCELLOTTI CELESTINA S/5 1996	4-R14R-33	
DN	HEMPELMANN FRIEDRICH ERNST & DEBORAH COLLEEN HEMPFLMANN	4-R14R-32	




07/25/2025

ADJOINING OWNERS TABLE		ADJOINING OWNERS TABLE	
TRACT	SURFACE OWNER	TAX PARCEL	
DO	BECKER CORY M & OLIVIA A	4-R14R-2	
DP	FIGARETTI MARIO ET AL	4-R14R-3	
DQ	WALLACE WILLIAM H	4-R14R-4	
DR	POLUS JODY M & ALEXANDRIA M	4-R14R-5	
DS	POLUS JODY M & ALEXANDRIA M	4-R14R-6	
DT	DIGIANDOMENICO RYAN J & DIGIANDOMENICO KRISTEN LEE	4-R14R-6.1	
DU	DIGIANDOMENICO RYAN J & DIGIANDOMENICO KRISTEN LEE	4-R14R-7	
DV	ALBERTINI BERNARD F & C A	4-R14R-8	
DW	FITZPATRICK ALAN H & ROSE BETTY C	4-R14R-9	
DY	PORCH CHARLES	4-R14R-10	
DZ	SHULTZ MICHAEL A	4-R14R-11	
EA	BELLI DINO P & MEGAN R	4-R14R-12	
EB	BELLI DINO P & MEGAN R	4-R14R-13	
EC	BELLI DINO P & MEGAN R	4-R14R-14	
ED	PLEVA THOMAS M & BARBARA J	4-R14R-15	
EE	SEIVERTSON DAVID J & TRACIE L	4-R14R-16	
EF	GRIFFITH NORMA V	4-R14M-12	
EG	GRIFFITH N V & J E	4-R14M-11	
EH	GRIFFITH DOROTHY V	4-R14M-10	
EI	FORTUNA ALEX C JR	4-R14M-9	
EJ	FORTUNA ALEX C JR	4-R14M-4	
EK	FORTUNA ALEX C JR	4-R14M-4	
EL	GRIFFITH DOROTHY V	4-R14M-2	
EM	GRIFFITH VINCENT A & RITA L	4-R14M-2.9	
EN	GRIFFITH RITA L & VINCENT A JR, TRUSTEE	4-R14M-2.10	
EO	GRIFFITH DOROTHY V	4-R14M-2.6	
EP	GRIFFITH DOROTHY V	4-R14M-2.3	
EQ	KOLAS LINDA L ET AL	4-R14M-1	
ER	GRIFFITH DOROTHY V	4-R14M-2.8	
ES	GANGA PRABHAKAR & KEKA	4-R14H-36	
ET	BERARDINELLI JON L & STEPHANIE	4-R14H-38	
EU	KELLY JAMES & CAROLINE	4-R14H-7	
EV	KELLY JAMES & CAROLINE	4-R14H-6.1	
EW	COSTANZO KATHLEEN A - TOD	4-R14H-6.2	
EX	COSTANZO KATHLEEN A - TOD	4-R14H-6	
EY	TORISEVA TERESA C & JOSHUA D MILLER	4-R14H-5	
EZ	MYNDRESKU SILVIA & MARTIN JOHN	4-R14H-4	
FA	AULICK NEAL F II & GINGER G	4-R14H-11	
FB	ANDREAS THOMAS G & K S (TOD)	4-R14H-10	
FC	LONGO LOUIS	4-R14H-9	
FD	EDGMON JEREMY J AND KARI C	4-R14H-18	
FE	GEYER ANTOINETTE C	4-R14H-30	
FF	KOVALESKY RAY AND LESLIE	10-W14H-29	
FG	KOVALESKY RAY AND LESLIE	10-W14H-2	
FH	KOVALESKY RAY AND LESLIE	10-W14H-3	
FI	CHMEL ELISA A & DEAN T	10-W14H-4	
FJ	CHMEL ELISA A & DEAN T	10-W14H-1.3	
FK	MCCOMBS DAVID BRADLEY	10-W14H-5	
FL	DEGUZMAN CRISTINA L	4-R14-35	
FM	HUGHES MARY ELIZABETH	4-R14-36	
FN	WHEELING PARK COMMISSION	4-R14-15.1	
FO	WHEELING PARK COMMISSION	4-R14-15.2	
FP	CITY OF WHEELING	4-R14-15	
FQ	PARKS SYSTEM TRUST FUND OF WHEELING	4-R1-21.3	
FR	WHEELING PARK COMMISSION	4-R14-91	
FS	WHEELING PARK COMMISSION	4-R1-21.4	
FT	WHEELING PARK COMMISSION	4-R1-20.1	
FU	SISTERS OF ST JOSEPH OF WHG	4-R1-20	
FV	SISTERS OF ST JOSEPH OF WHG	4-R1-21	
FW	KEEFER FRANK JAY - TOD	4-R11-21.28	
FX	KEEFER F JAY	4-R11-39	
FY	RICE BLAISE A	4-R11-31	
FZ	SPIELVOGEL TODD J	4-R11-32	
GA	RUCKMAN MARY ANN TRUST & K CUSTER & D BAUKNECHT TEES	4-R11-29	
GB	MARTIN NATHANIEL M & SCARNECHIA BRANDI L	4-R11-8	
GC	WADSWORTH GARY M & N A	4-R11-9.1	
GD	PADDEN BETH ANN & KARGE LINDA S	4-R11-9	
GE	DERICO DEBORAH KAY - TOD	4-R11-10	
GF	PISSOS DONNA JEAN - TOD	4-R11-11.1	
REVISIONS:			
COMPANY:		Production Company, LLC	
OPERATOR'S		FRANZ THOMAN OHI	
WELL #:		8H	
DISTRICT:		OHIO	
STATE:		WV	
WELL LOCATION PLAT		DRAWING NO:2018-781	
DATE: 02-06-2025		API NO: 47-069-00372	
DRAWN BY: Z. WOOD		SCALE: N/A	
COMPLETION ID 2501170612		PAD ID 3001170565	

07/25/2025

WELL #:

8H

OPERATOR:

FRANZ THOMAN CHI

DATE:

05-08-2025

WELL LOCATION PLAT

DRAWING NO: 2018-781

SCALE:

N/A

DRAWN BY:

S. WOOD

API NO:

43-089-00325

COMPLETION ID

2501170815

PAD ID

3001170825

COMPANY:

Production Company, LLC

Production Company, LLC

WELL #:

8H

OPERATOR:

FRANZ THOMAN CHI

DATE:

05-08-2025

WELL LOCATION PLAT

DRAWING NO: 2018-781

SCALE:

N/A

DRAWN BY:

S. WOOD

API NO:

43-089-00325


ADJOINING OWNERS TABLE			ADJOINING OWNERS TABLE		
TRACT	SURFACE OWNER	TAX PARCEL	TRACT	SURFACE OWNER	TAX PARCEL
GP	DORSEY JOHN T III & L A	10-W14-23	DO	BECKER CORY M & OLIVIA A	4-R14-2
IO	GORDON BRUCE D	10-W14-24	DP	FIGARETTI MARIO ET AL	4-R14-3
IN	DWYER SHELLEY A & VINCENT J JR	10-W14-25	DD	WALLACE WILLIAM H	4-R14-4
IM	OCONEILL LESLIE	10-W14-26	DR	POLUS JODY M & ALEXANDRIA M	4-R14-5
IL	KYLE KELSEY A	10-W14-28	DS	POLUS JODY M & ALEXANDRIA M	4-R14-6
IK	WHYTE LINDA A	10-W14-27	DT	DIGIANDOMENICO RYAN J & DIGIANDOMENICO KRISTEN LEE	4-R14-6.1
II	TUNNEY WILLIAM P	10-W14-14	DU	DIGIANDOMENICO RYAN J & DIGIANDOMENICO KRISTEN LEE	4-R14-7
IH	MCCULLOUGH SAMUEL M & M	10-W14-12	DV	NEWMAN LEWIS S V & C L	4-R14-8
IG	OLSAVSKY JOHN F AND JUDITH A	10-W14-16	DW	ALBERTINI BERNARD F & C A	4-R14-9
IF	LESHUK GARY M & L B	10-W14-17	DX	FITZPATRICK ALAN H & ROSE BETTY C	4-R14-10
IE	ZAMBITO RICARDO D & C A	10-W14-18	DY	PORCH CHARLES	4-R14-11
ID	ZAMBITO RICARDO D & CHERYL A	4-R14-33.1	DZ	SHULTZ MICHAEL A	4-R14-12
IC	SCHMITT LUKE T & NICOLE K	4-R14-33.3	EA	BELLI DINO P & MEGAN R	4-R14-13.1
IB	SCHMITT LUKE T & NICOLE K	4-R14-33.4	EB	BELLI DINO P & MEGAN R	4-R14-13
IA	SCHMITT JEAN M	4-R14-33.5	EC	BELLI DINO P & MEGAN R	4-R14-14
HZ	SCHMITT JEAN M	4-R14-31.5	ED	PLEVA THOMAS M & BARBARA J	4-R14-12
HY	SHACKELFORD JEFFREY D & JODI A	4-R14-36	EE	SEIVERSTON DAVID J & TRACIE J	4-R14-16
HX	LAWSON JOYCE A - TOD	4-R14-51.1	EF	GRIFFITH NORMAN V	4-R14M-12
HW	MICHAELS DIANA J	4-R14-32	EG	GRIFFITH N V & J E	4-R14M-11
HV	PEKLINSKY JAMES S & MONICA J	4-R14-32.1	EH	GRIFFITH DOROTHY V	4-R14M-10
HU	SOBRAY J TRUST; SOBRAY JANICE C TRUSTEE	4-R14-34	EI	FORTUNA ALEX C JR	4-R14M-9
HT	SCHNEIDER CAROLYN JAN	4-R14-30.1	EJ	FORTUNA ALEX C JR	4-R14M-4
H2	WRIGHT TAMMY J	4-R14-30	EK	FORTUNA ALEX C JR	4-R14M-4
HR	MAJEWSKI KAZMIR & MAJEWSKI EDWARD A	4-R8-65.8	EL	GRIFFITH DOROTHY V	4-R14M-5
HQ	MAJEWSKI KAZMIR & MAJEWSKI EDWARD A	4-R8-65.5	EM	GRIFFITH VINCENT J & RITA J	4-R14M-2.9
HP	TAYLOR DELORA J - TOD	4-R8K-100	EN	GRIFFITH RITA J & VINCENT J A JR, TRUSTEE	4-R14M-5.10
HO	MULDERW DAVID R & KAREN	4-R8K-101	EO	GRIFFITH DOROTHY V	4-R14M-5.6
HN	MILLARD BRITTANY LYNN	4-R8-65.6	EP	GRIFFITH DOROTHY V	4-R14M-5.3
HM	WILSON RAY B & ANN M	4-R8-65.7	EQ	KOLAS LINDA J ET AL	4-R14M-1
HJ	BOZENSKA B H AND OKELLEY K J	4-R8K-104	ER	GRIFFITH DOROTHY V	4-R14M-5.8
HK	REED ELMER & JOY	4-R8K-102	ES	GANGA PRABHAKAR & KEKA	4-R14H-36
HJ	SCHWERTFEGGER TYLER S	4-R8K-112	ET	BERARDINELLI JON L STEPHANIE	4-R14H-38
HI	SCHWERTFEGGER TYLER S	4-R8K-111	EU	KELLY JAMES & CAROLINE	4-R14H-7
HH	BOND CHARLES R	4-R8K-110	EV	KELLY JAMES & CAROLINE	4-R14H-6.1
HG	GAYDA DONALD P	4-R8P-18	EW	COSTANZO KATHLEEN A - TOD	4-R14H-6.5
HF	MCGEE JOHN M	4-R8P-17	EX	COSTANZO KATHLEEN A - TOD	4-R14H-6
HE	CRAFT JOSEPH W III FOUNDATION	4-R8-21	EY	TORISEVA AVA TERESA C & JOSEPH D MILLER	4-R14H-2
HD	TUNNEL RIDGE LLC	4-R8P-16	EZ	MYNDRSKU SJIVIA & MARTIN JOHN	4-R14H-4
HC	WEAVER SHIRLEY M	4-R8P-5	FA	AULICK NEAL F II & GINGER G	4-R14H-11
HB	TUNNEL RIDGE LLC	4-R8P-14	FB	ANDREAS THOMAS G & K S (TOD)	4-R14H-10
HA	TUNNEL RIDGE LLC	4-R8-65.4	FC	LONGO LOUIS	4-R14H-9
GZ	NEUMANN KURT ROBERT	4-R11-13	FD	EDMON JEREMY J AND KARI C	4-R14H-18
GY	MOLNAR KRISTINE N	4-R11-13.4	FE	GEYER ANTOINETTE C	4-R14H-30
GX	MOLNAR KRISTINE N	4-R11-13.1	FF	KOVALESKY RAY AND LESLIE	10-W14H-29
GW	MOLNAR KRISTINE N	4-R11-16.4	FG	KOVALESKY RAY AND LESLIE	10-W14H-5
GV	LAWRENCEFIELD CHAPEL TRUSTEES	4-R11-16.8	FH	KOVALESKY RAY AND LESLIE	10-W14H-3
GU	PROTESTANT EPISCOPAL CHURCH DIOCESE OF WV TRUSTEES	4-R11-16.5	FI	CHMEL ELISA A & DEAN T	10-W14H-4
GT	PROTESTANT EPISCOPAL CHURCH DIOCESE OF WV TRUSTEES	4-R11-16.1	FJ	CHMEL ELISA A & DEAN T	10-W14H-1.3
GM	CUNNINGHAM ERIN L & MICHAEL A	4-R14-31.1	FK	MCCOMB DAVID BRADLEY	10-W14H-2
GN	CUNNINGHAM ERIN L & MICHAEL A	4-R14-31	FL	DEGUZMAN CRISTINA J	4-R14-32
GO	GREENE MICHAEL J	4-R14-32	FM	HUGHES MARY ELIZABETH	4-R14-36
GP	CUNNINGHAM ERIN L & MICHAEL A	4-R14-32.1	FN	WHEELING PARK COMMISSION	4-R14-12.1
GQ	MILLER OLIVIA M	4-R14-27	FO	WHEELING PARK COMMISSION	4-R14-12.5
GR	SCHRAMM ALEXANDER M & ALESIA M SCHRAMM	4-R11-16.18	FP	CITY OF WHEELING	4-R14-12
G2	KLOS MARIE A	4-R11-16	FD	PARKS SYSTEM TRUST FUND OF WHEELING	4-R11-21.3
GI	FULOP JOSEF A & C L	4-R14-18	FR	WHEELING PARK COMMISSION	4-R14-91
GH	MOORE CHERYL IRENE ET AL	4-R14-19	F2	WHEELING PARK COMMISSION	4-R11-21.4
GG	CAMPBELL WM P & SUZANNE	4-R11-15	FT	WHEELING PARK COMMISSION	4-R11-20.1

07/25/2025



68011 Vineyard Road
St. Clairsville, Ohio 43950
740-695-6100

GRID NORTH
UTM, NAD83 DATUM, ZONE 17, US FT

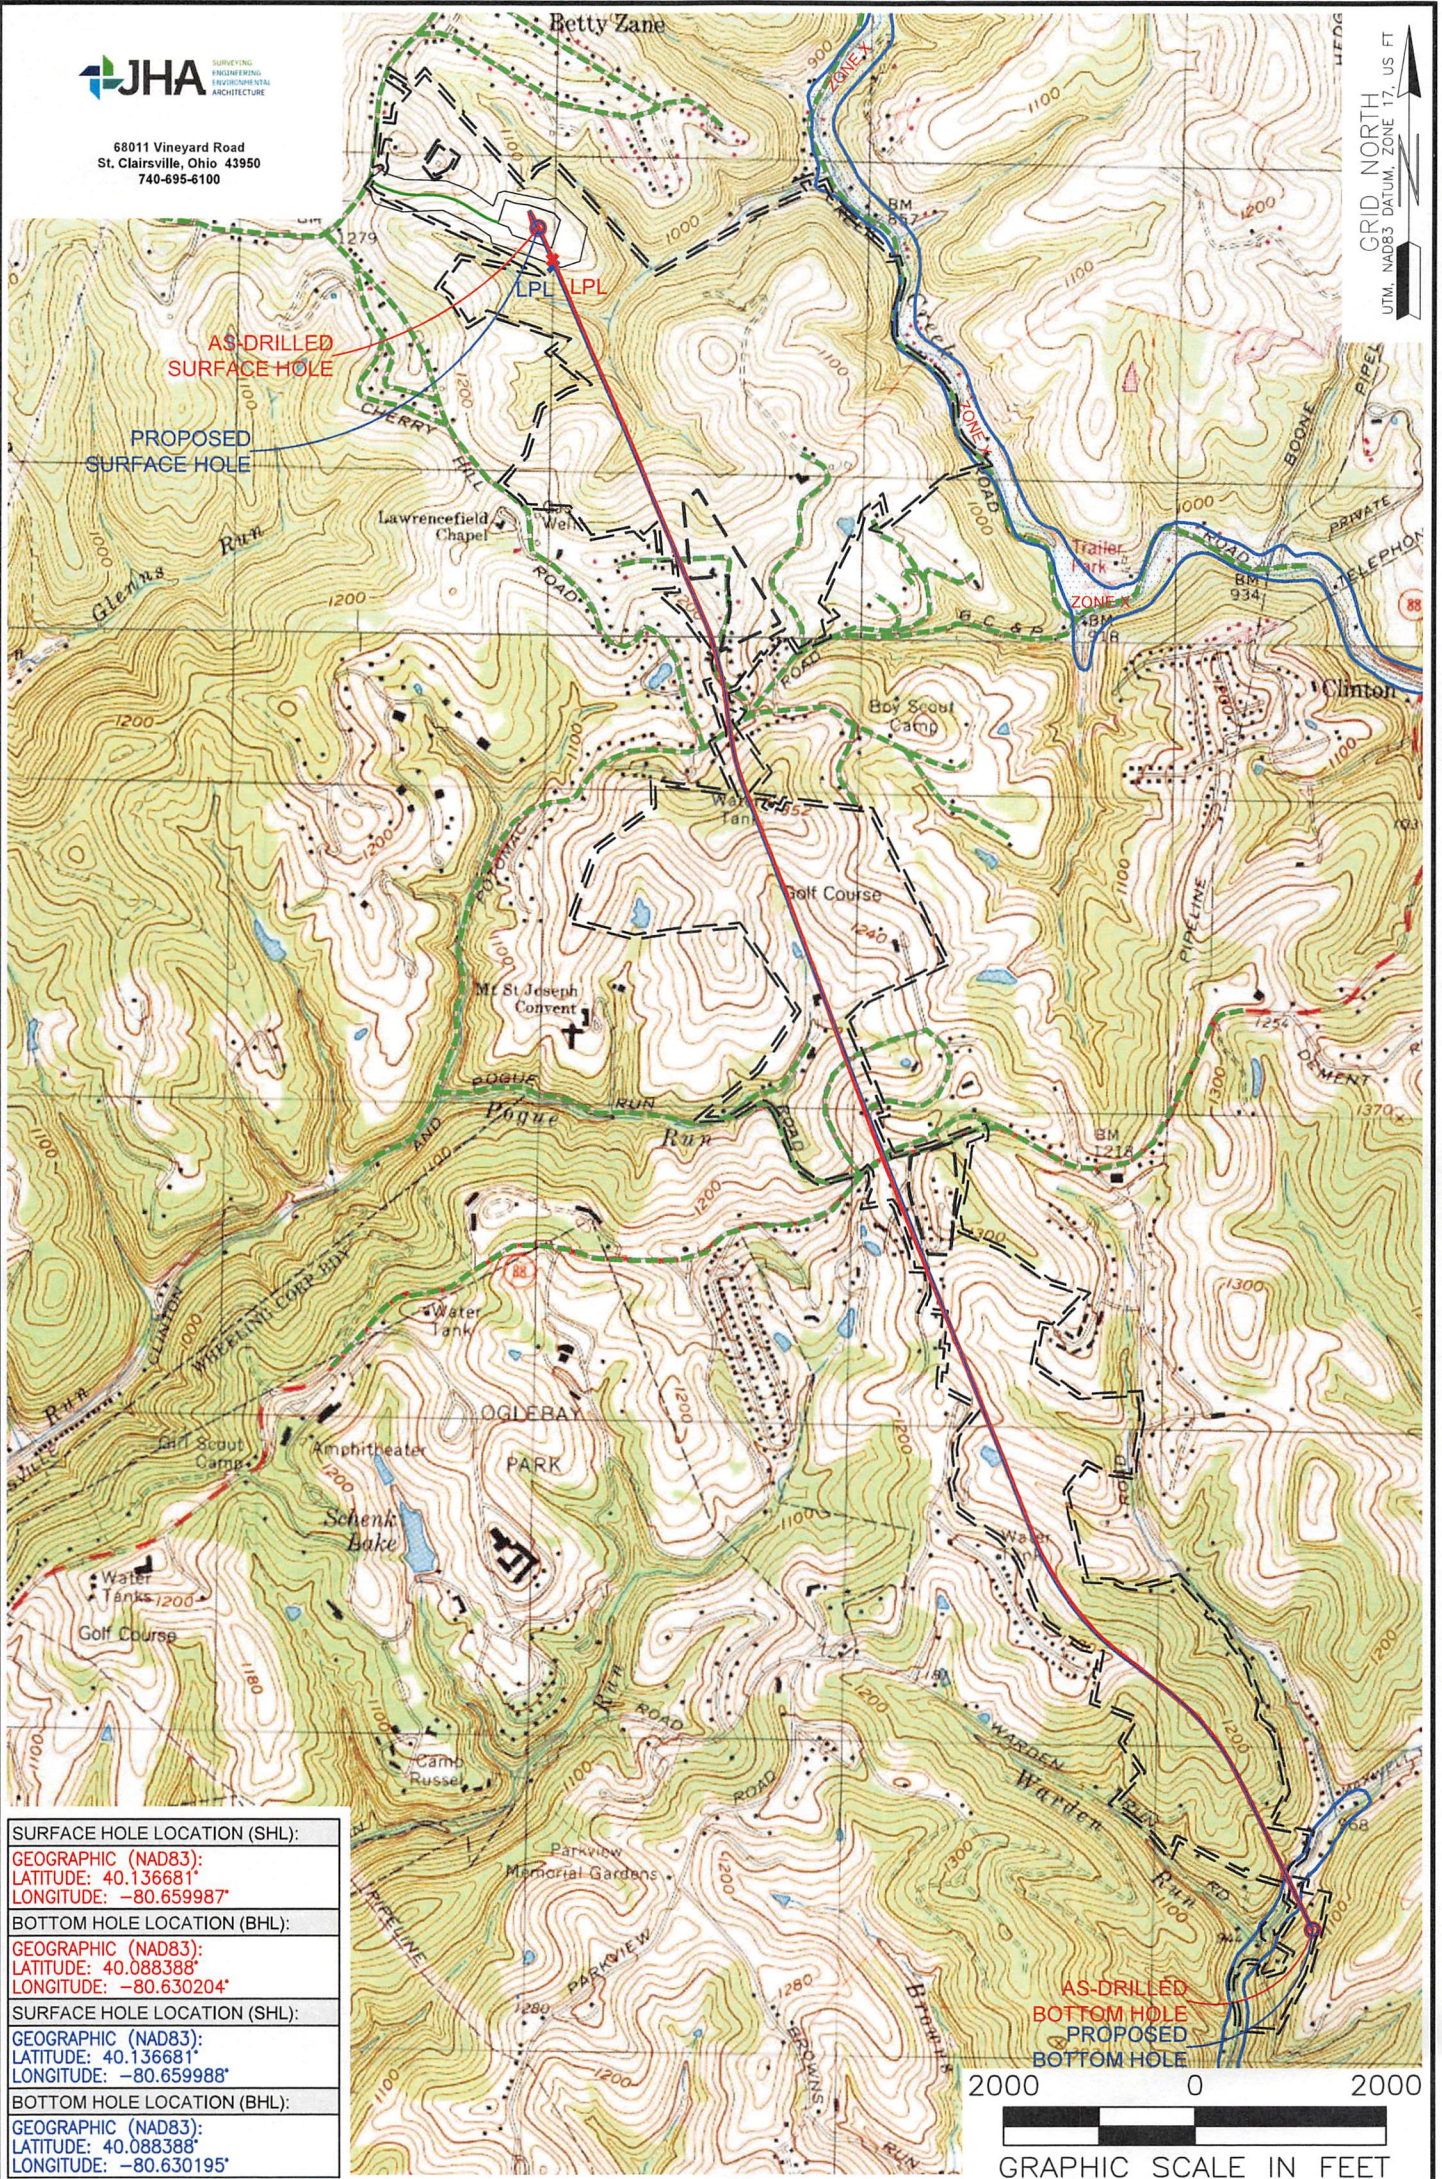

SURFACE HOLE LOCATION (SHL):

GEOGRAPHIC (NAD83):
LATITUDE: 40.136681°
LONGITUDE: -80.659987°

BOTTOM HOLE LOCATION (BHL):

GEOGRAPHIC (NAD83):
LATITUDE: 40.088388°
LONGITUDE: -80.630204°

SURFACE HOLE LOCATION (SHL):

GEOGRAPHIC (NAD83):
LATITUDE: 40.136681°
LONGITUDE: -80.659988°

BOTTOM HOLE LOCATION (BHL):

GEOGRAPHIC (NAD83):
LATITUDE: 40.088388°
LONGITUDE: -80.630195°

NOTES ON SURVEY

1. SURFACE AND ROYALTY OWNER INFORMATION AND THEIR BOUNDARIES SHOWN HEREON WERE PLOTTED FROM DEEDS AND/OR TAX PARCEL MAPS PROVIDED BY CLIENT AND/OR FIELD LOCATIONS.
2. THIS PLAT DOES NOT REPRESENT A BOUNDARY SURVEY OF THE PARCELS SHOWN HEREON.
3. ALL INSETS ARE GRID NORTH UNLESS OTHERWISE DEPICTED.

LEGEND:

- EXISTING BOTTOM HOLE
- EXISTING / PRODUCING WELLHEAD
- LPL EXISTING LANDING POINT LOCATION
- PROPOSED SURFACE HOLE / BOTTOM HOLE
- LPL PROPOSED LANDING POINT LOCATION

- 07/25/2025
- PUBLIC ROAD
- FLOOD PLAIN
- LEASE BOUNDARY
- ASDRILLED PATH
- PROPOSED PATH

WELL OPERATOR:
SWN PRODUCTION COMPANY, LLC

ADDRESS:
1300 FORT PIERPONT DRIVE, SUITE 201, MORGANTOWN, WV 26508

SURFACE OWNER:
FRANZ THOMAN

WELL (FARM) NAME:
FRANZ THOMAN OHI

COUNTY:
OHIO

CODE:
069

DISTRICT:
RICHLAND

API #
47-069-00372

USGS 7 1/2 QUADRANGLE MAP NAME:
TILTONVILLE, OH-WV