

State of West Virginia
Department of Environmental Protection - Office of Oil and Gas
Well Operator's Report of Well Work

RECEIVED
Office Of Oil and Gas
JUL 31 2025
WV Department of
Environmental Protection

API 47 - 069 - 00375 County Ohio District Richland
Quad Wheeling Pad Name Shannon Fields Field/Pool Name Panhandle Field - Wet
Farm name Shannon Fields OHI Well Number 3H
Operator (as registered with the OOG) SWN Production Company LLC
Address PO Box 12359 City Spring State TX Zip 77391

As Drilled location NAD 83/UTM Attach an as-drilled plat, profile view, and deviation survey
Top hole Northing 4,437,620.565 Easting 529,167.475
Landing Point of Curve Northing 4,437,368.620 Easting 528,353.578
Bottom Hole Northing 4,444,411.517 Easting 525,656.495

Elevation (ft) 1,236.13 GL Type of Well ☒ New ☐ Existing Type of Report ☐ Interim ☒ Final
Permit Type ☐ Deviated ☒ Horizontal ☐ Horizontal 6A ☐ Vertical Depth Type ☐ Deep ☒ Shallow
Type of Operation ☐ Convert ☐ Deepen ☒ Drill ☐ Plug Back ☐ Redrilling ☐ Rework ☒ Stimulate
Well Type ☐ Brine Disposal ☐ CBM ☒ Gas ☐ Oil ☐ Secondary Recovery ☐ Solution Mining ☐ Storage ☐ Other _____
Type of Completion ☒ Single ☐ Multiple Fluids Produced ☐ Brine ☒ Gas ☐ NGL ☐ Oil ☐ Other _____
Drilled with ☐ Cable ☒ Rotary


Drilling Media Surface hole ☒ Air ☐ Mud ☒ Fresh Water Intermediate hole ☒ Air ☐ Mud ☐ Fresh Water ☐ Brine
Production hole ☒ Air ☒ Mud ☐ Fresh Water ☐ Brine
Mud Type(s) and Additive(s)
SOBM

Date permit issued 2024-11-24 Date drilling commenced 2025-02-11 Date drilling ceased 2025-02-26
Date completion activities began 2025-04-09 Date completion activities ceased 2025-06-06
Verbal plugging (Y/N) N Date permission granted N/A Granted by N/A

Please note: Operator is required to submit a plugging application within 5 days of verbal permission to plug

Freshwater depth(s) ft 356' Open mine(s) (Y/N) depths N
Salt water depth(s) ft 606' Void(s) encountered (Y/N) depths N
Coal depth(s) ft 487' Cavern(s) encountered (Y/N) depths N
Is coal being mined in area (Y/N) N

Reviewed by:

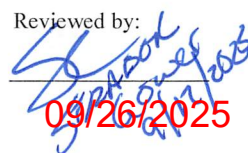
09/26/2025

JUL 31 2025

Page 2 of 4

WR-35
Rev. 8/23/13

API 47-069 - 00375

Farm name Shannon Fields OHI

WV Department of
Environmental Protection
Well number 3H

CASING STRINGS	Hole Size	Casing Size	Depth	New or Used	Grade wt/ft	Basket Depth(s)	Did cement circulate (Y/ N) * Provide details below*
Conductor	20.000	20.000	136		J-55/94.00		Y
Surface	17.500	13.375	553		J-55/54.50		Y
Coal							
Intermediate 1	12.250	9.625	2,323		J-55/36.00		Y
Intermediate 2							
Intermediate 3							
Production	8.500	5.500	32,010		P-110/20.00		Y
Tubing		2.875	0		P-110/6.50		
Packer type and depth set							

Comment Details _____

CEMENT DATA	Class/Type of Cement	Number of Sacks	Slurry wt (ppg)	Yield (ft ³ /sks)	Volume (ft ³)	Cement Top (MD)	WOC (hrs)
Conductor	Class A	Grout to Surface				Surface	24
Surface	Class A	981	15.6	1.19	0	Surface	8
Coal							
Intermediate 1	Class A	899	15.6	1.18	0	Surface	8
Intermediate 2							
Intermediate 3							
Production	Class A	6,154	14.5	1.26	0	Surface	24
Tubing							

Drillers TD (ft) 32,010 Loggers TD (ft) 32,010

Deepest formation penetrated Marcellus Plug back to (ft) 0

Plug back procedure N/A

Kick off depth (ft) _____

Check all wireline logs run ☒ caliper ☒ density ☒ deviated/directional ☐ induction
☒ neutron ☒ resistivity ☐ gamma ray ☒ temperature ☐ sonicWell cored ☐ Yes ☒ No Conventional Sidewall Were cuttings collected ☐ Yes ☒ No

DESCRIBE THE CENTRALIZER PLACEMENT USED FOR EACH CASING STRING _____

SURFACE: CENTRALIZERS - EVERY THIRD JOINT OF CASING

INTERMEDIATE: CENTRALIZERS - EVERY THIRD JOINT OF CASING

PRODUCTION: CENTRALIZERS - EVERY THIRD JOINT FROM SURFACE TO TOP OF CURVE, THEN EVERY JOINT UNTIL TD

WAS WELL COMPLETED AS SHOT HOLE ☐ Yes ☒ No DETAILS _____WAS WELL COMPLETED OPEN HOLE? ☐ Yes ☒ No DETAILS _____WERE TRACERS USED ☐ Yes ☒ No TYPE OF TRACER(S) USED _____

09/26/2025

Page 3 of 4

WR-35
Rev. 8/23/13

API 47-069 - 00375 Farm name Shannon Fields OHI Well number 3H

PERFORATION RECORD

[illegible]

Please insert additional pages as applicable.

STIMULATION INFORMATION PER STAGE

Complete a separate record for each stimulation stage.

[illegible]

Please insert additional pages as applicable.

09/26/2025

<u>PRODUCING FORMATION(S)</u>	<u>DEPTHS</u>	
Marcellus	6,038'	TVD 6,950'
		MD

RECEIVED
Office Of Oil and Gas
JUL 31 2025
WV Department of
Environmental Protection

OPEN FLOW	Gas		Oil		NGL		Water		GAS MEASURED BY		
	9,791	mcfpd	1,604	bpd	0	bpd	2,750	bpd	☐ Estimated	☒ Orifice	☐ Pilot

[illegible]

09/26/2025

Hydraulic Fracturing Fluid Product Component Information Disclosure

Job Start Date:	04/25/2025
Job End Date:	05/14/2025
State:	West Virginia
County:	Ohio
API Number:	47-069-00375-00-00
Operator Name:	Expand Operating LLC
Well Name and Number:	SHANNON FIELDS OHI 3H
Latitude:	40.088289
Longitude:	-80.658058
Datum:	NAD83
Federal Well:	NO
Indian Well:	NO
True Vertical Depth:	6073.9
Total Base Water Volume (gal)*:	38225840
Total Base Non Water Volume:	134376.7



Water Source	Percent
Surface Water, < 1000TDS	81.41%
Produced Water	18.59%

RECEIVED
Office Of Oil and Gas
JUL 31 2025
WV Department of
Environmental Protection

Hydraulic Fracturing Fluid Composition:

Trade Name	Supplier	Purpose	Ingredients	Chemical Abstract Service Number (CAS #)	Maximum Ingredient Concentration in Additive (% by mass)**	Maximum Ingredient Concentration in HF Fluid (% by mass)**	Comments
655 NM	Expand Completion Services	Scale Inhibitor					
Base Water	Operator	Base Fluid					
FERRIPLEX 80	Expand Completion Services	Iron Control Agent					
FSTI-CI-02	Expand Completion Services	Corrosion Inhibitor					
Hydrochloric Acid	Expand Completion Services	Solvent					
Plexslick CX 810	Expand Completion Services	Friction Reducer					
Sand	Expand Completion Services	Proppant					

09/26/2025

Tolcide 4 Frac 50	Expand Completion Services	Biocide					
Items above are Trade Names. Items below are the individual ingredients.							
			Water	7732-18-5	100.00000	87.72709	
			Crystalline Silica, Quartz	14808-60-7	100.00000	12.12321	
			HYDROCHLORIC ACID	7647-01-0	37.00000	0.09258	
			Copolymer of 2-propenamide	Proprietary	60.00000	0.02395	
			Isoalkanes	64742-47-8	30.00000	0.01796	
			Phosphonium, tetrakis(hydroxymethyl)-, sulfate (2:1)	55566-30-8	50.00000	0.00646	
			Ethoxylated Tridecanol	Proprietary	2.50000	0.00299	
			Surfactant	Proprietary	3.00000	0.00180	
			Sodium erythorbate	6381-77-7	98.00000	0.00131	
			Quaternary ammonium compounds, benzyl-C12-16- alkyldimethyl, chlorides	68424-85-1	10.00000	0.00129	
			Ethanol	64-17-5	1.50000	0.00065	
			Ethylene glycol	107-21-1	40.00000	0.00015	
			Cinnamaldehyde	104-55-2	19.00000	0.00007	
			1-Octanol	111-87-5	19.00000	0.00007	
			1-Decanol	112-30-1	19.00000	0.00007	
			N,N-Dimethylformamide	68-12-2	19.00000	0.00007	
			Triethyl phosphate	78-40-0	19.00000	0.00007	
			Poly(oxy-1,2-ethanediyl), .alpha.- (nonylphenyl)-.omega.- hydroxy-	9016-45-9	19.00000	0.00007	
			2-Butoxyethanol	111-76-2	10.00000	0.00004	
			Isopropyl alcohol	67-63-0	10.00000	0.00004	
			Tar bases, quinoline derivatives, benzyl chloride- quaternized	72480-70-7	10.00000	0.00004	

* Total Water Volume sources may include various types of water including fresh water, produced water, and recycled water

** Information is based on the maximum potential for concentration and thus the total may be over 100%

Note: For Field Development Products (products that begin with FDP), MSDS level only information has been provided.

Ingredient information for chemicals subject to 29 CFR 1910.1200(i) and Appendix D are obtained from suppliers Material Safety Data Sheets (MSDS)

RECEIVED
Office Of Oil and Gas
JUL 31 2025
WV Department of
Environmental Protection

09/26/2025

Company Name	SHANNON FIELDS OHI 3H - Original Hole
Operator	EXPAND OPERATING LLC
Location	SOUTHWEST APPALACHIA
Product	EXPAND OPERATING LLC

AFE	
Company	
Latitude	40.088289
Longitude	-80.658058

	1	2	3	4	5	6	7	8	9	10	11	12	13	14	15	16	17	18	19
Top Perf (ft)	31,829	31,617	31,509	31,201	30,992	30,784	30,576	30,367	30,159	29,950	29,742	29,534	29,325	29,117	28,909	28,700	28,492	28,284	28,075
Bottom Perf (ft)	31,921	31,793	31,668	31,543	31,418	31,293	31,168	31,043	30,918	30,793	30,668	30,543	30,418	30,293	30,168	30,043	29,918	29,793	29,668
Number of Perforations	36	36	36	36	36	36	36	36	36	36	36	36	36	36	36	36	36	36	36
Per Hole ID (in)	0.41	0.41	0.41	0.41	0.41	0.41	0.41	0.41	0.41	0.41	0.41	0.41	0.41	0.41	0.41	0.41	0.41	0.41	0.41
Capacity to Top Perf (bbls)	5,868	5,870	5,873	5,875	5,877	5,879	5,881	5,882	5,884	5,885	5,886	5,887	5,888	5,889	5,890	5,891	5,892	5,893	5,894
Capacity to Bottom Perf (bbls)	706	702	697	693	688	683	679	674	669	665	660	656	651	646	642	637	632	627	622
Survey (Indication)	709	705	701	696	692	687	683	678	673	669	664	659	655	650	646	641	636	632	627
Mid-Perf (MD)	31,875	31,705	31,497	31,289	31,080	30,872	30,664	30,455	30,247	30,038	29,830	29,622	29,413	29,205	28,997	28,788	28,580	28,372	28,163
Total Stage Time (hrs)	21.55	3.47	2.78	1.65	1.55	2.37	2.40	2.33	2.38	2.43	2.98	2.32	2.58	2.30	2.12	2.18	2.47	3.58	2.02
15 % HCI Acid (bbls)	980	2,550	2,436	2,765	2,810	3,149	2,961	2,869	2,746	2,807	2,862	3,102	2,916	3,164	3,227	3,100	2,994	2,576	2,402
Number of Perforations	3	3	3	3	3	3	3	3	3	3	3	3	3	3	3	3	3	3	3
Perf Spacing (ft)	35	35	35	35	35	35	35	35	35	35	35	35	35	35	35	35	35	35	35
Pump down (bbls)	161	155	143	141	145	144	144	144	144	144	144	135	135	133	131	133	129	145	133
Frac Water (bbls)	9,107	8,617	7,660	7,966	7,911	7,899	7,860	7,852	7,719	7,943	7,893	7,861	7,892	7,878	7,797	7,756	7,808	7,899	7,890
Load to Recover (Total Vol Pumped) (bbls)	9,107	8,778	7,815	8,121	8,054	8,040	8,105	7,991	7,869	8,087	8,037	7,996	8,027	8,011	7,928	7,889	7,937	8,044	8,023
Slurry Volume (bbls)	9,321	9,219	8,193	8,458	8,441	8,458	8,508	8,389	8,269	8,490	8,442	8,399	8,432	8,420	8,333	8,289	8,343	8,448	8,431
100 Mesh (bbls)	146,720	147,750	152,160	149,720	151,030	151,240	150,800	150,800	151,890	150,360	151,890	151,260	151,260	151,320	152,590	151,730	152,750	152,960	152,960
20/40, 30/50, 30/70, & 40/70 (lbs)	188,470	215,830	216,070	213,950	216,460	217,960	219,180	217,760	212,880	218,760	217,940	217,180	217,820	217,720	217,200	217,380	222,040	221,200	221,200
Total Prop from Stim Int Prop Table (lbs)	195,390	370,330	363,820	366,110	366,180	368,990	370,420	368,560	364,730	369,320	371,830	368,440	369,080	369,030	369,750	369,110	370,290	374,570	374,160
Total Prop from StimStageTable (lbs)	195,390	370,330	363,820	366,110	366,180	368,990	370,420	368,560	364,730	369,320	371,830	368,440	369,080	369,030	369,750	369,110	370,290	374,570	374,160
Avg Rate (bbls/min)	75	77	82	90	88	86	88	88	87	88	87	92	91	93	91	89	88	91	91
Avg Pressure (psi)	9,627	9,463	9,518	10,062	10,151	10,131	10,254	10,226	10,076	10,086	10,109	10,160	10,293	10,422	9,869	9,934	9,970	10,302	10,409
Max Rate (bpm)	83	82	82	91	100	100	97	97	97	96	100	93	93	100	99	100	96	97	98
Max Pressure (psi)	10,024	9,919	9,951	10,540	10,518	10,531	10,337	10,485	10,462	10,498	10,424	10,477	10,559	10,840	10,281	10,467	10,419	10,578	10,689
Break Pressure (psi)	8,878	5,190	5,016	4,755	4,815	4,795	4,990	4,619	4,618	4,800	4,896	4,625	4,720	4,795	4,894	4,756	4,672	4,672	5,019
ISIP (psi)	3,421	4,272	3,906	4,022	4,683	4,394	4,268	4,215	4,121	4,125	4,578	4,265	4,245	4,245	4,055	4,028	4,193	4,258	4,181
FG (psi/ft)	1.01	1.15	1.09	1.11	1.22	1.17	1.15	1.14	1.12	1.12	1.12	1.15	1.16	1.16	1.11	1.11	1.14	1.15	1.13
Corrosion (gal)	363	31	27	28	28	28	28	28	28	28	28	28	28	28	28	28	28	28	29
Corrosion Inhibitor (lbs)	3	3	3	3	3	3	3	3	3	3	3	3	3	3	3	3	3	3	3
Filtration Reducer (gal)	9,113	8,053	8,055	8,427	7,593	7,166	7,448	8,115	6,881	6,981	7,235	8,276	6,508	6,540	8,216	6,805	5,852	5,351	5,421
HCI 15% (gal)	1,400	1,400	1,400	1,400	1,400	1,400	1,400	1,400	1,400	1,400	1,400	1,400	1,400	1,400	1,400	1,400	1,400	1,000	1,000
Scale Inhibitor (gal)	36	31	27	28	28	28	28	29	28	28	28	28	28	28	28	28	28	28	29
Breaker																			
Average Density (SG)																			
Average of pH																			
Average of Conductivity																			
Average of Calcium																			
Average of Magnesium																			
Average of Chlorides																			
Average of Iron																			
Average of Temp pH																			
Fluid Density (lb/gal)																			
Frac																			
Pumpdown																			
HCI 15%																			
HCI 7.5%																			
Difference																			
Frac																			
PD																			

09/26/2025



Well Name: Shannon Fields OHI 3H 47069003750000

LITHOLOGY/FORMATION	TOP DEPTH, MD (FT)	TOP DEPTH, TVD (FT)	BOTTOM DEPTH, MD (FT)	BOTTOM DEPTH, TVD (FT)
Base of Fresh Water	0	0	356	356
Top of Salt Water	606	606	NA	NA
Pittsburgh Coal	487	487	493	493
Pottsville (ss)	682	682	742	742
Raven Cliff (ss)	959	956	1412	1401
Maxton (ss)	1412	1401	1519	1505
Big Injun (ss)	1557	1542	1858	1830
Berea (siltstone)	2159	2109	2198	2144
Rhinstreet (shale)	6159	5518	6453	5759
Cashaqua (shale)	6453	5759	6526	5813
Middlesex (shale)	6526	5813	6630	5884
Burket (shale)	6630	5884	6660	5903
Tully (ls)	6660	5903	6744	5951
Mahantango (shale)	6744	5951	6950	6038
Marcellus (shale)	6950	6038	NA	NA

RECEIVED
Office Of Oil and Gas


JUL 31 2025

WV Department of
Environmental Protection

09/26/2025



SURVEYOR/ENGINEER:
1700 ANMOORE ROAD
BRIDGEPORT, WV 26330
1-304-933-3463

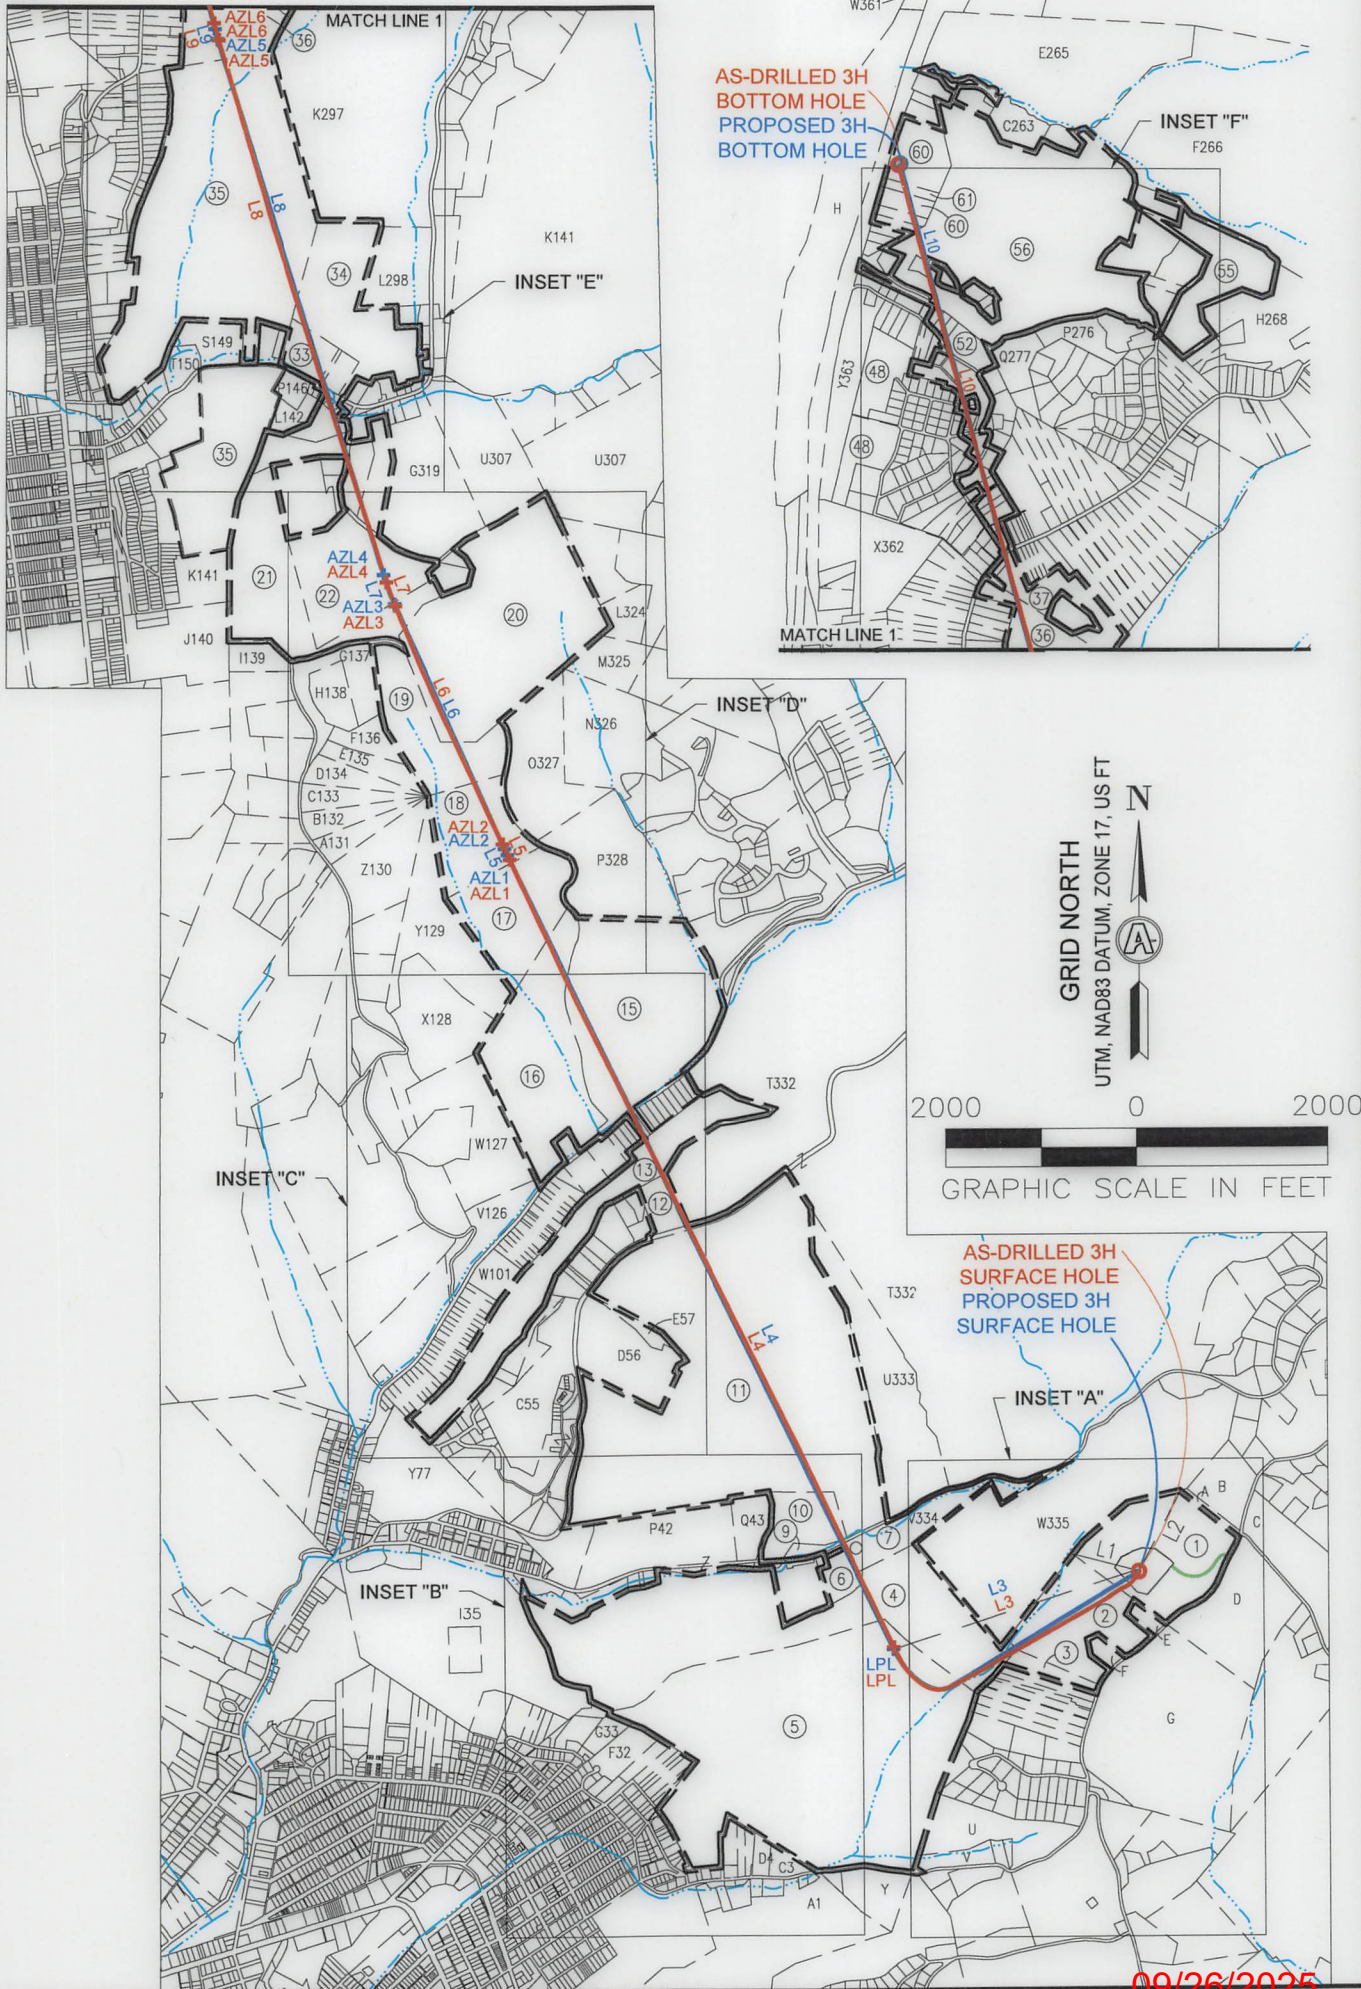

09/26/2025

REVISIONS:

COMPANY:



OPERATOR'S

SHANNON FIELDS OHI

DATE: 03-31-2025

WELL #:

3H

DRAWN BY: TMF

DISTRICT:

RICHLAND

COUNTY:

OHIO

STATE:

WV


SCALE: N/A

DRAWING NO: ACE-2326

WELL LOCATION PLAT



SURVEYOR/ENGINEER:
1700 ANMOORE ROAD
BRIDGEPORT, WV 26330
1-304-933-3463

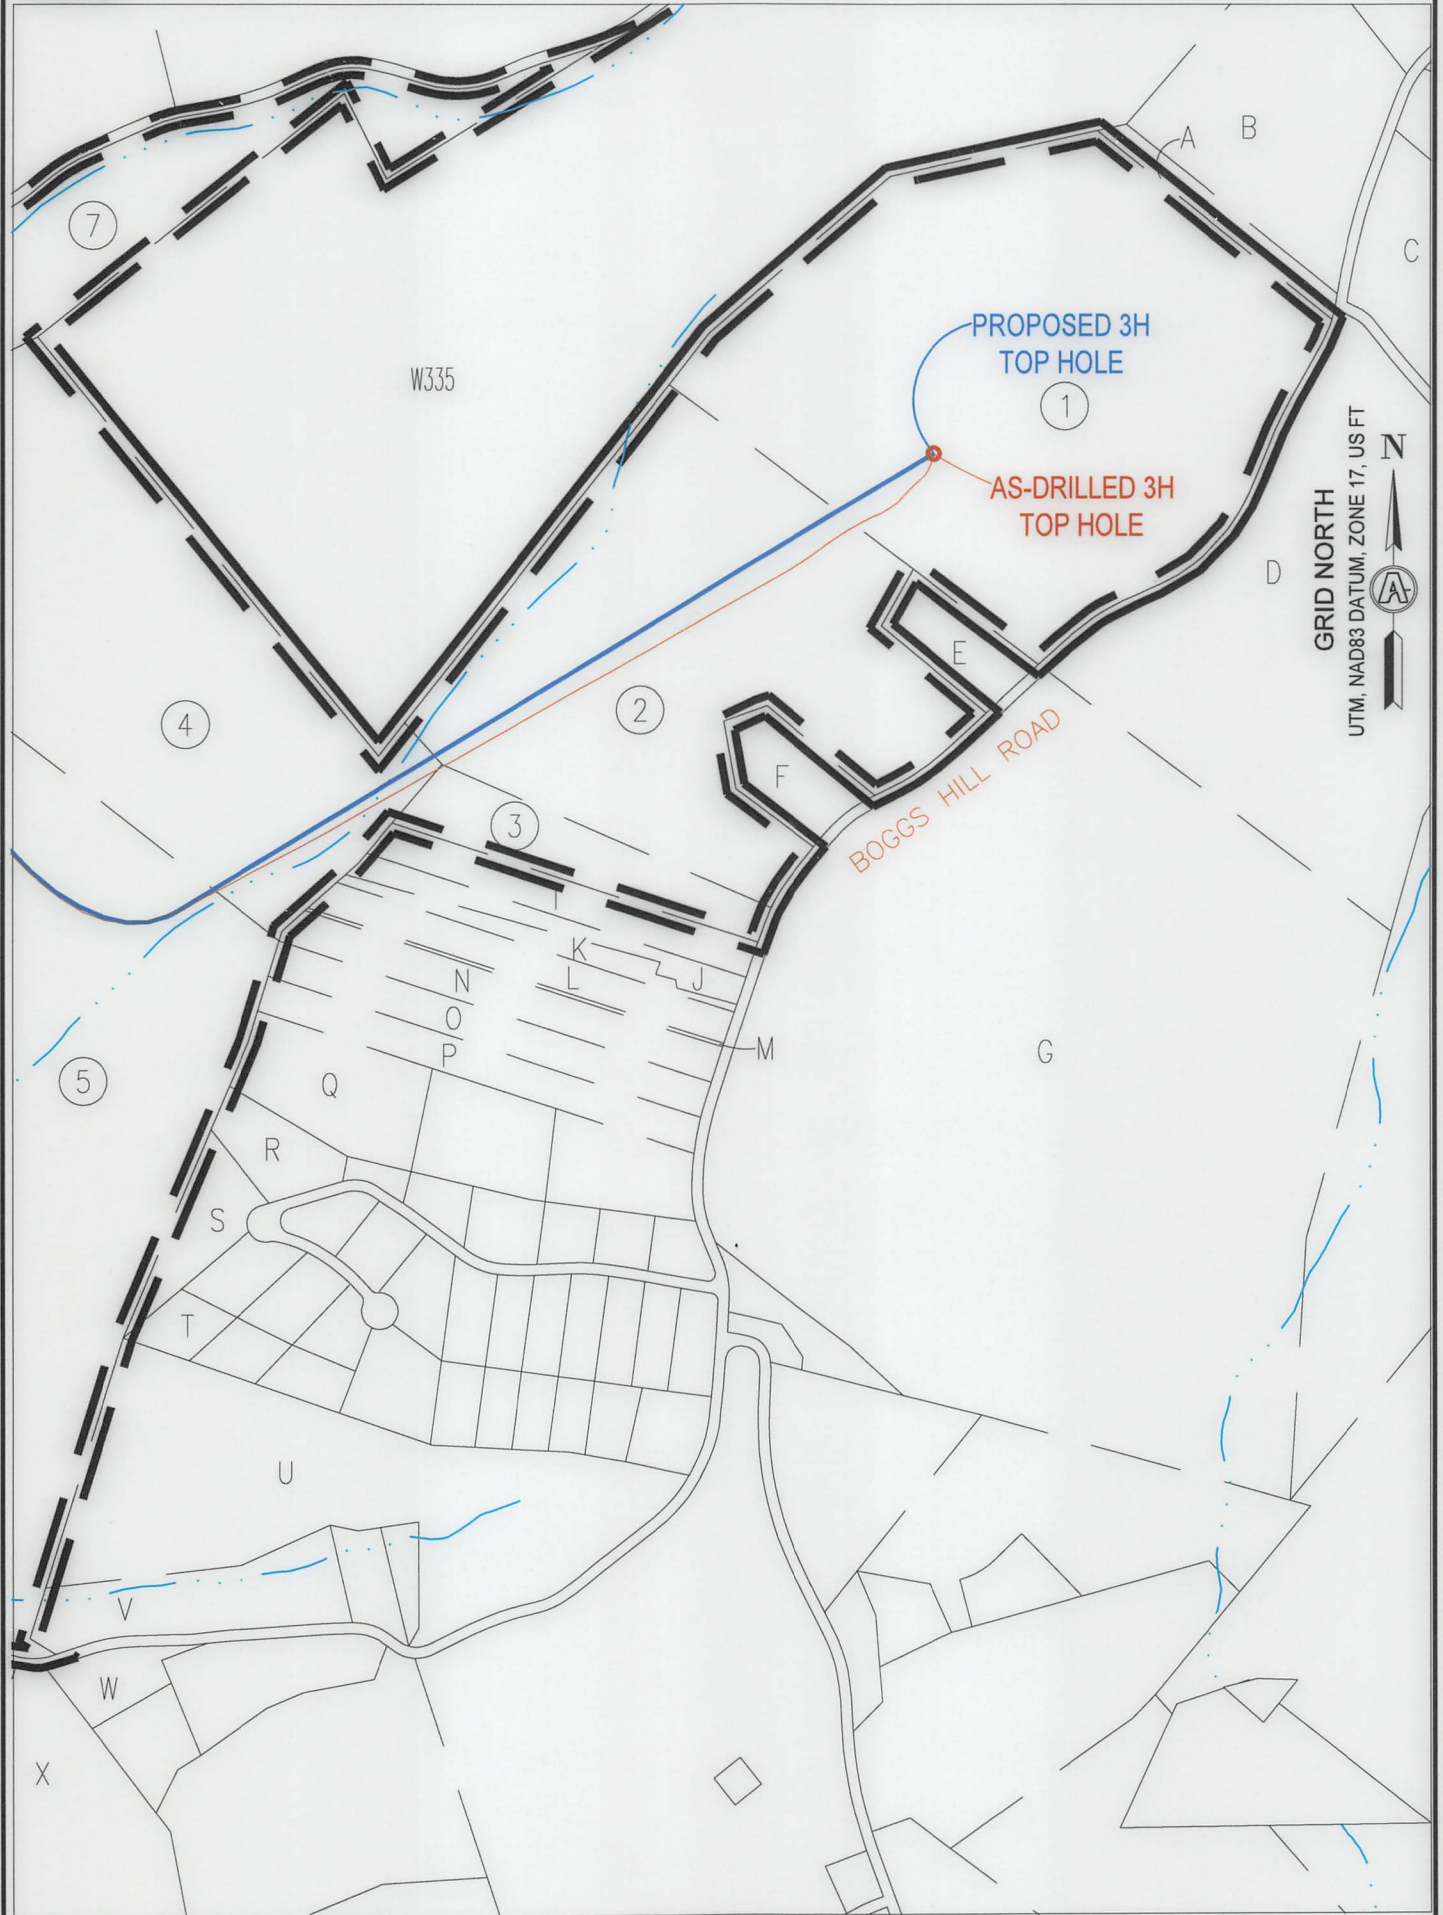

GRID NORTH
UTM, NAD83 DATUM, ZONE 17, US FT

INSET "A"
SCALE: 1"=500'

REVISIONS:		COMPANY:		09/26/2025	
OPERATOR'S		SHANNON FIELDS OHI		DATE: 03-31-2025	
WELL #:		3H		DRAWN BY: TMF	
DISTRICT:		COUNTY:	STATE:	SCALE: N/A	
RICHLAND		OHIO	WV	DRAWING NO: ACE-2326	
				WELL LOCATION PLAT	



SURVEYOR/ENGINEER:
1700 ANMOORE ROAD
BRIDGEPORT, WV 26330
1-304-933-3463



GRID NORTH
UTM, NAD83 DATUM, ZONE 17, US FT

INSET "B"
SCALE: 1"=500'


09/26/2025

03/31/2025

REVISIONS:	COMPANY:				
OPERATOR'S			SHANNON FIELDS OHI		DATE: 03-31-2025
WELL #:			3H		DRAWN BY: TMF
DISTRICT:		COUNTY:	STATE:	SCALE:	N/A
RICHLAND		OHIO	WV	DRAWING NO:	ACE-2326
					WELL LOCATION PLAT



SURVEYOR/ENGINEER:
1700 ANMOORE ROAD
BRIDGEPORT, WV 26330
1-304-933-3463

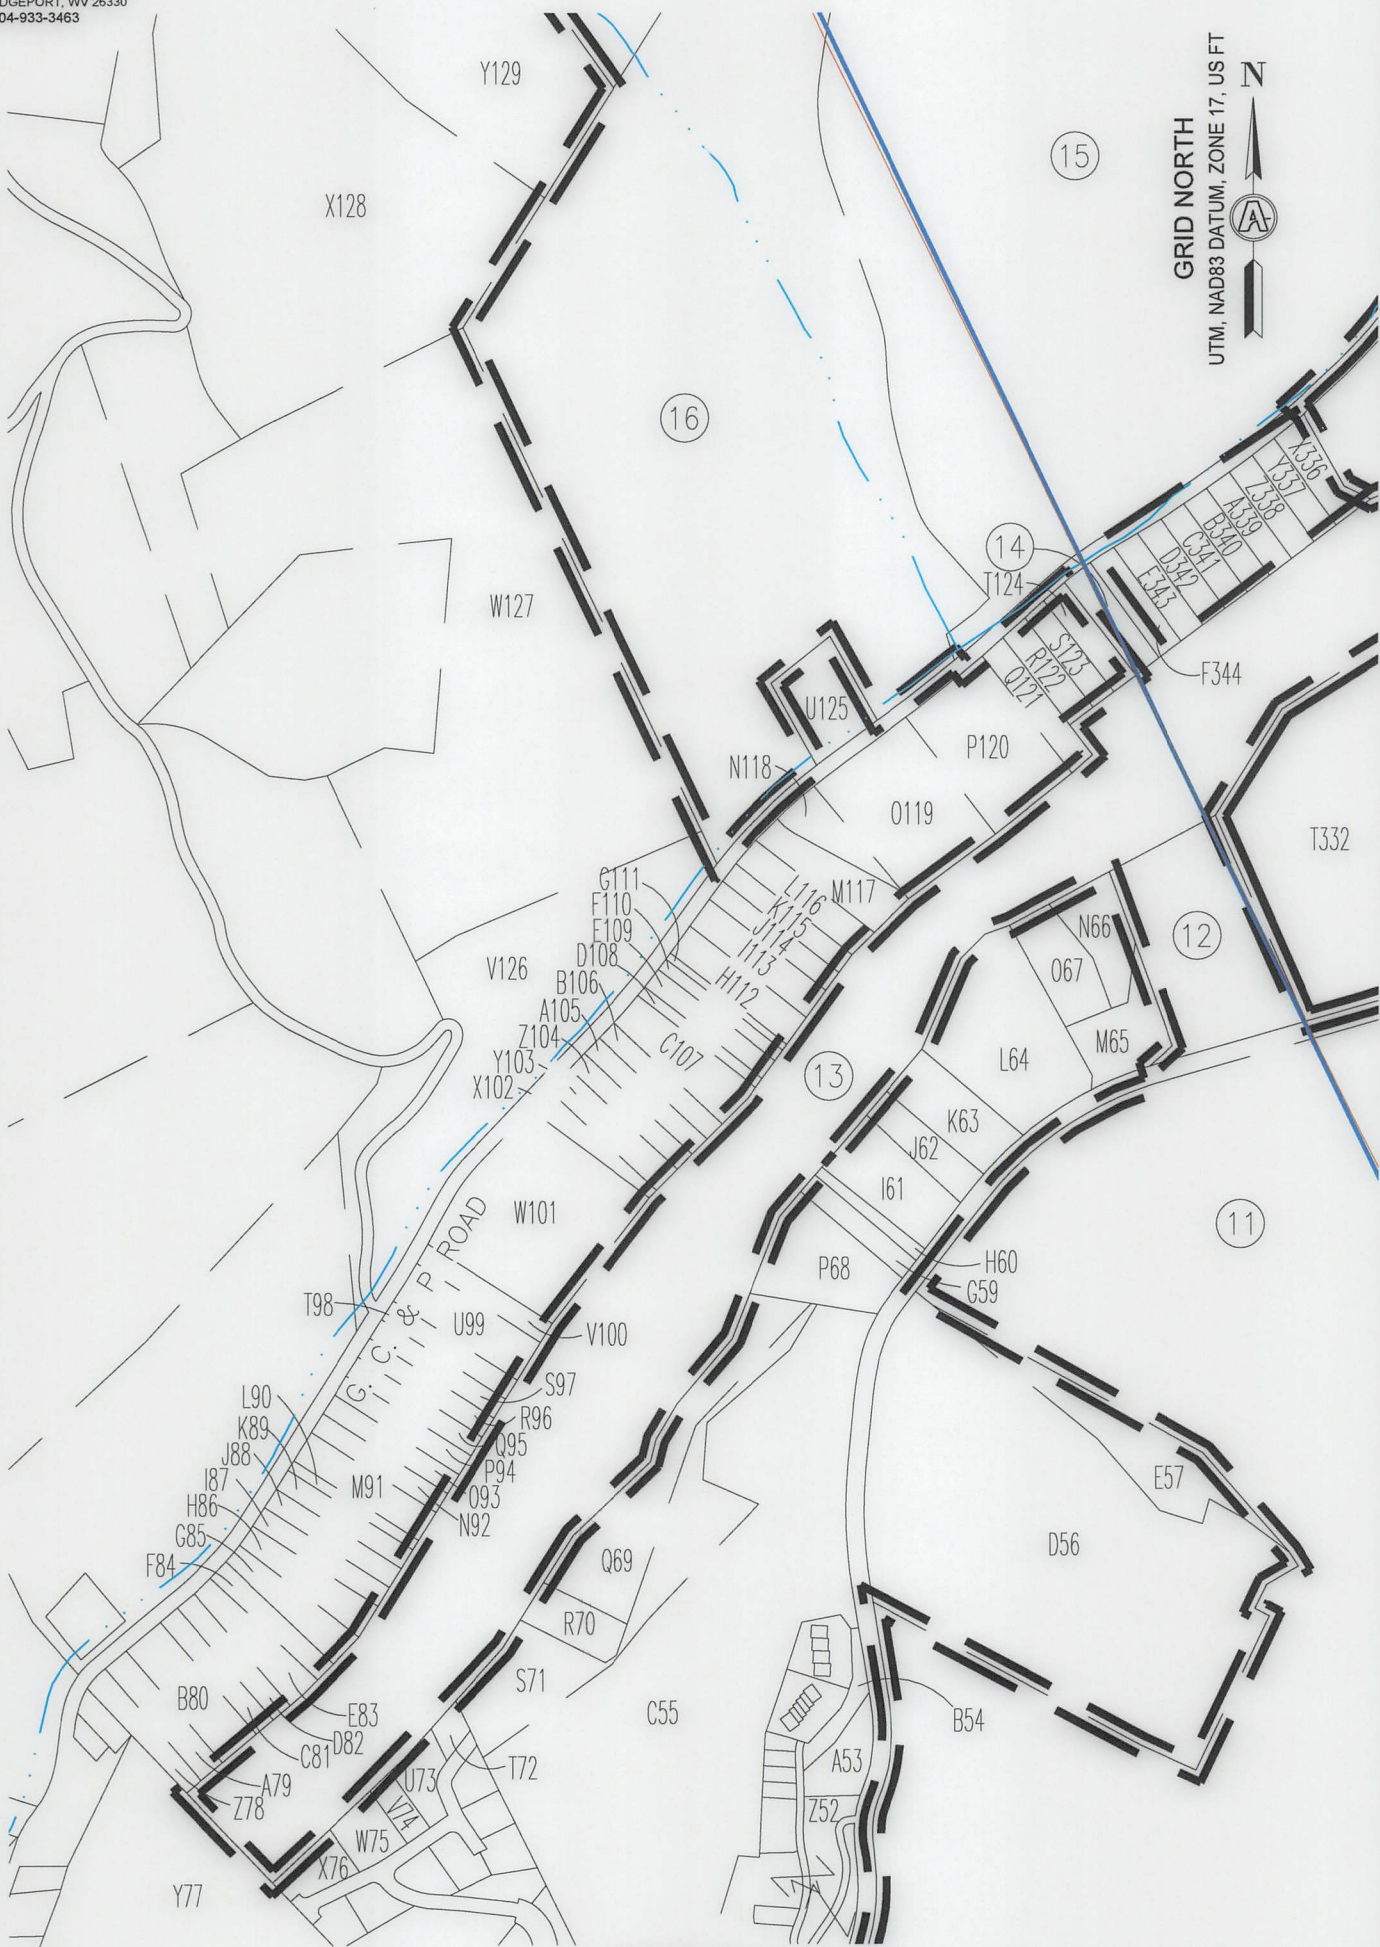

INSET "C"
SCALE: 1"=500'

09/26/2025

REVISIONS:

COMPANY:



OPERATOR'S

SHANNON FIELDS OHI

DATE: 03-31-2025

WELL #:

3H

DRAWN BY: TMF

DISTRICT:
RICHLAND


COUNTY:
OHIO

STATE:
WV

SCALE: N/A
DRAWING NO: ACE-2326
WELL LOCATION PLAT




SURVEYOR/ENGINEER:
1700 ANMOORE ROAD
BRIDGEPORT, WV 26330
1-304-933-3463

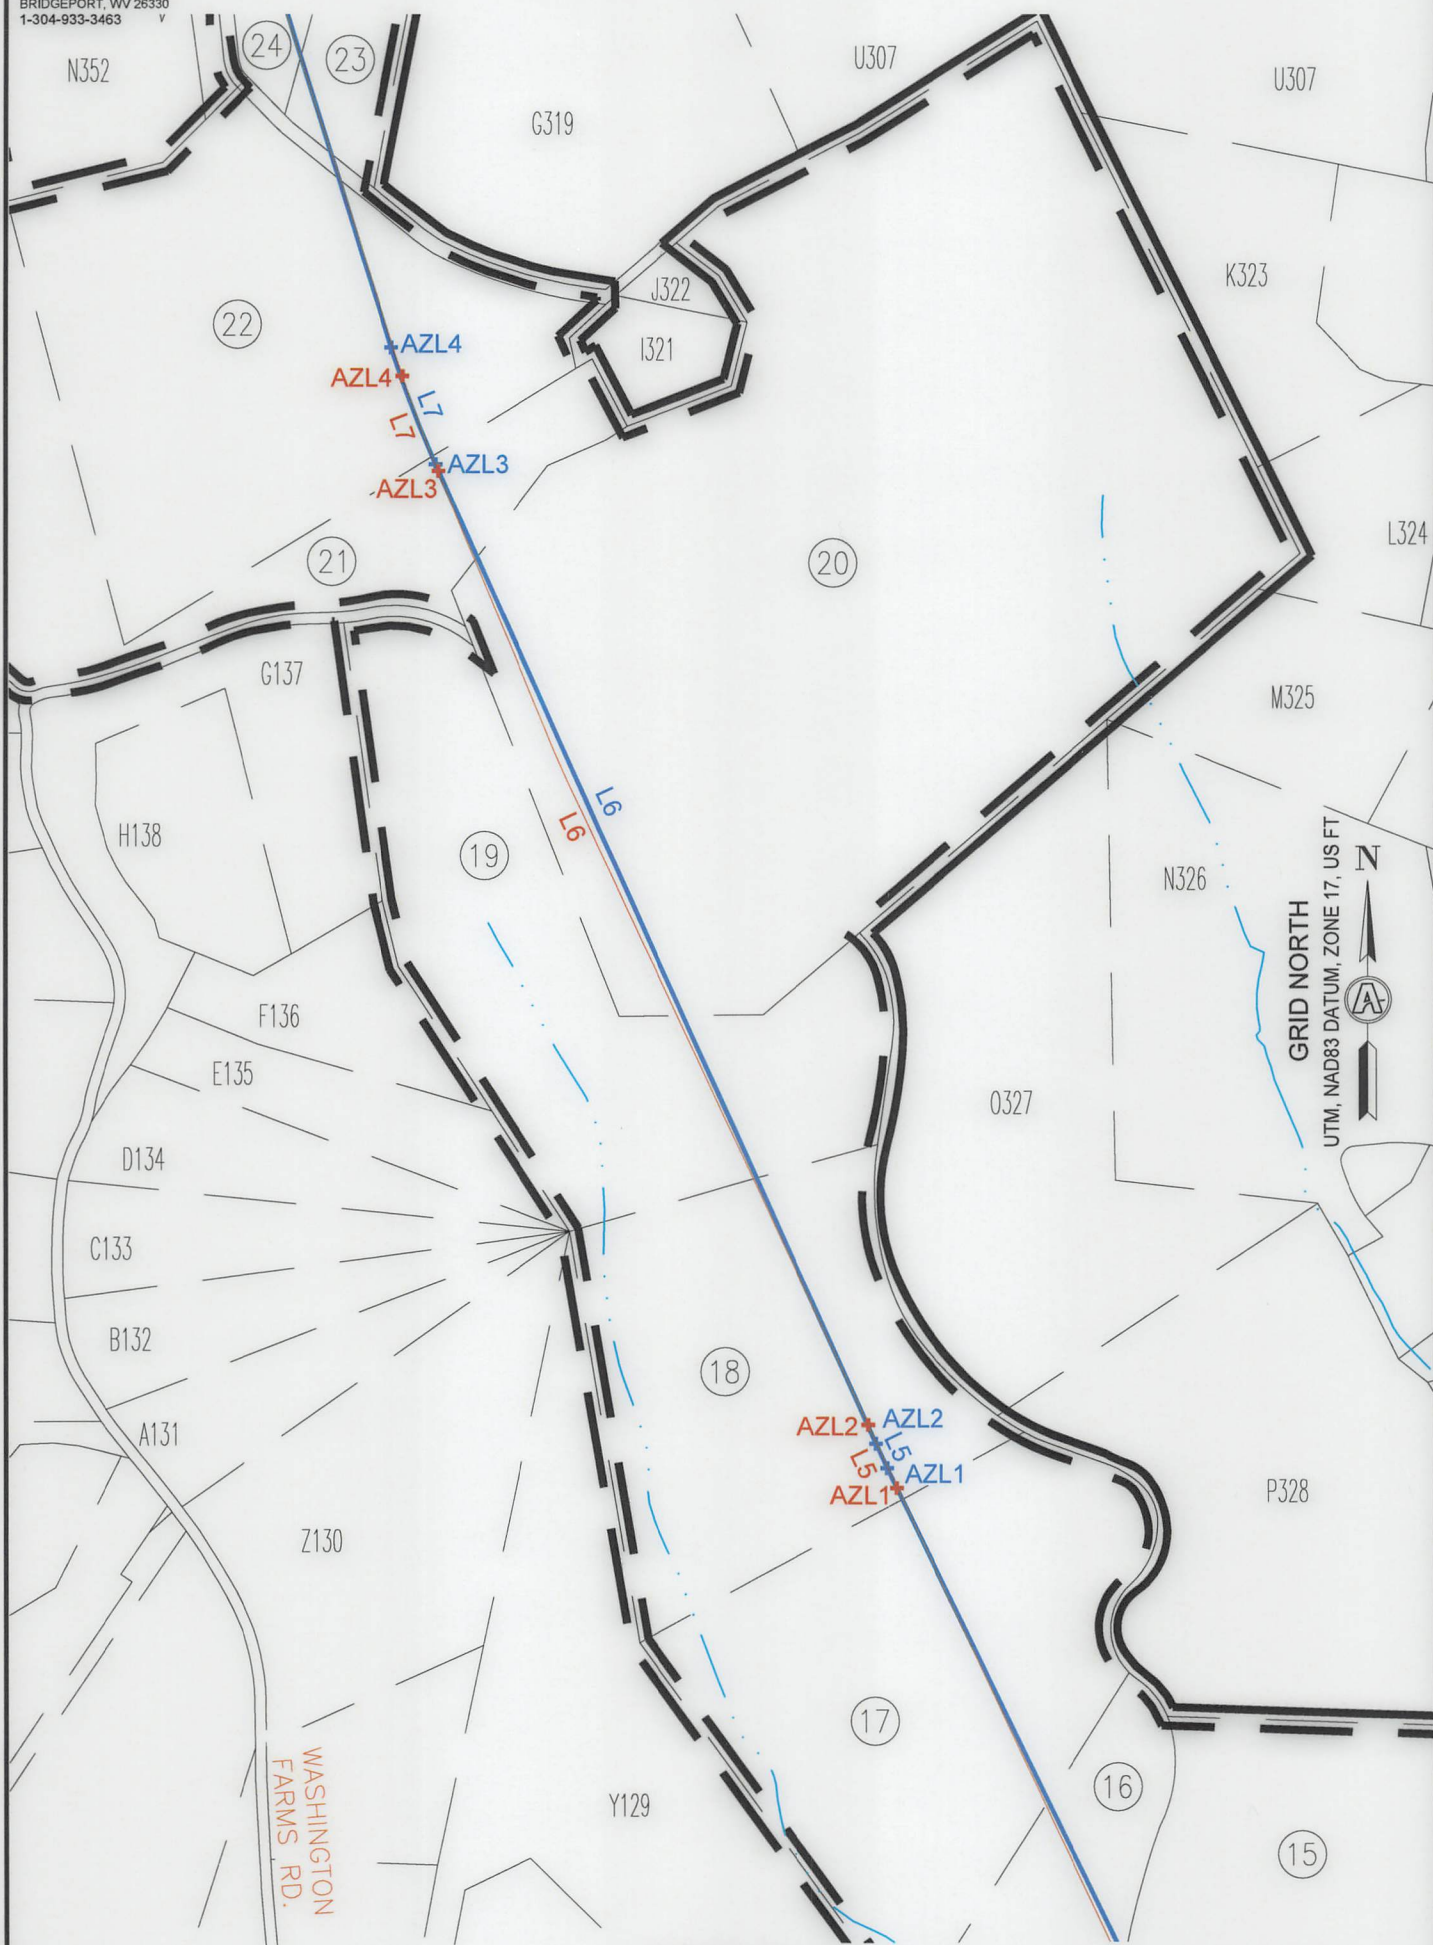



SURVEYOR/ENGINEER:
1700 ANMOORE ROAD
BRIDGEPORT, WV 26330
1-304-933-3463

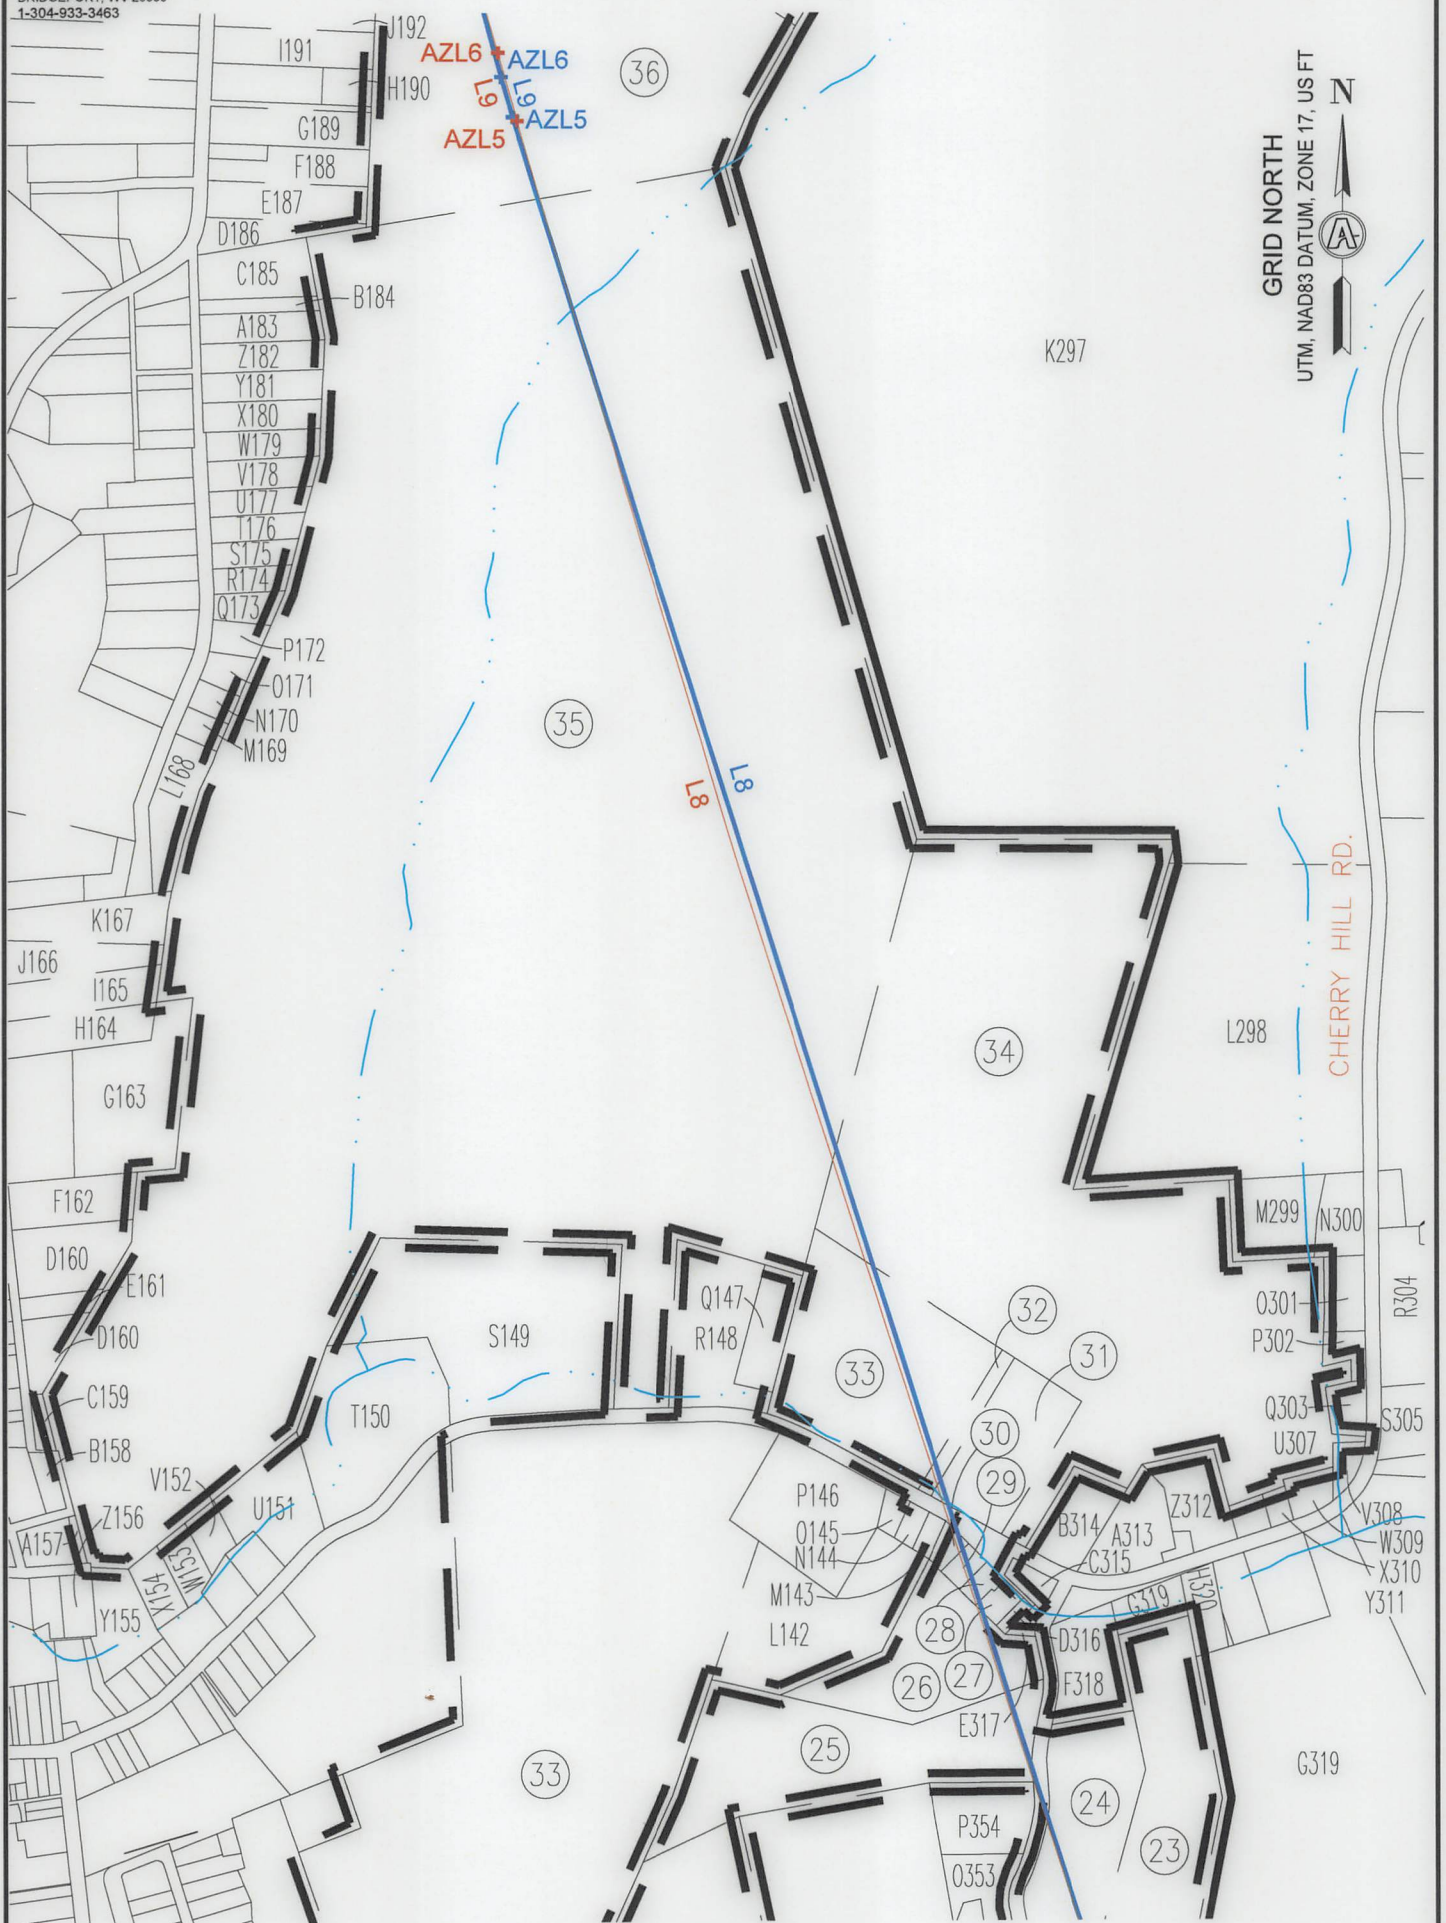

INSET "E"
SCALE: 1"=500'

09/26/2025

REVISIONS:		COMPANY:		expand	
		OPERATOR'S		SHANNON FIELDS OHI	
		WELL #:		3H	
		DISTRICT:		COUNTY:	STATE:
		RICHLAND		OHIO	WV
				DATE: 03-31-2025	
				DRAWN BY: TMF	
				SCALE: N/A	
				DRAWING NO: ACE-2326	
				WELL LOCATION PLAT	



SURVEYOR/ENGINEER:
1700 ANMOORE ROAD
BRIDGEPORT, WV 26330
1-304-933-3463

GRID NORTH
UTM, NAD83 DATUM, ZONE 17, US FT



INSET "F"
SCALE: 1"=500'

09/26/2025

REVISIONS:			COMPANY:			
			OPERATOR'S		SHANNON FIELDS OHI	
			WELL #:		3H	
			DISTRICT:		COUNTY:	STATE:
			RICHLAND		OHIO	WV
					DATE: 03-31-2025	
					DRAWN BY: TMF	
					SCALE: N/A	
					DRAWING NO: ACE-2326	
					WELL LOCATION PLAT	



SURVEYOR/ENGINEER:
1700 ANMOORE ROAD
BRIDGEPORT, WV 26330
1-304-933-3463

	WELL BORE TRACTS	
TRACT	SURFACE OWNER (S) / ROYALTY OWNER (R)	TAX PARCEL
1	SWN PRODUCTION COMPANY LLC	4-R17-23.2
TRACT	SURFACE OWNER (S)	TAX PARCEL
2	BENEKE NADA E ET AL	4-R17-19
3	OLEARY CRAIG V & EMMA L	4-R17-17
4	WHEELING PARK COMMISSION	4-R17-6.1
5	WHEELING PARK COMMISSION	6-T1-2
6	CHERRY BROOK CONDOS	10-W27-6
7	GACS LP	10-W27A-1
8	KELLY KATHRYN D	10-W27-6.C008
9	FIGARETTI C; NICODEMUS R; & KENNEN R; TRUSTEES	10-W27-5
10	KEY ANIMAL HOSPITAL INC	10-W27-2
11	ELM HILL HOLDINGS LLC	4-R14-14
12	SCHULTZ JEFFREY S	4-R14-13
13	WHEELING PARK COMMISSION	10-W17A-1
14	SYRYLO RONALD & M	4-R14J-10
15	POLACK EDWARD P	4-R14-95
16	POLACK E PHILLIPS M D	4-R13-15
17	HUPP MOLLY H 1/2 INT & SCHEINHOLTZ DAVID J 1/2 INT	4-R13-1.13
18	HUPP SARA STEPHENS	4-R13-1.17
19	PRATHER JOHN R	4-R13-1.11
20	MULL ELLEN CLARICE ET AL	4-R10-44.1
21	PRATHER JOHN R	4-R10-47
22	MYERS WILBERT E III	4-R10-2
23	ASSARO ANTHONY L & S L	4-R10-43.3
24	ASSARO ANTHONY L & S L	4-R10-43.4
25	HEBERLIG RICHARD EDWARD JR	4-R10-6.1
26	COFFMAN MARGARET AND COFFMAN JR KENNETH	4-R10-6
27	COFFMAN LEONARD & MARY	4-R10M-10
28	COFFMAN MARY K	4-R10M-3.2
29	COFFMAN MARY K	4-R10M-3.1
30	PANEPINTO MARK D	4-R10M-3
31	H3 LLC	4-R10-13
32	NORTH FORK LANDFILL INC	4-R10-14
33	PERSINGER PAMELA M	4-R10-15
34	SARKIS SJ; ROHRIG RF; ROHRIG JR; ROHRIG RF TTEE	4-R10-19
35	NORTH FORK LANDFILL INC	4-R10-43
36	MCGLAUGHLIN DENNIS & S	4-R7-30
37	CLEARVIEW VOL FIRE DEPT INC	2-CV6-34.1
38	WICKHAM THOMAS OR LINDA	2-CV5-31
39	VILLAGE OF CLEARVIEW	2-CV5-30.1
40	JARRETT MARK G & L K	2-CV5-26
41	PENNYBACKER SHAWN R	2-CV5-27
42	MAYNARD JACK E & CYNTHIA L	2-CV5-25
43	STANLEY SHERRY L & R JR	2-CV5-24
44	CRABTREE WM GREGORY & MARLA L	2-CV5-23
45	THOMAS AUSTIN D	2-CV5-22.1
46	GOUDY THOMAS A & S K	2-CV5-20
47	ROBINSON RICHARD J	4-R7L-114
48	CUPP JOSEPH T AND AMY JO	10-W1A-107
49	LENNOX ROBERT D & DEBORAH A	4-R7L-98.2
50	CARROLL JAMES C & ROSE MARIE A	4-R7L-120
51	HOLDERMAN ALBERT JOHN IV & JANA	4-R7L-86.3
52	CITY OF WHEELING	4-R7L-105
53	CITY OF WHEELING	4-R7L-100
54	CITY OF WHEELING	4-R7L-99
55	CITY OF WHEELING	4-R7G-25
56	CITY OF WHEELING	4-R7-18
57	FLUHARTY MICHAEL L	4-R7-6
58	FAZZOLARI FRANK SAMUEL ESTATE	4-R7L-56.5
59	WEST VIRGINIA STATE ROAD COMM	4-R7L-56.4
60	FLUHARTY MICHAEL L & BRENDA K	4-R7L-56
61	WEST VIRGINIA STATE ROAD COMM	4-R7L-56.3

REVISIONS:

COMPANY:

expand

OPERATOR'S

WELL #:

DISTRICT:

COUNTY:

STATE:

SHANNON FIELDS OHI

3H

RICHLAND

OHIO

WV

DATE:

DRAWN BY:

SCALE:

DRAWING NO:

WELL LOCATION

03-31-2025

TMF

N/A

ACE-2326

PLAT



SURVEYOR/ENGINEER:
1700 ANMOORE ROAD
BRIDGEPORT, WV 26330
1-304-933-3463

ADJOINING OWNERS TABLE		
TRACT	SURFACE OWNER	TAX PARCEL
A	HUFFNER EARL P	4-R17-24.1
B	MULL JAMES R	4-R17-24
C	MINCH HERBERT PAUL (1/2 INT) & MINCH BRENDA SUE (1/2 INT)	4-R17-57
D	APPALACHIA MIDSTREAM SERVICES LLC & CYNTHIA SMITH	4-R17-23
E	BENEKE NADA E	4-R17-22
F	JOHN THOMAS & MICHELLE	4-R17-20
G	CARTER RICHARD P	4-R17-23.3
H	UNITED STATES OF AMERICA ARMY CORP OF ENG - PITTS DIV	4-R7-38
I	SCHREIBER JEREMY A & PHILBRICK ELIZABETH	4-R17-16
J	HEMPELMAN MARGARET E ESTATE	4-R17-14
K	COLUMBIA GAS TRANSMISSION CORP	4-R17-15
L	HEMPELMANN GUNTHER F JR	4-R17-13
M	BURKLAND CARL D III & JOLIN H	4-R17-13.1
N	BURKLAND CARL D III & JOLIN H	4-R17-12
O	FISHER HARRY S & BARBARA J	4-R17-11
P	FISHER HARRY S & BARBARA J	4-R17-11.1
Q	LENKEY ATTILA A	4-R17-10.1
R	KIRBY LAUREN MARIE & ANDAM DANIEL KIRBY	6-T2J-11
S	WONDERLY CHERYL LYNN	6-T2J-13
T	APEL RAYMOND	6-T2J-20.6
U	PACHUTA KAREN A & VARONE K J	6-T2-3
V	BLATT TRISTEN M	6-T2-4
W	WALTER MATTHEW C	6-T1-3
X	RCK 2 GROUP LLC 1/2 VOGRIN MICHELLE L 1/2	10-W41-74
Y	DOBBS DANIEL L & JULIE A	6-T1-13
Z	CARROLL DONALD L & CARROLL D ANN M	10-W41-57
A1	VOGRIN STEPHEN T	10-W41-38
B2	TEMPLIN GENEVA E	10-W41-56
C3	STORCH PETER G & LAURIE L	10-W41-46
D4	KOVALICK ROBERT J JR	10-W41-45
E5	MCGINLEY JOSEPH R & KELLY K	10-W41-44.2
F6	MCGINLEY JOSEPH R & KELLY K	10-W41-44.1
G7	MCGINLEY JOSEPH R & KELLY K	10-W41-44
H8	MCGINLEY JOSEPH R & KELLY K	10-W41-43
I9	STORCH PETER G & LAURIE	10-W41-42
J10	HINEGARDNER JAMES L & B S	10-W41-41
K11	HINEGARDNER JAMES L JR & BRENDA S	10-W41-40
L12	STEADMAN STELLA M - TOD	10-W41-39
M13	INGRAM ROBERT H & MARLENE L	10-W41-35.2
N144	BARANOWSKI CRYSTAL L	10-W41-24.2
O15	MCKEETS JEANNE M - TOD	10-W41-24.1
P16	HAMM WILLIAM A	10-W41-24
Q17	RUSSELL NESBITT SERVICES INC	10-W34-16
R18	HOLT SHERYL L	10-W34-17.1
S19	HOLT SHERYL L	10-W34-17
T20	HOLT SHERYL L	10-W34-17.2
U21	NALLY SUSAN B	10-W34-18
V22	SNIDER JAMES & CINDY	10-W34-18.3
W23	SNIDER JAMES & CINDY	10-W34-18.1
X24	SNIDER JAMES & CINDY	10-W34-19
Y25	SNIDER JAMES & CINDY	10-W34-29.1
Z26	WHEELING PARK COMMISSION	10-W34-29
A27	WHEELING PARK COMMISSION	10-W34-28
B28	SNIDER JAMES R	10-W34-27
C29	YOUNG DANIEL & CHELSEA	10-W34-26
D30	YOUNG DANIEL & CHELSEA	10-W34-25
E31	YOUNG DANIEL R & CHELSEA R	10-W34-25.1
F32	YOUNG DANIEL R & CHELSEA R	10-W33-331.9
*HIGHLIGHTED PARCELS MAY BE IMPACTED DURING DRILLING.		

REVISIONS:

COMPANY:



09/26/2025

OPERATOR'S SHANNON FIELDS OHI

DATE: 03-31-2025

WELL #: 3H

DRAWN BY: TMF

DISTRICT: RICHLAND

COUNTY: OHIO

STATE: WV

SCALE: N/A

DRAWING NO: ACE-2326

WELL LOCATION PLAT



SURVEYOR/ENGINEER:
1700 ANMOORE ROAD
BRIDGEPORT, WV 26330
1-304-933-3463

ADJOINING OWNERS TABLE		
TRACT	SURFACE OWNER	TAX PARCEL
G33		35-NO-01DO-01D-
H34	PHILLIPSON SANDIN E	6-T1-1
I35	GC&P DEVELOPMENT LLC	10-W26-90
J36	LOHR LINDA J	10-W26-89
K37	GACS L P	10-W26-90.1
L38	LLL LLC	4-R17-6
M39	SEABRIGHT JACK & DANIELLE	4-R17-6.4
N40	SEABRIGHT JACK & DANIELLE	4-R17-6.2
O41	SEABRIGHT JACK A & DANIELLE L	4-R17-6.3
P42	VINEYARD CHRISTIAN FELLOWSHIP & WHEELING TRUSTEES	10-W27-1
Q43	FIRST CLASS REALTY LLC	10-W27-1.1
R44	FIRST CLASS REALTY LLC	10-W27-2.1
S45	FIRST CLASS REALTY LLC	10-W27-2.2
T46	JOCHUM BARBARA ANN	10-W27-3.C001
U47	FOREST BROOK CONDOS	10-W27-3
V48	ARRITT JOSHUA C	10-W27-4
W49	GILSON THOMAS A & STEPHANIE S	10-W26-50
X50	MCCARTHY T CARROLL JR	4-R16-1.5
Y51	HEISELE BARBARA ELLEN	4-R16-1.4
Z52	WEST RENTALS INC	4-R16-1
A53	RAW HOLDINGS LLC	4-R16-1.24
B54	LINDSAY MARK E & JULIE K	4-R16-1.26
C55	ELM HILL HOLDINGS LLC	4-R14-14
D56	ELM HILL LLC	4-R14-7
E57	ELM HILL LLC	4-R14-14.2
F58	WRIGHT DEBORAH D & JOHN E IV	4-R14-8
G59	TOWNSEND TAMMY J	4-R14-9.3
H60	MOREHOUSE SHAWN R	4-R14-9.2
I61	WEST RENTALS INC	4-R14-9
J62	ATKINSON RYAN J & ANN SHANLEY ATKINSON	4-R14-9.1
K63	CHURILLA PAULINE	4-R14-10
L64	WALTER DEBORAH & GERALD	4-R14-11
M65	GREER PETER S	4-R14-12
N66	GREER PETER S	4-R14-11.2
O67	WALTER DEBORAH & GERALD	4-R14-11.1
P68	WRIGHT DEBORAH D & JOHN E IV	4-R14-8
Q69	MICHALSKI JOHN & SUSAN	4-R16-1.23
R70	ROBERTS MARY L - TOD	4-R16-1.1
S71	JOHN M STASKY TRUST UNDER AGREEMENT	4-R16-1.28
T72	MURPHY ROBERT L & LINDA D	4-R16-1.13
U73	DEEM STEVEN C & NORMA J	4-R16-1.22
V74	KALISZ WILLIAM & CATHERINE A	4-R16-1.21
W75	MENDEL MARTHA J	4-R16-1.19
X76	SPERLAZZA RYAN J & ASHLEY M	4-R16-1.18
Y77	BAUER ROBB V AND KATHY	10-W21-43
Z78	BURGER KAREN E & STEVEN T BURGER	4-R13R-25
A79	BECK ISABELLE M	4-R13R-24
B80	WORKMAN KAITLYN MARIE & JACK ARMSTRONG FITCH	4-R13R-22
C81	FINSLEY HENRY M	4-R13R-21
D82	KETTLER JARED E	4-R13R-20
E83	WEISENBORN STEPHANIE L	4-R13R-19
F84	ALTMAN SHARON LOUISE C/O WESBANCO TRUST DEPT	4-R13R-18
G85	DUPLAGA MICHAEL F III	4-R13R-17
H86	GROUX FRED E JR	4-R13R-16
I87	ETHEL ROSE SMITH - TOD	4-R13R-15
J88	HUGHES JOSHUA KELLER	4-R13R-14
K89	MANNING JAMES C	4-R13R-13
L90	MANNING JAMES C	4-R13R-12
M91	WEISENBORN DALE A & S L	4-R13R-11
N92	BEARY HILARY H	4-R13R-10
O93	BOWMAN ROBERT E & BARBARA A	4-R13R-9
*HIGHLIGHTED PARCELS MAY BE IMPACTED DURING DRILLING.		

REVISIONS:		COMPANY:		09/26/2025	
		OPERATOR'S		DATE: 03-31-2025	
		WELL #:		DRAWN BY: TMF	
		DISTRICT:		SCALE: N/A	
		COUNTY:		DRAWING NO: ACE-2326	
		STATE:		WELL LOCATION PLAT	
		RICHLAND		WV	
		OHIO			



SURVEYOR/ENGINEER:
1700 ANMOORE ROAD
BRIDGEPORT, WV 26330
1-304-933-3463

ADJOINING OWNERS TABLE		
TRACT	SURFACE OWNER	TAX PARCEL
Q95	PAREE ANGELO JR & KELLY J	4-R13R-7
R96	MOSCA TRUST; LOUISE E MOSCA TRUSTEE	4-R13R-6
S97	MOSCA TRUST; ROBERT J OR LOUISE E MOSCA TRUSTEES	4-R13R-5
T98	TRABERT TERRI L ET AL	4-R13R-4
U99	BACHMANN PETER	4-R13R-3
V100	SCHUNK CHRISTOPHER & JESSICA	4-R13R-1
W101	JARVIS DOWNING & EMCH INC	4-R13R-27
X102	BICKERSTAFF ROBERT DALE JR	4-R13M-14
Y103	HOLT NED S & CHRISTINE L	4-R13M-13
Z104	HARTMANN SHARON J	4-R13M-12
A105	HARTMANN SHARON J	4-R13M-12.1
B106	COLUMBIA GAS TRANSMISSION CORP	4-R13M-11
C107	RITNER ROBERT L & TRACI L	4-R13M-10
D108	MULL JUSTIN & TAMMEY (LC-BYRS) OLEKSIK CASSIE & D J(LC-SLRS)	4-R13M-8.1
E109	MULL JUSTIN & TAMMEY (LC-BYRS) OLEKSIK CASSIE & D J(LC-SLRS)	4-R13M-8
F110	MULL JUSTIN & TAMMEY (LC-BYRS) OLEKSIK CASSIE & D J(LC-SLRS)	4-R13M-7
G111	FLICK-MOOSS SUZANNE M & MOOSS CHRISTOPHER J	4-R13M-7.1
H112	FLICK-MOOSS SUZANNE M & MOOSS CHRISTOPHER J	4-R13M-6
I113	VOLUSIA VENTURES	4-R13M-4
J114	ARCHER BYRON F JR & M L	4-R13M-3
K115	MICKER DEBORAH A	4-R13M-2
L116	WEST RENTALS INC	4-R13M-1
M117	WEST RENTALS INC	4-R13M-1.1
N118	WEST RENTALS INC	4-R13M-1.2
O119	THURSTON BONNIE BOWMAN	4-R13M-1.3
P120	THURSTON BONNIE L	4-R14J-16
Q121	CLARK MARY LADONNA	4-R14J-14
R122	CLARK MARY LADONNA	4-R14J-13
S123	TODD HOWARD R JR	4-R14J-12
T124	CHIAZZA PETER P & AUDREY D	4-R14J-11
U125	POLACK WENDY B	4-R13-15.1
V126	LAURENCE WASH FARMS IMPROVEMENT ASSN	4-R13-1
W127	CARR NANCY P & ROBERT E JR-TOD	4-R13-17
X128	HOOFF ROBERT H - TOD	4-R13-17.1
Y129	PEACE ANTHONY & TRACEY PEACE-GANTZER	4-R13-25
Z130	POLACK EDWARD P	4-R13-1.18
A131	FERNS MICHAEL D SR & LINDA K	4-R13-16.4
B132	JUNE PAMELA B & WHITLINGER STEVEN W	4-R13-16.5
C133	COLEMAN JOSEPH P & M A	4-R13-16.2
D134	BATES NANCY A & MARCONI LORNA	4-R13-16.1
E135	GRUBLER J & BODNAR K	4-R13-16.3
F136	MYERS MICHAEL & STEPHANIE	4-R13-16.6
G137	MYERS MICHAEL & STEPHANIE	4-R13-16.7
H138	FLETCHER SCOTT A & FLETCHER MELISSA D	4-R13-16
I139	DEVINE DANIEL FRANCIS AND RENSHAW JEAN ANNE	4-R10-48
J140	PRATHER TYLER D	10-W10-171
K141	CITY OF WHEELING	10-W8-348
L142	VAN SICKLE JUDITH ANN	4-R10-6.3
M143	GREEN RANDY L	4-R10M-3.4
N144	GREEN RANDY L	4-R10M-2
O145	ROSS DONNA M	4-R10M-1
P146	NORTH FORK LANDFILL INC C/O SARKIS SUSAN	4-R10-7
Q147	NORTH FORK LANDFILL INC	4-R10-16
R148	NORTH FORK LANDFILL INC	4-R10-17
S149	ROHRIG CATHERINE A	4-R10-43.8
T150	KLEEH JAMES L & M L	4-R10G-16
U151	KLEEH JAMES L & MARILYN	4-R10L-34
*HIGHLIGHTED PARCELS MAY BE IMPACTED DURING DRILLING.		

09/26/2025

REVISIONS:

COMPANY:

expand

OPERATOR'S
WELL #:
DISTRICT:
RICHLAND

SHANNON FIELDS OHI
3H
COUNTY:
OHIO

STATE:
WV

DATE: 03-31-2025
DRAWN BY: TMF
SCALE: N/A
DRAWING NO: ACE-2326
WELL LOCATION PLAT



SURVEYOR/ENGINEER:
1700 ANMOORE ROAD
BRIDGEPORT, WV 26330
1-304-933-3463

ADJOINING OWNERS TABLE		
TRACT	SURFACE OWNER	TAX PARCEL
V152	MONTELEONE DAVID P	4-R10G-16.5
W153	DODD CHAS WILSON & RUTH A	4-R10G-16.4
X154	WELSHHANS DIANA MAE	4-R10L-36
Y155	WELSHHANS DIANA MAE	4-R10L-35
Z156	NASH GARY A & KAREN L	4-R10L-2
A157	WELSHHANS DIANA MAE	4-R10L-3
B158	H3 LLC	4-R10G-15.1
C159	MIKLAVIC THOMAS J	4-R10G-14.2
D160	ROHRIG ROBERT F & KATHLEEN S	4-R10G-14
E161	THOMPSON MARY JEAN	4-R10G-14.1
F162	ROHRIG ROBERT F & KATHLEEN S	4-R10G-12
G163	ROHRIG ROBERT F & K S	4-R10G-17
H164	ROHRIG ROBERT F & KATHLEEN S	4-R10G-8
I165	SARKIS SJ; ROHRIG RF; ROHRIG JR; ROHRIG RF TTEE	4-R10G-7
J166	SARKIS SJ; ROHRIG RF; ROHRIG JR; ROHRIG RF TTEE	4-R10G-6
K167	SARKIS SJ; ROHRIG RF; ROHRIG JR; ROHRIG RF TTEE	4-R10G-4
L168	ROHRIG SHELLEY J	10-W4-118
M169	ALIG JOSEPH E	10-W4-118.5
N170	JOHNSON BARON M JR & C J	10-W4-118.3
O171	OKEY SHAUN D & ALIYA Z	10-W4-118.6
P172	BALDAUF LEIGH ANN C/O GOSSETT LEIGH ANN	10-W4-128
Q173	GWENNAP ROBERT K & ROBIN L PERRY	10-W4-129
R174	GROB PHYLLIS TRUST; GROB PHYLLIS L & R E GROB TEES	10-W4-130
S175	BARTELS MICHAEL STANLEY & JANET KENNEDY BARTELS	10-W4-131
T176	MARTIN JOHN P & AMY L	10-W4-132
U177	ANDERSON CARLAS E JR & ANDERSON RICHELE R	10-W4-133
V178	GREINER MARTHA J TR; GREINER MARTHA J IRREV TRUST	10-W4-134
W179	MILLER ROBERT D - RTO; ROBERT R MILLER	2-CV7-42.1
X180	PEKLINSKY JENNIFER S & ANDREW	2-CV7-41
Y181	TYSON DAVID DUANE & LINDA	2-CV7-39
Z182	KREITZER RAYMOND F & A B	2-CV7-38
A183	KLOSS HELEN LUCY ESTATE	2-CV7-37
B184	CONNIFF ROBERT B & JONI L; MILLER BECCA R & ANDREW K	2-CV7-36
C185	FOX SUSAN C	2-CV7-34
D186	HANEY WILLIAM D & DARLENE	2-CV7-32
E187	OTT THOMAS A & DEBRA A	2-CV7-31
F188	OTT THOMAS ANDREW & DEBRA A	2-CV7-30
G189	HARRISON LISA MAUREEN	2-CV7-28
H190	MCGLAUGHLIN DENNIS J	2-CV7-27
I191	TRABERT DORIS H	2-CV7-26
J192	TRABERT GERALD L & D H	2-CV7-25
K193	SCHMITT CAMERON & JONES PATRICK J JR	2-CV7-22
L194	SCHMITT CAMERON & JONES PATRICK J JR	2-CV7-22.1
M195	MACRI LOGAN B	2-CV5-39
N196	DELBRUGGE MARK A & PATRICIA DELBRUGGE - TOD	2-CV5-38
O197	MAHLKE CATHERINE BROWN	2-CV5-37
P198	BLANKENSHIP LYNNE K	2-CV5-34
Q199	WRIGHT DANIEL L & MARIANNA L	2-CV5-8
R200	COOLEY RODNEY	2-CV5-10
S201	DRAGONETTI EDA L	2-CV5-11
T202	DRAGONETTI EDA L	2-CV5-11.1
U203	WICKHAM THOMAS OR LINDA	2-CV5-31
V204	KOSEM GERALD L	2-CV5-12
W205	CUPP MICHAEL L & R I	2-CV5-13.1
X206	CUPP MICHAEL L & RUBY I	2-CV5-13
Y207	PENNYBACKER SHAWN R & PENNYBACKER VICKI I	2-CV5-15
Z208	PENNYBACKER SHAWN R & VICKI I	2-CV5-15.1
A209	ALLEN AARON & DARLENE - TOD	2-CV5-16
*HIGHLIGHTED PARCELS MAY BE IMPACTED DURING DRILLING.		

09/26/2025

REVISIONS:	COMPANY:		
	OPERATOR'S	SHANNON FIELDS OHI	
	WELL #:	3H	
	DISTRICT:	COUNTY:	STATE:
	RICHLAND	OHIO	WV
			DATE: 03-31-2025
			DRAWN BY: TMF
			SCALE: N/A
			DRAWING NO: ACE-2326
			WELL LOCATION PLAT



SURVEYOR/ENGINEER:
1700 ANMOORE ROAD
BRIDGEPORT, WV 26330
1-304-933-3463

ADJOINING OWNERS TABLE		
TRACT	SURFACE OWNER	TAX PARCEL
B210	BARRY WILLIAM D & CHIAZZA MARY L	2-CV5-17.1
C211	CRABTREE WILLIAM G & M L	2-CV5-17
D212	WILLIAMS RAY A	2-CV5-18.1
E213	THOMAS AUSTIN D	2-CV5-23.1
F214	THOMAS AUSTIN D	2-CV5-22
G215	CAMPBELL MARK A & C L	2-CV5-18
H216	VAN LANEN SAMANTHA R & FOLMAR REESE A	2-CV5-40
I217	COTTRELL ROGER KEITH JR	2-CV5-41
J218	DELANEY EXIE C & B K	2-CV5-19
K219	MAYLES HARRY J JR	2-CV2-1
L220	ANGIUS JEANIE M	2-CV2-1.2
M221	LENNOX ROBERT & DEBORAH	4-R7L-119
N222	LENNOX ROBERT D & D	4-R7L-118
O223	MITCHELL EVERETT & JESSICA R	4-R7L-85.3
P224	HOLDERMAN ALBERT JOHN IV & JANA	4-R7L-86.2
Q225	WRIGHT BILLY R II & BECKY S	4-R7L-86.1
R226	DOWLER ELIZABETH & DAVID	4-R7L-86
S227	WORLS GEORGE R JR & BETTY B; WORLS BRENT R - TOD	4-R7L-87
T228	MOORE JERRY W	4-R7L-87.1
U229	CROOK REBECCA J & MELINDA S CROOK	4-R7L-88
V230	CROOK REBECCA J & MELINDA S CROOK	4-R7L-89
W231	SHAVER NATALIE A & GARY P JR	4-R7L-43
X232	STECHLY ROBERT F & J A	4-R7L-44
Y233	STECHLY ROBERT F & J A	4-R7L-45
Z234	BRUHN DAVID ALAN	4-R7L-46
A235	COLUMBIA GAS TRANSMISSION CORP	4-R7L-47
B236	RUSNAK BRITTANY	4-R7L-74.1
C237	BEITER MATTHEW & COLLEEN	4-R7L-74
D238	BLACK BRIAN J & M G	4-R7L-73
E239	KALCUM CATHERINE G	4-R7L-72.1
F240	CUPP JOSEPH T & AMY JO	4-R7L-72
G241	GOUDY JARID	2-CV5-50
H242	GOUDY JARID	4-R7L-107.1
I243	SACCO FAMILY TRUST	4-R7L-107.2
J244	MACFARLAND KIMBERLY	4-R7L-92
K245	MACFARLAND KIMBERLY	4-R7L-91
L246	MACFARLAND KIMBERLY	4-R7L-41
M247	MACFARLAND KIMBERLY	4-R7L-39
N248	MACFARLAND KIMBERLY	4-R7G-24
O249	PAYTON SHARON S ET AL	4-R7G-23
P250	PAYTON SHARON S ET AL	4-R7G-20
Q251	ROBINSON RICHARD J	4-R7G-19
R252	VELEGOL DAVID & CAROLYN	4-R7G-18
S253	GUZZI COREY A & BRITTANY N	4-R7-11
T254	GUZZI COREY A & BRITTANY N	4-R7-10
U255	BOURNE JOHN & LETHA	4-R7L-56.8
V256	WEST VIRGINIA STATE ROAD COMM	4-R7L-56.7
W257	MORGAN WILBUR W	4-R7L-56.6
X258	WEST VIRGINIA STATE ROAD COMM	4-R7L-56.2
Y259	DOUGHERTY GEORGE H & THELMA T	4-R7L-56.1
Z260	JONES SHANNON M WILDS	4-R7-16.1
A261	DEAN LOMAN L & R Z	4-R7-21
B262	LOEW J W JR & ELSIE	4-R7-22
C263	HARTFILE GARY L - TOD	4-R7-16
D264	HARTFILE GARY L - TOD	4-R7-20
HIGHLIGHTED PARCELS MAY BE IMPACTED DURING DRILLING.		

REVISIONS:

COMPANY:

expand

OPERATOR'S

WELL #:

DISTRICT:

RICHLAND

COUNTY:

OHIO

STATE:

WV

DATE: 03-31-2025

DRAWN BY: TMF

SCALE: N/A

DRAWING NO: ACE-2326

WELL LOCATION PLAT



SURVEYOR/ENGINEER:
1700 ANMOORE ROAD
BRIDGEPORT, WV 26330
1-304-933-3463

ADJOINING OWNERS TABLE		
TRACT	SURFACE OWNER	TAX PARCEL
E265	EDGE BRUCE W	4-R7-23
F266	ROTH FARMS, LLC	4-R7-24
G267	HARTFILE GARY L -TOD	4-R7-15.1
H268	FEDORKE AARON P & TIMOTHY J	2-CV4-3
I269	FLUHARTY MICHAEL AND BRENDA K	4-R7-17
J270	STEWART MARK E; GEIGER LEEANN	4-R7-28
K271	STEWART MARK E	4-R7-15.2
L272	BIEGA FRANKIE P & C S	4-R7-15
M273	STOEHR RONALD J & MARIE G- TOD	2-CV3-4.7
N274	ROWND DENISE A & ROWND DANIEL THOMPSON III	4-R7-14.1
O275	ROWND DENISE & DANIEL T III	4-R7-14
P276	ROWND DENISE & THOMPSON DANIEL, III	4-R7-12
Q277	BIEGA CONNIE SUE & FRANK PAUL	4-R7-12.10
R278	CUPP JOSEPH T AND AMY JO	4-R7L-107
S279	CHUMNEY KEVIN K AND JANET L	4-R7Q-13
T280	VILLAGE OF CLEARVIEW	4-R7L-117
U281	REINACHER CHARLES J & CAROL S	2-CV6-4
V282	WAGNER JOHN M & JODY L	2-CV6-2.1
W283	WAGNER JOHN M & JODY L	2-CV6-2.2
X284	WAGNER JOHN M & JODY L	2-CV6-2
Y285	FRUM JAMES P & CAROL L	2-CV6-1
Z286	LEIB RAYCE P & GEORGE CARRIE A	2-CV5-29
A287	WICKHAM THOMAS OR LINJA	2-CV5-28
B288	CLATTERBUCK CHAD J	2-CV6-34
C289	STEFANOW JOHN	2-CV6-33
D290	PARKER GAGE C	2-CV6-32
E291	THOMAS AMANDA & MARK S II	2-CV6-31
F292	HAWK ANGELA S & BART N WISIALOWSKI	2-CV6-30
G293	RUSSELL J F SR & W M (L/E) KUZNICK MARGARET CAROL	2-CV6-29
H294	SPARKS FAMILY IRREVOCABLE TRST; TRACY LYNN EBERHARD TRUSTEE	2-CV6-29.1
I295	PLANET HOME LENDING LLC	2-CV6-28
J296	VILLAGE OF CLEARVIEW	2-CV6-34.2
K297	WARWOOD LAND CO LLC	4-R7-31
L298	BREIDING JOSHUA D & SARAH N	4-R10-20
M299	MCGARRY CORENA ESTATE	4-R10-33
N300	MCGARRY CORENA ESTATE	4-R10-32
O301	BREIDING JOSHUA D	4-R10-34.2
P302	NORTH FORK LANDFILL INC	4-R10-34.1
Q303	ROBINSON RICHARD J	4-R10-37
R304	MCCARDLE STANLEY M JR & M	4-R10-36
S305	IAFRATE DAVID A	4-R10-39
T306	NORTH FORK LANDFILL INC C/O SUSAN SARKIS	4-R10-41.1
U307	NORTH FORK LANDFILL INC C/O SUSAN SARKIS	4-R10-39.1
V308	NORTH FORK LANDFILL INC	4-R10-38
W309	JAQUAY TODD F	4-R10-19.1
X310	MOFFITT SYLVIA F	4-R10-10
Y311		4-R10-19.2
Z312	SARKIS SJ; ROHRIG RF; ROHRIG JR; ROHRIG RF TTEE	4-R10-10.1
A313	SARKIS SJ; ROHRIG RF; ROHRIG JR; ROHRIG RF TTEE	4-R10-11
B314	GILBERT DONALD E JR	4-R10-12
C315	RENSHAW MICHAEL F & RENSCHAW OWEN F JR	4-R10M-3.3
D316		4-R10M-11
E317	COFFMAN KENNETH JR	4-R10-6.2
F318	ASSARO ANTHONY L & S L	4-R10-43.2
G319	NORTH FORK LANDFILL INC	4-R10-43.1
H320	ASSARO ANTHONY L SR & SANDRA	4-R10-43.5
I321	PRATHER TYLER D	4-R10-44
*HIGHLIGHTED PARCELS MAY BE IMPACTED DURING DRILLING.		

REVISIONS:

COMPANY:

DATE: 03-31-2025

OPERATOR'S

SHANNON FIELDS OHI

WELL #:

3H

DISTRICT:

RICHLAND

COUNTY:

OHIO

STATE:

WV

DRAWN BY: TMF

SCALE: N/A

DRAWING NO: ACE-2326

WELL LOCATION PLAT



SURVEYOR/ENGINEER:
1700 ANMOORE ROAD
BRIDGEPORT, WV 26330
1-304-933-3463

ADJOINING OWNERS TABLE		
TRACT	SURFACE OWNER	TAX PARCEL
J322	PRATHER TYLER D	4-R10-44.2
K323	DOYLE DANIEL T & LUCINDA E	4-R11-2.12
L324	LOWE JEREMY J & AMANDA L	4-R11-2.11
M325	LOWE JEREMY J & AMANDA L	4-R11-2.6
N326	SANTORINE LORA KAY & SANTORINE ADOLPH W JR	4-R14A-24
O327	GRIMES THOMAS B TRUSTEE THE ARCHIE TODD HUPP IV	4-R13-1.15
P328	HUPP SARA	4-R13-1.14
Q329	ADAMS JAMES C & MELISSA S	4-R14E-1
R330	SUNSHINE STATE INV GROUP LLC	4-R14A-53
S331	ALLEN AMY & THOMAS E JR (BYRS) ALLEN THOMAS E (LC-SLR)	4-R14E-4
T332	CITY OF WHEELING	4-R14-15
U333	WHEELING PARK COMMISSION	4-R14-14.1
V334	H3 LLC	04-0R7L-0098.1
W335	PARK VIEW MEMORIAL GARDENS INC	4-R17-8
X336	PELUCHETTE JOHN M & C L	4-R14J-1
Y337	PANEPINTO MARK D & MINDY D	4-R14J-2
Z338	DUVAL THOMAS & ALLAMONG MARY F	4-R14J-3
A339	BOUDREAU DENISE LYNN	4-R14J-4
B340	FERRELL ELLIOT C	4-R14J-5
C341	TAYLOR JOANE L	4-R14J-8
D342	RICE STEVEN A AND JUDITH A	4-R14J-7
E343	BALTZ LEE E & J L	4-R14J-6
F344	ZAVOLTA RONALD W	4-R14J-9
G345	LIGNUM VIA LLC	10-W27-6.C001
H346	CLATTERBUCK MARIANNE	10-W27-6.C002
I347	LIGNUM VIA LLC	10-W27-6.C003
J348	LIGNUM VIA LLC	10-W27-6.C004
K349	LIGNUM VIA LLC	10-W27-6.C005
L350	NESTOR PAMELA	10-W27-6.C006
M351	LIGNUM VIA LLC	10-W27-6.C007
N352	PRATHER TYLER D	4-R10-3
O353	WADDELL DONALD L & D J	4-R10-4
P354	RENSHAW VICKI J	4-R10-5
Q355	WOLFE JAMES R ESTATE	4-R7-7
R356	FLUHARTY MICHAEL L & BRENDA K	4-R7-8
S357	FLUHARTY MICHAEL L & BRENDA K	4-R7-9.1
T358	FLUHARTY MICHAEL & BRENDA	4-R7-9
U359	FEDORKE TIMOTHY JOSEPH	4-R7-37
V360	BIEGA FRANK & CONNIE	4-R7-27.2
W361	UNITED STATES OF AMERICA ARMY CORP OF ENG - PITTS DIV	4-R4-1
X362	MONTELEONE TERESA	10-W2-1
Y363	H3 LLC	04-0R7G-29
Z364	H3 LLC	04-0R7L-116
A365		
*HIGHLIGHTED PARCELS MAY BE IMPACTED DURING DRILLING.		

REVISIONS:

COMPANY:

expand

OPERATOR'S
WELL #:
DISTRICT:
RICHLAND

SHANNON FIELDS OHI
3H
COUNTY:
OHIO

STATE:
WV

DATE: 03-31-2025

DRAWN BY: TMF


SCALE: N/A

DRAWING NO: ACE-2326


WELL LOCATION PLAT



SURVEYOR/ENGINEER:
1700 ANMOORE ROAD
BRIDGEPORT, WV 26330
1-304-933-3463

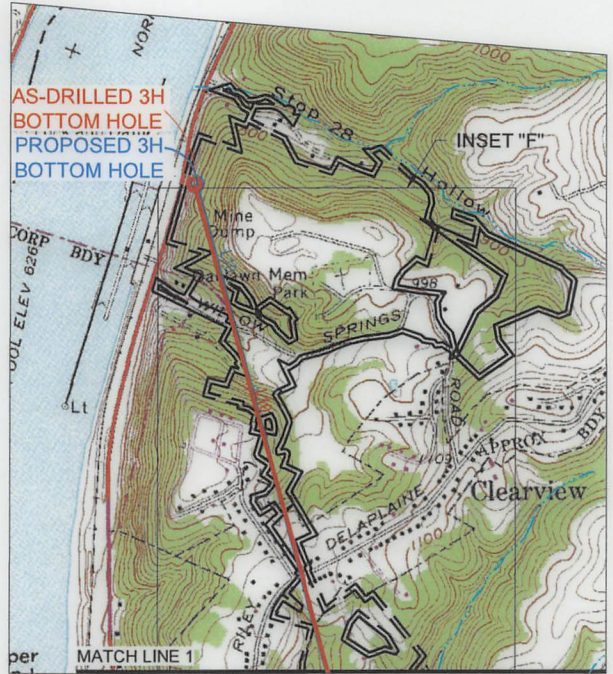

SURFACE HOLE LOCATION (SHL):
GEOGRAPHIC (NAD83):
LATITUDE: 40.088361°
LONGITUDE: -80.657858°
BOTTOM HOLE LOCATION (BHL):
GEOGRAPHIC (NAD83):
LATITUDE: 40.149637°
LONGITUDE: -80.698841°

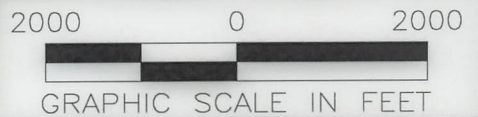


- NOTES ON SURVEY
1. SURFACE AND ROYALTY OWNER INFORMATION AND THEIR BOUNDARIES SHOWN HEREON WERE PLOTTED FROM DEEDS AND/OR TAX PARCEL MAPS PROVIDED BY CLIENT AND/OR FIELD LOCATIONS.
 2. THIS PLAT DOES NOT REPRESENT A BOUNDARY SURVEY OF THE PARCELS SHOWN HEREON.
 4. ALL INSETS ARE GRID NORTH UNLESS OTHERWISE DEPICTED.

- LEGEND:
- PROPOSED SURFACE HOLE / BOTTOM HOLE
 - EXISTING / PRODUCING WELLHEAD
 - LPL* LANDING POINT LOCATION
 - EXISTING WATER WELL
 - EXISTING SPRING
 - SURVEYED BOUNDARY
 - LEASE BOUNDARY
 - ASDRILLED PATH
 - PROPOSED PATH
 - DHP BUFFER


WELL OPERATOR: EXPAND ENERGY CORPORATION	WELL (FARM) NAME: SHANNON FIELDS OHI	WELL # 3H	SERIAL # XXXX
ADDRESS: 1300 FORT PIERPONT DRIVE, SUITE 201	COUNTY - CODE OHIO - 35	DISTRICT; RICHLAND	
SURFACE OWNER: SWN PRODUCTION COMPANY, LLC	USGS 7 1/2 QUADRANGLE MAP NAME WHEELING, WV		

GRID NORTH
UTM, NAD83 DATUM, ZONE 17, US FT

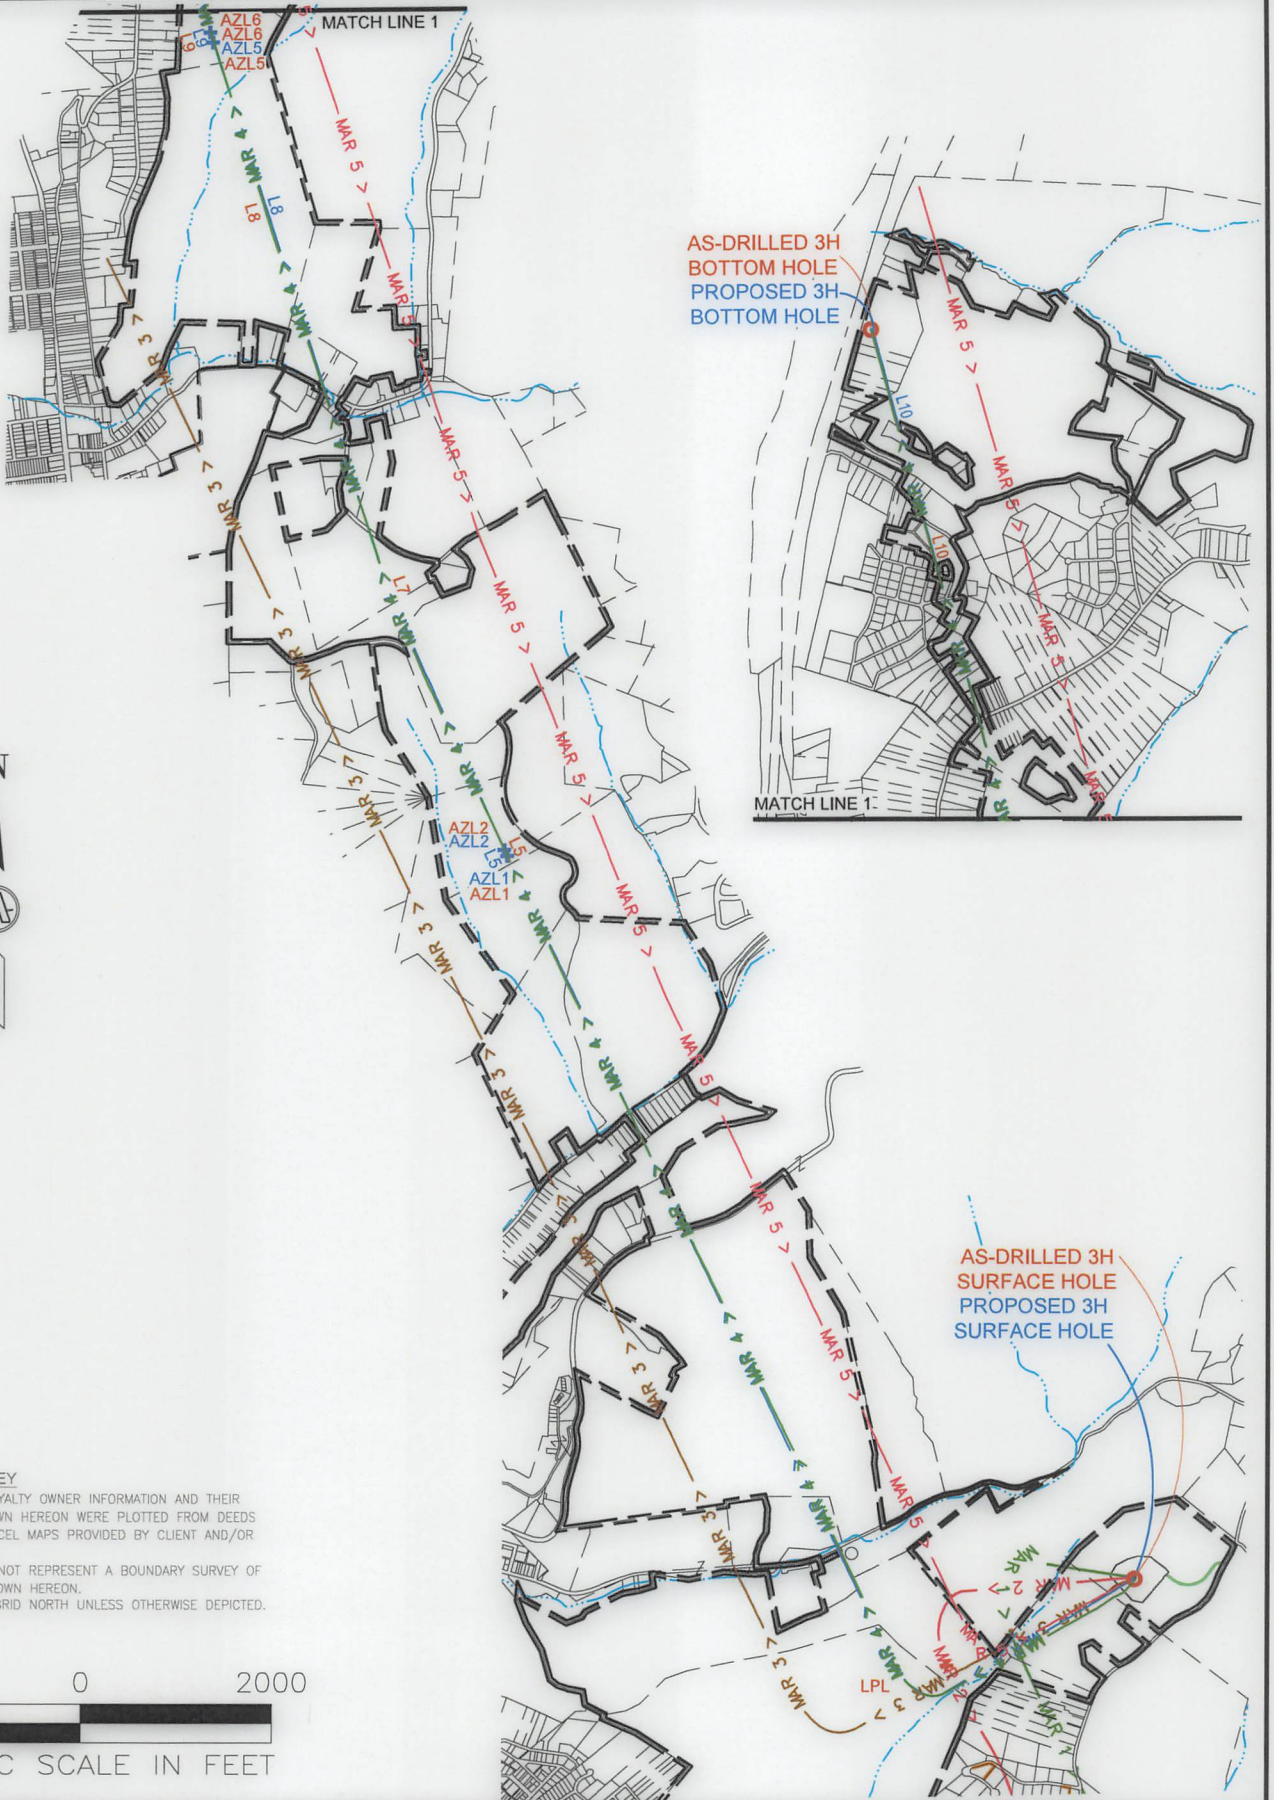

NOTES ON SURVEY

1. SURFACE AND ROYALTY OWNER INFORMATION AND THEIR BOUNDARIES SHOWN HEREON WERE PLOTTED FROM DEEDS AND/OR TAX PARCEL MAPS PROVIDED BY CLIENT AND/OR FIELD LOCATIONS.
2. THIS PLAT DOES NOT REPRESENT A BOUNDARY SURVEY OF THE PARCELS SHOWN HEREON.
4. ALL INSETS ARE GRID NORTH UNLESS OTHERWISE DEPICTED.

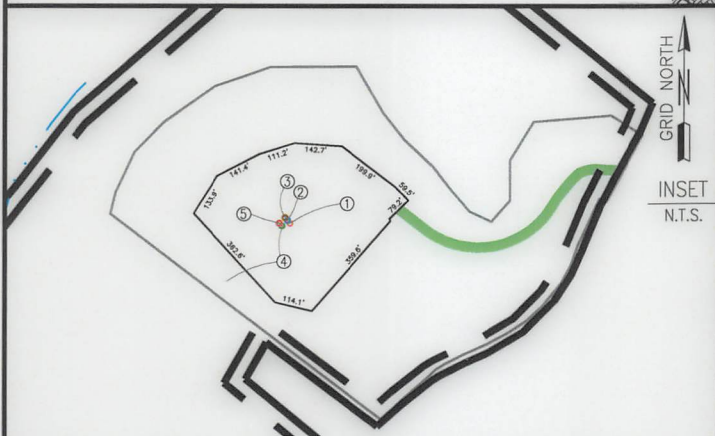

COMPANY:

expand

OPERATOR'S

SHANNON FIELDS OHI

WELL #:

3H

DISTRICT:

COUNTY:

STATE:

RICHLAND

OHIO

WEST VIRGINIA

SWN PRODUCTION COMPANY, LLC
SURFACE HOLES

1. "SHANNON FIELDS-OHI 210H"
2. "SHANNON FIELDS-OHI 10H"
3. "SHANNON FIELDS-OHI 1H"
4. "SHANNON FIELDS-OHI 3H"
5. "SHANNON FIELDS-OHI 5H"

09/26/2025

REVISIONS:

DATE: 03-31-2025


DRAWN BY: TMF
SCALE: 1" = 2500'
DRAWING NO: ACE-2326
INTERNAL WELL PLAT

S:\PROJECTS 2251-2500\PROJECT 2326 SHANNON FIELDS WELL PLAT\SURVEY\DRAWINGS\HORIZONTAL WELL PLAT\SHANNON FIELDS OHI 3H\AS-DRILLED PLAT\SHANNON FIELDS OHI 3H_ADP.DWG
MONDAY MARCH 31 2025 03:54PM

COMPLETION ID 2501189821
PAD ID 3001189761

- LEGEND:
- PROPOSED SURFACE HOLE / BOTTOM HOLE
 - EXISTING / PRODUCING WELLHEAD
 - ABANDONED WELL
 - PLUGGED & ABANDONED WELL
 - LPL LANDING POINT LOCATION
 - DRILLING UNIT
 - LEASE BOUNDARY
 - HARDLINE BOUNDARY
 - UPP 2 UPPER POINT PLEASANT PATH
 - MAR 2 MARCELLUS PATH

SURFACE HOLE LOCATION (SHL):	SURFACE HOLE LOCATION (SHL):	AZIMUTH POINT LOCATION (AZL5):	AZIMUTH POINT LOCATION (AZL5):
GEOGRAPHIC (NAD83): LATITUDE: 40.088361° LONGITUDE: -80.657858°	GEOGRAPHIC (NAD27): LATITUDE: 40.088288° LONGITUDE: -80.658058°	GEOGRAPHIC (NAD83): LATITUDE: 40.134215° LONGITUDE: -80.693380°	GEOGRAPHIC (NAD27): LATITUDE: 40.134143° LONGITUDE: -80.693579°
UTM (NAD83, ZONE 17, FEET): NORTHING: 14,559,093.470 EASTING: 1,736,110.290	UTM (NAD27, ZONE 17, FEET): NORTHING: 14,558,377.118 EASTING: 1,736,057.007	UTM (NAD83, ZONE 17, FEET): NORTHING: 14,575,754.910 EASTING: 1,726,117.480	UTM (NAD27, ZONE 17, FEET): NORTHING: 14,575,038.583 EASTING: 1,726,064.449
UTM (NAD83, ZONE 17, METERS): NORTHING: 4,437,620.565 EASTING: 529,167.475	UTM (NAD27, ZONE 17, METERS): NORTHING: 4,437,402.220 EASTING: 529,151.234	UTM (NAD83, ZONE 17, METERS): NORTHING: 4,442,698.982 EASTING: 526,121.660	UTM (NAD27, ZONE 17, METERS): NORTHING: 4,442,480.645 EASTING: 526,105.496
LANDING POINT LOCATION (LPL):	LANDING POINT LOCATION (LPL):	AZIMUTH POINT LOCATION (AZL6):	AZIMUTH POINT LOCATION (AZL6):
GEOGRAPHIC (NAD83): LATITUDE: 40.086119° LONGITUDE: -80.667416°	GEOGRAPHIC (NAD27): LATITUDE: 40.086046° LONGITUDE: -80.667616°	GEOGRAPHIC (NAD83): LATITUDE: 40.134512° LONGITUDE: -80.693492°	GEOGRAPHIC (NAD27): LATITUDE: 40.134440° LONGITUDE: -80.693690°
UTM (NAD83, ZONE 17, FEET): NORTHING: 14,558,266.880 EASTING: 1,733,440.030	UTM (NAD27, ZONE 17, FEET): NORTHING: 14,557,550.556 EASTING: 1,733,386.826	UTM (NAD83, ZONE 17, FEET): NORTHING: 14,575,862.840 EASTING: 1,726,085.920	UTM (NAD27, ZONE 17, FEET): NORTHING: 14,575,146.523 EASTING: 1,726,032.890
UTM (NAD83, ZONE 17, METERS): NORTHING: 4,437,368.620 EASTING: 528,353.578	UTM (NAD27, ZONE 17, METERS): NORTHING: 4,437,150.284 EASTING: 528,337.361	UTM (NAD83, ZONE 17, METERS): NORTHING: 4,442,731.879 EASTING: 526,112.041	UTM (NAD27, ZONE 17, METERS): NORTHING: 4,442,513.545 EASTING: 526,095.877
AZIMUTH POINT LOCATION (AZL1):	AZIMUTH POINT LOCATION (AZL1):	BOTTOM HOLE LOCATION (BHL):	BOTTOM HOLE LOCATION (BHL):
GEOGRAPHIC (NAD83): LATITUDE: 40.109921° LONGITUDE: -80.682171°	GEOGRAPHIC (NAD27): LATITUDE: 40.109849° LONGITUDE: -80.682369°	GEOGRAPHIC (NAD83): LATITUDE: 40.149658° LONGITUDE: -80.698772°	GEOGRAPHIC (NAD27): LATITUDE: 40.149587° LONGITUDE: -80.698970°
UTM (NAD83, ZONE 17, FEET): NORTHING: 14,566,919.360 EASTING: 1,729,282.260	UTM (NAD27, ZONE 17, FEET): NORTHING: 14,566,203.041 EASTING: 1,729,229.158	UTM (NAD83, ZONE 17, FEET): NORTHING: 14,581,373.451 EASTING: 1,724,591.349	UTM (NAD27, ZONE 17, FEET): NORTHING: 14,580,657.113 EASTING: 1,724,538.349
UTM (NAD83, ZONE 17, METERS): NORTHING: 4,440,005.901 EASTING: 527,086.287	UTM (NAD27, ZONE 17, METERS): NORTHING: 4,439,787.566 EASTING: 527,070.101	UTM (NAD83, ZONE 17, METERS): NORTHING: 4,444,411.517 EASTING: 525,656.495	UTM (NAD27, ZONE 17, METERS): NORTHING: 4,444,193.176 EASTING: 525,640.340
AZIMUTH POINT LOCATION (AZL2):	AZIMUTH POINT LOCATION (AZL2):		
GEOGRAPHIC (NAD83): LATITUDE: 40.110102° LONGITUDE: -80.682279°	GEOGRAPHIC (NAD27): LATITUDE: 40.110030° LONGITUDE: -80.682478°		
UTM (NAD83, ZONE 17, FEET): NORTHING: 14,566,985.260 EASTING: 1,729,251.620	UTM (NAD27, ZONE 17, FEET): NORTHING: 14,566,268.941 EASTING: 1,729,198.519		
UTM (NAD83, ZONE 17, METERS): NORTHING: 4,440,025.987 EASTING: 527,076.948	UTM (NAD27, ZONE 17, METERS): NORTHING: 4,439,807.653 EASTING: 527,060.763		
AZIMUTH POINT LOCATION (AZL3):	AZIMUTH POINT LOCATION (AZL3):		
GEOGRAPHIC (NAD83): LATITUDE: 40.117408° LONGITUDE: -80.686517°	GEOGRAPHIC (NAD27): LATITUDE: 40.117336° LONGITUDE: -80.686716°		
UTM (NAD83, ZONE 17, FEET): NORTHING: 14,569,641.360 EASTING: 1,728,057.280	UTM (NAD27, ZONE 17, FEET): NORTHING: 14,568,925.041 EASTING: 1,728,004.208		
UTM (NAD83, ZONE 17, METERS): NORTHING: 4,440,835.568 EASTING: 526,712.912	UTM (NAD27, ZONE 17, METERS): NORTHING: 4,440,617.234 EASTING: 526,696.736		
AZIMUTH POINT LOCATION (AZL4):	AZIMUTH POINT LOCATION (AZL4):		
GEOGRAPHIC (NAD83): LATITUDE: 40.118279° LONGITUDE: -80.686944°	GEOGRAPHIC (NAD27): LATITUDE: 40.118207° LONGITUDE: -80.687142°		
UTM (NAD83, ZONE 17, FEET): NORTHING: 14,569,958.210 EASTING: 1,727,936.810	UTM (NAD27, ZONE 17, FEET): NORTHING: 14,569,241.891 EASTING: 1,727,883.740		
UTM (NAD83, ZONE 17, METERS): NORTHING: 4,440,932.144 EASTING: 526,676.193	UTM (NAD27, ZONE 17, METERS): NORTHING: 4,440,713.810 EASTING: 526,660.017		

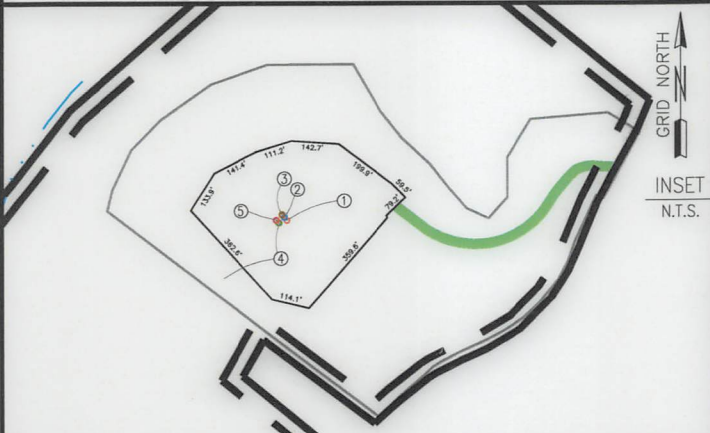

NOTE: ANY UTILITIES OR IMPROVEMENTS SHOWN ON THIS PLAT ARE FROM REASONABLE VISUAL OBSERVATIONS. NO UTILITY COMPANIES WERE CONTACTED FOR UTILITY LINE LOCATIONS.


LEGEND:	
PROPOSED SURFACE HOLE / BOTTOM HOLE	DRILLING UNIT
EXISTING / PRODUCING WELLHEAD	LEASE BOUNDARY
ABANDONED WELL	HARDLINE BOUNDARY
PLUGGED & ABANDONED WELL	UPP 2 > - UPPER POINT PLEASANT PATH
LANDING POINT LOCATION	MAR 2 > - MARCELLUS PATH

COMPANY:		
OPERATOR'S		
SHANNON FIELDS OHI		
WELL #:		
3H		
DISTRICT:	COUNTY:	STATE:
RICHLAND	OHIO	WEST VIRGINIA
SWN PRODUCTION COMPANY, LLC		
SURFACE HOLES		
1. "SHANNON FIELDS-OHI 210H"		
2. "SHANNON FIELDS-OHI 10H"		
3. "SHANNON FIELDS-OHI 1H"		
4. "SHANNON FIELDS-OHI 3H"		
5. "SHANNON FIELDS-OHI 5H"		
09/26/2025		
REVISIONS:		DATE: 03-31-2025
		DRAWN BY: TMF
		SCALE: 1" = 2500'
		DRAWING NO: ACE-2326
		INTERNAL WELL PLAT



SURVEYOR/ENGINEER:
1700 ANMOORE ROAD
BRIDGEPORT, WV 26330
1-304-933-3463

SURFACE HOLE LOCATION (SHL):	AZIMUTH POINT LOCATION (AZL3):	BOTTOM HOLE LOCATION (BHL):
GEOGRAPHIC (NAD83): LATITUDE: 40.088361° LONGITUDE: -80.657858°	GEOGRAPHIC (NAD83): LATITUDE: 40.117360° LONGITUDE: -80.686495°	GEOGRAPHIC (NAD83): LATITUDE: 40.149637° LONGITUDE: -80.698841°
UTM (NAD83, ZONE 17, FEET): NORTHING: 14,559,093.460 EASTING: 1,736,110.240	UTM (NAD83, ZONE 17, FEET): NORTHING: 14,569,624.040 EASTING: 1,728,063.640	UTM (NAD83, ZONE 17, FEET): NORTHING: 14,581,365.730 EASTING: 1,724,572.260
UTM (NAD83, ZONE 17, METERS): NORTHING: 4,437,620.562 EASTING: 529,167.459	UTM (NAD83, ZONE 17, METERS): NORTHING: 4,440,830.289 EASTING: 526,714.851	UTM (NAD83, ZONE 17, METERS): NORTHING: 4,444,409.163 EASTING: 525,650.676
SPCS, WV NORTH (NAD83): NORTHING: 580,628.737 EASTING: 1,644,547.060	SPCS, WV NORTH (NAD83): NORTHING: 591,296.385 EASTING: 1,636,674.912	SPCS, WV NORTH (NAD83): NORTHING: 603,099.235 EASTING: 1,633,379.265
GEOGRAPHIC (NAD27): LATITUDE: 40.088288° LONGITUDE: -80.658058°	GEOGRAPHIC (NAD27): LATITUDE: 40.117288° LONGITUDE: -80.686693°	GEOGRAPHIC (NAD27): LATITUDE: 40.149566° LONGITUDE: -80.699039°
SPCS, WV NORTH (NAD27): NORTHING: 580,591.982 EASTING: 1,675,982.270	SPCS, WV NORTH (NAD27): NORTHING: 591,259.660 EASTING: 1,668,110.333	SPCS, WV NORTH (NAD27): NORTHING: 603,062.491 EASTING: 1,664,814.757
LANDING POINT LOCATION (LPL):	AZIMUTH POINT LOCATION (AZL4):	
GEOGRAPHIC (NAD83): LATITUDE: 40.086179° LONGITUDE: -80.667407°	GEOGRAPHIC (NAD83): LATITUDE: 40.118068° LONGITUDE: -80.686836°	
UTM (NAD83, ZONE 17, FEET): NORTHING: 14,558,288.850 EASTING: 1,733,442.610	UTM (NAD83, ZONE 17, FEET): NORTHING: 14,569,881.450 EASTING: 1,727,967.400	
UTM (NAD83, ZONE 17, METERS): NORTHING: 4,437,375.316 EASTING: 528,354.364	UTM (NAD83, ZONE 17, METERS): NORTHING: 4,440,908.748 EASTING: 526,685.517	
SPCS, WV NORTH (NAD83): NORTHING: 579,868.600 EASTING: 1,641,865.367	SPCS, WV NORTH (NAD83): NORTHING: 591,555.465 EASTING: 1,636,582.959	
GEOGRAPHIC (NAD27): LATITUDE: 40.086106° LONGITUDE: -80.667606°	GEOGRAPHIC (NAD27): LATITUDE: 40.117996° LONGITUDE: -80.687034°	
SPCS, WV NORTH (NAD27): NORTHING: 579,831.872 EASTING: 1,673,300.657	SPCS, WV NORTH (NAD27): NORTHING: 591,518.739 EASTING: 1,668,018.381	
AZIMUTH POINT LOCATION (AZL1):	AZIMUTH POINT LOCATION (AZL5):	
GEOGRAPHIC (NAD83): LATITUDE: 40.109785° LONGITUDE: -80.682079°	GEOGRAPHIC (NAD83): LATITUDE: 40.134188° LONGITUDE: -80.693338°	
UTM (NAD83, ZONE 17, FEET): NORTHING: 14,566,870.010 EASTING: 1,729,307.940	UTM (NAD83, ZONE 17, FEET): NORTHING: 14,575,745.020 EASTING: 1,726,129.490	
UTM (NAD83, ZONE 17, METERS): NORTHING: 4,439,990.859 EASTING: 527,094.114	UTM (NAD83, ZONE 17, METERS): NORTHING: 4,442,695.967 EASTING: 526,125.321	
SPCS, WV NORTH (NAD83): NORTHING: 588,520.899 EASTING: 1,637,873.398	SPCS, WV NORTH (NAD83): NORTHING: 597,451.149 EASTING: 1,634,842.773	
GEOGRAPHIC (NAD27): LATITUDE: 40.109713° LONGITUDE: -80.682278°	GEOGRAPHIC (NAD27): LATITUDE: 40.134116° LONGITUDE: -80.693536°	
SPCS, WV NORTH (NAD27): NORTHING: 588,484.175 EASTING: 1,669,308.789	SPCS, WV NORTH (NAD27): NORTHING: 597,414.415 EASTING: 1,666,278.234	
AZIMUTH POINT LOCATION (AZL2):	AZIMUTH POINT LOCATION (AZL6):	
GEOGRAPHIC (NAD83): LATITUDE: 40.110244° LONGITUDE: -80.682354°	GEOGRAPHIC (NAD83): LATITUDE: 40.134692° LONGITUDE: -80.693523°	
UTM (NAD83, ZONE 17, FEET): NORTHING: 14,567,036.880 EASTING: 1,729,230.610	UTM (NAD83, ZONE 17, FEET): NORTHING: 14,575,928.620 EASTING: 1,726,077.170	
UTM (NAD83, ZONE 17, METERS): NORTHING: 4,440,041.721 EASTING: 527,070.544	UTM (NAD83, ZONE 17, METERS): NORTHING: 4,442,751.929 EASTING: 526,109.374	
SPCS, WV NORTH (NAD83): NORTHING: 588,689.102 EASTING: 1,637,798.844	SPCS, WV NORTH (NAD83): NORTHING: 597,635.667 EASTING: 1,634,793.514	
GEOGRAPHIC (NAD27): LATITUDE: 40.110172° LONGITUDE: -80.682553°	GEOGRAPHIC (NAD27): LATITUDE: 40.134620° LONGITUDE: -80.693721°	
SPCS, WV NORTH (NAD27): NORTHING: 588,652.377 EASTING: 1,669,234.237	SPCS, WV NORTH (NAD27): NORTHING: 597,598.933 EASTING: 1,666,228.976	

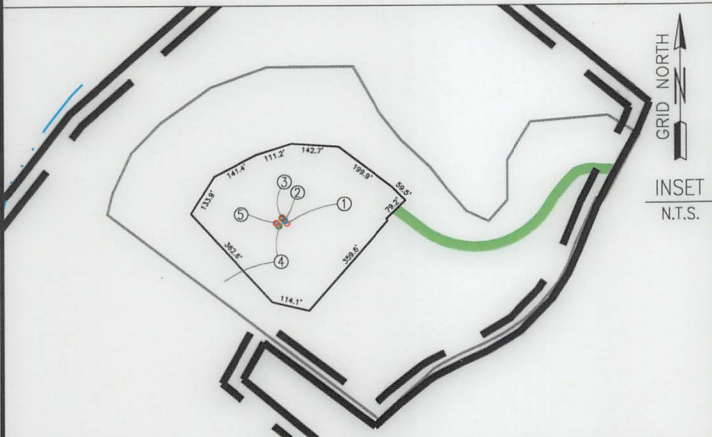

NOTE: ANY UTILITIES OR IMPROVEMENTS SHOWN ON THIS PLAT ARE FROM REASONABLE VISUAL OBSERVATIONS. NO UTILITY COMPANIES WERE CONTACTED FOR UTILITY LINE LOCATIONS.

LEGEND:	
PROPOSED SURFACE HOLE / BOTTOM HOLE	DRILLING UNIT
EXISTING / PRODUCING WELLHEAD	LEASE BOUNDARY
ABANDONED WELL	HARDLINE BOUNDARY
PLUGGED & ABANDONED WELL	UPP 2 > > UPPER POINT PLEASANT PATH
LPL* LANDING POINT LOCATION	MAR 2 > > MARCELLUS PATH

COMPANY:		
OPERATOR'S		
WELL #: SHANNON FIELDS OHI 3H		
DISTRICT:	COUNTY:	STATE:
RICHLAND	OHIO	WEST VIRGINIA
SWN PRODUCTION COMPANY, LLC SURFACE HOLES		
1. "SHANNON FIELDS-OHI 210H" 2. "SHANNON FIELDS-OHI 10H" 3. "SHANNON FIELDS-OHI 1H" 4. "SHANNON FIELDS-OHI 3H" 5. "SHANNON FIELDS-OHI 5H"		
09/26/2025		
REVISIONS:		DATE: 03-31-2025
		DRAWN BY: TMF
		SCALE: 1" = 2500'
		DRAWING NO: ACE-2326
		INTERNAL WELL PLAT