


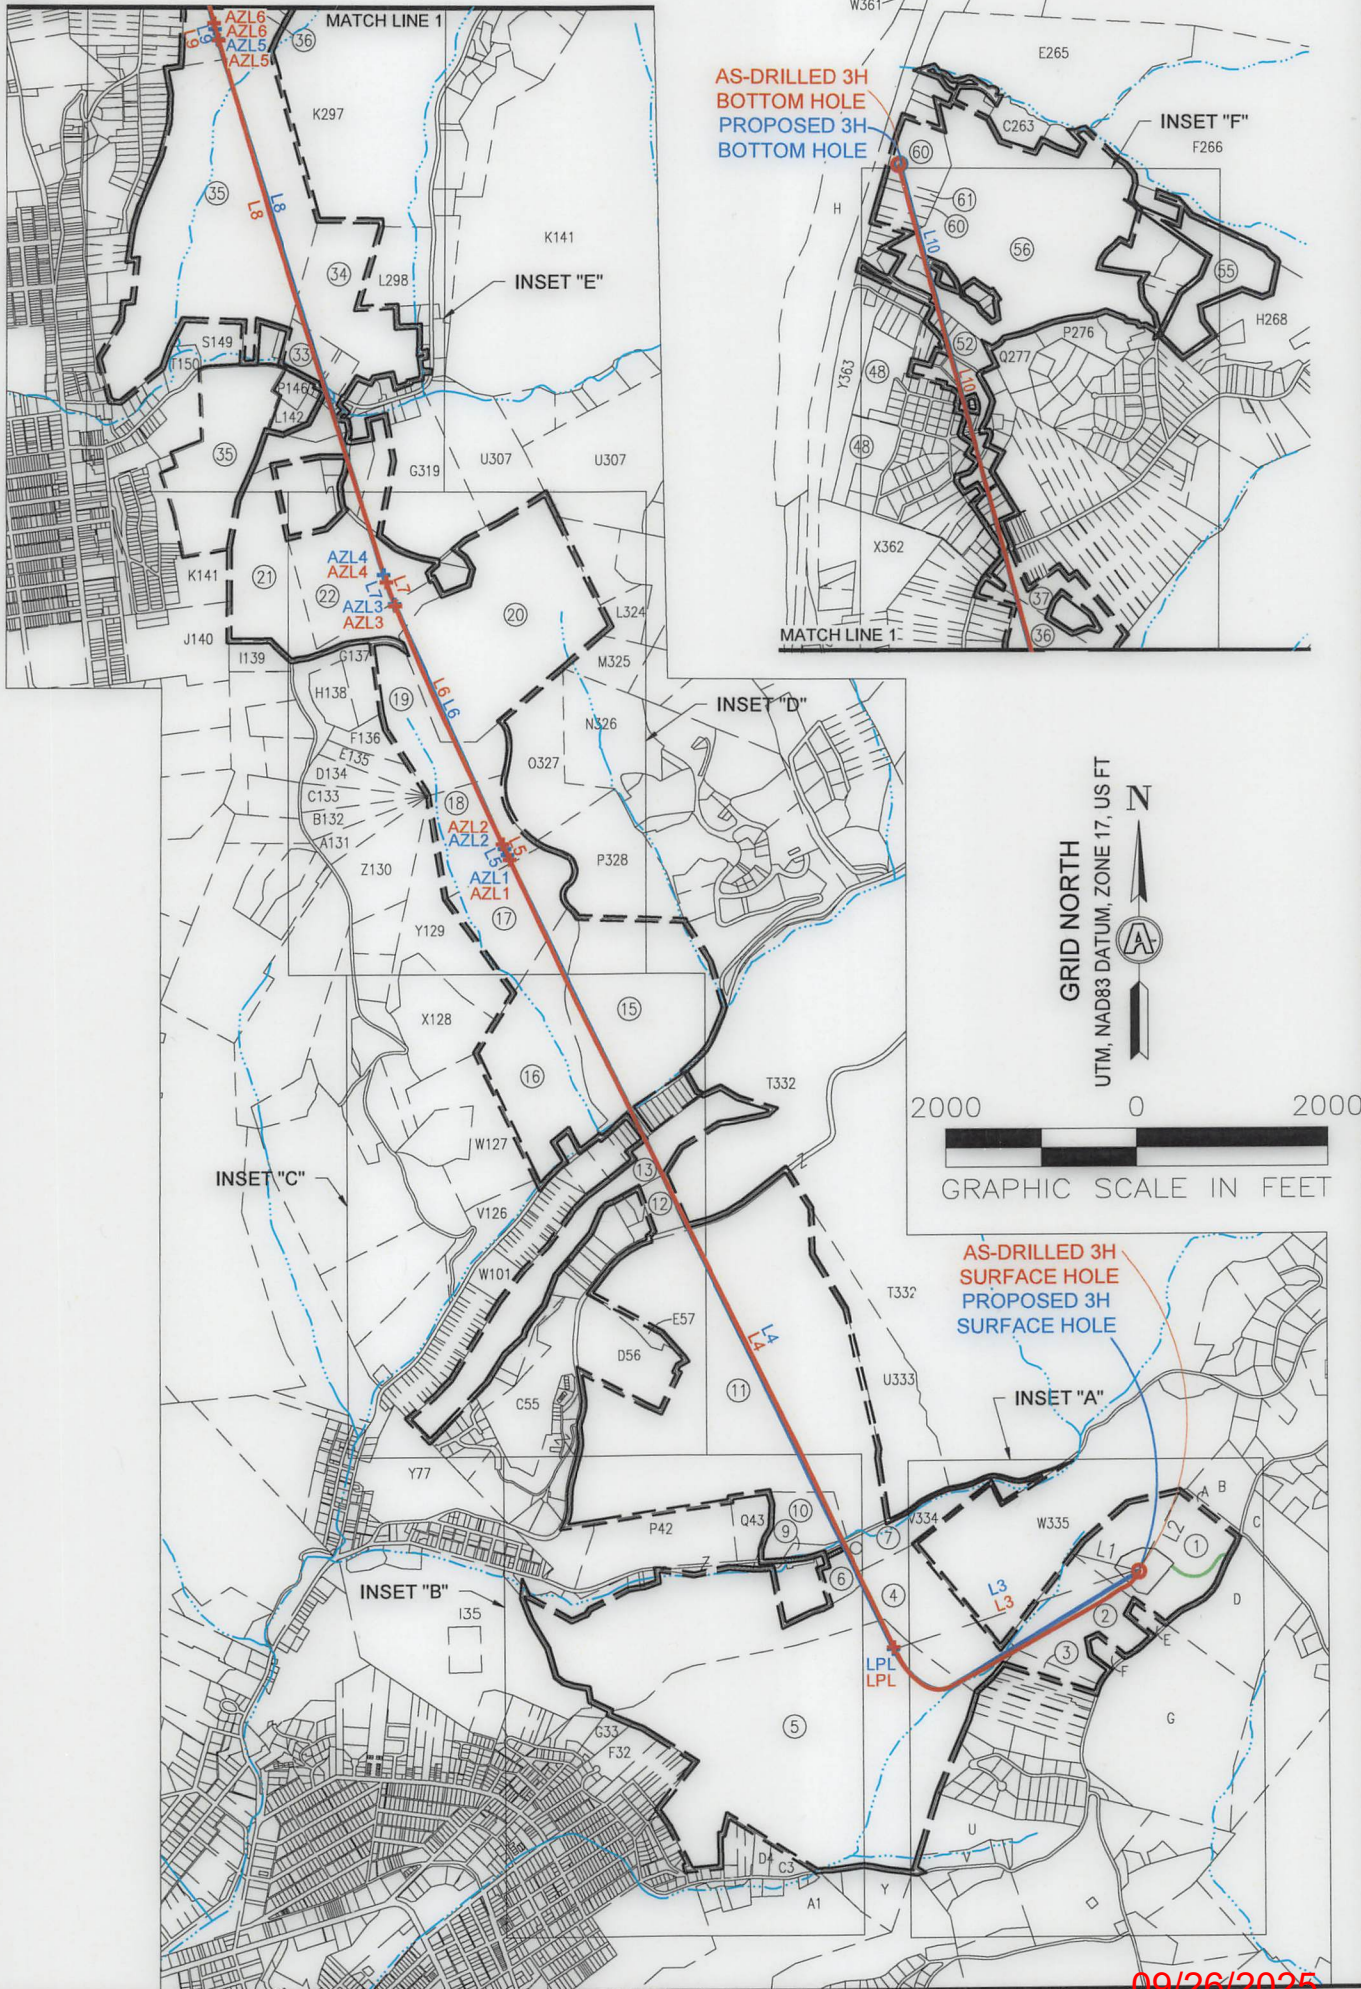

SURVEYOR/ENGINEER:
1700 ANMOORE ROAD
BRIDGEPORT, WV 26330
1-304-933-3463



09/26/2025

REVISIONS:

COMPANY:



OPERATOR'S

SHANNON FIELDS OHI

DATE: 03-31-2025

WELL #:

3H

DRAWN BY: TMF

DISTRICT:

RICHLAND

COUNTY:

OHIO

STATE:

WV


SCALE: N/A

DRAWING NO: ACE-2326

WELL LOCATION PLAT



SURVEYOR/ENGINEER:
1700 ANMOORE ROAD
BRIDGEPORT, WV 26330
1-304-933-3463

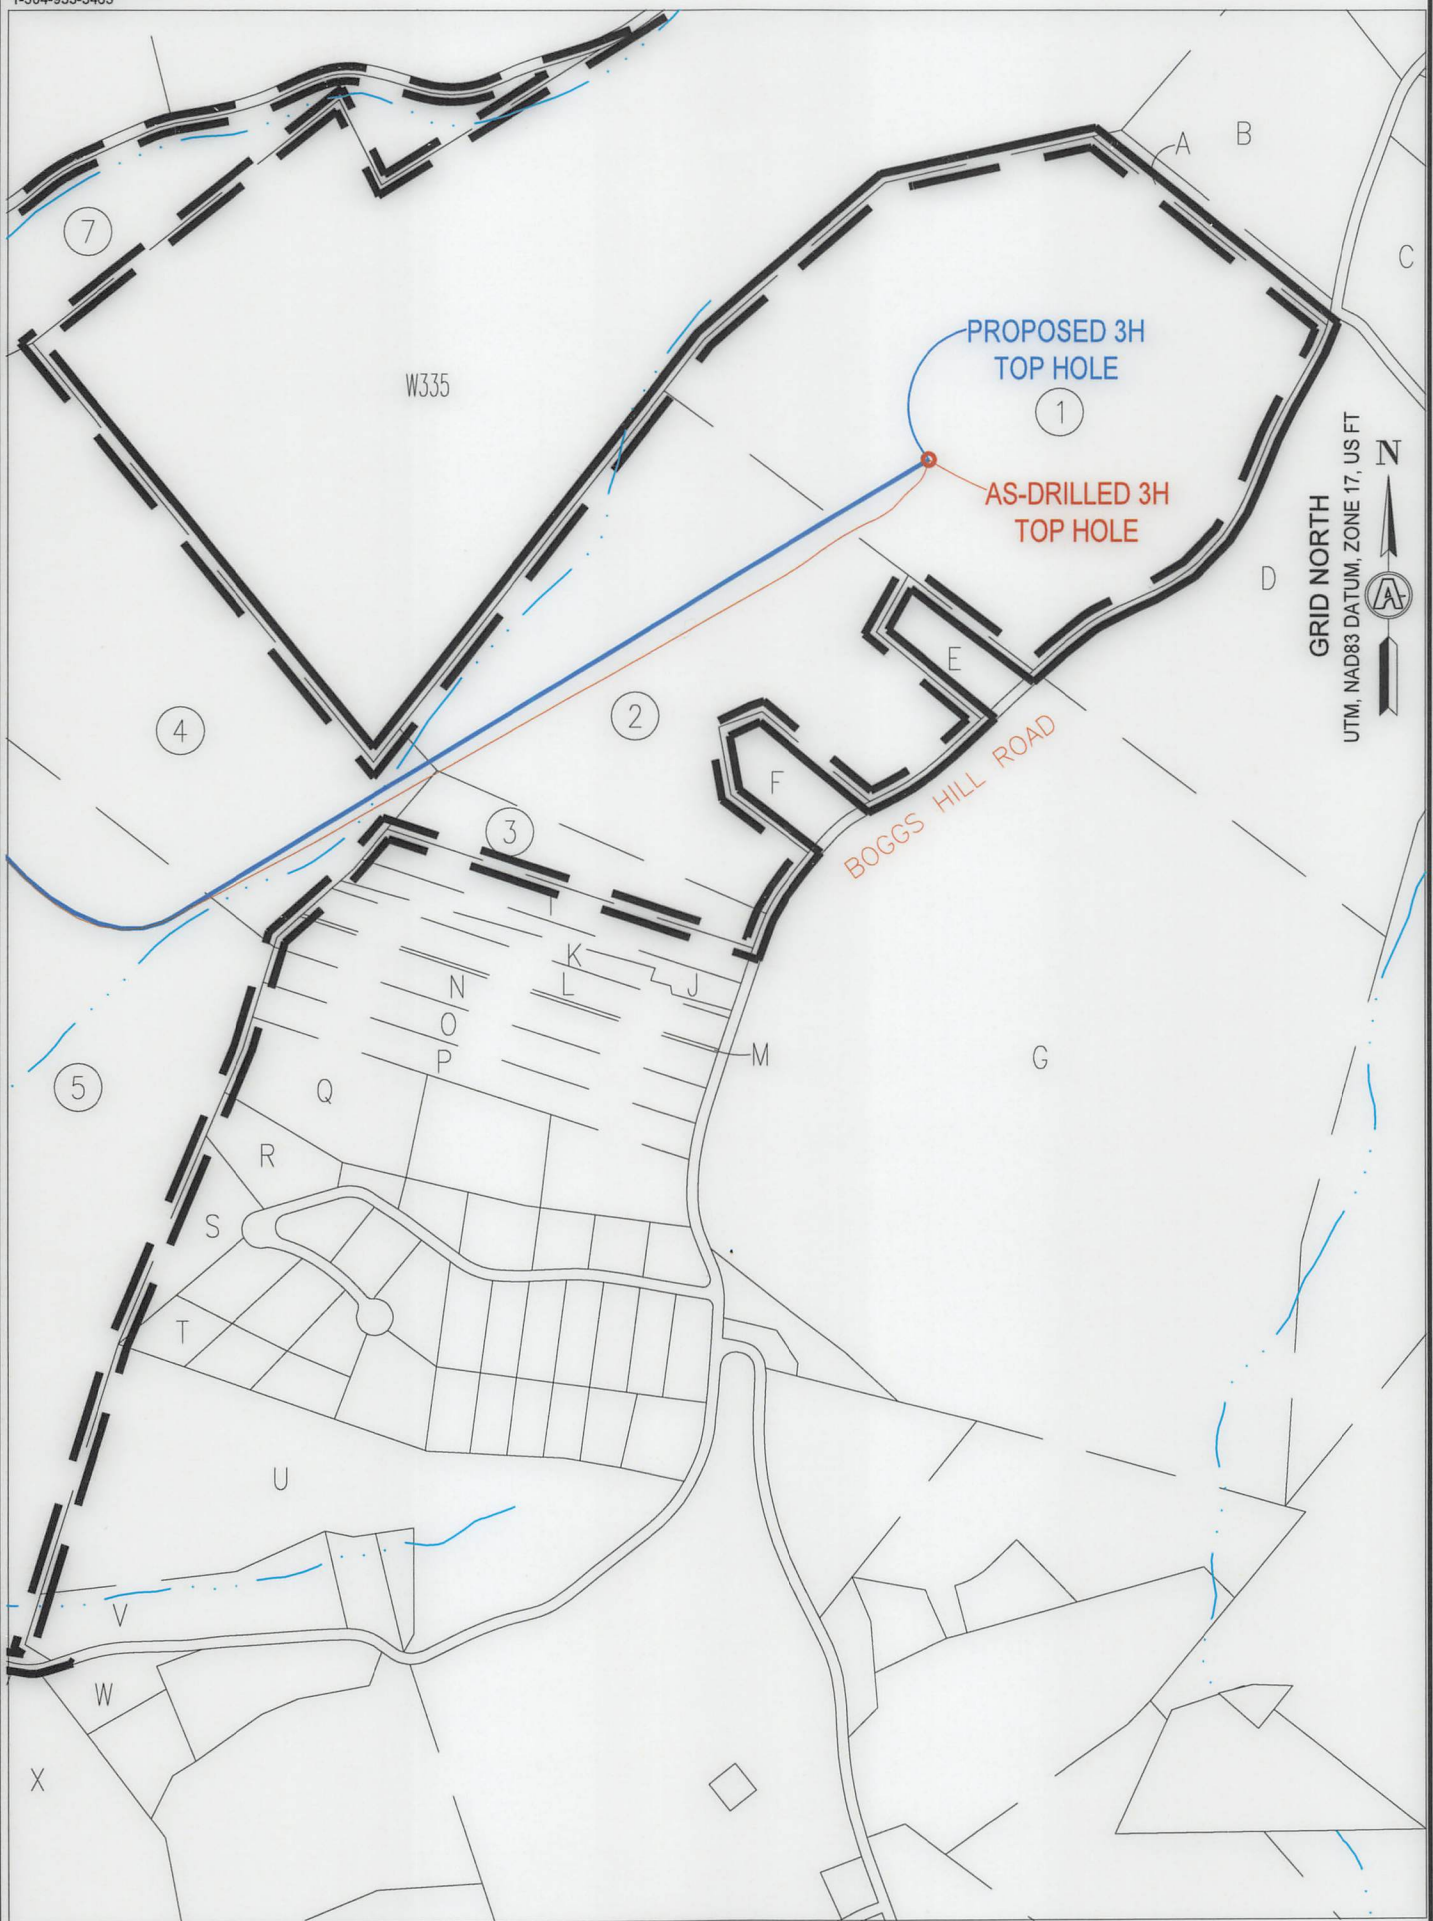

INSET "A"
SCALE: 1"=500'

09/26/2025

REVISIONS:

COMPANY:


OPERATOR'S

SHANNON FIELDS OHI

DATE: 03-31-2025

WELL #:

3H

DRAWN BY: TMF

DISTRICT:
RICHLAND

COUNTY:
OHIO

STATE:
WV

SCALE: N/A
DRAWING NO: ACE-2326
WELL LOCATION PLAT



SURVEYOR/ENGINEER:
1700 ANMOORE ROAD
BRIDGEPORT, WV 26330
1-304-933-3463



GRID NORTH
UTM, NAD83 DATUM, ZONE 17, US FT


INSET "B"
SCALE: 1"=500'

09/26/2025

REVISIONS:			COMPANY:				
			OPERATOR'S			DATE: 03-31-2025	
			WELL #:			DRAWN BY: TMF	
			DISTRICT:			SCALE: N/A	
			COUNTY:			DRAWING NO: ACE-2326	
			STATE:			WELL LOCATION PLAT	



SURVEYOR/ENGINEER:
1700 ANMOORE ROAD
BRIDGEPORT, WV 26330
1-304-933-3463

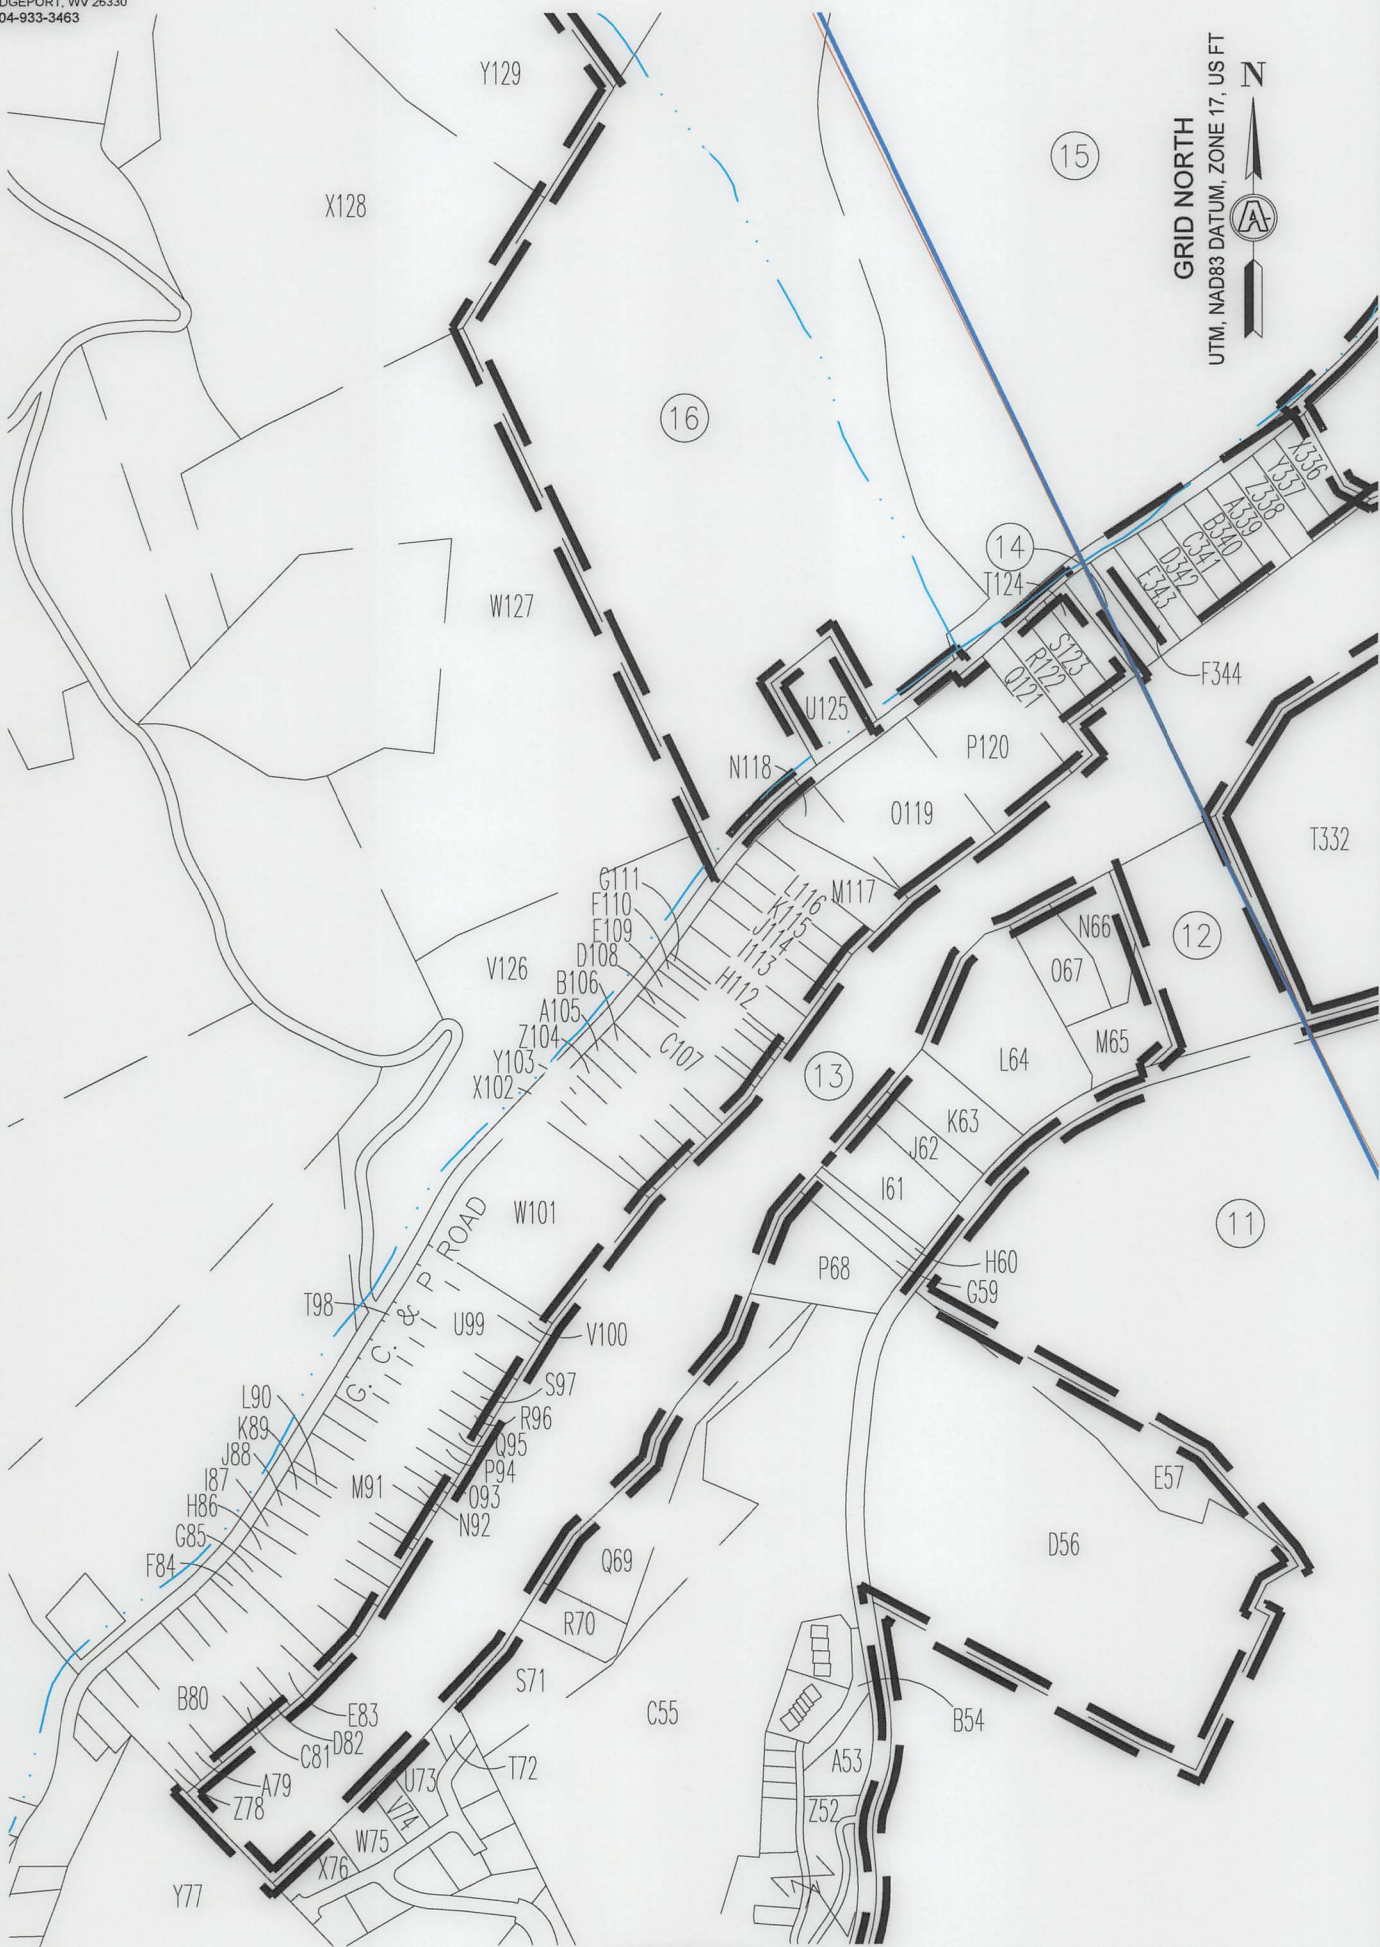

GRID NORTH
UTM, NAD83 DATUM, ZONE 17, US FT

INSET "C"
SCALE: 1"=500'

09/26/2025

REVISIONS:

COMPANY:



OPERATOR'S

SHANNON FIELDS OHI

DATE: 03-31-2025

WELL #:

3H

DRAWN BY: TMF

DISTRICT:
RICHLAND


COUNTY:
OHIO

STATE:
WV

SCALE: N/A
DRAWING NO: ACE-2326
WELL LOCATION PLAT



SURVEYOR/ENGINEER:
1700 ANMOORE ROAD
BRIDGEPORT, WV 26330
1-304-933-3463

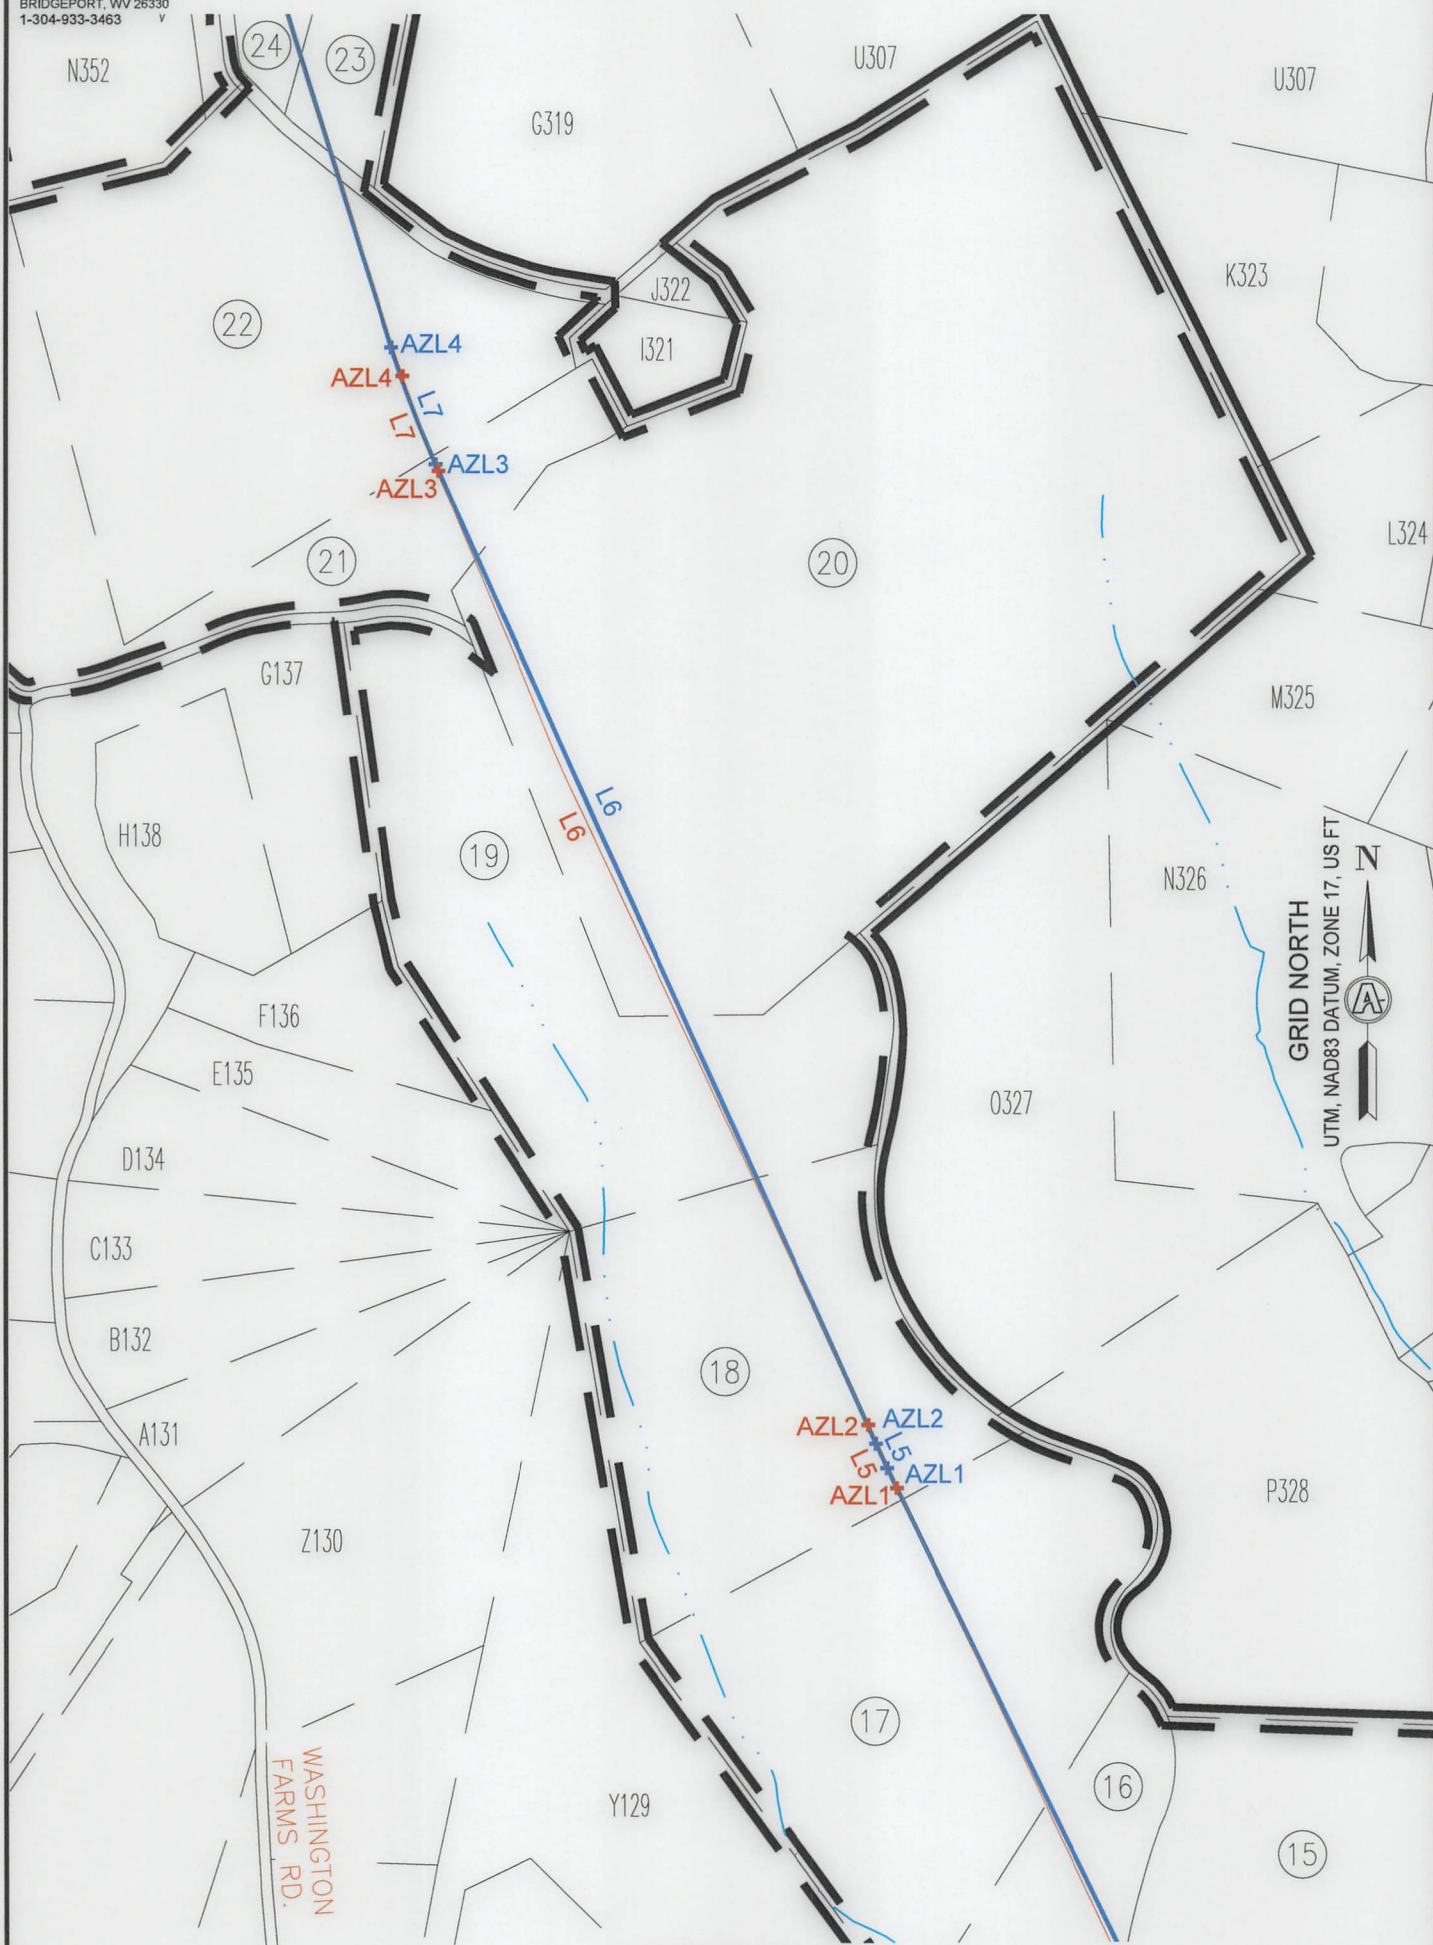

INSET "D"
SCALE: 1"=500'

09/26/2025

REVISIONS:

COMPANY:

expand

OPERATOR'S

SHANNON FIELDS OHI

DATE: 03-31-2025

WELL #:

3H



DRAWN BY: TMF

DISTRICT:
RICHLAND

COUNTY:
OHIO

STATE:
WV

SCALE: N/A
DRAWING NO: ACE-2326
WELL LOCATION PLAT

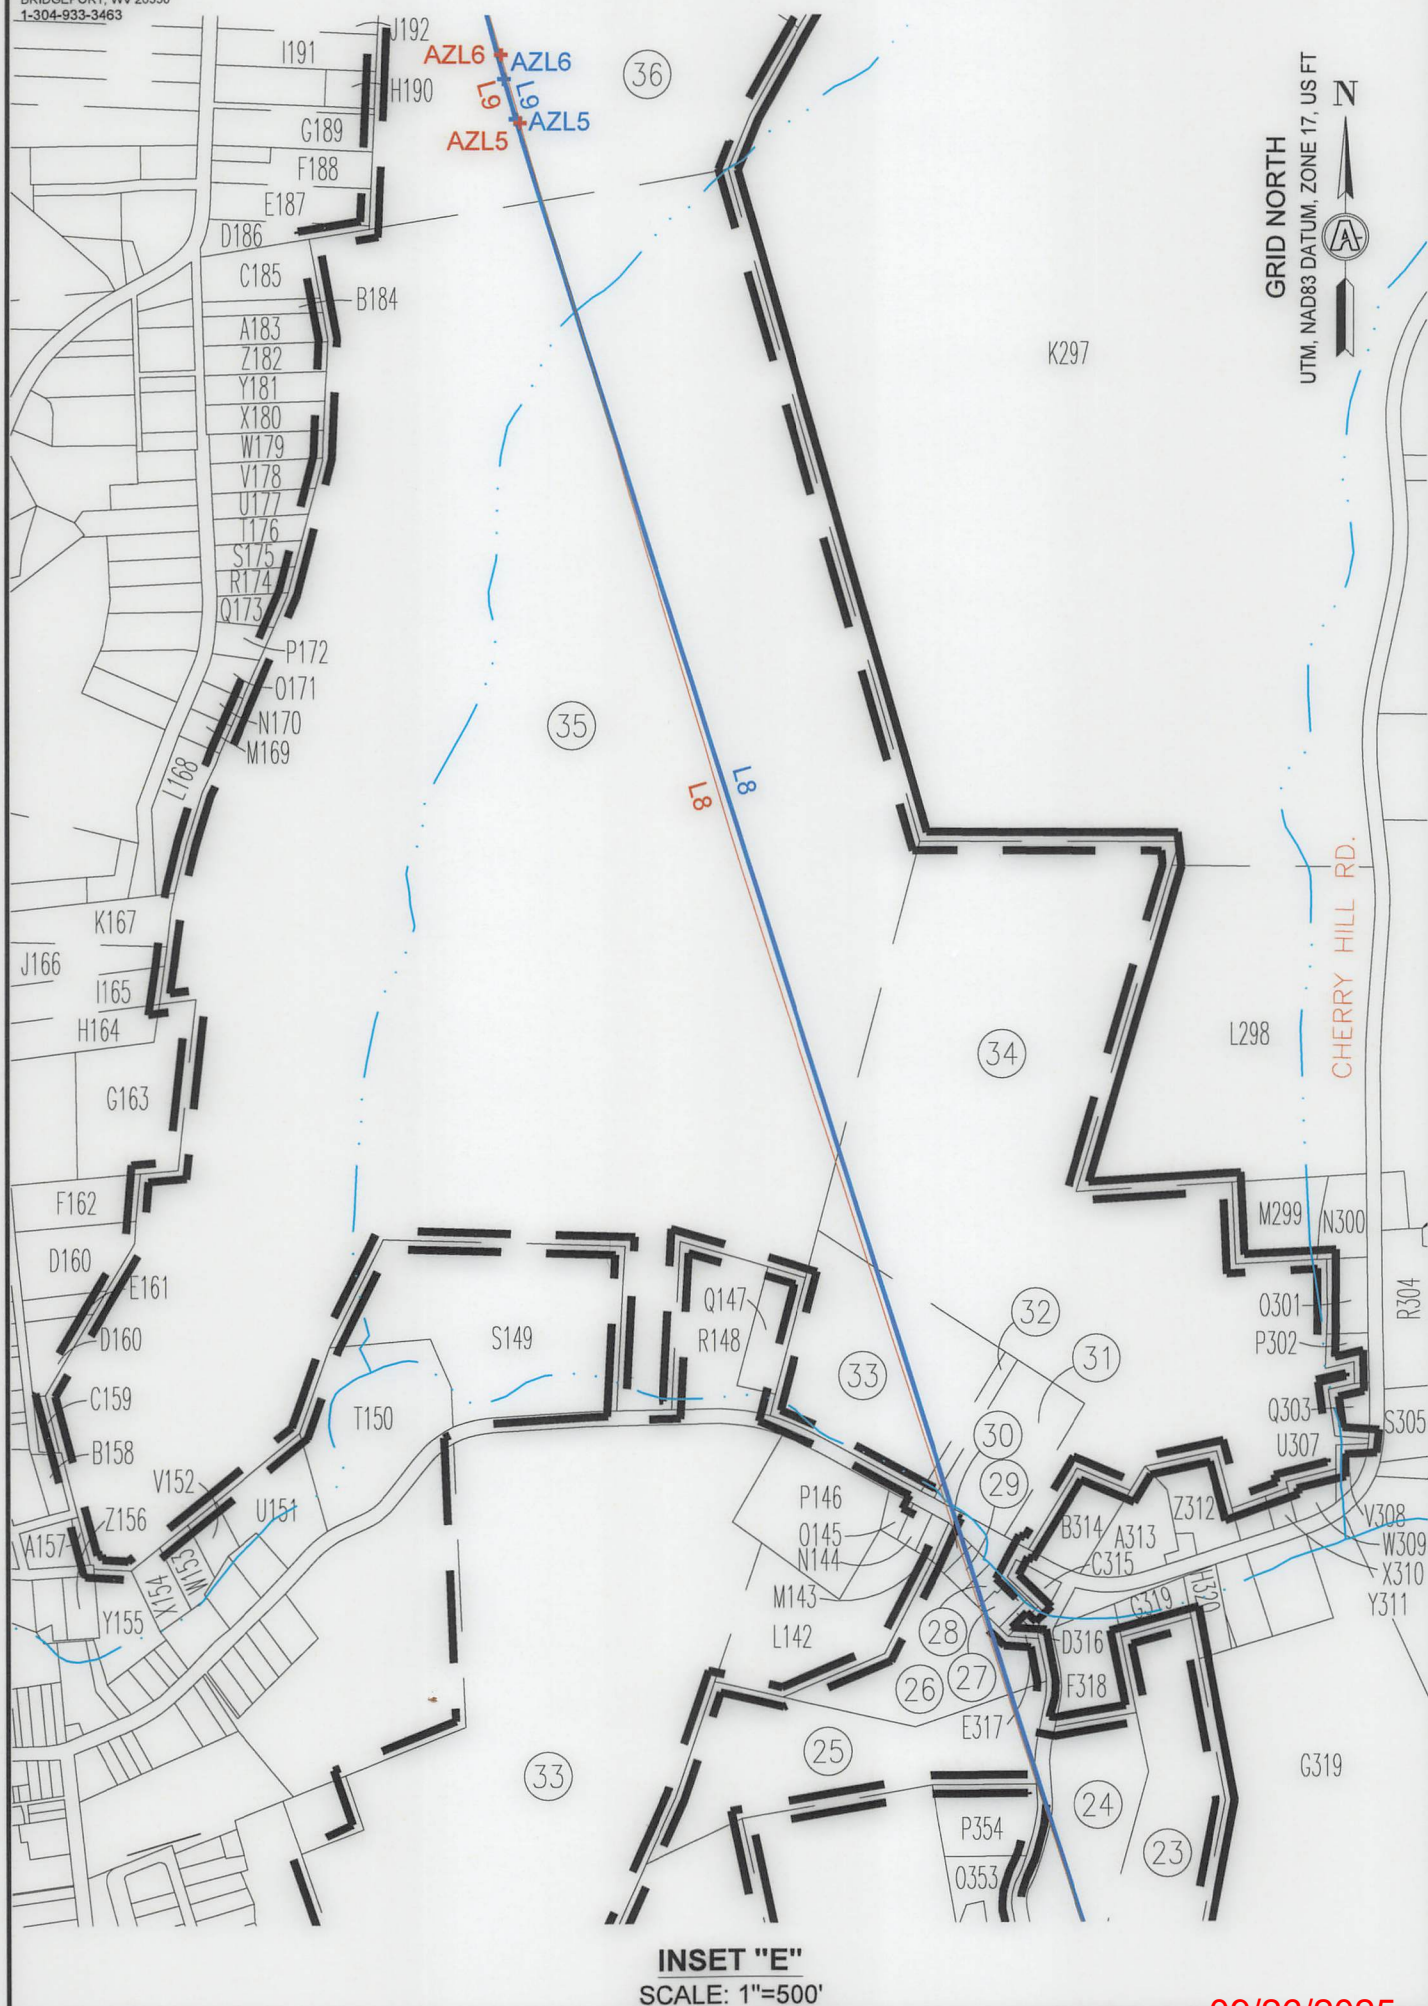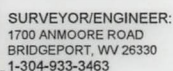[illegible]

expand

STATE:
WV

WELL LOCATION PLAT



SURVEYOR/ENGINEER:
1700 ANMOORE ROAD
BRIDGEPORT, WV 26330
1-304-933-3463

GRID NORTH
UTM, NAD83 DATUM, ZONE 17, US FT





SURVEYOR/ENGINEER:
1700 ANMOORE ROAD
BRIDGEPORT, WV 26330
1-304-933-3463

	WELL BORE TRACTS	
TRACT	SURFACE OWNER (S) / ROYALTY OWNER (R)	TAX PARCEL
1	SWN PRODUCTION COMPANY LLC	4-R17-23.2
TRACT	SURFACE OWNER (S)	TAX PARCEL
2	BENEKE NADA E ET AL	4-R17-19
3	OLEARY CRAIG V & EMMA L	4-R17-17
4	WHEELING PARK COMMISSION	4-R17-6.1
5	WHEELING PARK COMMISSION	6-T1-2
6	CHERRY BROOK CONDOS	10-W27-6
7	GACS LP	10-W27A-1
8	KELLY KATHRYN D	10-W27-6.C008
9	FIGARETTI C; NICODEMUS R; & KENNEN R; TRUSTEES	10-W27-5
10	KEY ANIMAL HOSPITAL INC	10-W27-2
11	ELM HILL HOLDINGS LLC	4-R14-14
12	SCHULTZ JEFFREY S	4-R14-13
13	WHEELING PARK COMMISSION	10-W17A-1
14	SYRYLO RONALD & M	4-R14J-10
15	POLACK EDWARD P	4-R14-95
16	POLACK E PHILLIPS M D	4-R13-15
17	HUPP MOLLY H 1/2 INT & SCHEINHOLTZ DAVID J 1/2 INT	4-R13-1.13
18	HUPP SARA STEPHENS	4-R13-1.17
19	PRATHER JOHN R	4-R13-1.11
20	MULL ELLEN CLARICE ET AL	4-R10-44.1
21	PRATHER JOHN R	4-R10-47
22	MYERS WILBERT E III	4-R10-2
23	ASSARO ANTHONY L & S L	4-R10-43.3
24	ASSARO ANTHONY L & S L	4-R10-43.4
25	HEBERLIG RICHARD EDWARD JR	4-R10-6.1
26	COFFMAN MARGARET AND COFFMAN JR KENNETH	4-R10-6
27	COFFMAN LEONARD & MARY	4-R10M-10
28	COFFMAN MARY K	4-R10M-3.2
29	COFFMAN MARY K	4-R10M-3.1
30	PANEPINTO MARK D	4-R10M-3
31	H3 LLC	4-R10-13
32	NORTH FORK LANDFILL INC	4-R10-14
33	PERSINGER PAMELA M	4-R10-15
34	SARKIS SJ; ROHRIG RF; ROHRIG JR; ROHRIG RF TTEE	4-R10-19
35	NORTH FORK LANDFILL INC	4-R10-43
36	MCGLAUGHLIN DENNIS & S	4-R7-30
37	CLEARVIEW VOL FIRE DEPT INC	2-CV6-34.1
38	WICKHAM THOMAS OR LINDA	2-CV5-31
39	VILLAGE OF CLEARVIEW	2-CV5-30.1
40	JARRETT MARK G & L K	2-CV5-26
41	PENNYBACKER SHAWN R	2-CV5-27
42	MAYNARD JACK E & CYNTHIA L	2-CV5-25
43	STANLEY SHERRY L & R JR	2-CV5-24
44	CRABTREE WM GREGORY & MARLA L	2-CV5-23
45	THOMAS AUSTIN D	2-CV5-22.1
46	GOUDY THOMAS A & S K	2-CV5-20
47	ROBINSON RICHARD J	4-R7L-114
48	CUPP JOSEPH T AND AMY JO	10-W1A-107
49	LENNOX ROBERT D & DEBORAH A	4-R7L-98.2
50	CARROLL JAMES C & ROSE MARIE A	4-R7L-120
51	HOLDERMAN ALBERT JOHN IV & JANA	4-R7L-86.3
52	CITY OF WHEELING	4-R7L-105
53	CITY OF WHEELING	4-R7L-100
54	CITY OF WHEELING	4-R7L-99
55	CITY OF WHEELING	4-R7G-25
56	CITY OF WHEELING	4-R7-18
57	FLUHARTY MICHAEL L	4-R7-6
58	FAZZOLARI FRANK SAMUEL ESTATE	4-R7L-56.5
59	WEST VIRGINIA STATE ROAD COMM	4-R7L-56.4
60	FLUHARTY MICHAEL L & BRENDA K	4-R7L-56
61	WEST VIRGINIA STATE ROAD COMM	4-R7L-56.3

REVISIONS:

COMPANY:

expand

OPERATOR'S

WELL #:

DISTRICT:

COUNTY:

STATE:

SHANNON FIELDS OHI

3H

RICHLAND

OHIO

WV

DATE:

DRAWN BY:

SCALE:

DRAWING NO:

WELL LOCATION

03-31-2025

TMF

N/A

ACE-2326

PLAT



SURVEYOR/ENGINEER:
1700 ANMOORE ROAD
BRIDGEPORT, WV 26330
1-304-933-3463

ADJOINING OWNERS TABLE		
TRACT	SURFACE OWNER	TAX PARCEL
A	HUFFNER EARL P	4-R17-24.1
B	MULL JAMES R	4-R17-24
C	MINCH HERBERT PAUL (1/2 INT) & MINCH BRENDA SUE (1/2 INT)	4-R17-57
D	APPALACHIA MIDSTREAM SERVICES LLC & CYNTHIA SMITH	4-R17-23
E	BENEKE NADA E	4-R17-22
F	JOHN THOMAS & MICHELLE	4-R17-20
G	CARTER RICHARD P	4-R17-23.3
H	UNITED STATES OF AMERICA ARMY CORP OF ENG - PITTS DIV	4-R7-38
I	SCHREIBER JEREMY A & PHILBRICK ELIZABETH	4-R17-16
J	HEMPELMAN MARGARET E ESTATE	4-R17-14
K	COLUMBIA GAS TRANSMISSION CORP	4-R17-15
L	HEMPELMANN GUNTHER F JR	4-R17-13
M	BURKLAND CARL D III & JOLIN H	4-R17-13.1
N	BURKLAND CARL D III & JOLIN H	4-R17-12
O	FISHER HARRY S & BARBARA J	4-R17-11
P	FISHER HARRY S & BARBARA J	4-R17-11.1
Q	LENKEY ATTILA A	4-R17-10.1
R	KIRBY LAUREN MARIE & ANDAM DANIEL KIRBY	6-T2J-11
S	WONDERLY CHERYL LYNN	6-T2J-13
T	APEL RAYMOND	6-T2J-20.6
U	PACHUTA KAREN A & VARONE K J	6-T2-3
V	BLATT TRISTEN M	6-T2-4
W	WALTER MATTHEW C	6-T1-3
X	RCK 2 GROUP LLC 1/2 VOGRIN MICHELLE L 1/2	10-W41-74
Y	DOBBS DANIEL L & JULIE A	6-T1-13
Z	CARROLL DONALD L & CARROLL D ANN M	10-W41-57
A1	VOGRIN STEPHEN T	10-W41-38
B2	TEMPLIN GENEVA E	10-W41-56
C3	STORCH PETER G & LAURIE L	10-W41-46
D4	KOVALICK ROBERT J JR	10-W41-45
E5	MCGINLEY JOSEPH R & KELLY K	10-W41-44.2
F6	MCGINLEY JOSEPH R & KELLY K	10-W41-44.1
G7	MCGINLEY JOSEPH R & KELLY K	10-W41-44
H8	MCGINLEY JOSEPH R & KELLY K	10-W41-43
I9	STORCH PETER G & LAURIE	10-W41-42
J10	HINEGARDNER JAMES L & B S	10-W41-41
K11	HINEGARDNER JAMES L JR & BRENDA S	10-W41-40
L12	STEADMAN STELLA M - TOD	10-W41-39
M13	INGRAM ROBERT H & MARLENE L	10-W41-35.2
N144	BARANOWSKI CRYSTAL L	10-W41-24.2
O15	MCKEETS JEANNE M - TOD	10-W41-24.1
P16	HAMM WILLIAM A	10-W41-24
Q17	RUSSELL NESBITT SERVICES INC	10-W34-16
R18	HOLT SHERYL L	10-W34-17.1
S19	HOLT SHERYL L	10-W34-17
T20	HOLT SHERYL L	10-W34-17.2
U21	NALLY SUSAN B	10-W34-18
V22	SNIDER JAMES & CINDY	10-W34-18.3
W23	SNIDER JAMES & CINDY	10-W34-18.1
X24	SNIDER JAMES & CINDY	10-W34-19
Y25	SNIDER JAMES & CINDY	10-W34-29.1
Z26	WHEELING PARK COMMISSION	10-W34-29
A27	WHEELING PARK COMMISSION	10-W34-28
B28	SNIDER JAMES R	10-W34-27
C29	YOUNG DANIEL & CHELSEA	10-W34-26
D30	YOUNG DANIEL & CHELSEA	10-W34-25
E31	YOUNG DANIEL R & CHELSEA R	10-W34-25.1
F32	YOUNG DANIEL R & CHELSEA R	10-W33-331.9
*HIGHLIGHTED PARCELS MAY BE IMPACTED DURING DRILLING.		

09/26/2025

REVISIONS:

COMPANY:			
OPERATOR'S		SHANNON FIELDS OHI	
WELL #:		3H	
DISTRICT:		COUNTY:	STATE:
RICHLAND		OHIO	WV
		DATE: 03-31-2025	
		DRAWN BY: TMF	
		SCALE: N/A	
		DRAWING NO: ACE-2326	
		WELL LOCATION PLAT	



SURVEYOR/ENGINEER:
1700 ANMOORE ROAD
BRIDGEPORT, WV 26330
1-304-933-3463

ADJOINING OWNERS TABLE		
TRACT	SURFACE OWNER	TAX PARCEL
G33		35-NO-01DO-01D-
H34	PHILLIPSON SANDIN E	6-T1-1
I35	GC&P DEVELOPMENT LLC	10-W26-90
J36	LOHR LINDA J	10-W26-89
K37	GACS L P	10-W26-90.1
L38	LLL LLC	4-R17-6
M39	SEABRIGHT JACK & DANIELLE	4-R17-6.4
N40	SEABRIGHT JACK & DANIELLE	4-R17-6.2
O41	SEABRIGHT JACK A & DANIELLE L	4-R17-6.3
P42	VINEYARD CHRISTIAN FELLOWSHIP & WHEELING TRUSTEES	10-W27-1
Q43	FIRST CLASS REALTY LLC	10-W27-1.1
R44	FIRST CLASS REALTY LLC	10-W27-2.1
S45	FIRST CLASS REALTY LLC	10-W27-2.2
T46	JOCHUM BARBARA ANN	10-W27-3.C001
U47	FOREST BROOK CONDOS	10-W27-3
V48	ARRITT JOSHUA C	10-W27-4
W49	GILSON THOMAS A & STEPHANIE S	10-W26-50
X50	MCCARTHY T CARROLL JR	4-R16-1.5
Y51	HEISELE BARBARA ELLEN	4-R16-1.4
Z52	WEST RENTALS INC	4-R16-1
A53	RAW HOLDINGS LLC	4-R16-1.24
B54	LINDSAY MARK E & JULIE K	4-R16-1.26
C55	ELM HILL HOLDINGS LLC	4-R14-14
D56	ELM HILL LLC	4-R14-7
E57	ELM HILL LLC	4-R14-14.2
F58	WRIGHT DEBORAH D & JOHN E IV	4-R14-8
G59	TOWNSEND TAMMY J	4-R14-9.3
H60	MOREHOUSE SHAWN R	4-R14-9.2
I61	WEST RENTALS INC	4-R14-9
J62	ATKINSON RYAN J & ANN SHANLEY ATKINSON	4-R14-9.1
K63	CHURILLA PAULINE	4-R14-10
L64	WALTER DEBORAH & GERALD	4-R14-11
M65	GREER PETER S	4-R14-12
N66	GREER PETER S	4-R14-11.2
O67	WALTER DEBORAH & GERALD	4-R14-11.1
P68	WRIGHT DEBORAH D & JOHN E IV	4-R14-8
Q69	MICHALSKI JOHN & SUSAN	4-R16-1.23
R70	ROBERTS MARY L - TOD	4-R16-1.1
S71	JOHN M STASKY TRUST UNDER AGREEMENT	4-R16-1.28
T72	MURPHY ROBERT L & LINDA D	4-R16-1.13
U73	DEEM STEVEN C & NORMA J	4-R16-1.22
V74	KALISZ WILLIAM & CATHERINE A	4-R16-1.21
W75	MENDEL MARTHA J	4-R16-1.19
X76	SPERLAZZA RYAN J & ASHLEY M	4-R16-1.18
Y77	BAUER ROBB V AND KATHY	10-W21-43
Z78	BURGER KAREN E & STEVEN T BURGER	4-R13R-25
A79	BECK ISABELLE M	4-R13R-24
B80	WORKMAN KAITLYN MARIE & JACK ARMSTRONG FITCH	4-R13R-22
C81	FINSLEY HENRY M	4-R13R-21
D82	KETTLER JARED E	4-R13R-20
E83	WEISENBORN STEPHANIE L	4-R13R-19
F84	ALTMAN SHARON LOUISE C/O WESBANCO TRUST DEPT	4-R13R-18
G85	DUPLAGA MICHAEL F III	4-R13R-17
H86	GROUX FRED E JR	4-R13R-16
I87	ETHEL ROSE SMITH - TOD	4-R13R-15
J88	HUGHES JOSHUA KELLER	4-R13R-14
K89	MANNING JAMES C	4-R13R-13
L90	MANNING JAMES C	4-R13R-12
M91	WEISENBORN DALE A & S L	4-R13R-11
N92	BEARY HILARY H	4-R13R-10
O93	BOWMAN ROBERT E & BARBARA A	4-R13R-9
*HIGHLIGHTED PARCELS MAY BE IMPACTED DURING DRILLING.		

09/26/2025

REVISIONS:	COMPANY:			
	OPERATOR'S			DATE: 03-31-2025
	WELL #:			DRAWN BY: TMF
	DISTRICT:	COUNTY:	STATE:	SCALE: N/A
	RICHLAND	OHIO	WV	DRAWING NO: ACE-2326
				WELL LOCATION PLAT



SURVEYOR/ENGINEER:
1700 ANMOORE ROAD
BRIDGEPORT, WV 26330
1-304-933-3463

ADJOINING OWNERS TABLE		
TRACT	SURFACE OWNER	TAX PARCEL
Q95	PAREE ANGELO JR & KELLY J	4-R13R-7
R96	MOSCA TRUST; LOUISE E MOSCA TRUSTEE	4-R13R-6
S97	MOSCA TRUST; ROBERT J OR LOUISE E MOSCA TRUSTEES	4-R13R-5
T98	TRABERT TERRI L ET AL	4-R13R-4
U99	BACHMANN PETER	4-R13R-3
V100	SCHUNK CHRISTOPHER & JESSICA	4-R13R-1
W101	JARVIS DOWNING & EMCH INC	4-R13R-27
X102	BICKERSTAFF ROBERT DALE JR	4-R13M-14
Y103	HOLT NED S & CHRISTINE L	4-R13M-13
Z104	HARTMANN SHARON J	4-R13M-12
A105	HARTMANN SHARON J	4-R13M-12.1
B106	COLUMBIA GAS TRANSMISSION CORP	4-R13M-11
C107	RITNER ROBERT L & TRACI L	4-R13M-10
D108	MULL JUSTIN & TAMMEY (LC-BYRS) OLEKSIK CASSIE & D J(LC-SLRS)	4-R13M-8.1
E109	MULL JUSTIN & TAMMEY (LC-BYRS) OLEKSIK CASSIE & D J(LC-SLRS)	4-R13M-8
F110	MULL JUSTIN & TAMMEY (LC-BYRS) OLEKSIK CASSIE & D J(LC-SLRS)	4-R13M-7
G111	FLICK-MOOSS SUZANNE M & MOOSS CHRISTOPHER J	4-R13M-7.1
H112	FLICK-MOOSS SUZANNE M & MOOSS CHRISTOPHER J	4-R13M-6
I113	VOLUSIA VENTURES	4-R13M-4
J114	ARCHER BYRON F JR & M L	4-R13M-3
K115	MICKER DEBORAH A	4-R13M-2
L116	WEST RENTALS INC	4-R13M-1
M117	WEST RENTALS INC	4-R13M-1.1
N118	WEST RENTALS INC	4-R13M-1.2
O119	THURSTON BONNIE BOWMAN	4-R13M-1.3
P120	THURSTON BONNIE L	4-R14J-16
Q121	CLARK MARY LADONNA	4-R14J-14
R122	CLARK MARY LADONNA	4-R14J-13
S123	TODD HOWARD R JR	4-R14J-12
T124	CHIAZZA PETER P & AUDREY D	4-R14J-11
U125	POLACK WENDY B	4-R13-15.1
V126	LAURENCE WASH FARMS IMPROVEMENT ASSN	4-R13-1
W127	CARR NANCY P & ROBERT E JR-TOD	4-R13-17
X128	HOOFF ROBERT H - TOD	4-R13-17.1
Y129	PEACE ANTHONY & TRACEY PEACE-GANTZER	4-R13-25
Z130	POLACK EDWARD P	4-R13-1.18
A131	FERNS MICHAEL D SR & LINDA K	4-R13-16.4
B132	JUNE PAMELA B & WHITLINGER STEVEN W	4-R13-16.5
C133	COLEMAN JOSEPH P & M A	4-R13-16.2
D134	BATES NANCY A & MARCONI LORNA	4-R13-16.1
E135	GRUBLER J & BODNAR K	4-R13-16.3
F136	MYERS MICHAEL & STEPHANIE	4-R13-16.6
G137	MYERS MICHAEL & STEPHANIE	4-R13-16.7
H138	FLETCHER SCOTT A & FLETCHER MELISSA D	4-R13-16
I139	DEVINE DANIEL FRANCIS AND RENSHAW JEAN ANNE	4-R10-48
J140	PRATHER TYLER D	10-W10-171
K141	CITY OF WHEELING	10-W8-348
L142	VAN SICKLE JUDITH ANN	4-R10-6.3
M143	GREEN RANDY L	4-R10M-3.4
N144	GREEN RANDY L	4-R10M-2
O145	ROSS DONNA M	4-R10M-1
P146	NORTH FORK LANDFILL INC C/O SARKIS SUSAN	4-R10-7
Q147	NORTH FORK LANDFILL INC	4-R10-16
R148	NORTH FORK LANDFILL INC	4-R10-17
S149	ROHRIG CATHERINE A	4-R10-43.8
T150	KLEEH JAMES L & M L	4-R10G-16
U151	KLEEH JAMES L & MARILYN	4-R10L-34
*HIGHLIGHTED PARCELS MAY BE IMPACTED DURING DRILLING.		

09/26/2025

REVISIONS:	COMPANY:		
	OPERATOR'S	SHANNON FIELDS OHI	
	WELL #:	3H	
	DISTRICT:	COUNTY:	STATE:
	RICHLAND	OHIO	WV
			DATE: 03-31-2025
			DRAWN BY: TMF
			SCALE: N/A
			DRAWING NO: ACE-2326
			WELL LOCATION PLAT



SURVEYOR/ENGINEER:
1700 ANMOORE ROAD
BRIDGEPORT, WV 26330
1-304-933-3463

ADJOINING OWNERS TABLE		
TRACT	SURFACE OWNER	TAX PARCEL
V152	MONTELEONE DAVID P	4-R10G-16.5
W153	DODD CHAS WILSON & RUTH A	4-R10G-16.4
X154	WELSHHANS DIANA MAE	4-R10L-36
Y155	WELSHHANS DIANA MAE	4-R10L-35
Z156	NASH GARY A & KAREN L	4-R10L-2
A157	WELSHHANS DIANA MAE	4-R10L-3
B158	H3 LLC	4-R10G-15.1
C159	MIKLAVIC THOMAS J	4-R10G-14.2
D160	ROHRIG ROBERT F & KATHLEEN S	4-R10G-14
E161	THOMPSON MARY JEAN	4-R10G-14.1
F162	ROHRIG ROBERT F & KATHLEEN S	4-R10G-12
G163	ROHRIG ROBERT F & K S	4-R10G-17
H164	ROHRIG ROBERT F & KATHLEEN S	4-R10G-8
I165	SARKIS SJ; ROHRIG RF; ROHRIG JR; ROHRIG RF TTEE	4-R10G-7
J166	SARKIS SJ; ROHRIG RF; ROHRIG JR; ROHRIG RF TTEE	4-R10G-6
K167	SARKIS SJ; ROHRIG RF; ROHRIG JR; ROHRIG RF TTEE	4-R10G-4
L168	ROHRIG SHELLEY J	10-W4-118
M169	ALIG JOSEPH E	10-W4-118.5
N170	JOHNSON BARON M JR & C J	10-W4-118.3
O171	OKEY SHAUN D & ALIYA Z	10-W4-118.6
P172	BALDAUF LEIGH ANN C/O GOSSETT LEIGH ANN	10-W4-128
Q173	GWENNAP ROBERT K & ROBIN L PERRY	10-W4-129
R174	GROB PHYLLIS TRUST; GROB PHYLLIS L & R E GROB TEES	10-W4-130
S175	BARTELS MICHAEL STANLEY & JANET KENNEDY BARTELS	10-W4-131
T176	MARTIN JOHN P & AMY L	10-W4-132
U177	ANDERSON CARLAS E JR & ANDERSON RICHELE R	10-W4-133
V178	GREINER MARTHA J TR; GREINER MARTHA J IRREV TRUST	10-W4-134
W179	MILLER ROBERT D - RTO; ROBERT R MILLER	2-CV7-42.1
X180	PEKLINSKY JENNIFER S & ANDREW	2-CV7-41
Y181	TYSON DAVID DUANE & LINDA	2-CV7-39
Z182	KREITZER RAYMOND F & A B	2-CV7-38
A183	KLOSS HELEN LUCY ESTATE	2-CV7-37
B184	CONNIFF ROBERT B & JONI L; MILLER BECCA R & ANDREW K	2-CV7-36
C185	FOX SUSAN C	2-CV7-34
D186	HANEY WILLIAM D & DARLENE	2-CV7-32
E187	OTT THOMAS A & DEBRA A	2-CV7-31
F188	OTT THOMAS ANDREW & DEBRA A	2-CV7-30
G189	HARRISON LISA MAUREEN	2-CV7-28
H190	MCGLAUGHLIN DENNIS J	2-CV7-27
I191	TRABERT DORIS H	2-CV7-26
J192	TRABERT GERALD L & D H	2-CV7-25
K193	SCHMITT CAMERON & JONES PATRICK J JR	2-CV7-22
L194	SCHMITT CAMERON & JONES PATRICK J JR	2-CV7-22.1
M195	MACRI LOGAN B	2-CV5-39
N196	DELBRUGGE MARK A & PATRICIA DELBRUGGE - TOD	2-CV5-38
O197	MAHLKE CATHERINE BROWN	2-CV5-37
P198	BLANKENSHIP LYNNE K	2-CV5-34
Q199	WRIGHT DANIEL L & MARIANNA L	2-CV5-8
R200	COOLEY RODNEY	2-CV5-10
S201	DRAGONETTI EDA L	2-CV5-11
T202	DRAGONETTI EDA L	2-CV5-11.1
U203	WICKHAM THOMAS OR LINDA	2-CV5-31
V204	KOSEM GERALD L	2-CV5-12
W205	CUPP MICHAEL L & R I	2-CV5-13.1
X206	CUPP MICHAEL L & RUBY I	2-CV5-13
Y207	PENNYBACKER SHAWN R & PENNYBACKER VICKI I	2-CV5-15
Z208	PENNYBACKER SHAWN R & VICKI I	2-CV5-15.1
A209	ALLEN AARON & DARLENE - TOD	2-CV5-16
*HIGHLIGHTED PARCELS MAY BE IMPACTED DURING DRILLING.		

09/26/2025

REVISIONS:	COMPANY:		
	OPERATOR'S	SHANNON FIELDS OHI	
	WELL #:	3H	
	DISTRICT:	COUNTY:	STATE:
	RICHLAND	OHIO	WV
			DATE: 03-31-2025
			DRAWN BY: TMF
			SCALE: N/A
			DRAWING NO: ACE-2326
			WELL LOCATION PLAT



SURVEYOR/ENGINEER:
1700 ANMOORE ROAD
BRIDGEPORT, WV 26330
1-304-933-3463

ADJOINING OWNERS TABLE		
TRACT	SURFACE OWNER	TAX PARCEL
B210	BARRY WILLIAM D & CHIAZZA MARY L	2-CV5-17.1
C211	CRABTREE WILLIAM G & M L	2-CV5-17
D212	WILLIAMS RAY A	2-CV5-18.1
E213	THOMAS AUSTIN D	2-CV5-23.1
F214	THOMAS AUSTIN D	2-CV5-22
G215	CAMPBELL MARK A & C L	2-CV5-18
H216	VAN LANEN SAMANTHA R & FOLMAR REESE A	2-CV5-40
I217	COTTRELL ROGER KEITH JR	2-CV5-41
J218	DELANEY EXIE C & B K	2-CV5-19
K219	MAYLES HARRY J JR	2-CV2-1
L220	ANGIUS JEANIE M	2-CV2-1.2
M221	LENNOX ROBERT & DEBORAH	4-R7L-119
N222	LENNOX ROBERT D & D	4-R7L-118
O223	MITCHELL EVERETT & JESSICA R	4-R7L-85.3
P224	HOLDERMAN ALBERT JOHN IV & JANA	4-R7L-86.2
Q225	WRIGHT BILLY R II & BECKY S	4-R7L-86.1
R226	DOWLER ELIZABETH & DAVID	4-R7L-86
S227	WORLS GEORGE R JR & BETTY B; WORLS BRENT R - TOD	4-R7L-87
T228	MOORE JERRY W	4-R7L-87.1
U229	CROOK REBECCA J & MELINDA S CROOK	4-R7L-88
V230	CROOK REBECCA J & MELINDA S CROOK	4-R7L-89
W231	SHAVER NATALIE A & GARY P JR	4-R7L-43
X232	STECHLY ROBERT F & J A	4-R7L-44
Y233	STECHLY ROBERT F & J A	4-R7L-45
Z234	BRUHN DAVID ALAN	4-R7L-46
A235	COLUMBIA GAS TRANSMISSION CORP	4-R7L-47
B236	RUSNAK BRITTANY	4-R7L-74.1
C237	BEITER MATTHEW & COLLEEN	4-R7L-74
D238	BLACK BRIAN J & M G	4-R7L-73
E239	KALCUM CATHERINE G	4-R7L-72.1
F240	CUPP JOSEPH T & AMY JO	4-R7L-72
G241	GOUDY JARID	2-CV5-50
H242	GOUDY JARID	4-R7L-107.1
I243	SACCO FAMILY TRUST	4-R7L-107.2
J244	MACFARLAND KIMBERLY	4-R7L-92
K245	MACFARLAND KIMBERLY	4-R7L-91
L246	MACFARLAND KIMBERLY	4-R7L-41
M247	MACFARLAND KIMBERLY	4-R7L-39
N248	MACFARLAND KIMBERLY	4-R7G-24
O249	PAYTON SHARON S ET AL	4-R7G-23
P250	PAYTON SHARON S ET AL	4-R7G-20
Q251	ROBINSON RICHARD J	4-R7G-19
R252	VELEGOL DAVID & CAROLYN	4-R7G-18
S253	GUZZI COREY A & BRITTANY N	4-R7-11
T254	GUZZI COREY A & BRITTANY N	4-R7-10
U255	BOURNE JOHN & LETHA	4-R7L-56.8
V256	WEST VIRGINIA STATE ROAD COMM	4-R7L-56.7
W257	MORGAN WILBUR W	4-R7L-56.6
X258	WEST VIRGINIA STATE ROAD COMM	4-R7L-56.2
Y259	DOUGHERTY GEORGE H & THELMA T	4-R7L-56.1
Z260	JONES SHANNON M WILDS	4-R7-16.1
A261	DEAN LOMAN L & R Z	4-R7-21
B262	LOEW J W JR & ELSIE	4-R7-22
C263	HARTFILE GARY L - TOD	4-R7-16
D264	HARTFILE GARY L - TOD	4-R7-20
HIGHLIGHTED PARCELS MAY BE IMPACTED DURING DRILLING.		

REVISIONS:

COMPANY:

expand

OPERATOR'S

WELL #:

DISTRICT:

RICHLAND

COUNTY:

OHIO

STATE:

WV

DATE: 03-31-2025

DRAWN BY: TMF

SCALE: N/A

DRAWING NO: ACE-2326

WELL LOCATION PLAT



SURVEYOR/ENGINEER:
1700 ANMOORE ROAD
BRIDGEPORT, WV 26330
1-304-933-3463

ADJOINING OWNERS TABLE		
TRACT	SURFACE OWNER	TAX PARCEL
E265	EDGE BRUCE W	4-R7-23
F266	ROTH FARMS, LLC	4-R7-24
G267	HARTFILE GARY L -TOD	4-R7-15.1
H268	FEDORKE AARON P & TIMOTHY J	2-CV4-3
I269	FLUHARTY MICHAEL AND BRENDA K	4-R7-17
J270	STEWART MARK E; GEIGER LEEANN	4-R7-28
K271	STEWART MARK E	4-R7-15.2
L272	BIEGA FRANKIE P & C S	4-R7-15
M273	STOEHR RONALD J & MARIE G- TOD	2-CV3-4.7
N274	ROWND DENISE A & ROWND DANIEL THOMPSON III	4-R7-14.1
O275	ROWND DENISE & DANIEL T III	4-R7-14
P276	ROWND DENISE & THOMPSON DANIEL, III	4-R7-12
Q277	BIEGA CONNIE SUE & FRANK PAUL	4-R7-12.10
R278	CUPP JOSEPH T AND AMY JO	4-R7L-107
S279	CHUMNEY KEVIN K AND JANET L	4-R7Q-13
T280	VILLAGE OF CLEARVIEW	4-R7L-117
U281	REINACHER CHARLES J & CAROL S	2-CV6-4
V282	WAGNER JOHN M & JODY L	2-CV6-2.1
W283	WAGNER JOHN M & JODY L	2-CV6-2.2
X284	WAGNER JOHN M & JODY L	2-CV6-2
Y285	FRUM JAMES P & CAROL L	2-CV6-1
Z286	LEIB RAYCE P & GEORGE CARRIE A	2-CV5-29
A287	WICKHAM THOMAS OR LINJA	2-CV5-28
B288	CLATTERBUCK CHAD J	2-CV6-34
C289	STEFANOW JOHN	2-CV6-33
D290	PARKER GAGE C	2-CV6-32
E291	THOMAS AMANDA & MARK S II	2-CV6-31
F292	HAWK ANGELA S & BART N WISIALOWSKI	2-CV6-30
G293	RUSSELL J F SR & W M (L/E) KUZNICK MARGARET CAROL	2-CV6-29
H294	SPARKS FAMILY IRREVOCABLE TRST; TRACY LYNN EBERHARD TRUSTEE	2-CV6-29.1
I295	PLANET HOME LENDING LLC	2-CV6-28
J296	VILLAGE OF CLEARVIEW	2-CV6-34.2
K297	WARWOOD LAND CO LLC	4-R7-31
L298	BREIDING JOSHUA D & SARAH N	4-R10-20
M299	MCGARRY CORENA ESTATE	4-R10-33
N300	MCGARRY CORENA ESTATE	4-R10-32
O301	BREIDING JOSHUA D	4-R10-34.2
P302	NORTH FORK LANDFILL INC	4-R10-34.1
Q303	ROBINSON RICHARD J	4-R10-37
R304	MCCARDLE STANLEY M JR & M	4-R10-36
S305	IAFRATE DAVID A	4-R10-39
T306	NORTH FORK LANDFILL INC C/O SUSAN SARKIS	4-R10-41.1
U307	NORTH FORK LANDFILL INC C/O SUSAN SARKIS	4-R10-39.1
V308	NORTH FORK LANDFILL INC	4-R10-38
W309	JAQUAY TODD F	4-R10-19.1
X310	MOFFITT SYLVIA F	4-R10-10
Y311		4-R10-19.2
Z312	SARKIS SJ; ROHRIG RF; ROHRIG JR; ROHRIG RF TTEE	4-R10-10.1
A313	SARKIS SJ; ROHRIG RF; ROHRIG JR; ROHRIG RF TTEE	4-R10-11
B314	GILBERT DONALD E JR	4-R10-12
C315	RENSHAW MICHAEL F & RENSCHAW OWEN F JR	4-R10M-3.3
D316		4-R10M-11
E317	COFFMAN KENNETH JR	4-R10-6.2
F318	ASSARO ANTHONY L & S L	4-R10-43.2
G319	NORTH FORK LANDFILL INC	4-R10-43.1
H320	ASSARO ANTHONY L SR & SANDRA	4-R10-43.5
I321	PRATHER TYLER D	4-R10-44
*HIGHLIGHTED PARCELS MAY BE IMPACTED DURING DRILLING.		

REVISIONS:

COMPANY:

DATE: 03-31-2025

OPERATOR'S

SHANNON FIELDS OHI

WELL #:

3H

DISTRICT:

RICHLAND

COUNTY:

OHIO

STATE:

WV

DRAWN BY: TMF

SCALE: N/A

DRAWING NO: ACE-2326

WELL LOCATION PLAT



SURVEYOR/ENGINEER:
1700 ANMOORE ROAD
BRIDGEPORT, WV 26330
1-304-933-3463

ADJOINING OWNERS TABLE		
TRACT	SURFACE OWNER	TAX PARCEL
J322	PRATHER TYLER D	4-R10-44.2
K323	DOYLE DANIEL T & LUCINDA E	4-R11-2.12
L324	LOWE JEREMY J & AMANDA L	4-R11-2.11
M325	LOWE JEREMY J & AMANDA L	4-R11-2.6
N326	SANTORINE LORA KAY & SANTORINE ADOLPH W JR	4-R14A-24
O327	GRIMES THOMAS B TRUSTEE THE ARCHIE TODD HUPP IV	4-R13-1.15
P328	HUPP SARA	4-R13-1.14
Q329	ADAMS JAMES C & MELISSA S	4-R14E-1
R330	SUNSHINE STATE INV GROUP LLC	4-R14A-53
S331	ALLEN AMY & THOMAS E JR (BYRS) ALLEN THOMAS E (LC-SLR)	4-R14E-4
T332	CITY OF WHEELING	4-R14-15
U333	WHEELING PARK COMMISSION	4-R14-14.1
V334	H3 LLC	04-0R7L-0098.1
W335	PARK VIEW MEMORIAL GARDENS INC	4-R17-8
X336	PELUCHETTE JOHN M & C L	4-R14J-1
Y337	PANEPINTO MARK D & MINDY D	4-R14J-2
Z338	DUVAL THOMAS & ALLAMONG MARY F	4-R14J-3
A339	BOUDREAU DENISE LYNN	4-R14J-4
B340	FERRELL ELLIOT C	4-R14J-5
C341	TAYLOR JOANE L	4-R14J-8
D342	RICE STEVEN A AND JUDITH A	4-R14J-7
E343	BALTZ LEE E & J L	4-R14J-6
F344	ZAVOLTA RONALD W	4-R14J-9
G345	LIGNUM VIA LLC	10-W27-6.C001
H346	CLATTERBUCK MARIANNE	10-W27-6.C002
I347	LIGNUM VIA LLC	10-W27-6.C003
J348	LIGNUM VIA LLC	10-W27-6.C004
K349	LIGNUM VIA LLC	10-W27-6.C005
L350	NESTOR PAMELA	10-W27-6.C006
M351	LIGNUM VIA LLC	10-W27-6.C007
N352	PRATHER TYLER D	4-R10-3
O353	WADDELL DONALD L & D J	4-R10-4
P354	RENSHAW VICKI J	4-R10-5
Q355	WOLFE JAMES R ESTATE	4-R7-7
R356	FLUHARTY MICHAEL L & BRENDA K	4-R7-8
S357	FLUHARTY MICHAEL L & BRENDA K	4-R7-9.1
T358	FLUHARTY MICHAEL & BRENDA	4-R7-9
U359	FEDORKE TIMOTHY JOSEPH	4-R7-37
V360	BIEGA FRANK & CONNIE	4-R7-27.2
W361	UNITED STATES OF AMERICA ARMY CORP OF ENG - PITTS DIV	4-R4-1
X362	MONTELEONE TERESA	10-W2-1
Y363	H3 LLC	04-0R7G-29
Z364	H3 LLC	04-0R7L-116
A365		
*HIGHLIGHTED PARCELS MAY BE IMPACTED DURING DRILLING.		

REVISIONS:

COMPANY:

DATE: 03-31-2025

OPERATOR'S

SHANNON FIELDS OHI

DATE: 03-31-2025

WELL #:

3H

DRAWN BY: TMF

DISTRICT:

RICHLAND

SCALE: N/A

COUNTY:

OHIO

DRAWING NO: ACE-2326


STATE:

WV


WELL LOCATION PLAT



SURVEYOR/ENGINEER:
1700 ANMOORE ROAD
BRIDGEPORT, WV 26330
1-304-933-3463

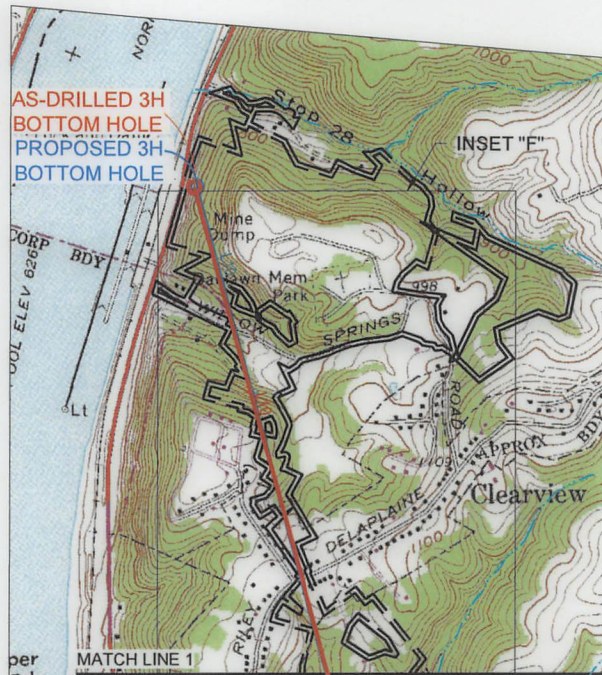

SURFACE HOLE LOCATION (SHL):
GEOGRAPHIC (NAD83):
LATITUDE: 40.088361°
LONGITUDE: -80.657858°
BOTTOM HOLE LOCATION (BHL):
GEOGRAPHIC (NAD83):
LATITUDE: 40.149637°
LONGITUDE: -80.698841°

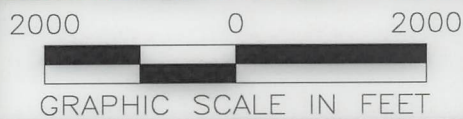


- NOTES ON SURVEY
1. SURFACE AND ROYALTY OWNER INFORMATION AND THEIR BOUNDARIES SHOWN HEREON WERE PLOTTED FROM DEEDS AND/OR TAX PARCEL MAPS PROVIDED BY CLIENT AND/OR FIELD LOCATIONS.
 2. THIS PLAT DOES NOT REPRESENT A BOUNDARY SURVEY OF THE PARCELS SHOWN HEREON.
 4. ALL INSETS ARE GRID NORTH UNLESS OTHERWISE DEPICTED.

- LEGEND:
- PROPOSED SURFACE HOLE / BOTTOM HOLE
 - EXISTING / PRODUCING WELLHEAD
 - LPL* LANDING POINT LOCATION
 - EXISTING WATER WELL
 - EXISTING SPRING
 - SURVEYED BOUNDARY
 - LEASE BOUNDARY
 - ASDRILLED PATH
 - PROPOSED PATH
 - DHP BUFFER


WELL OPERATOR: EXPAND ENERGY CORPORATION	WELL (FARM) NAME: SHANNON FIELDS OHI	WELL # 3H	SERIAL # XXXX
ADDRESS: 1300 FORT PIERPONT DRIVE, SUITE 201	COUNTY - CODE OHIO - 35	DISTRICT; RICHLAND	
SURFACE OWNER: SWN PRODUCTION COMPANY, LLC	USGS 7 1/2 QUADRANGLE MAP NAME WHEELING, WV		

GRID NORTH
UTM, NAD83 DATUM, ZONE 17, US FT

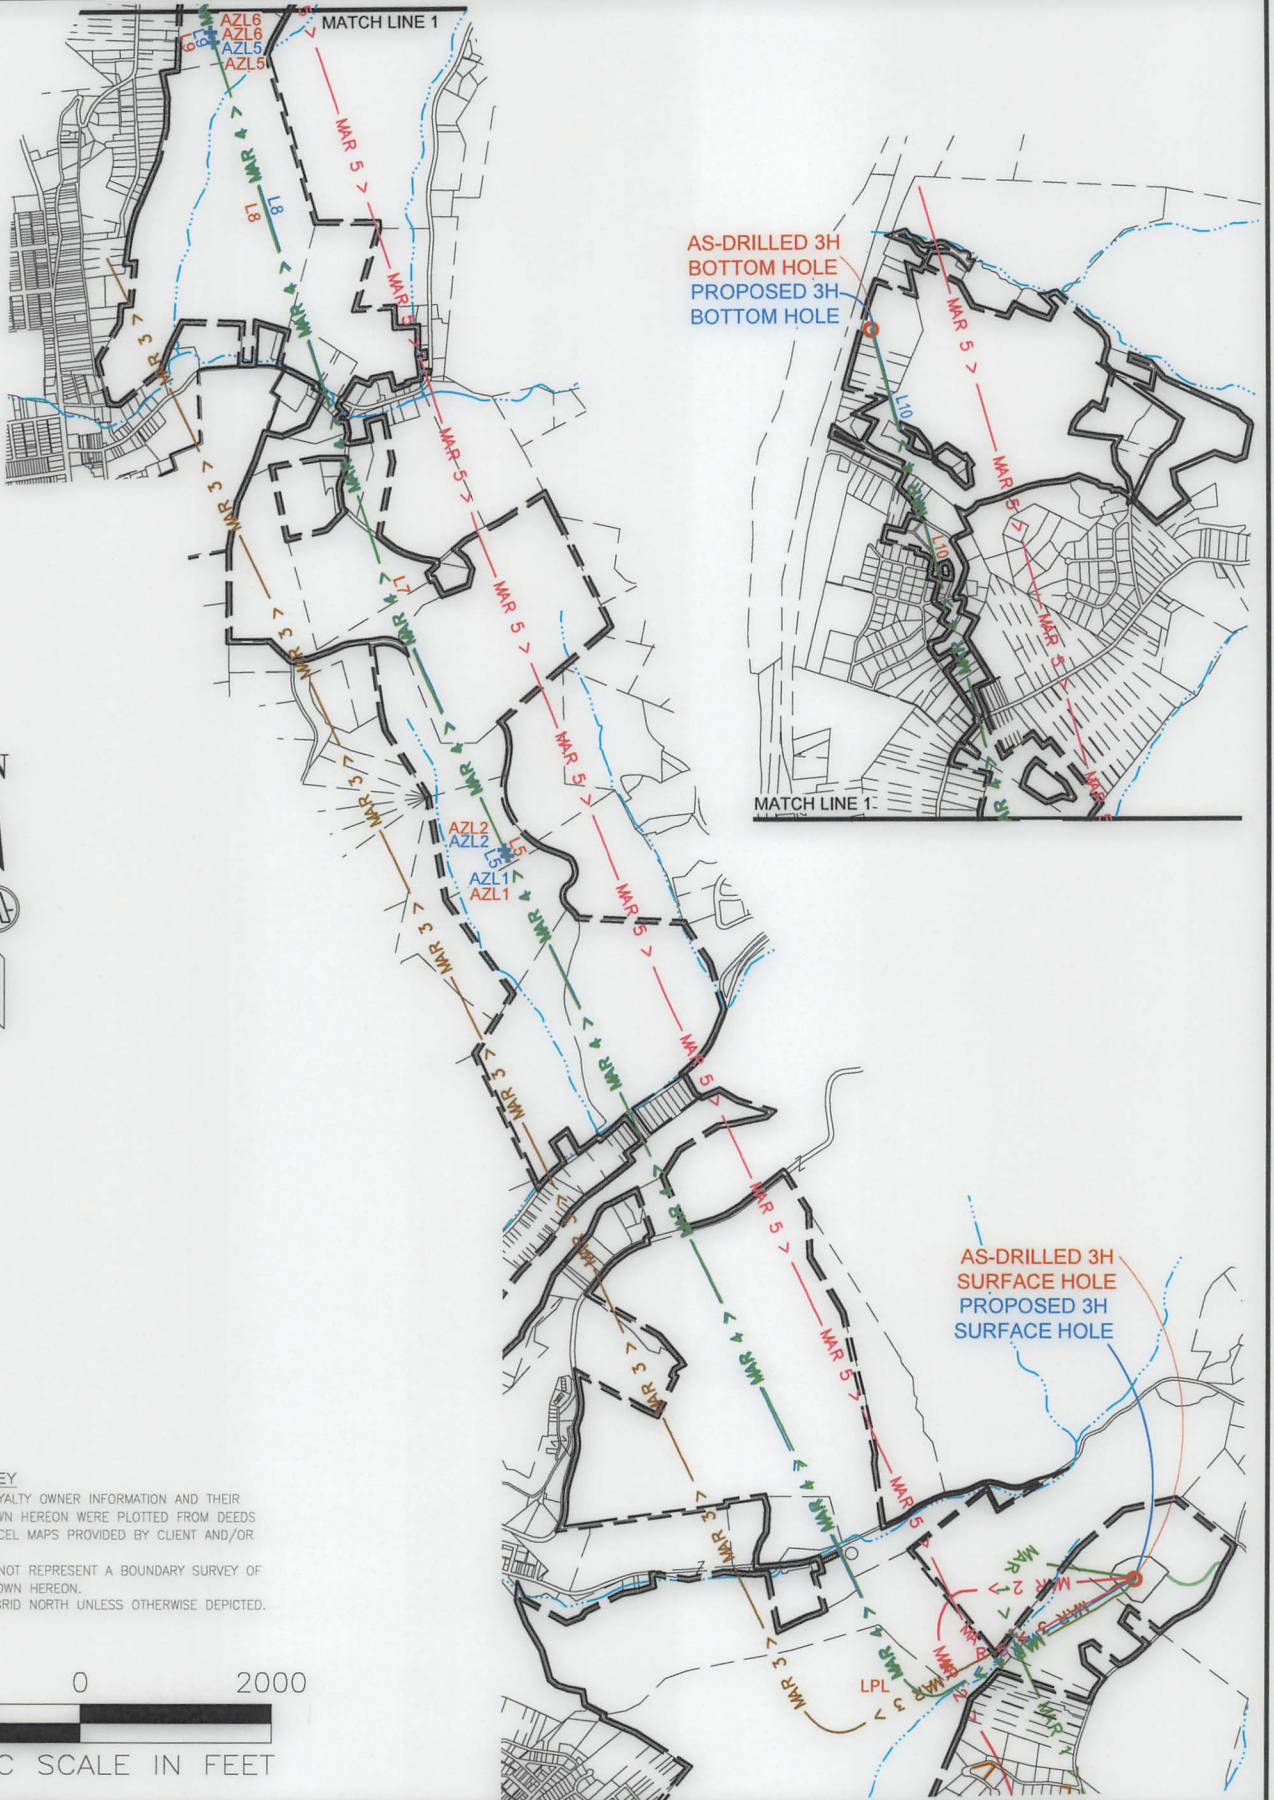

NOTES ON SURVEY

1. SURFACE AND ROYALTY OWNER INFORMATION AND THEIR BOUNDARIES SHOWN HEREON WERE PLOTTED FROM DEEDS AND/OR TAX PARCEL MAPS PROVIDED BY CLIENT AND/OR FIELD LOCATIONS.
2. THIS PLAT DOES NOT REPRESENT A BOUNDARY SURVEY OF THE PARCELS SHOWN HEREON.
4. ALL INSETS ARE GRID NORTH UNLESS OTHERWISE DEPICTED.

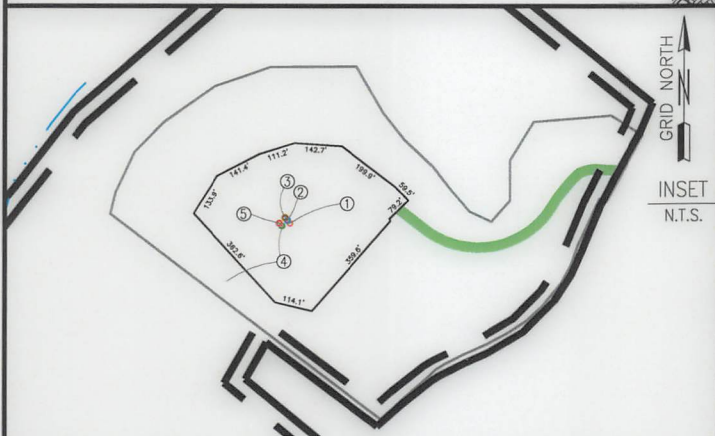

COMPANY:

expand

OPERATOR'S

SHANNON FIELDS OHI

WELL #:

3H

DISTRICT:

COUNTY:

STATE:

RICHLAND

OHIO

WEST VIRGINIA

SWN PRODUCTION COMPANY, LLC
SURFACE HOLES

1. "SHANNON FIELDS-OHI 210H"
2. "SHANNON FIELDS-OHI 10H"
3. "SHANNON FIELDS-OHI 1H"
4. "SHANNON FIELDS-OHI 3H"
5. "SHANNON FIELDS-OHI 5H"

09/26/2025

REVISIONS:

DATE: 03-31-2025


DRAWN BY: TMF
SCALE: 1" = 2500'
DRAWING NO: ACE-2326
INTERNAL WELL PLAT

S:\PROJECTS 2251-2500\PROJECT 2326 SHANNON FIELDS WELL PLAT\SURVEY\DRAWINGS\HORIZONTAL WELL PLAT\SHANNON FIELDS OHI 3H\AS-DRILLED PLAT\SHANNON FIELDS OHI 3H_ADP.DWG
MONDAY MARCH 31 2025 03:54PM

COMPLETION ID 2501189821
PAD ID 3001189761

- LEGEND:
- PROPOSED SURFACE HOLE / BOTTOM HOLE
 - EXISTING / PRODUCING WELLHEAD
 - ABANDONED WELL
 - PLUGGED & ABANDONED WELL
 - LPL LANDING POINT LOCATION
 - DRILLING UNIT
 - LEASE BOUNDARY
 - HARDLINE BOUNDARY
 - UPP 2 UPPER POINT PLEASANT PATH
 - MAR 2 MARCELLUS PATH

SURFACE HOLE LOCATION (SHL):	SURFACE HOLE LOCATION (SHL):	AZIMUTH POINT LOCATION (AZL5):	AZIMUTH POINT LOCATION (AZL5):
GEOGRAPHIC (NAD83): LATITUDE: 40.088361° LONGITUDE: -80.657858°	GEOGRAPHIC (NAD27): LATITUDE: 40.088288° LONGITUDE: -80.658058°	GEOGRAPHIC (NAD83): LATITUDE: 40.134215° LONGITUDE: -80.693380°	GEOGRAPHIC (NAD27): LATITUDE: 40.134143° LONGITUDE: -80.693579°
UTM (NAD83, ZONE 17, FEET): NORTHING: 14,559,093.470 EASTING: 1,736,110.290	UTM (NAD27, ZONE 17, FEET): NORTHING: 14,558,377.118 EASTING: 1,736,057.007	UTM (NAD83, ZONE 17, FEET): NORTHING: 14,575,754.910 EASTING: 1,726,117.480	UTM (NAD27, ZONE 17, FEET): NORTHING: 14,575,038.583 EASTING: 1,726,064.449
UTM (NAD83, ZONE 17, METERS): NORTHING: 4,437,620.565 EASTING: 529,167.475	UTM (NAD27, ZONE 17, METERS): NORTHING: 4,437,402.220 EASTING: 529,151.234	UTM (NAD83, ZONE 17, METERS): NORTHING: 4,442,698.982 EASTING: 526,121.660	UTM (NAD27, ZONE 17, METERS): NORTHING: 4,442,480.645 EASTING: 526,105.496
LANDING POINT LOCATION (LPL):	LANDING POINT LOCATION (LPL):	AZIMUTH POINT LOCATION (AZL6):	AZIMUTH POINT LOCATION (AZL6):
GEOGRAPHIC (NAD83): LATITUDE: 40.086119° LONGITUDE: -80.667416°	GEOGRAPHIC (NAD27): LATITUDE: 40.086046° LONGITUDE: -80.667616°	GEOGRAPHIC (NAD83): LATITUDE: 40.134512° LONGITUDE: -80.693492°	GEOGRAPHIC (NAD27): LATITUDE: 40.134440° LONGITUDE: -80.693690°
UTM (NAD83, ZONE 17, FEET): NORTHING: 14,558,266.880 EASTING: 1,733,440.030	UTM (NAD27, ZONE 17, FEET): NORTHING: 14,557,550.556 EASTING: 1,733,386.826	UTM (NAD83, ZONE 17, FEET): NORTHING: 14,575,862.840 EASTING: 1,726,085.920	UTM (NAD27, ZONE 17, FEET): NORTHING: 14,575,146.523 EASTING: 1,726,032.890
UTM (NAD83, ZONE 17, METERS): NORTHING: 4,437,368.620 EASTING: 528,353.578	UTM (NAD27, ZONE 17, METERS): NORTHING: 4,437,150.284 EASTING: 528,337.361	UTM (NAD83, ZONE 17, METERS): NORTHING: 4,442,731.879 EASTING: 526,112.041	UTM (NAD27, ZONE 17, METERS): NORTHING: 4,442,513.545 EASTING: 526,095.877
AZIMUTH POINT LOCATION (AZL1):	AZIMUTH POINT LOCATION (AZL1):	BOTTOM HOLE LOCATION (BHL):	BOTTOM HOLE LOCATION (BHL):
GEOGRAPHIC (NAD83): LATITUDE: 40.109921° LONGITUDE: -80.682171°	GEOGRAPHIC (NAD27): LATITUDE: 40.109849° LONGITUDE: -80.682369°	GEOGRAPHIC (NAD83): LATITUDE: 40.149658° LONGITUDE: -80.698772°	GEOGRAPHIC (NAD27): LATITUDE: 40.149587° LONGITUDE: -80.698970°
UTM (NAD83, ZONE 17, FEET): NORTHING: 14,566,919.360 EASTING: 1,729,282.260	UTM (NAD27, ZONE 17, FEET): NORTHING: 14,566,203.041 EASTING: 1,729,229.158	UTM (NAD83, ZONE 17, FEET): NORTHING: 14,581,373.451 EASTING: 1,724,591.349	UTM (NAD27, ZONE 17, FEET): NORTHING: 14,580,657.113 EASTING: 1,724,538.349
UTM (NAD83, ZONE 17, METERS): NORTHING: 4,440,005.901 EASTING: 527,086.287	UTM (NAD27, ZONE 17, METERS): NORTHING: 4,439,787.566 EASTING: 527,070.101	UTM (NAD83, ZONE 17, METERS): NORTHING: 4,444,411.517 EASTING: 525,656.495	UTM (NAD27, ZONE 17, METERS): NORTHING: 4,444,193.176 EASTING: 525,640.340
AZIMUTH POINT LOCATION (AZL2):	AZIMUTH POINT LOCATION (AZL2):		
GEOGRAPHIC (NAD83): LATITUDE: 40.110102° LONGITUDE: -80.682279°	GEOGRAPHIC (NAD27): LATITUDE: 40.110030° LONGITUDE: -80.682478°		
UTM (NAD83, ZONE 17, FEET): NORTHING: 14,566,985.260 EASTING: 1,729,251.620	UTM (NAD27, ZONE 17, FEET): NORTHING: 14,566,268.941 EASTING: 1,729,198.519		
UTM (NAD83, ZONE 17, METERS): NORTHING: 4,440,025.987 EASTING: 527,076.948	UTM (NAD27, ZONE 17, METERS): NORTHING: 4,439,807.653 EASTING: 527,060.763		
AZIMUTH POINT LOCATION (AZL3):	AZIMUTH POINT LOCATION (AZL3):		
GEOGRAPHIC (NAD83): LATITUDE: 40.117408° LONGITUDE: -80.686517°	GEOGRAPHIC (NAD27): LATITUDE: 40.117336° LONGITUDE: -80.686716°		
UTM (NAD83, ZONE 17, FEET): NORTHING: 14,569,641.360 EASTING: 1,728,057.280	UTM (NAD27, ZONE 17, FEET): NORTHING: 14,568,925.041 EASTING: 1,728,004.208		
UTM (NAD83, ZONE 17, METERS): NORTHING: 4,440,835.568 EASTING: 526,712.912	UTM (NAD27, ZONE 17, METERS): NORTHING: 4,440,617.234 EASTING: 526,696.736		
AZIMUTH POINT LOCATION (AZL4):	AZIMUTH POINT LOCATION (AZL4):		
GEOGRAPHIC (NAD83): LATITUDE: 40.118279° LONGITUDE: -80.686944°	GEOGRAPHIC (NAD27): LATITUDE: 40.118207° LONGITUDE: -80.687142°		
UTM (NAD83, ZONE 17, FEET): NORTHING: 14,569,958.210 EASTING: 1,727,936.810	UTM (NAD27, ZONE 17, FEET): NORTHING: 14,569,241.891 EASTING: 1,727,883.740		
UTM (NAD83, ZONE 17, METERS): NORTHING: 4,440,932.144 EASTING: 526,676.193	UTM (NAD27, ZONE 17, METERS): NORTHING: 4,440,713.810 EASTING: 526,660.017		

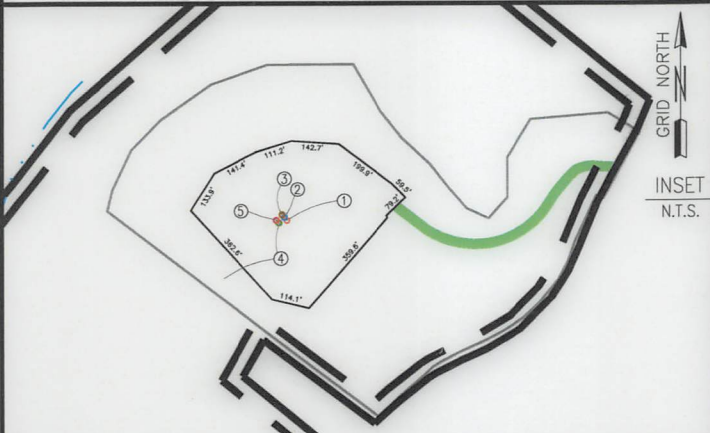

NOTE: ANY UTILITIES OR IMPROVEMENTS SHOWN ON THIS PLAT ARE FROM REASONABLE VISUAL OBSERVATIONS. NO UTILITY COMPANIES WERE CONTACTED FOR UTILITY LINE LOCATIONS.


LEGEND:	
PROPOSED SURFACE HOLE / BOTTOM HOLE	DRILLING UNIT
EXISTING / PRODUCING WELLHEAD	LEASE BOUNDARY
ABANDONED WELL	HARDLINE BOUNDARY
PLUGGED & ABANDONED WELL	UPP 2 > - UPPER POINT PLEASANT PATH
LANDING POINT LOCATION	MAR 2 > - MARCELLUS PATH

COMPANY:		
OPERATOR'S		
SHANNON FIELDS OHI		
WELL #:		
3H		
DISTRICT:	COUNTY:	STATE:
RICHLAND	OHIO	WEST VIRGINIA
SWN PRODUCTION COMPANY, LLC		
SURFACE HOLES		
1. "SHANNON FIELDS-OHI 210H"		
2. "SHANNON FIELDS-OHI 10H"		
3. "SHANNON FIELDS-OHI 1H"		
4. "SHANNON FIELDS-OHI 3H"		
5. "SHANNON FIELDS-OHI 5H"		
09/26/2025		
REVISIONS:		DATE: 03-31-2025
		DRAWN BY: TMF
		SCALE: 1" = 2500'
		DRAWING NO: ACE-2326
		INTERNAL WELL PLAT



SURVEYOR/ENGINEER:
1700 ANMOORE ROAD
BRIDGEPORT, WV 26330
1-304-933-3463

SURFACE HOLE LOCATION (SHL):	AZIMUTH POINT LOCATION (AZL3):	BOTTOM HOLE LOCATION (BHL):
GEOGRAPHIC (NAD83): LATITUDE: 40.088361° LONGITUDE: -80.657858°	GEOGRAPHIC (NAD83): LATITUDE: 40.117360° LONGITUDE: -80.686495°	GEOGRAPHIC (NAD83): LATITUDE: 40.149637° LONGITUDE: -80.698841°
UTM (NAD83, ZONE 17, FEET): NORTHING: 14,559,093.460 EASTING: 1,736,110.240	UTM (NAD83, ZONE 17, FEET): NORTHING: 14,569,624.040 EASTING: 1,728,063.640	UTM (NAD83, ZONE 17, FEET): NORTHING: 14,581,365.730 EASTING: 1,724,572.260
UTM (NAD83, ZONE 17, METERS): NORTHING: 4,437,620.562 EASTING: 529,167.459	UTM (NAD83, ZONE 17, METERS): NORTHING: 4,440,830.289 EASTING: 526,714.851	UTM (NAD83, ZONE 17, METERS): NORTHING: 4,444,409.163 EASTING: 525,650.676
SPCS, WV NORTH (NAD83): NORTHING: 580,628.737 EASTING: 1,644,547.060	SPCS, WV NORTH (NAD83): NORTHING: 591,296.385 EASTING: 1,636,674.912	SPCS, WV NORTH (NAD83): NORTHING: 603,099.235 EASTING: 1,633,379.265
GEOGRAPHIC (NAD27): LATITUDE: 40.088288° LONGITUDE: -80.658058°	GEOGRAPHIC (NAD27): LATITUDE: 40.117288° LONGITUDE: -80.686693°	GEOGRAPHIC (NAD27): LATITUDE: 40.149566° LONGITUDE: -80.699039°
SPCS, WV NORTH (NAD27): NORTHING: 580,591.982 EASTING: 1,675,982.270	SPCS, WV NORTH (NAD27): NORTHING: 591,259.660 EASTING: 1,668,110.333	SPCS, WV NORTH (NAD27): NORTHING: 603,062.491 EASTING: 1,664,814.757
LANDING POINT LOCATION (LPL):	AZIMUTH POINT LOCATION (AZL4):	
GEOGRAPHIC (NAD83): LATITUDE: 40.086179° LONGITUDE: -80.667407°	GEOGRAPHIC (NAD83): LATITUDE: 40.118068° LONGITUDE: -80.686836°	
UTM (NAD83, ZONE 17, FEET): NORTHING: 14,558,288.850 EASTING: 1,733,442.610	UTM (NAD83, ZONE 17, FEET): NORTHING: 14,569,881.450 EASTING: 1,727,967.400	
UTM (NAD83, ZONE 17, METERS): NORTHING: 4,437,375.316 EASTING: 528,354.364	UTM (NAD83, ZONE 17, METERS): NORTHING: 4,440,908.748 EASTING: 526,685.517	
SPCS, WV NORTH (NAD83): NORTHING: 579,868.600 EASTING: 1,641,865.367	SPCS, WV NORTH (NAD83): NORTHING: 591,555.465 EASTING: 1,636,582.959	
GEOGRAPHIC (NAD27): LATITUDE: 40.086106° LONGITUDE: -80.667606°	GEOGRAPHIC (NAD27): LATITUDE: 40.117996° LONGITUDE: -80.687034°	
SPCS, WV NORTH (NAD27): NORTHING: 579,831.872 EASTING: 1,673,300.657	SPCS, WV NORTH (NAD27): NORTHING: 591,518.739 EASTING: 1,668,018.381	
AZIMUTH POINT LOCATION (AZL1):	AZIMUTH POINT LOCATION (AZL5):	
GEOGRAPHIC (NAD83): LATITUDE: 40.109785° LONGITUDE: -80.682079°	GEOGRAPHIC (NAD83): LATITUDE: 40.134188° LONGITUDE: -80.693338°	
UTM (NAD83, ZONE 17, FEET): NORTHING: 14,566,870.010 EASTING: 1,729,307.940	UTM (NAD83, ZONE 17, FEET): NORTHING: 14,575,745.020 EASTING: 1,726,129.490	
UTM (NAD83, ZONE 17, METERS): NORTHING: 4,439,990.859 EASTING: 527,094.114	UTM (NAD83, ZONE 17, METERS): NORTHING: 4,442,695.967 EASTING: 526,125.321	
SPCS, WV NORTH (NAD83): NORTHING: 588,520.899 EASTING: 1,637,873.398	SPCS, WV NORTH (NAD83): NORTHING: 597,451.149 EASTING: 1,634,842.773	
GEOGRAPHIC (NAD27): LATITUDE: 40.109713° LONGITUDE: -80.682278°	GEOGRAPHIC (NAD27): LATITUDE: 40.134116° LONGITUDE: -80.693536°	
SPCS, WV NORTH (NAD27): NORTHING: 588,484.175 EASTING: 1,669,308.789	SPCS, WV NORTH (NAD27): NORTHING: 597,414.415 EASTING: 1,666,278.234	
AZIMUTH POINT LOCATION (AZL2):	AZIMUTH POINT LOCATION (AZL6):	
GEOGRAPHIC (NAD83): LATITUDE: 40.110244° LONGITUDE: -80.682354°	GEOGRAPHIC (NAD83): LATITUDE: 40.134692° LONGITUDE: -80.693523°	
UTM (NAD83, ZONE 17, FEET): NORTHING: 14,567,036.880 EASTING: 1,729,230.610	UTM (NAD83, ZONE 17, FEET): NORTHING: 14,575,928.620 EASTING: 1,726,077.170	
UTM (NAD83, ZONE 17, METERS): NORTHING: 4,440,041.721 EASTING: 527,070.544	UTM (NAD83, ZONE 17, METERS): NORTHING: 4,442,751.929 EASTING: 526,109.374	
SPCS, WV NORTH (NAD83): NORTHING: 588,689.102 EASTING: 1,637,798.844	SPCS, WV NORTH (NAD83): NORTHING: 597,635.667 EASTING: 1,634,793.514	
GEOGRAPHIC (NAD27): LATITUDE: 40.110172° LONGITUDE: -80.682553°	GEOGRAPHIC (NAD27): LATITUDE: 40.134620° LONGITUDE: -80.693721°	
SPCS, WV NORTH (NAD27): NORTHING: 588,652.377 EASTING: 1,669,234.237	SPCS, WV NORTH (NAD27): NORTHING: 597,598.933 EASTING: 1,666,228.976	

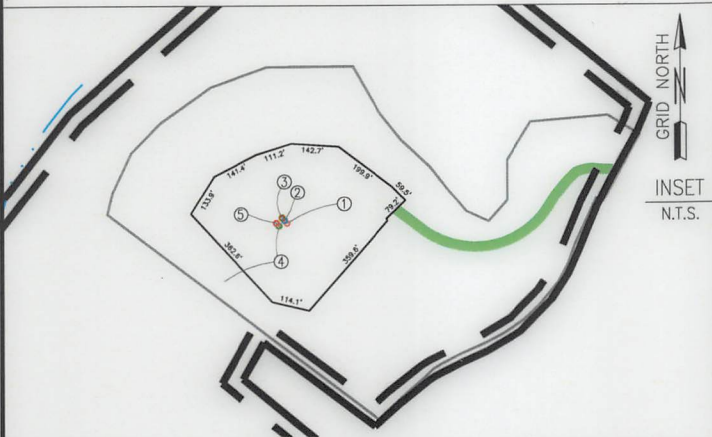

NOTE: ANY UTILITIES OR IMPROVEMENTS SHOWN ON THIS PLAT ARE FROM REASONABLE VISUAL OBSERVATIONS. NO UTILITY COMPANIES WERE CONTACTED FOR UTILITY LINE LOCATIONS.

LEGEND:

- PROPOSED SURFACE HOLE / BOTTOM HOLE
- EXISTING / PRODUCING WELLHEAD
- ABANDONED WELL
- PLUGGED & ABANDONED WELL
- LPL* LANDING POINT LOCATION
- DRILLING UNIT
- LEASE BOUNDARY
- HARDLINE BOUNDARY
- UPP 2 > UPPER POINT PLEASANT PATH
- MAR 2 > MARCELLUS PATH

COMPANY:



OPERATOR'S

SHANNON FIELDS OHI

WELL #:

3H

DISTRICT:

COUNTY:

STATE:

RICHLAND

OHIO

WEST VIRGINIA

SWN PRODUCTION COMPANY, LLC
SURFACE HOLES

- 1. "SHANNON FIELDS-OHI 210H"
- 2. "SHANNON FIELDS-OHI 10H"
- 3. "SHANNON FIELDS-OHI 1H"
- 4. "SHANNON FIELDS-OHI 3H"
- 5. "SHANNON FIELDS-OHI 5H"

09/26/2025

REVISIONS:

DATE: 03-31-2025

DRAWN BY: TMF

SCALE: 1" = 2500'

DRAWING NO: ACE-2326

INTERNAL WELL PLAT