



SURVEYOR/ENGINEER: 1-304-933-3463
1700 ANMOORE RD,
BRIDGEPORT, WV 26330

UTM (NAD83, ZONE 17, METERS):
NORTHING: 4,437,623.662
EASTING: 529,164.539

UTM (NAD83, ZONE 17, METERS):
NORTHING: 4,437,523.983
EASTING: 528,578.743

UTM (NAD83, ZONE 17, METERS):
NORTHING: 4,444,878.556
EASTING: 525,813.827

UTM (NAD83, ZONE 17, METERS):
NORTHING: 4,437,534.450
EASTING: 529,164.521

UTM (NAD83, ZONE 17, METERS):
NORTHING: 4,437,534.450
EASTING: 528,580.090

UTM (NAD83, ZONE 17, METERS):
NORTHING: 4,444,880.525
EASTING: 525,819.502

GRID NORTH
UTM, NAD83 DATUM, ZONE 17, US FT

WELL RESTRICTIONS

1. NO OCCUPIED DWELLINGS > 2500 SQ. FT. WITHIN 625 FEET OF CENTER OF PAD.
2. NO AGRICULTURE BUILDINGS > 2500 SQ. FT. WITHIN 625 FEET OF CENTER OF PAD.
3. NO WATER WELLS OR DEVELOPED SPRINGS ARE WITHIN 250 FEET OF PROPOSED WELL.
4. NO PERENNIAL STREAMS, LAKES, PONDS, OR RESERVOIRS WITHIN 100 FEET OF THE LIMITS OF DISTURBANCE.
5. NO NATURALLY PRODUCING TROUT STREAM WITHIN 100 FEET OF LIMITS OF DISTURBANCE.
6. NO GROUND INTAKE OR PUBLIC WATER SUPPLY WITHIN 1000 FEET OF WELL PAD, LIMITS OF DISTURBANCE, E & S CONTROLS OR PUBLIC WATER SUPPLY.

NOTES ON SURVEY

1. SURFACE AND ROYALTY OWNER INFORMATION AND THEIR BOUNDARIES SHOWN HEREON WERE PLOTTED FROM DEEDS AND/OR TAX PARCEL MAPS PROVIDED BY CLIENT AND/OR FIELD LOCATIONS.
2. THIS PLAT DOES NOT REPRESENT A BOUNDARY SURVEY OF THE PARCELS SHOWN HEREON.
4. ALL INSETS ARE GRID NORTH UNLESS OTHERWISE DEPICTED.

I, THE UNDERSIGNED, HEREBY CERTIFY THAT THIS PLAT IS CORRECT TO THE BEST OF MY KNOWLEDGE AND BELIEF AND SHOWS ALL THE INFORMATION REQUIRED BY LAW AND REGULATIONS ISSUED AND PRESCRIBED BY THE DEPARTMENT OF ENVIRONMENTAL PROTECTION.





P.S. 983

LATITUDE: 40°07'30" | SURFACE HOLE 9,201'
LATITUDE: 40°10'00" | BOTTOM HOLE 8,432'

L1	N 75°39'54" W	731.48'	SHL TO MONUMENT	STONE
L2	N 28°18'03" E	974.63'	SHL TO MONUMENT	CONCRETE MONUMENT
L1	N 75°38'44" W	731.48'	SHL TO MONUMENT	STONE
L2	N 28°17'50" E	974.87'	SHL TO MONUMENT	CONCRETE MONUMENT

L3	S 80°20'35" W	1,949.53'	2,362.87'	SHL TO LPL
L4	N 25°36'35" W	7,298.17'	7,298.17'	LPL TO AZL1
L5	N 23°50'01" W	177.46'	177.48'	AZL1 TO AZL2
L6	N 22°03'29" W	5,156.45'	5,156.45'	AZL2 TO AZL3
L7	N 20°09'27" W	189.99'	190.02'	AZL3 TO AZL4
L8	N 18°15'21" W	6,448.21'	6,448.21'	AZL4 TO AZL5
L9	N 17°11'04" W	107.23'	107.23'	AZL5 TO AZL6
L10	N 16°06'37" W	6,455.68'	6,455.68'	AZL6 TO BHL

L3	S 81°19'41" W	1,939.59'	2,409.71'	SHL TO LPL
L4	N 25°40'22" W	7,236.77'	7,236.77'	LPL TO AZL1
L5	N 23°12'35" W	274.85'	274.88'	AZL1 TO AZL2
L6	N 22°00'42" W	5,127.82'	5,127.82'	AZL2 TO AZL3
L7	N 20°21'30" W	183.91'	183.92'	AZL3 TO AZL4
L8	N 18°15'57" W	6,409.43'	6,409.43'	AZL4 TO AZL5
L9	N 17°31'11" W	182.90'	182.91'	AZL5 TO AZL6
L10	N 16°01'46" W	6,387.25'	6,387.25'	AZL6 TO BHL

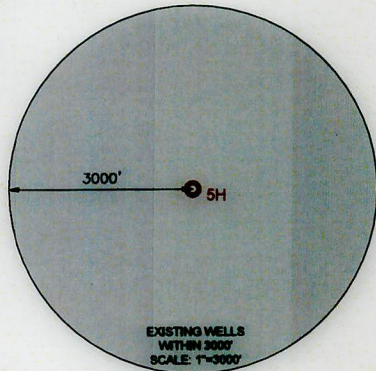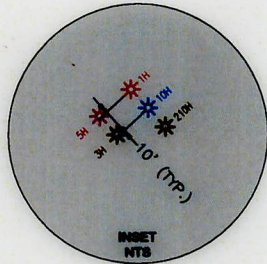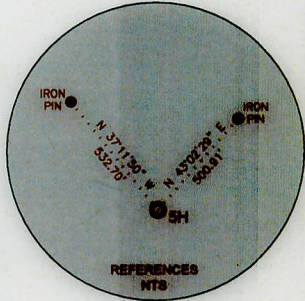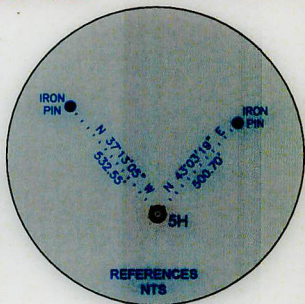

2000' 0 2000'
GRAPHIC SCALE IN FEET

COMPANY:

expand



(+) DENOTES LOCATION OF WELL ON UNITED STATES TOPOGRAPHIC MAPS
WVDEP
OFFICE OF OIL & GAS
601 57TH STREET
CHARLESTON, WV 25034

MINIMUM DEGREE OF ACCURACY: 1/200
PROVEN SOURCE OF ELEVATION: SURVEY GRADE GPS (NAVD 88, US FT)

SHANNON FIELDS OHI
OPERATOR'S WELL #: 5H
API WELL #: 47 69 00376
STATE COUNTY PERMIT


WELL TYPE: OIL ☐ WASTE DISPOSAL ☐ PRODUCTION ☒ DEEP ☒ GAS ☒ LIQUID INJECTION ☐ STORAGE ☐ SHALLOW ☐
WATERSHED: UPPER OHIO SOUTH ELEVATION: 1235.90
DISTRICT: RICHLAND COUNTY: OHIO QUADRANGLE: WHEELING 7.5', WV
SURFACE OWNER: SWN PRODUCTION COMPANY, LLC ACREAGE: ±35.07
OIL & GAS ROYALTY OWNER: SHANNON FIELDS, LLC ACREAGE: ±35.07
DRILL ☒ DRILL DEEPER ☐ REDRILL ☐ FRACTURE OR STIMULATE ☒ PLUG OFF OLD FORMATION ☐ PERFORATE NEW FORMATION ☐
CONVERT ☐ PLUG & ABANDON ☐ CLEAN OUT & REPLUG ☐ OTHER CHANGE ☒ (SPECIFY) AS-DRILLED
TARGET FORMATION: MARCELLUS ESTIMATED DEPTH: 6,077' TVD, 32,648' TMD

WELL OPERATOR: EXPAND OPERATING, LLC DESIGNATED AGENT: BRITTANY WOODY
ADDRESS: 1300 FORT PIERPONT DRIVE, SUITE 201 ADDRESS: 1300 FORT PIERPONT DRIVE, SUITE 201
CITY: MORGANTOWN STATE: WV ZIP CODE: 26508 CITY: MORGANTOWN STATE: WV ZIP CODE: 26508


LEGEND:
○ PROPOSED SURFACE HOLE / BOTTOM HOLE
* EXISTING / PRODUCING WELLHEAD
LPL LANDING POINT LOCATION
W EXISTING WATER WELL
S EXISTING SPRING
— SURVEYED BOUNDARY
— DRILLING UNIT
— LEASE BOUNDARY
— PROPOSED PATH
REVISIONS:
DATE: 03-31-2025
DRAWN BY: TMF
SCALE: 1" = 2000'
DRAWING NO: ACE-2326
WELL LOCATION PLAT 1



SURVEYOR/ENGINEER:
1700 ANMOORE ROAD
BRIDGEPORT, WV 26330
1-304-933-3463

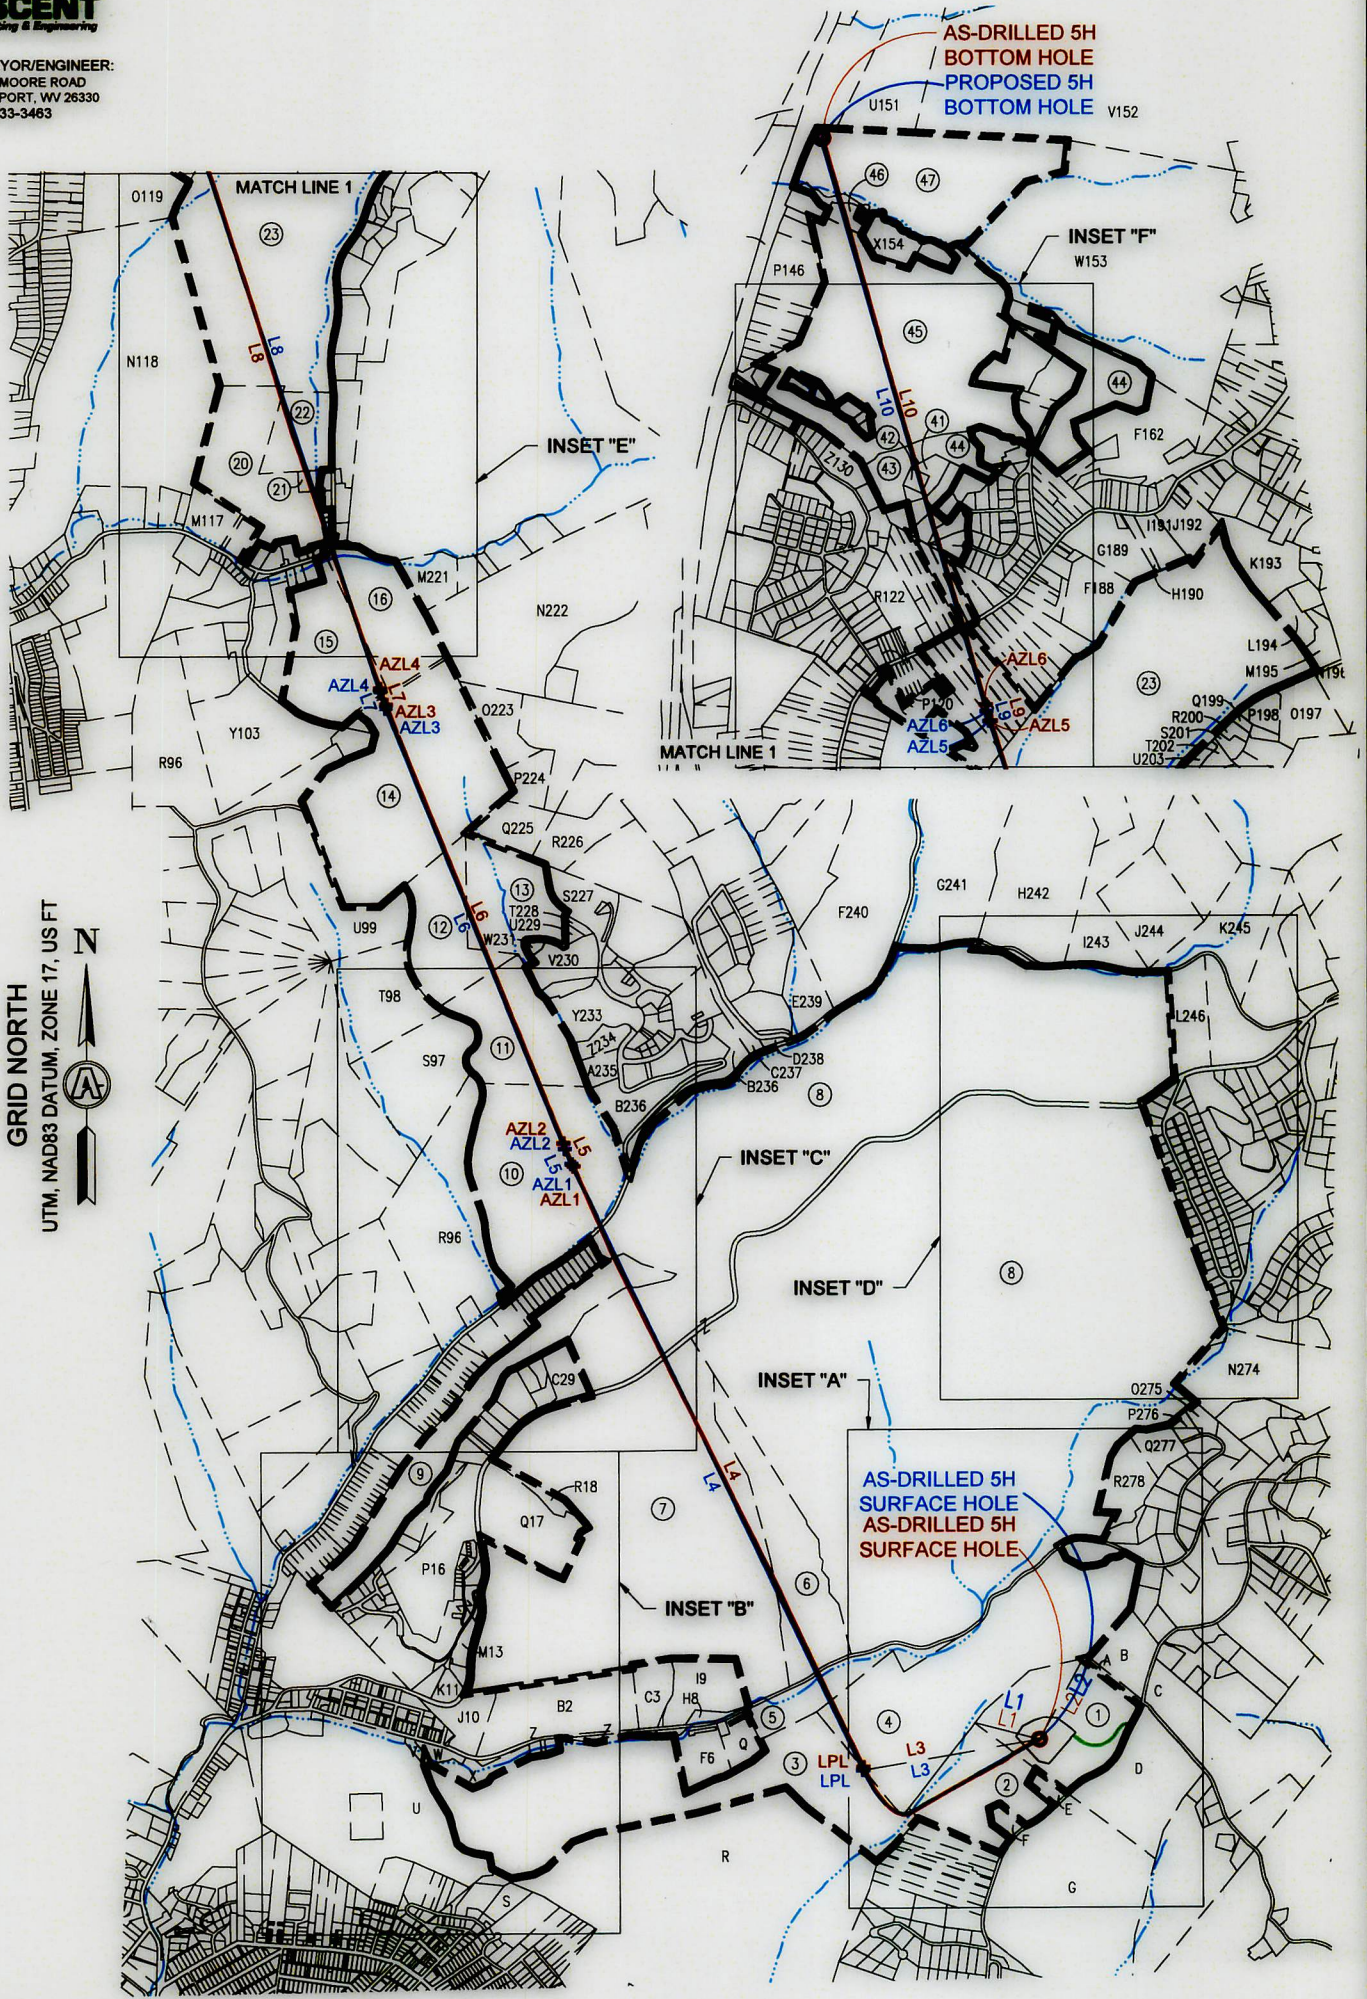

GRID NORTH
UTM, NAD83 DATUM, ZONE 17, US FT

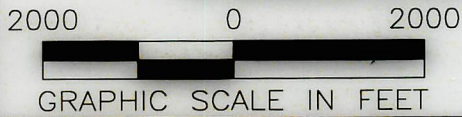


09/26/2025

REVISIONS:		COMPANY:			
		OPERATOR'S		SHANNON FIELDS OHI	
		WELL #:		5H	
		DISTRICT:		COUNTY:	
		RICHLAND		OHIO	
				STATE:	
				WV	
				DATE: 03-31-2025	
				DRAWN BY: TMF	
				SCALE: N/A	
				DRAWING NO: ACE-2326	
				WELL LOCATION PLAT	



SURVEYOR/ENGINEER:
1700 ANMOORE ROAD
BRIDGEPORT, WV 26330
1-304-933-3463

GRID NORTH
UTM, NAD83 DATUM, ZONE 17, US FT

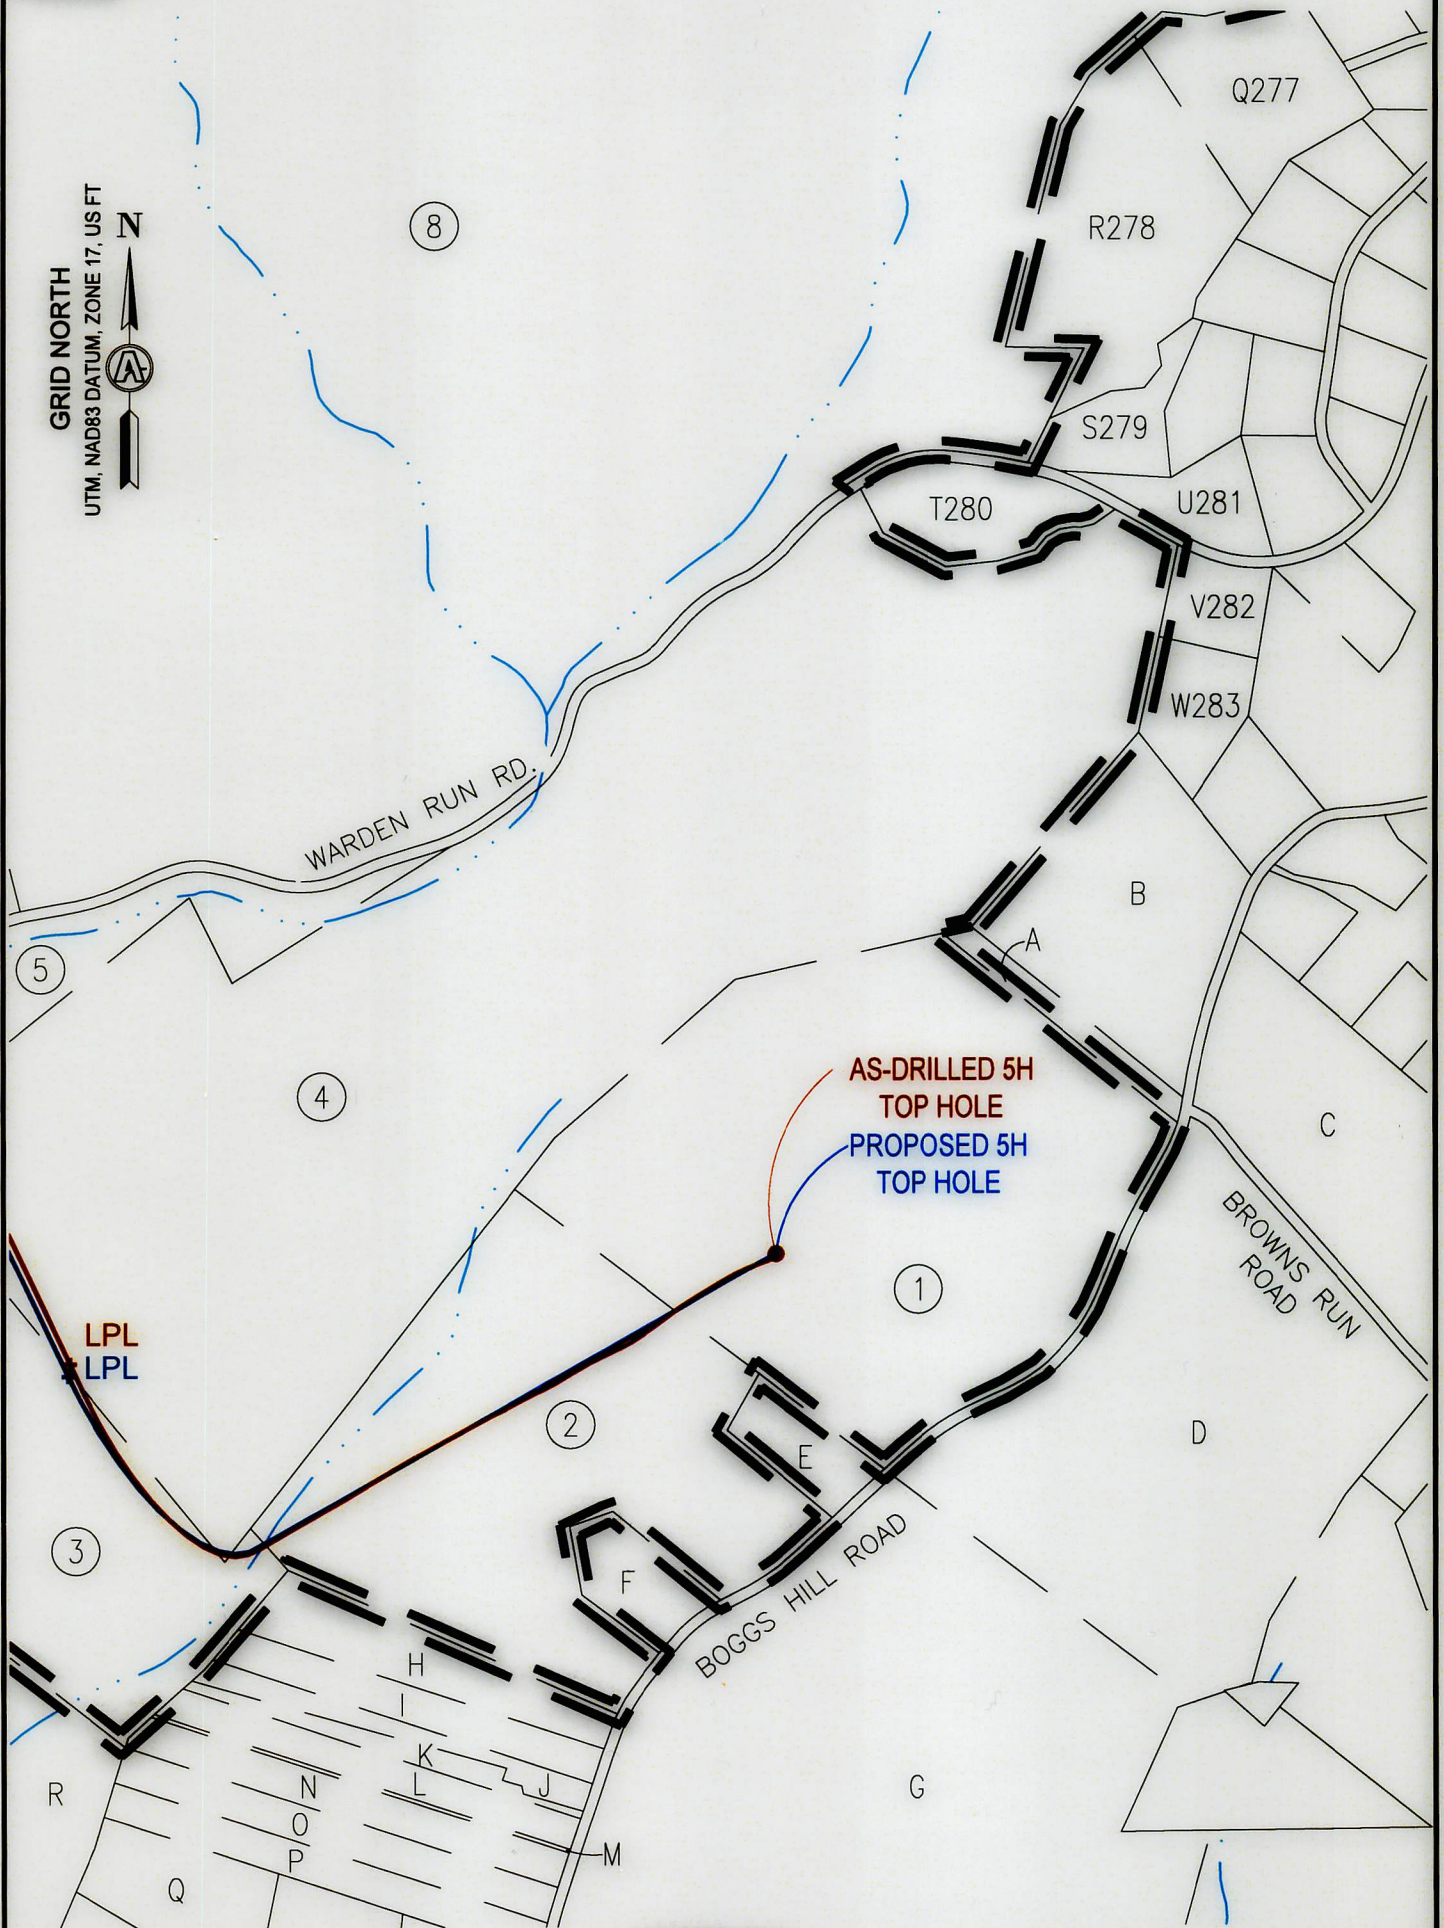

INSET "A"
SCALE: 1"=500'

09/26/2025

REVISIONS:

COMPANY:

expand

OPERATOR'S

SHANNON FIELDS OHI

DATE: 03-31-2025

WELL #:

5H



DRAWN BY: TMF

DISTRICT:
RICHLAND

COUNTY:
OHIO

STATE:
WV

SCALE: N/A
DRAWING NO: ACE-2326
WELL LOCATION PLAT

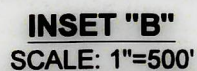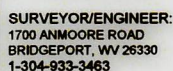


09/26/2025

REVISIONS: 	COMPANY: 			03/31/2025
	OPERATOR'S SHANNON FIELDS OHI			DATE: 03-31-2025
	WELL #: 5H			DRAWN BY: TMF
	DISTRICT: RICHLAND	COUNTY: OHIO	STATE: WV	SCALE: N/A DRAWING NO: ACE-2326 WELL LOCATION PLAT



SURVEYOR/ENGINEER:
1700 ANMOORE ROAD
BRIDGEPORT, WV 26330
1-304-933-3463

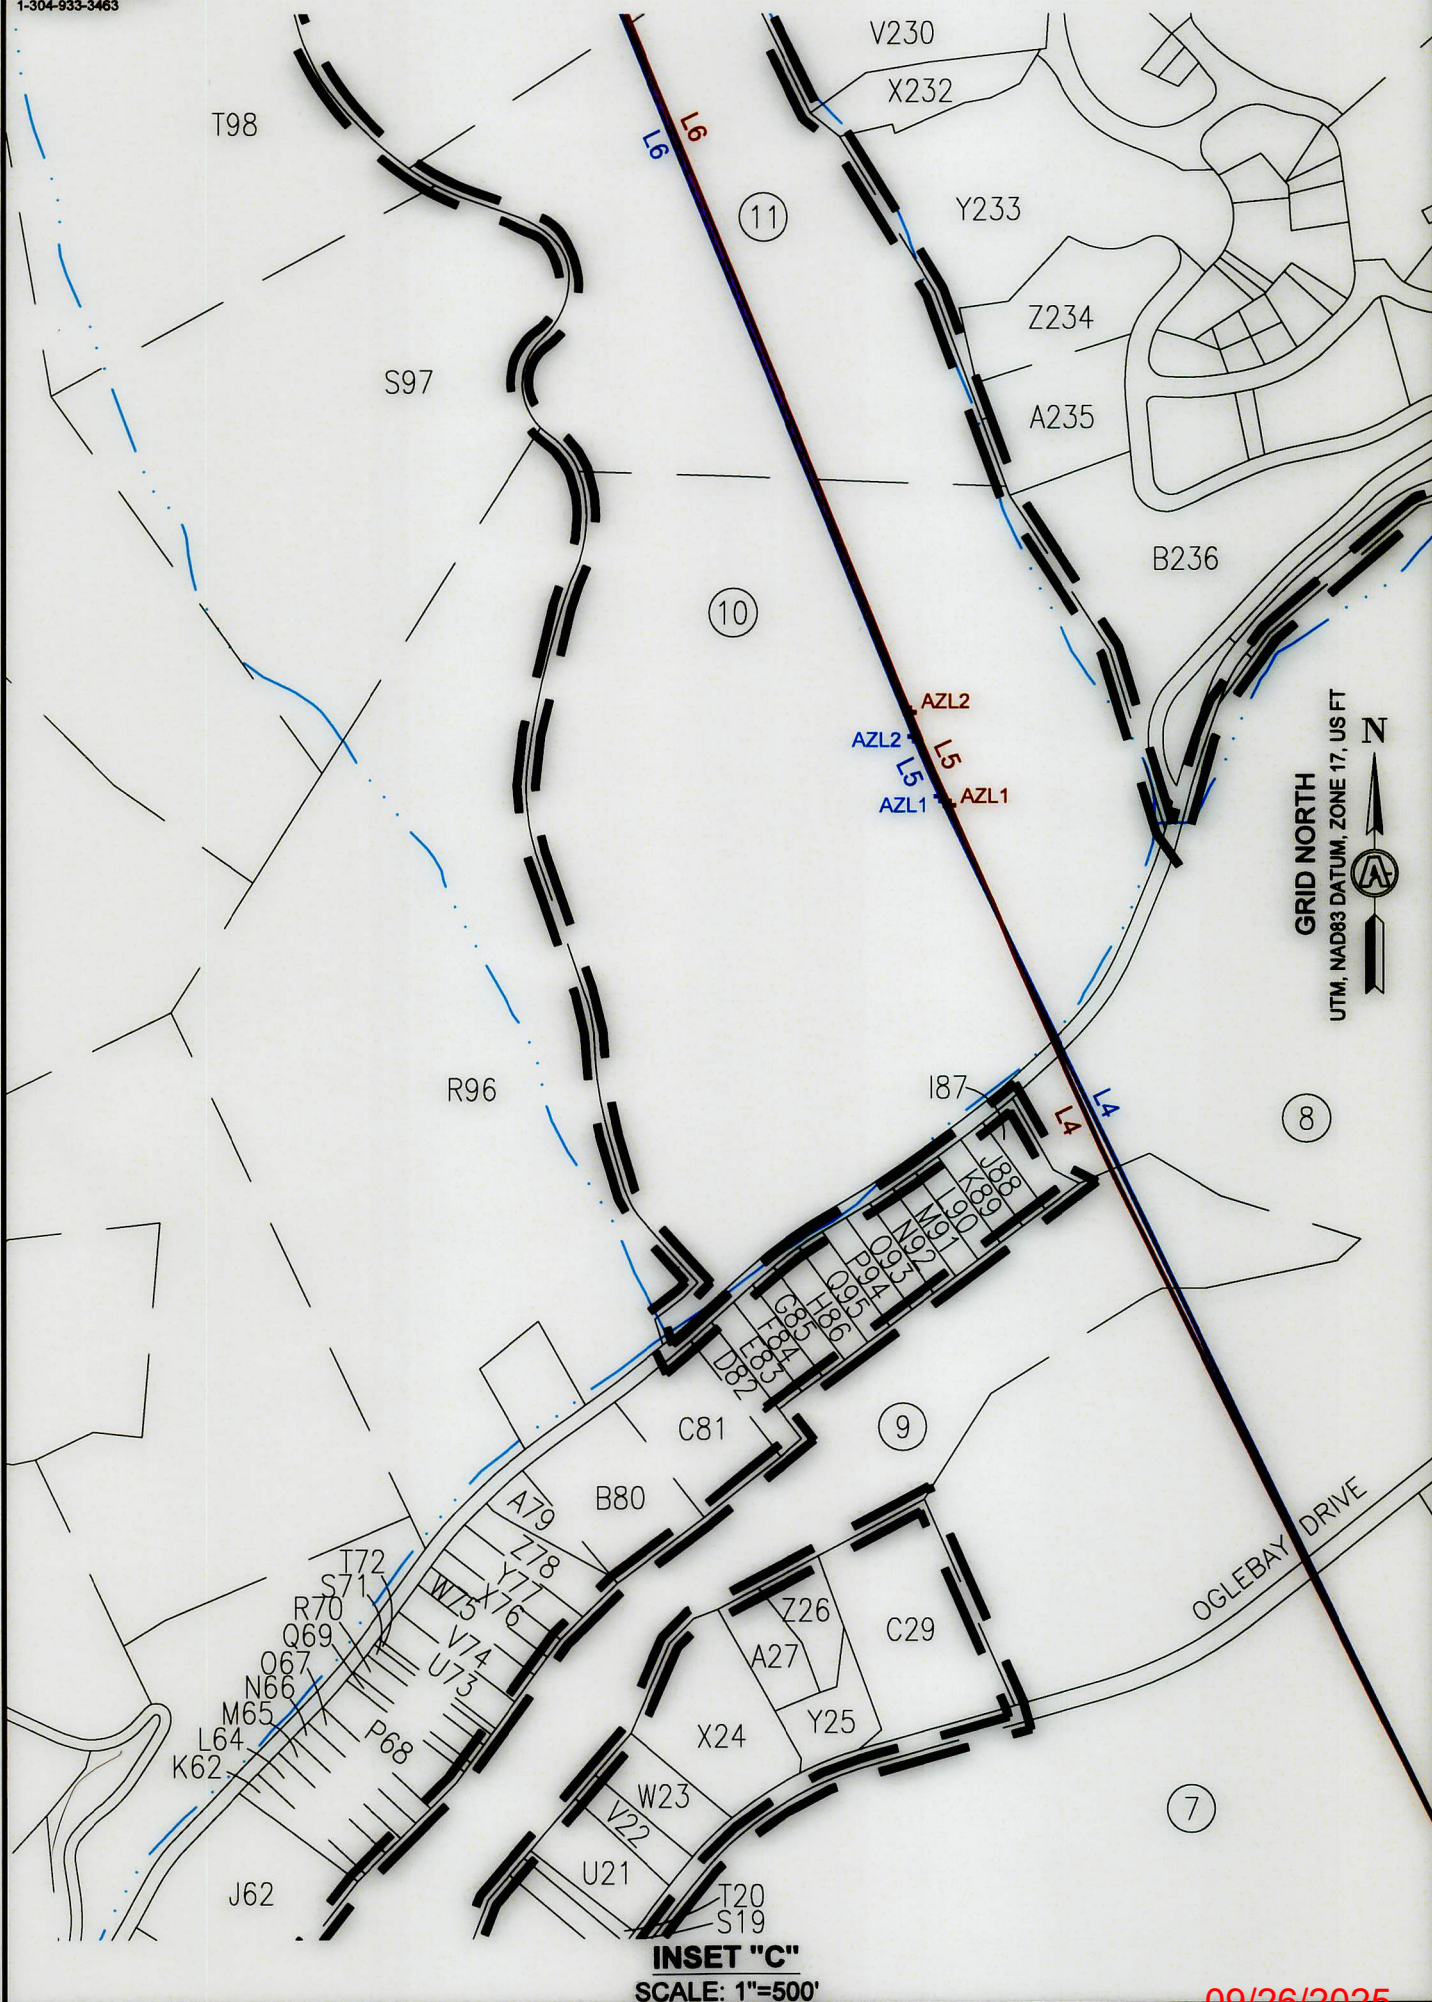

INSET "C"
SCALE: 1"=500'

09/26/2025

REVISIONS:			COMPANY:			
			OPERATOR'S		SHANNON FIELDS OHI	
			WELL #:		5H	
			DISTRICT:		COUNTY:	STATE:
			RICHLAND		OHIO	WV
					DATE: 03-31-2025	
					DRAWN BY: TMF	
					SCALE: N/A	
					DRAWING NO: ACE-2326	
					WELL LOCATION PLAT	



SURVEYOR/ENGINEER:
1700 ANMOORE ROAD
BRIDGEPORT, WV 26330
1-304-933-3463

GRID NORTH
UTM, NAD83 DATUM, ZONE 17, US FT



INSET "D"
SCALE: 1"=500'

09/26/2025

REVISIONS:

COMPANY:

expand

OPERATOR'S

SHANNON FIELDS OHI

DATE: 03-31-2025

WELL #:

5H

DRAWN BY: TMF

DISTRICT:
RICHLAND


COUNTY:
OHIO

STATE:
WV

SCALE: N/A
DRAWING NO: ACE-2326
WELL LOCATION PLAT



GRID NORTH
UTM, NAD83 DATUM, ZONE 17, US FT

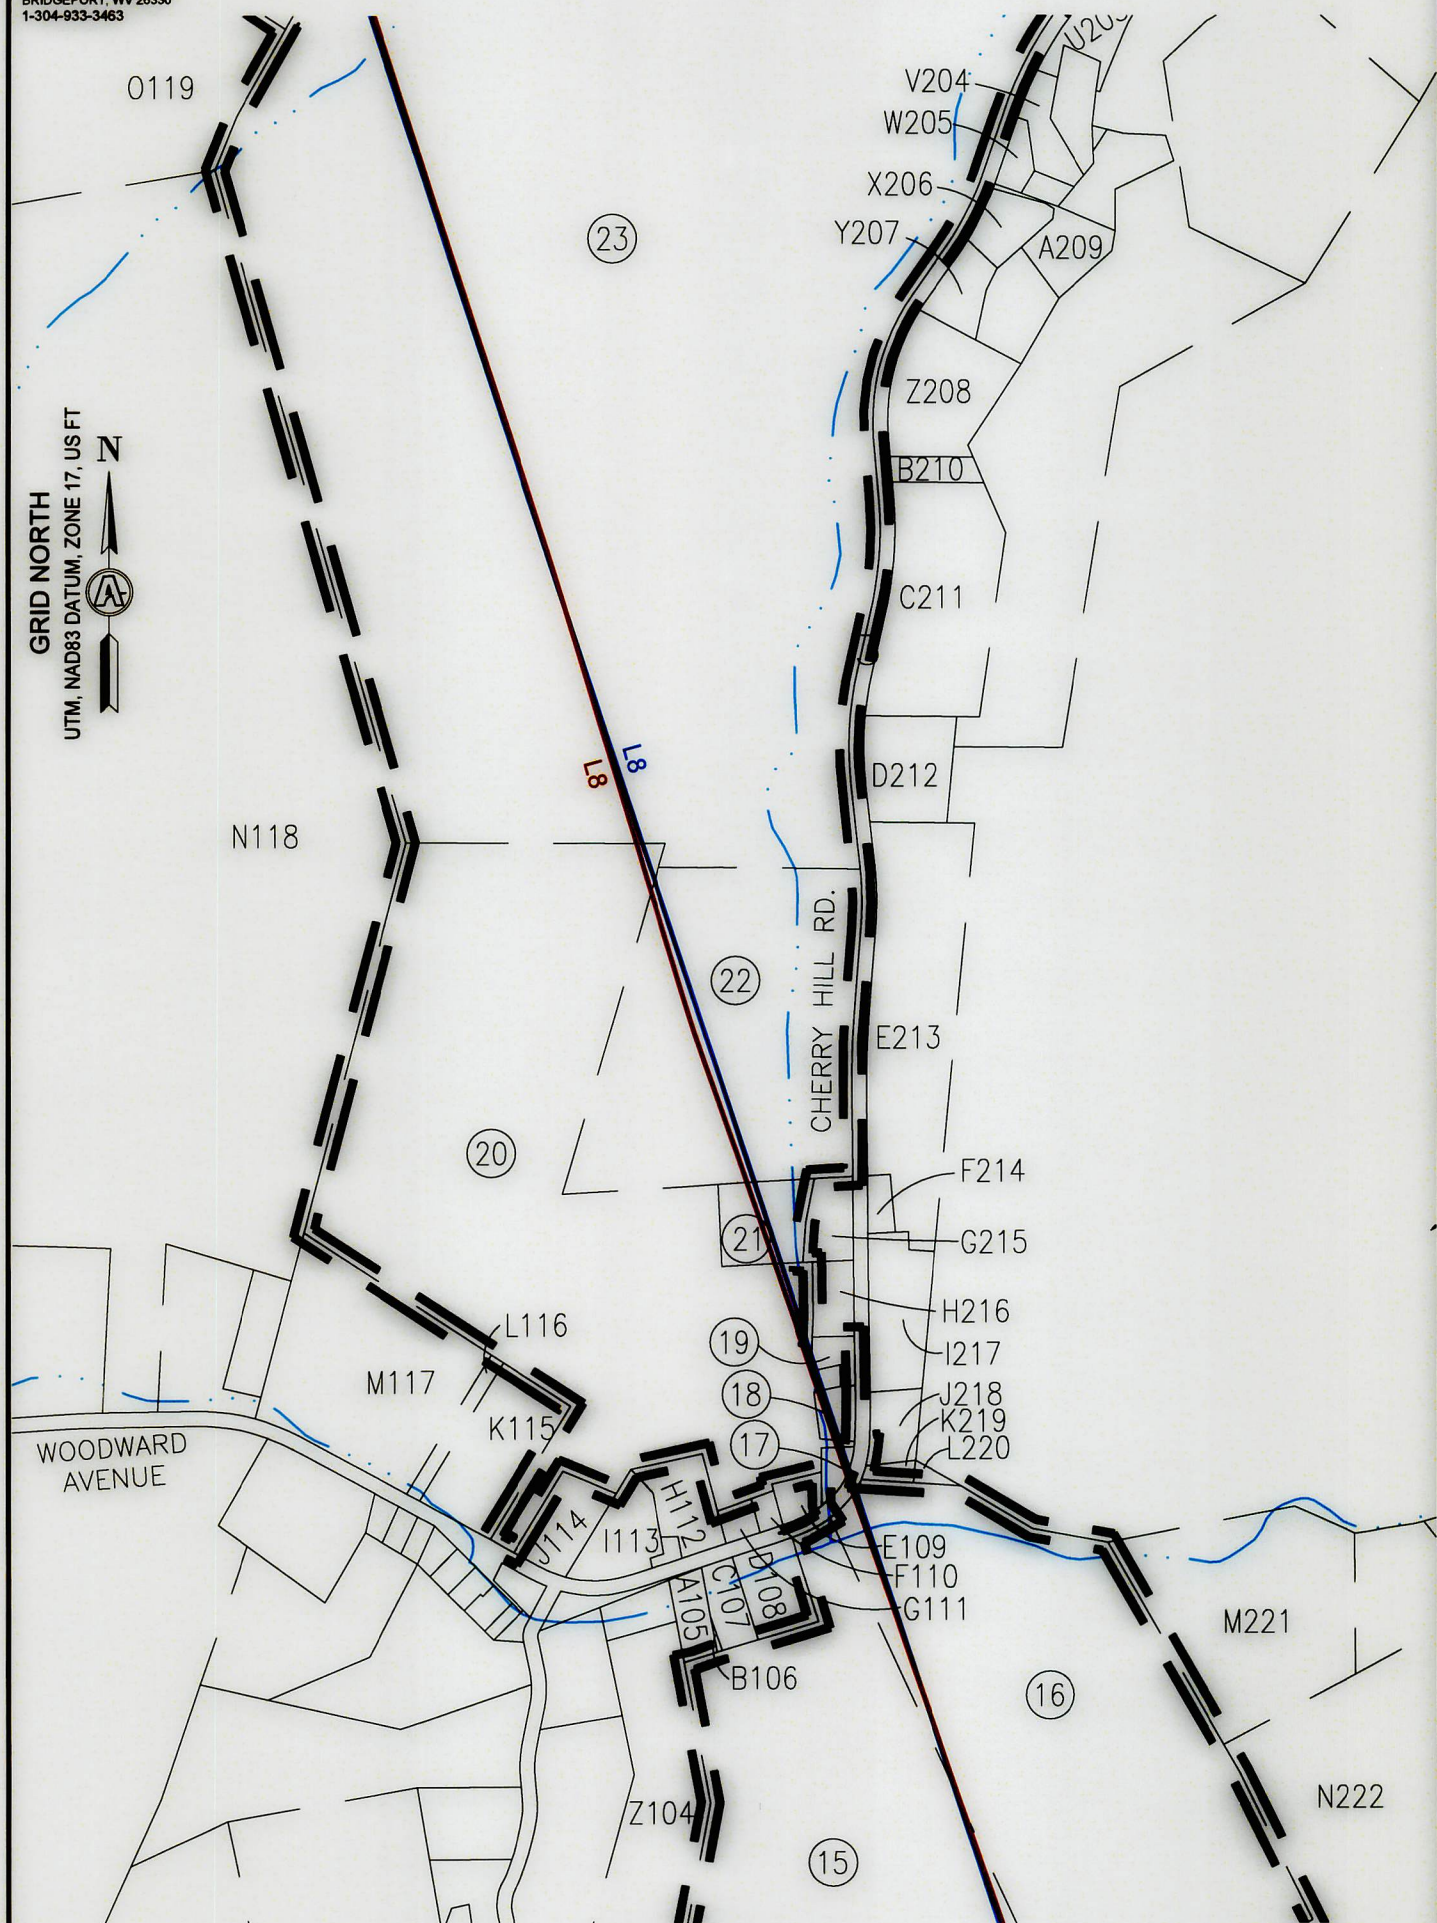

INSET "E"
SCALE: 1"=500'

09/26/2025

REVISIONS: 	COMPANY: 			03/31/2025
	OPERATOR'S SHANNON FIELDS OHI			DATE: 03-31-2025
	WELL #: 5H			DRAWN BY: TMF
	DISTRICT: RICHLAND	COUNTY: OHIO	STATE: WV	SCALE: N/A DRAWING NO: ACE-2326 WELL LOCATION PLAT



SURVEYOR/ENGINEER:
1700 ANMOORE ROAD
BRIDGEPORT, WV 26330
1-304-933-3463

GRID NORTH
UTM, NAD83 DATUM, ZONE 17, US FT



INSET "F"
SCALE: 1"=500'

09/26/2025

REVISIONS:		COMPANY:			
		OPERATOR'S		SHANNON FIELDS OHI	
		WELL #:		5H	
		DISTRICT:		COUNTY:	STATE:
		RICHLAND		OHIO	WV
				DATE: 03-31-2025	
				DRAWN BY: TMF	
				SCALE: N/A	
				DRAWING NO: ACE-2326	
				WELL LOCATION PLAT	



SURVEYOR/ENGINEER:
1700 ANMOORE ROAD
BRIDGEPORT, WV 26330
1-304-933-3463

TRACT	OWNER	TAX PARCEL
1	SWN PRODUCTION COMPANY LLC	4-R17-23.2
TRACT	OWNER	TAX PARCEL
2	BENEKE NADA E ET AL	4-R17-19
3	WHEELING PARK COMMISSION	4-R17-6.1
4	PARK VIEW MEMORIAL GARDENS INC	4-R17-8
5	GACS LP	10-W27A-1
6	WHEELING PARK COMMISSION	4-R14-14.1
7	ELM HILL HOLDINGS LLC	4-R14-14
8	CITY OF WHEELING	4-R14-15
9	WHEELING PARK COMMISSION	10-W17A-1
10	POLACK EDWARD P	4-R14-95
11	HUPP SARA	4-R13-1.14
12	GRIMES THOMAS B TRUSTEE THE ARCHIE TODD HUPP IV	4-R13-1.15
13	SANTORINE LORA KAY & SANTORINE ADOLPH W JR	4-R14A-24
14	MULL ELLEN CLARICE ET AL	4-R10-44.1
15	NORTH FORK LANDFILL INC	4-R10-43.1
16	NORTH FORK LANDFILL INC C/O SUSAN SARKIS	4-R10-41
17	NORTH FORK LANDFILL INC	4-R10-38
18	ROBINSON RICHARD J	4-R10-37
19	NORTH FORK LANDFILL INC	4-R10-34.1
20	SARKIS SJ; ROHRIG RF; ROHRIG JR; ROHRIG RF TTEE	4-R10-19
21	MCGARRY CORENA ESTATE	4-R10-33
22	BREIDING JOSHUA D & SARAH N	4-R10-20
23	WARWOOD LAND CO LLC	4-R7-31
24	CLEARVIEW VOL FIRE DEPT INC	2-CV6-34.1
25	CRAIG TRENDENICK	2-CV6-28
26	BOPP VICTOR V III & DIANN	2-CV6-28.3
27	JOSEPH BRADLEY R & JANETTE L	2-CV6-27.1
28	JOSEPH BRADLEY R & JANETTE L	2-CV6-27
29	JOSEPH BRADLEY R & JANETTE L	2-CV6-27.2
30	LAING MARGARET T	2-CV6-26
31	KIRKSEY MARK R & WEATHERSON NANCY (RES'V L/E)	2-CV6-25
32	BLUM RONALD & ROBIN S	2-CV6-8
33	ANDERSON COREY M & ANDERSON MARLENA J	2-CV6-9
34	ROBRECHT THOMAS A	2-CV7A-22
35	ROBRECHT THOMAS A	2-CV7A-23
36	SCHOOLCRAFT JOHN & CHRISTINA	2-CV7A-1
37	ALTMAN RICHARD T	4-R7-12.3
38	ROWND DENISE A & D T	4-R7-12.4
39	SAYRE MICHELLE L & THORNGATE ERIC W	4-R7-12.7
40	BIEGA FRANK P & C S	4-R7-12.6
41	BIEGA CONNIE SUE & FRANK PAUL	4-R7-12.9
42	BIEGA CONNIE SUE & FRANK PAUL	4-R7-12.2
43	BIEGA CONNIE SUE & FRANK PAUL	4-R7-12.10
44	ROWND DENISE & THOMPSON DANIEL, III	4-R7-12
45	CITY OF WHEELING	4-R7-18
46	DEAN LOMAN L & R Z	4-R7-21
47	EDGE BRUCE W	4-R7-23

REVISIONS:

COMPANY:



09/26/2025

OPERATOR'S

SHANNON FIELDS OHI

WELL #:

5H

DISTRICT:
RICHLAND

COUNTY:
OHIO

STATE:
WV

DATE: 03-31-2025

DRAWN BY: TMF

SCALE: N/A

DRAWING NO: ACE-2326

WELL LOCATION PLAT



SURVEYOR/ENGINEER:
1700 ANMOORE ROAD
BRIDGEPORT, WV 26330
1-304-933-3463

ADJOINING OWNERS TABLE		
TRACT	SURFACE OWNER	TAX PARCEL
A	HUFFNER EARL P	4-R17-24.1
B	MULL JAMES R	4-R17-24
C	MINCH HERBERT PAUL (1/2 INT) & MINCH BRENDA SUE (1/2 INT)	4-R17-57
D	LEWIS RUTH CARTER (DECD) IRREVOCABLE TRUST	4-R17-23
E	BENEKE NADA E	4-R17-22
F	JOHN THOMAS & MICHELLE	4-R17-20
G	CARTER RICHARD P	4-R17-23.3
H	OLEARY CRAIG V & EMMA L	4-R17-17
I	SCHREIBER JEREMY A & PHILBRICK ELIZABETH	4-R17-16
J	HEMPELMAN MARGARET E ESTATE	4-R17-14
K	COLUMBIA GAS TRANSMISSION CORP	4-R17-15
L	HEMPELMANN GUNTHER F JR	4-R17-13
M	BURKLAND CARL D III & JOLIN H	4-R17-13.1
N	BURKLAND CARL D III & JOLIN H	4-R17-12
O	FISHER HARRY S & BARBARA J	4-R17-11
P	FISHER HARRY S & BARBARA J	4-R17-11.1
Q	LENKEY ATTILA A	4-R17-10.1
R	WHEELING PARK COMMISSION	6-T1-2
T	PHILLIPSON SANDIN E	6-T1-1
U	GC&P DEVELOPMENT LLC	10-W26-90
V	LOHR LINDA J	10-W26-89
W	GACS L P	10-W26-90.1
X	LLL LLC	4-R17-6
Y	SEABRIGHT JACK & DANIELLE	4-R17-6.4
Z	SEABRIGHT JACK & DANIELLE	4-R17-6.2
A1	SEABRIGHT JACK A & DANIELLE L	4-R17-6.3
B2	VINEYARD CHRISTIAN FELLOWSHIP & WHEELING TRUSTEES	10-W27-1
C3	FIRST CLASS REALTY LLC	10-W27-1.1
D4	FIRST CLASS REALTY LLC	10-W27-2.1
E5	FIRST CLASS REALTY LLC	10-W27-2.2
F6	FOREST BROOK CONDOS	10-W27-3
G7	CHERRY BROOK CONDOS	10-W27A-6
H8	FIGARETTI C; NICODEMUS R; & KENNEN R; TRUSTEES	10-W27-5
I9	KEY ANIMAL HOSPITAL INC	10-W27-2
J10	GILSON THOMAS A & STEPHANIE S	10-W26-50
K11	MCCARTHY T CARROLL JR	4-R16-1.5
L12	HEISELE BARBARA ELLEN	4-R16-1.4
M13	WEST RENTALS INC	4-R16-1
N14	SUNRISE VALLEY REALITY LLC	4-R16-1.24
O15	LINDSAY MARK E & JULIE K	4-R16-1.26
P16	ELM HILL HOLDINGS LLC	4-R14-14
Q17	NUTTING ROBERT M	4-R14-7
R18	ELM HILL LLC	4-R14-14.2
S19	TOWNSEND TAMMY J	4-R14-9.3
T20	MOREHOUSE SHAWN R	4-R14-9.2
U21	WEST RENTALS INC	4-R14-9
V22	ATKINSON RYAN J & ANN SHANLEY ATKINSON	4-R14-9.1
W23	CHURILLA PAULINE	4-R14-10
X24	WALTER DEBORAH & GERALD	4-R14-11
Y25	GREER PETER S	4-R14-12
Z26	GREER PETER S	4-R14-11.2
A27	WALTER DEBORAH & GERALD	4-R14-11.1
B28	WRIGHT DEBORAH D & JOHN E IV	4-R14-8
C29	SCHULTZ JEFFREY S	4-R14-13
D30	MICHALSKI JOHN & SUSAN	4-R16-1.23
E31	ROBERTS MARY L - TOD	4-R16-1.1
F32	JOHN M STASKY TRUST UNDER AGREEMENT	4-R16-1.28

REVISIONS:

COMPANY:



09/26/2025

OPERATOR'S SHANNON FIELDS OHI

DATE: 03-31-2025

WELL #: 5H

DRAWN BY: TMF

DISTRICT: RICHLAND

COUNTY: OHIO

STATE: WV

SCALE: N/A

DRAWING NO: ACE-2326

WELL LOCATION PLAT



SURVEYOR/ENGINEER:
1700 ANMOORE ROAD
BRIDGEPORT, WV 26330
1-304-933-3463

ADJOINING OWNERS TABLE		
TRACT	SURFACE OWNER	TAX PARCEL
G33	MURPHY ROBERT L & LINDA D	4-R16-1.13
H34	DEEM STEVEN C & NORMA J	4-R16-1.22
I35	KALISZ WILLIAM & CATHERINE A	4-R16-1.21
J36	MENDEL MARTHA J	4-R16-1.19
K37	SPERLAZZA RYAN J & ASHLEY M	4-R16-1.18
L38	BAUER ROBB V AND KATHY	10-W21-43
M39	BURGER RAYMOND P KAREN E	4-R13R-25
N40	BECK ISABELLE M	4-R13R-24
O41	WORKMAN KAITLYN MARIE & JACK ARMSTRONG FITCH	4-R13R-22
P42	FINSLEY HENRY M	4-R13R-21
Q43	KETTLER JARED E	4-R13R-20
R44	WEISENBORN STEPHANIE L	4-R13R-19
S45	ALTMAN SHARON LOUISE C/O WESBANCO TRUST DEPT	4-R13R-18
T46	DUPLAGA MICHAEL F III	4-R13R-17
U47	GROUX FRED E JR	4-R13R-16
V48	ETHEL ROSE SMITH - TOD	4-R13R-15
W49	HUGHES JOSHUA KELLER	4-R13R-14
X50	MANNING JAMES C	4-R13R-13
Y51	MANNING JAMES C	4-R13R-12
Z52	WEISENBORN DALE A & S L	4-R13R-11
A53	BALL MATTHEW	4-R13R-10
B54	BOWMAN ROBERT E & BARBARA A	4-R13R-9
C55	MANNING LAWRENCE R & LESLIE A	4-R13R-8
D56	PARÉE ANGELO JR & KELLY J	4-R13R-7
E57	MOSCA TRUST; LOUISE E MOSCA TRUSTEE	4-R13R-6
F58	MOSCA TRUST; ROBERT J OR LOUISE E MOSCA TRUSTEES	4-R13R-5
G59	TRABERT TERRI L ET AL	4-R13R-4
H60	BACHMANN PETER	4-R13R-3
I61	SCHUNK CHRISTOPHER & JESSICA	4-R13R-1
J62	JARVIS DOWNING & EMCH INC	4-R13R-27
K63	BICKERSTAFF ROBERT DALE JR	4-R13M-14
L64	HOLT NED S & CHRISTINE L	4-R13M-13
M65	HARTMANN SHARON J	4-R13M-12
N66	HARTMANN SHARON J	4-R13M-12.1
O67	COLUMBIA GAS TRANSMISSION CORP	4-R13M-11
P68	RITNER ROBERT L & TRACI L	4-R13M-10
Q69	MULL JUSTIN & TAMMEY (LC-BYRS) OLEKSIK CASSIE & D J(LC-SLRS)	4-R13M-8.1
R70	MULL JUSTIN & TAMMEY (LC-BYRS) OLEKSIK CASSIE & D J(LC-SLRS)	4-R13M-8
S71	MULL JUSTIN & TAMMEY (LC-BYRS) OLEKSIK CASSIE & D J(LC-SLRS)	4-R13M-7
T72	FLICK-MOOS SUZANNE M & MOOS CHRISTOPHER J	4-R13M-7.1
U73	FLICK-MOOS SUZANNE M & MOOS CHRISTOPHER J	4-R13M-6
V74	VOLUSIA VENTURES	4-R13M-4
W75	ARCHER BYRON F JR & M L	4-R13M-3
X76	MICKER DEBORAH A	4-R13M-2
Y77	WEST RENTALS INC	4-R13M-1
Z78	WEST RENTALS INC	4-R13M-1.1
A79	WEST RENTALS INC	4-R13M-1.2
B80	THURSTON BONNIE BOWMAN	4-R13M-1.3
C81	THURSTON BONNIE L	4-R14J-16
D82	CLARK MARY LADONNA	4-R14J-14
E83	CLARK MARY LADONNA	4-R14J-13
F84	TODD HOWARD R JR	4-R14J-12
G85	CHIAZZA PETER P & AUDREY D	4-R14J-11
H86	SYRYLO RONALD & M	4-R14J-10
I87	PELUCHETTE JOHN M & C L	4-R14J-1
J88	PANEPINTO MARK D & MINDY D	4-R14J-2
K89	DUVAL THOMAS & ALLAMONG MARY F	4-R14J-3
L90	BOUDREAU DENISE LYNN	4-R14J-4
M91	BLAZER ROBERT J	4-R14J-5
N92	TAYLOR JOANE L	4-R14J-8
O93	RICE STEVEN A AND JUDITH A	4-R14J-7
P94	BALTZ LEE E & J L	4-R14J-6

REVISIONS:

COMPANY:



09/26/2025

OPERATOR'S SHANNON FIELDS OHI

DATE: 03-31-2025

WELL #: 5H

DRAWN BY: TMF

DISTRICT: RICHLAND

COUNTY: OHIO

STATE: WV

SCALE: N/A

DRAWING NO: ACE-2326

WELL LOCATION PLAT



SURVEYOR/ENGINEER:
1700 ANMOORE ROAD
BRIDGEPORT, WV 26330
1-304-933-3463

ADJOINING OWNERS TABLE		
TRACT	SURFACE OWNER	TAX PARCEL
Q95	ZAVOLTA RONALD W	4-R14J-9
R96	POLACK E PHILLIPS M D	4-R13-15
S97	HUPP MOLLY H 1/2 INT & SCHEINHOLTZ DAVID J 1/2 INT	4-R13-1.13
T98	HUPP SARA STEPHENS	4-R13-1.17
U99	PRATHER JOHN R	4-R13-1.11
V100	PRATHER JOHN R	4-R10-47
W101	PRATHER JOHN R	4-R10-44
X102	PRATHER JOHN R	4-R10-44.2
Y103	MYERS WILBERT E III	4-R10-2
Z104	ASSARO ANTHONY L & S L	4-R10-43.3
A105	ASSARO ANTHONY L SR & SANDRA	4-R10-43.5
B106	ASSARO ANTHONY L SR & SANDRA	4-R10-43.9
C107	ROHRIG ROBERT F & KATHLEEN S	4-R10-43.6
D108	BENNETT CLIFFORD DWANE & BENNETT SANDRA V	4-R10-43.7
E109	JAQUAY TODD F	4-R10-19.1
F110	MOFFITT SYLVIA F	4-R10-10
G111		4-R10-19.2
H112	SARKIS SJ; ROHRIG RF; ROHRIG JR; ROHRIG RF TTEE	4-R10-10.1
I113	SARKIS SJ; ROHRIG RF; ROHRIG JR; ROHRIG RF TTEE	4-R10-11
J114	GILBERT DONALD E JR	4-R10-12
K115	H3 LLC	4-R10-13
L116	NORTH FORK LANDFILL INC	4-R10-14
M117	PERSINGER PAMELA M	4-R10-15
N118	NORTH FORK LANDFILL INC	4-R10-43
O119	MCGLAUGHLIN DENNIS & S	4-R7-30
P120	VILLAGE OF CLEARVIEW	2-CV6-34.2
Q121	SPARKS FAMILY IRREVOCABLE TRST; TRACY LYNN EBERHARD TRUSTEE	2-CV6-29.1
R122	REINACHER CHARLES J & CAROL S	2-CV6-4
S123	REINACHER CHARLES J & CAROL S	2-CV6-4.2
T124	CAMPBELL JAMES & MICHELLE	2-CV6-5.1
U125	CAMPBELL CLYDE D & J L	2-CV6-6
V126	CAMPBELL CLYDE D	2-CV6-7
W127	ROWND DENISE & DANIEL T III	4-R7-12.11
X128	CHUMNEY KEVIN K AND JANET L	4-R7Q-13
Y129	CUPP JOSEPH T AND AMY JO	4-R7L-107
Z130	CITY OF WHEELING	4-R7L-105
A131	CITY OF WHEELING	4-R7L-100
B132	MACFARLAND DARIN P & KL	4-R7L-99
C133	CITY OF WHEELING	4-R7G-25
D134	MACFARLAND DARIN P & KIMBERLY	4-R7G-24
E135	COMER JEAN A	4-R7G-23
F136	COMER JEAN A	4-R7G-20
G137	ROBINSON RICHARD J	4-R7G-19
H138	VELEGOL DAVID & CAROLYN	4-R7G-18
I139	GUZZI COREY A & BRITTANY N	4-R7-10
J140	GUZZI COREY A & BRITTANY N	4-R7-11
K141	BOURNE JOHN & LETHA	4-R7L-56.8
L142	WEST VIRGINIA STATE ROAD COMM	4-R7L-56.7
M143	MORGAN WILBUR W	4-R7L-56.6
N144	FAZZOLARI FRANK SAMUEL ESTATE	4-R7L-56.5
O145	WEST VIRGINIA STATE ROAD COMM	4-R7L-56.4
P146	FLUHARTY MICHAEL L & BRENDA K	4-R7L-56
Q147	WEST VIRGINIA STATE ROAD COMM	4-R7L-56.3
R148	WEST VIRGINIA STATE ROAD COMM	4-R7L-56.2
S149	DOUGHERTY GEORGE H & THELMA T	4-R7L-56.1
T150	JONES SHANNON M WILDS	4-R7-16.1
U151	DONOHEW WILLIAM SCOTT & LAURA	4-R4-2.4

09/26/2025

REVISIONS:

COMPANY:



OPERATOR'S

SHANNON FIELDS OHI

DATE: 03-31-2025

WELL #:

5H

DRAWN BY: TMF

DISTRICT:
RICHLAND

COUNTY:
OHIO

STATE:
WV

SCALE: N/A

DRAWING NO: ACE-2326

WELL LOCATION PLAT



SURVEYOR/ENGINEER:
1700 ANMOORE ROAD
BRIDGEPORT, WV 26330
1-304-933-3463

ADJOINING OWNERS TABLE		
TRACT	SURFACE OWNER	TAX PARCEL
V152	MCCLURE WM H & MARG A	4-R4-7
W153	ROTH FARMS, LLC	4-R7-24
X154	HARTFILE GARY L - TOD	4-R7-16
Y155	HARTFILE GARY L - TOD	4-R7-20
Z156	LOEW J W JR & ELSIE	4-R7-22
A157	HARTFILE GARY L -TOD	4-R7-15.1
B158	FLUHARTY MICHAEL AND BRENDA K	4-R7-17
C159	STEWART MARK E; GEIGER LEEANN	4-R7-28
D160	STEWART MARK E	4-R7-15.2
E161	BIEGA FRANKIE P & C S	4-R7-15
F162	FEDORKE AARON P & TIMOTHY J	2-CV4-3
G163	FEDORKE TIMOTHY JOSEPH	4-R7-37
H164	BIEGA FRANK & CONNIE	4-R7-27.2
I165	STOEHR RONALD J & MARIE G- TOD	2-CV3-4.7
J166	ROWND DENISE A & ROWND DANIEL THOMPSON III	4-R7-14.1
K167	ROWND DENISE & DANIEL T III	4-R7-14
L168	UTTERMOHLEN JAMES VINCENT & ALINA DOLORES UTTERMOHLEN	2-CV7A-8
M169	JOHNSON TIMOTHY P & CRYSTAL J	2-CV7A-7
N170	RATCLIFFE LINDA L & RATCLIFFE RUSSELL B ESTATE	2-CV7A-6
O171	COMER JEAN A	2-CV7A-3
P172	SCHANE DOUGLAS W & CARRIE L	4-R7-12.8
Q173		
R174	ROWND DANIEL III & DENISE	4-R7-12.14
S175	BENNETT JOHN & HOLLY	2-CV7A-33
T176	WHITE DAVID A	2-CV7A-24
U177	EUTSEY NICOLE R	2-CV7A-21
V178	ANGIUS JENNA	2-CV6-10
W179	BOLES ROBERT E III & TIFFANY M	2-CV6-10.1
X180	GIBSON ROBERT H & D L	2-CV7A-4
Y181	MCQUAID RYAN P & SAMANTHA M	2-CV7A-2
Z182	CONTRAGUERRO MICHAEL J JR & BRITTANY LEIGH CONTRAGUERRO	2-CV6-24
A183	STEWART GREGORY L & JODI A	2-CV6-23
B184	SAVAGE CHARLES J & RACHEL M	2-CV6-22
C185	DAGRAVA TIMOTHY & MEGAN	2-CV6-21
D186	HLAD DOUGLAS M & LISA ANN	2-CV6-20
E187	STEWART LOGAN G & ALICIA D	2-CV6-19
F188	SZALAY FRANCIS E & PL	2-CV3-13.1
G189	MYERS WILBERT E III & J S	2-CV3-13
H190	KLEIN JACK W JR & BRENDA J-TOD	2-CV4-22.1
I191	MURRAY BRYAN M AND JOAN C	2-CV4-22
J192	PAVLIK NICHOLAS D AND GLORIA K	2-CV4-21.2
K193	HESTIA LLC	4-R8-65.1
L194	GLENN VIEW LIMITED PARTNERSHIP	4-R8-65.4
M195	GLENN VIEW II LIMITED PARTNERSHIP	4-R8-68
N196	MEREDITH DONALD R II AND JULIE	4-R8-69.1
O197	MARY ANN HESS REALTY LLC C/O HANNIG & ASSOCIATES PLLC	4-R8-70
P198	CASTILOW CHET	4-R7-34
Q199	STEVEN JOHNSON LEWIS ET AL	4-R7-33
R200	JOHNSON STEVEN LEWIS ET AL	4-R7-32
S201	SCHMALZ ANGELA	4-R7-36
T202	JOHNSON JOHN	4-R10-29
U203	JOHNSON JOHN LLOYD	4-R7-39
V204	KYLE CHAD J & E A	4-R10-22
W205	NEWLAND DARRELL L	4-R10-22.3
X206	BROST RICHARD	4-R10-24.1
Y207	WILSON CINDY L P & DANIEL-TOD	4-R10-26
Z208	ERNEST RICHARD H JR & A L	4-R10-27
A209	LASH MARTHA J	4-R10-24

REVISIONS:	COMPANY:			09/26/2025
	OPERATOR'S	SHANNON FIELDS OHI		DATE: 03-31-2025
	WELL #:	5H		DRAWN BY: TMF
	DISTRICT:	COUNTY:	STATE:	SCALE: N/A
	RICHLAND	OHIO	WV	DRAWING NO: ACE-2326
				WELL LOCATION PLAT



SURVEYOR/ENGINEER:
1700 ANMOORE ROAD
BRIDGEPORT, WV 26330
1-304-933-3463

ADJOINING OWNERS TABLE		
TRACT	SURFACE OWNER	TAX PARCEL
B210	BROOKS WILLIAM S C/O WESBANCO TRUST	4-R10-27.1
C211	WEST SHARON L	4-R10-28
D212	INTERSTATE DEV CORP C/O JACK FELTON CPA	4-R10-46
E213	MCCARDLE STANLEY M JR & M	4-R10-35
F214	OHIO COUNTY PUBLIC SERV DIST	4-R10-35.2
G215	MCGARRY CORENA ESTATE	4-R10-32
H216	BREIDING JOSHUA D	4-R10-34.2
I217	MCCARDLE STANLEY M JR & M	4-R10-36
J218	IAFRATE DAVID A	4-R10-39
K219	NORTH FORK LANDFILL INC C/O SUSAN SARKIS	4-R10-39.1
L220	NORTHFORK LANDFILL INC C/O SARKIS SUSAN	4-R10-41.1
M221	NORTH FORK LANDFILL INC C/O SUSAN SARKIS	4-R10-41
N222	GOLDEN CHRISTOPHER SCOTT & GOLDEN BRANDACE LYNN	4-R11-2.4
O223	DOYLE DANIEL T & LUCINDA E	4-R11-2.12
P224	LOWE JEREMY J & AMANDA L	4-R11-2.11
Q225	LOWE JEREMY J & AMANDA L	4-R11-2.6
R226	CUSACK JOHN L & TAMMIE L	4-R11-2.9
S227	COX C NOLAN	4-R14A-25
T228	DUFF FRANK X & DEBORAH M	4-R14A-69.1
U229	DUFF FRANK X & DEBORAH M	4-R14A-69
V230	DUFF FRANCIS X & D M	4-R14A-71
W231	DUFF DEBORAH M	4-R14A-88
X232	DUFF FRANCIS X & D M	4-R14A-53.2
Y233	EXLEY R BANFORD & T L	4-R14A-111
Z234	KIDD JOHN M	4-R14A-210
A235	ADAMS JAMES C & MELISSA S	4-R14E-1
B236	SUNSHINE STATE INV GROUP LLC	4-R14A-53
C237	SCHMITT JAMES A	4-R14-4.6
D238	SCHMITT JAMES A	4-R14-4.5
E239	LONG RUN PET HOSPITAL INC	4-R14-6
F240	JONES WILBUR S JR & JEFFERSON JOYCE P	4-R14-90
G241	SISTERS OF ST JOSEPH OF WHEELING INC	4-R11-21
H242	SISTERS OF ST JOSEPH OF WHG	4-R11-20
I243	PARKS SYSTEM TRUST FUND OF WHEELING	4-R11-21.3
J244	WHEELING PARK COMMISSION	4-R14-91
K245	WHEELING PARK COMMISSION	4-R14-20.4
L246	WHEELING PARK COMMISSION	4-R14-15.2
M247	HOSFELT WILLIAM J & PATRICIA HOSFELT ESTATES	10-W12D-2
N248	RANSOM CHARLES M & CRYSTAL G	10-W12D-1
O249	DIVINEY MARY F & TOMMY S JR	10-W14D-1
P250	SATTERFIELD DOROTHY & MARY KAY FAHEY	10-W14D-2
Q251	TUCKER ROBERT A & ROSEMARY	10-W14D-3
R252	MCKINLEY BETTY J	10-W14D-4
S253	WORKMAN WHITNEY SAMARA	10-W14D-5
T254	QUEEN THOMAS R & CYNTHIA A	10-W14D-6
U255	RIGGS DAVID V & KERRIE L	10-W14D-7
V256	ROBINSON TONY A	10-W14D-8
W257	BTCT RENTALS LLC	10-W14D-9
X258	KUHAR DOROTHY RES'V L/E KUHAR CHRISTINE	10-W14D-10
Y259	BASSI ALBERTO & THAIANE N LIMA	10-W14D-11
Z260	PEARCE CRAGO PAULA	10-W14D-12
A261	SMITH CODY A	10-W14D-13
B262	SAFCSAK KATHLEEN	10-W14D-14
C263	DOEPKEN DAVID W & CHRISTINE B	10-W14D-15
D264	BAUER JESSICA L & CHAD	10-W14D-16

REVISIONS:

COMPANY:



09/26/2025

OPERATOR'S

SHANNON FIELDS OHI

DATE: 03-31-2025

WELL #:

5H

DRAWN BY: TMF

DISTRICT:
RICHLAND

COUNTY:
OHIO

STATE:
WV

SCALE: N/A

DRAWING NO: ACE-2326

WELL LOCATION PLAT



SURVEYOR/ENGINEER:
1700 ANMOORE ROAD
BRIDGEPORT, WV 26330
1-304-933-3463

ADJOINING OWNERS TABLE		
TRACT	SURFACE OWNER	TAX PARCEL
E265	NEUMAN CHARLES & B J WOTRING	10-W14D-17
F266	YOUNG MARK K & SAMANTHA	10-W14D-18
G267	PETRI DANIEL S & D	10-W14D-19
H268	WATSON STEVEN A & SHERI	10-W17D-2
I269	HANNA STEPHEN L & C H	10-W17D-3
J270	MILLER DAVID W & JUNKERSFELD PETER J	10-W17D-4
K271	MILLER DAVID W & JUNKERSFELD P	10-W17D-5
L272	FITZSIMMONS CLAYTON J	4-R14-46.13
M273	MCBANE DANIEL & CLARE FAMILY TRUST	10-W17D-6
N274	WHEELING PARK COMMISSION	10-W17D-7
O275	LAPP SAMUEL J II & HEATHER A	4-R14-50.1
P276	GOMPERS KATHLEEN M	4-R14-50.3
Q277	GOMPERS KATHLEEN M	4-R14-50.2
R278	FRIEND HARRIETTE E & FRIEND L EDWARD II	4-R14-51
S279	HITCHMAN HELEN G	4-R14-53
T280	BURGE EDWARD LEE JR	4-R17-8.1
U281	HITCHMAN HELEN G	4-R14-67
V282	KNOX TARA MICHELLE & TORY JAY	4-R17-59.1
W283	EDDY DONALD R & M M	4-R17-59.2
X284	FLUHARTY MICHAEL L	4-R7-6
Y285	WOLFE JAMES R ESTATE	4-R7-7
Z286	FLUHARTY MICHAEL L & BRENDA K	4-R7-8
A287	FLUHARTY MICHAEL L & BRENDA K	4-R7-9.1
B288	FLUHARTY MICHAEL & BRENDA	4-R7-9
C289	WICKHAM THOMAS OR LINDA	2-CV5-31
D290		2-CV5-30
E291	VILLAGE OF CLEARVIEW	2-CV5-30.1
F292	CLATTERBUCK CHAD J	2-CV6-34
G293	STEFANOW JOHN	2-CV6-33
H294	PARKER GAGE C	2-CV6-32
I295	THOMAS AMANDA & MARK S II	2-CV6-31
J296	HAWK ANGELA S & BART N WISIALOWSKI	2-CV6-30
K297	RUSSELL J F SR & W M (L/E) KUZNICK MARGARET CAROL	2-CV6-29

REVISIONS:

COMPANY:



09/26/2025

OPERATOR'S

SHANNON FIELDS OHI

DATE: 03-31-2025

WELL #:

5H

DRAWN BY: TMF

DISTRICT:
RICHLAND

COUNTY:
OHIO

STATE:
WV



SCALE: N/A

DRAWING NO: ACE-2326

WELL LOCATION PLAT




SURVEYOR/ENGINEER:
1700 ANMOORE ROAD
BRIDGEPORT, WV 26330
1-304-933-3463

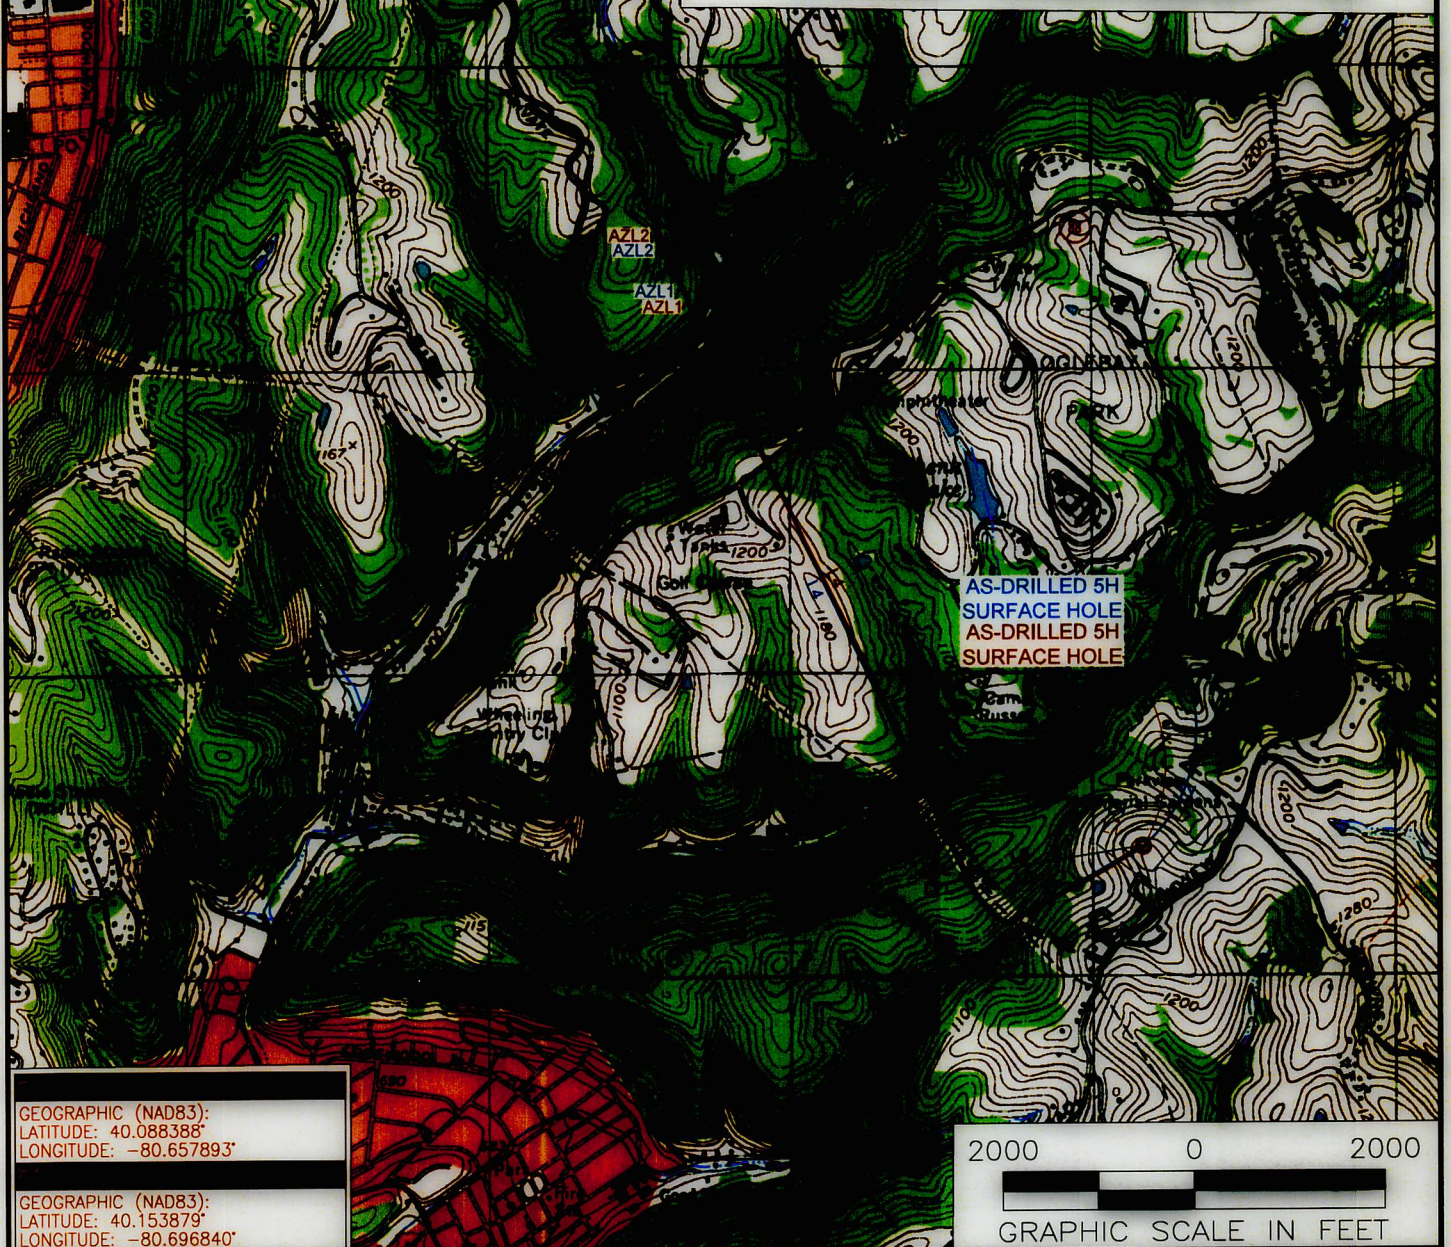
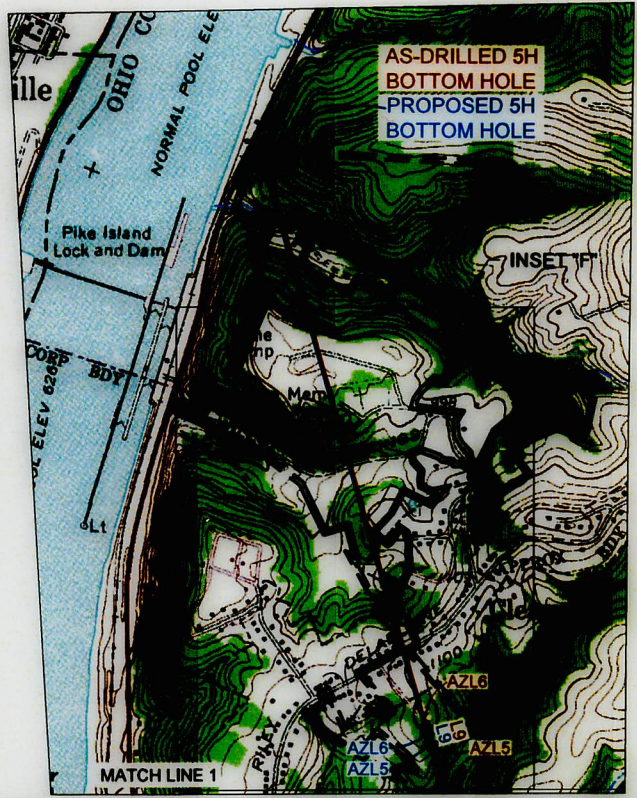


GEOGRAPHIC (NAD83):
LATITUDE: 40.088388°
LONGITUDE: -80.657893°

GEOGRAPHIC (NAD83):
LATITUDE: 40.153879°
LONGITUDE: -80.696840°

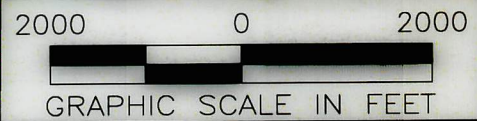

NOTES ON SURVEY 1. SURFACE AND ROYALTY OWNER INFORMATION AND THEIR BOUNDARIES SHOWN HEREON WERE PLOTTED FROM DEEDS AND/OR TAX PARCEL MAPS PROVIDED BY CLIENT AND/OR FIELD LOCATIONS. 2. THIS PLAT DOES NOT REPRESENT A BOUNDARY SURVEY OF THE PARCELS SHOWN HEREON. 4. ALL INSETS ARE GRID NORTH UNLESS OTHERWISE DEPICTED.			
LEGEND: ○ PROPOSED SURFACE HOLE / BOTTOM HOLE ⊙ EXISTING / PRODUCING WELLHEAD LPL* LANDING POINT LOCATION W EXISTING WATER WELL S EXISTING SPRING		09/20/2025 — SURVEYED BOUNDARY — LEASE BOUNDARY — ASDRILLED PATH — PROPOSED PATH — DHP BUFFER	
WELL OPERATOR: SWN PRODUCTION COMPANY, LLC		WELL (FARM) NAME: SHANNON FIELDS OHI	WELL # 5H
ADDRESS: 1300 FORT PIERPONT DRIVE, SUITE 201		COUNTY — CODE OHIO — 35	SERIAL # XXXX
SURFACE OWNER: SWN PRODUCTION COMPANY, LLC		DISTRICT; RICHLAND	
		USGS 7 1/2 QUADRANGLE MAP NAME WHEELING, WV	

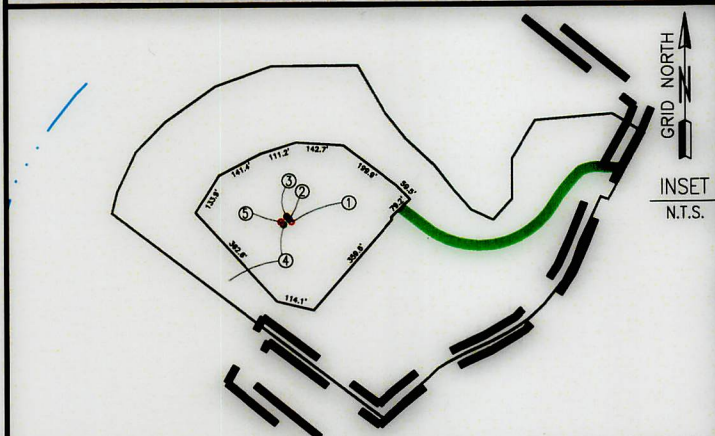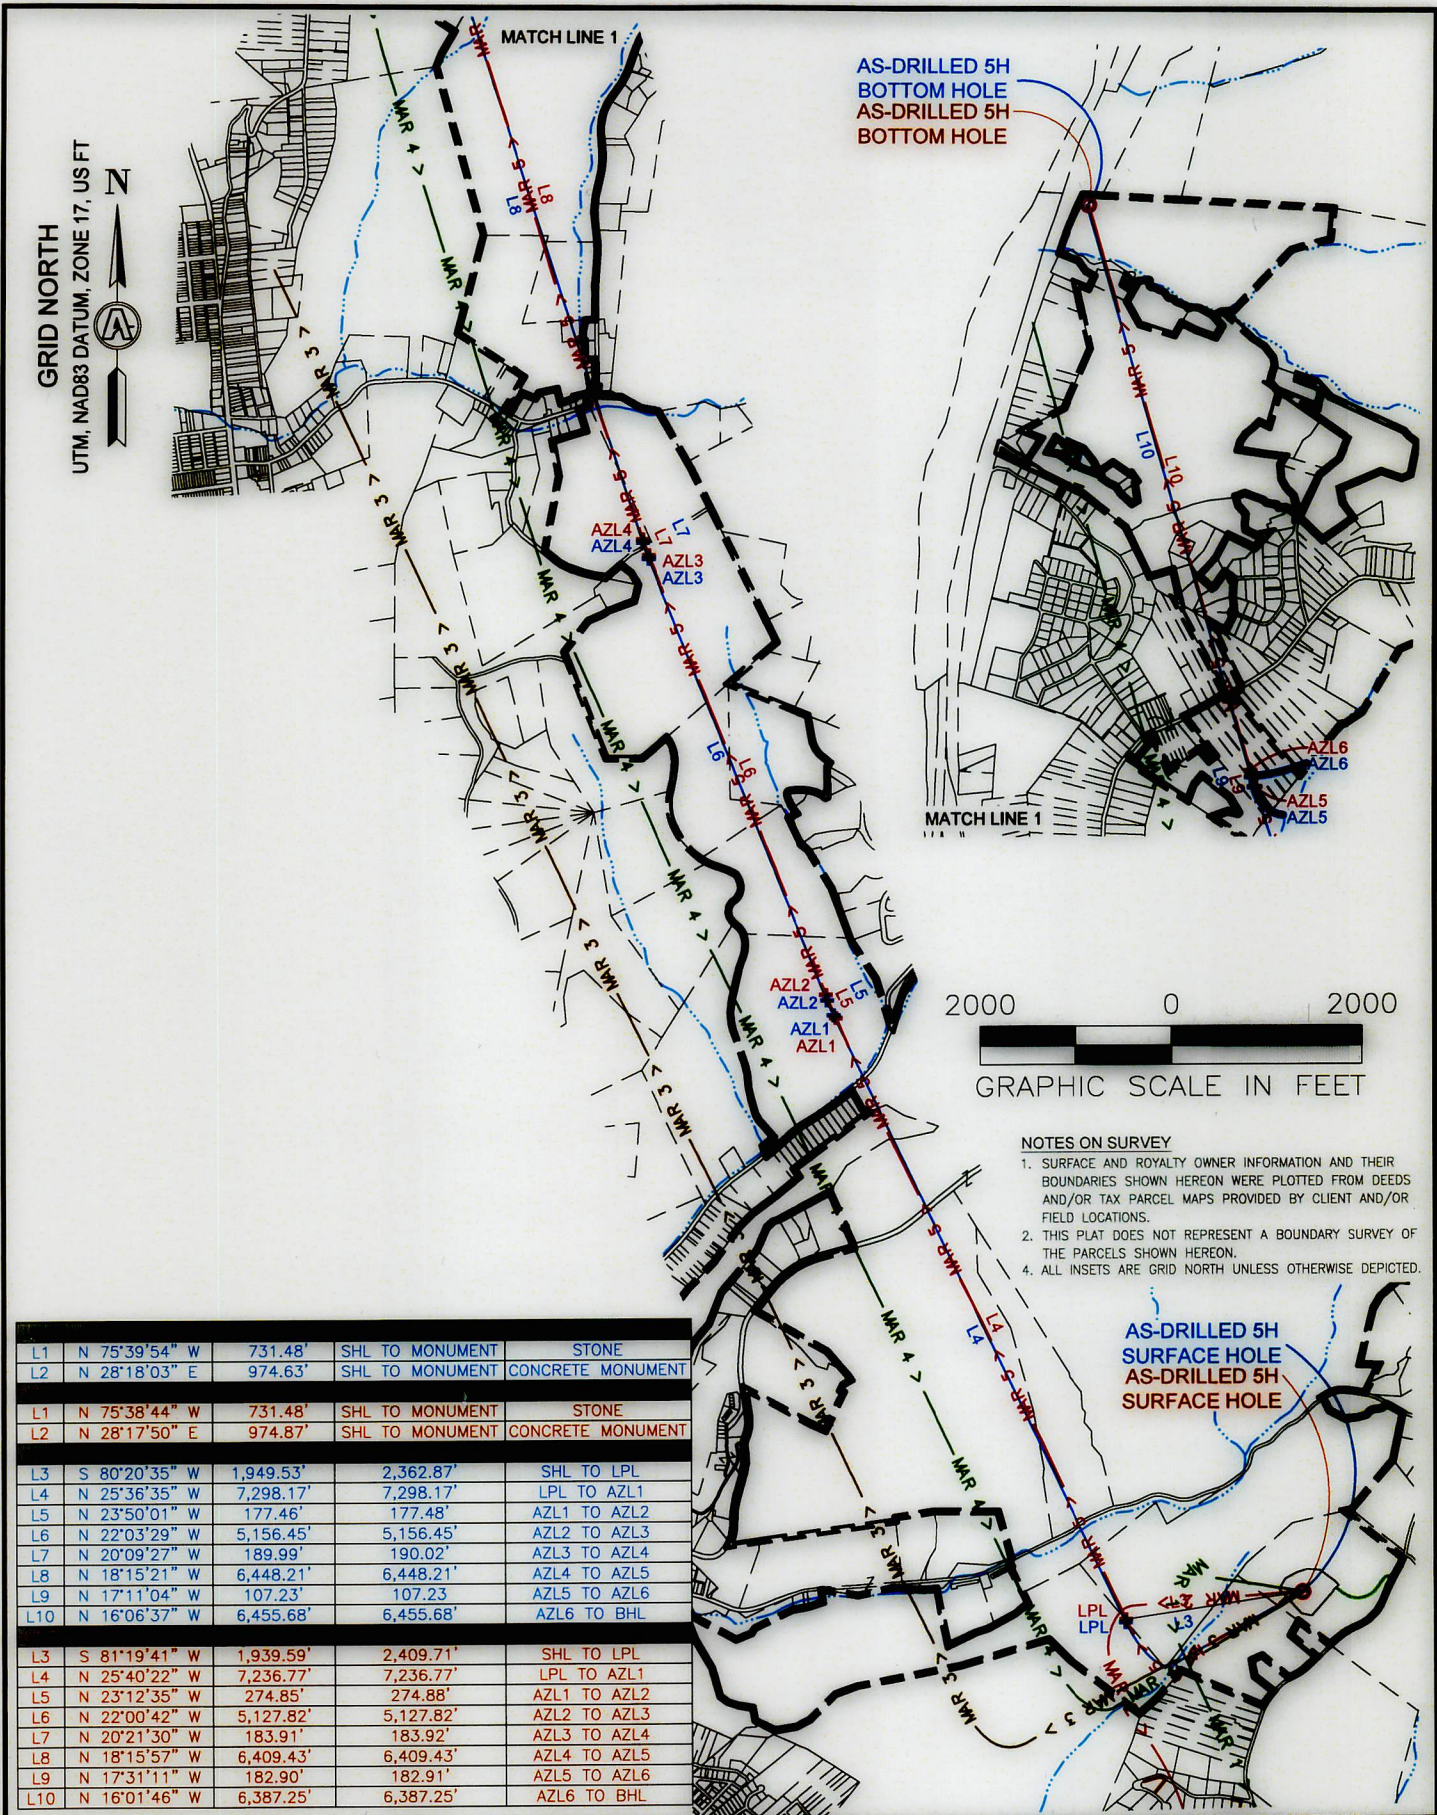

LEGEND:

○	PROPOSED SURFACE HOLE / BOTTOM HOLE	— — — — —	DRILLING UNIT
⊗	EXISTING / PRODUCING WELLHEAD	== == ==	LEASE BOUNDARY
⊗	ABANDONED WELL	— — — — —	HARDLINE BOUNDARY
⊗	PLUGGED & ABANDONED WELL	— UPP 2 > —	UPPER POINT PLEASANT PATH
LPL*	LANDING POINT LOCATION	— MAR 2 > —	MARCELLUS PATH

COMPANY: **expand**

OPERATOR'S **SHANNON FIELDS OHI**

WELL #: **5H**

DISTRICT: RICHLAND	COUNTY: OHIO	STATE: WEST VIRGINIA
-----------------------	-----------------	-------------------------


SWN PRODUCTION COMPANY, LLC
SURFACE HOLES

1. "SHANNON FIELDS—OH 210H"
2. "SHANNON FIELDS—OH 10H"
3. "SHANNON FIELDS—OH 1H"
4. "SHANNON FIELDS—OH 3H"
5. "SHANNON FIELDS—OH 5H"

09/26/2025


REVISIONS:	DATE: 03-31-2025
	DRAWN BY: TMF
	SCALE: 1" = 2500'
	DRAWING NO: ACE-2326
	INTERNAL WELL PLAT

GEOGRAPHIC (NAD83): LATITUDE: 40.088389° LONGITUDE: -80.657892°	GEOGRAPHIC (NAD27): LATITUDE: 40.088316° LONGITUDE: -80.658092°	GEOGRAPHIC (NAD83): LATITUDE: 40.136531° LONGITUDE: -80.690461°	GEOGRAPHIC (NAD27): LATITUDE: 40.136459° LONGITUDE: -80.690659°
UTM (NAD83, ZONE 17, FEET): NORTHING: 14,559,103.630 EASTING: 1,736,100.660	UTM (NAD27, ZONE 17, FEET): NORTHING: 14,558,387.278 EASTING: 1,736,047.377	UTM (NAD83, ZONE 17, FEET): NORTHING: 14,576,601.130 EASTING: 1,726,930.570	UTM (NAD27, ZONE 17, FEET): NORTHING: 14,575,884.793 EASTING: 1,726,877.514
UTM (NAD83, ZONE 17, METERS): NORTHING: 4,437,623.662 EASTING: 529,164.539	UTM (NAD27, ZONE 17, METERS): NORTHING: 4,437,405.317 EASTING: 529,148.299	UTM (NAD83, ZONE 17, METERS): NORTHING: 4,442,956.910 EASTING: 526,369.490	UTM (NAD27, ZONE 17, METERS): NORTHING: 4,442,738.570 EASTING: 526,353.319
GEOGRAPHIC (NAD83): LATITUDE: 40.087511° LONGITUDE: -80.664768°	GEOGRAPHIC (NAD27): LATITUDE: 40.087438° LONGITUDE: -80.664968°	GEOGRAPHIC (NAD83): LATITUDE: 40.136813° LONGITUDE: -80.690573°	GEOGRAPHIC (NAD27): LATITUDE: 40.136741° LONGITUDE: -80.690771°
UTM (NAD83, ZONE 17, FEET): NORTHING: 14,558,776.600 EASTING: 1,734,178.760	UTM (NAD27, ZONE 17, FEET): NORTHING: 14,558,060.267 EASTING: 1,734,125.534	UTM (NAD83, ZONE 17, FEET): NORTHING: 14,576,703.570 EASTING: 1,726,898.890	UTM (NAD27, ZONE 17, FEET): NORTHING: 14,575,987.233 EASTING: 1,726,845.835
UTM (NAD83, ZONE 17, METERS): NORTHING: 4,437,523.983 EASTING: 528,578.743	UTM (NAD27, ZONE 17, METERS): NORTHING: 4,437,305.644 EASTING: 528,562.520	UTM (NAD83, ZONE 17, METERS): NORTHING: 4,442,988.134 EASTING: 526,359.834	UTM (NAD27, ZONE 17, METERS): NORTHING: 4,442,769.794 EASTING: 526,343.663
GEOGRAPHIC (NAD83): LATITUDE: 40.105616° LONGITUDE: -80.675961°	GEOGRAPHIC (NAD27): LATITUDE: 40.105543° LONGITUDE: -80.676160°	GEOGRAPHIC (NAD83): LATITUDE: 40.153861° LONGITUDE: -80.696907°	GEOGRAPHIC (NAD27): LATITUDE: 40.153790° LONGITUDE: -80.697105°
UTM (NAD83, ZONE 17, FEET): NORTHING: 14,565,357.790 EASTING: 1,731,024.210	UTM (NAD27, ZONE 17, FEET): NORTHING: 14,564,641.462 EASTING: 1,730,971.062	UTM (NAD83, ZONE 17, FEET): NORTHING: 14,582,905.730 EASTING: 1,725,107.530	UTM (NAD27, ZONE 17, FEET): NORTHING: 14,582,189.383 EASTING: 1,725,054.511
UTM (NAD83, ZONE 17, METERS): NORTHING: 4,439,529.933 EASTING: 527,617.234	UTM (NAD27, ZONE 17, METERS): NORTHING: 4,439,311.596 EASTING: 527,601.035	UTM (NAD83, ZONE 17, METERS): NORTHING: 4,444,878.556 EASTING: 525,813.827	UTM (NAD27, ZONE 17, METERS): NORTHING: 4,444,660.213 EASTING: 525,797.666
GEOGRAPHIC (NAD83): LATITUDE: 40.106062° LONGITUDE: -80.676215°	GEOGRAPHIC (NAD27): LATITUDE: 40.105990° LONGITUDE: -80.676414°		
UTM (NAD83, ZONE 17, FEET): NORTHING: 14,565,520.120 EASTING: 1,730,952.500	UTM (NAD27, ZONE 17, FEET): NORTHING: 14,564,803.792 EASTING: 1,730,899.353		
UTM (NAD83, ZONE 17, METERS): NORTHING: 4,439,579.412 EASTING: 527,595.377	UTM (NAD27, ZONE 17, METERS): NORTHING: 4,439,361.074 EASTING: 527,579.178		
GEOGRAPHIC (NAD83): LATITUDE: 40.119205° LONGITUDE: -80.683080°	GEOGRAPHIC (NAD27): LATITUDE: 40.119133° LONGITUDE: -80.683278°		
UTM (NAD83, ZONE 17, FEET): NORTHING: 14,570,299.130 EASTING: 1,729,016.010	UTM (NAD27, ZONE 17, FEET): NORTHING: 14,569,582.800 EASTING: 1,728,962.909		
UTM (NAD83, ZONE 17, METERS): NORTHING: 4,441,036.057 EASTING: 527,005.134	UTM (NAD27, ZONE 17, METERS): NORTHING: 4,440,817.719 EASTING: 526,988.949		
GEOGRAPHIC (NAD83): LATITUDE: 40.119695° LONGITUDE: -80.683312°	GEOGRAPHIC (NAD27): LATITUDE: 40.119623° LONGITUDE: -80.683510°		
UTM (NAD83, ZONE 17, FEET): NORTHING: 14,570,477.480 EASTING: 1,728,950.540	UTM (NAD27, ZONE 17, FEET): NORTHING: 14,569,761.150 EASTING: 1,728,897.440		
UTM (NAD83, ZONE 17, METERS): NORTHING: 4,441,090.418 EASTING: 526,985.179	UTM (NAD27, ZONE 17, METERS): NORTHING: 4,440,872.080 EASTING: 526,968.994		

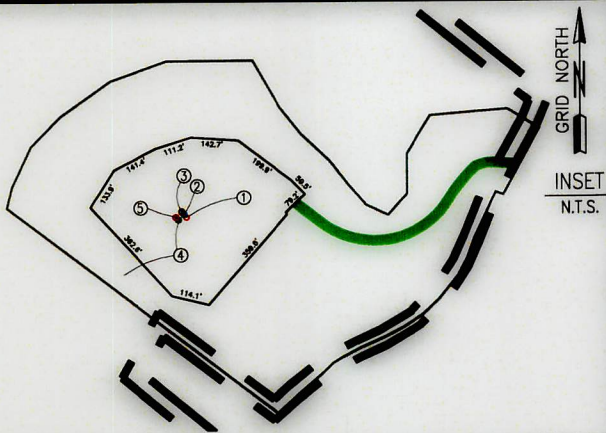

COMPANY:		
OPERATOR'S		
SHANNON FIELDS OHI		
WELL #:		
5H		
DISTRICT:	COUNTY:	STATE:
RICHLAND	OHIO	WEST VIRGINIA
SWN PRODUCTION COMPANY, LLC		
SURFACE HOLES		
1. "SHANNON FIELDS-OHI 210H"		
2. "SHANNON FIELDS-OHI 10H"		
3. "SHANNON FIELDS-OHI 1H"		
4. "SHANNON FIELDS-OHI 3H"		
5. "SHANNON FIELDS-OHI 5H"		
09/26/2025		
REVISIONS:		DATE: 03-31-2025
		DRAWN BY: TMF
		SCALE: 1" = 2500'
		DRAWING NO: ACE-2326
		INTERNAL WELL PLAT

GEOGRAPHIC (NAD83): LATITUDE: 40.088388° LONGITUDE: -80.657893°	GEOGRAPHIC (NAD83): LATITUDE: 40.119317° LONGITUDE: -80.683073°	GEOGRAPHIC (NAD83): LATITUDE: 40.153879° LONGITUDE: -80.696840°
UTM (NAD83, ZONE 17, FEET): NORTHING: 14,559,103.390 EASTING: 1,736,100.600	UTM (NAD83, ZONE 17, FEET): NORTHING: 14,570,339.960 EASTING: 1,729,017.780	UTM (NAD83, ZONE 17, FEET): NORTHING: 14,582,912.190 EASTING: 1,725,126.150
UTM (NAD83, ZONE 17, METERS): NORTHING: 4,437,623.589 EASTING: 529,164.521	UTM (NAD83, ZONE 17, METERS): NORTHING: 4,441,048.502 EASTING: 527,005.673	UTM (NAD83, ZONE 17, METERS): NORTHING: 4,444,880.525 EASTING: 525,819.502
SPCS (NAD 83, WEST VIRGINIA NORTH): NORTHING: 580,638.830 EASTING: 1,644,537.584	SPCS (NAD 83, WEST VIRGINIA NORTH): NORTHING: 591,996.498 EASTING: 1,637,641.254	SPCS (NAD 83, WEST VIRGINIA NORTH): NORTHING: 604,636.787 EASTING: 1,633,959.172
GEOGRAPHIC (NAD27): LATITUDE: 40.088315° LONGITUDE: -80.658093°	GEOGRAPHIC (NAD27): LATITUDE: 40.119245° LONGITUDE: -80.683272°	GEOGRAPHIC (NAD27): LATITUDE: 40.153807° LONGITUDE: -80.697038°
SPCS (NAD 27, WEST VIRGINIA NORTH): NORTHING: 580,602.076 EASTING: 1,675,972.794	SPCS (NAD 27, WEST VIRGINIA NORTH): NORTHING: 591,959.762 EASTING: 1,669,076.645	SPCS (NAD 27, WEST VIRGINIA NORTH): NORTHING: 604,600.032 EASTING: 1,665,394.644
GEOGRAPHIC (NAD83): LATITUDE: 40.087605° LONGITUDE: -80.664752°	GEOGRAPHIC (NAD83): LATITUDE: 40.119791° LONGITUDE: -80.683300°	
UTM (NAD83, ZONE 17, FEET): NORTHING: 14,558,810.940 EASTING: 1,734,183.180	UTM (NAD83, ZONE 17, FEET): NORTHING: 14,570,512.380 EASTING: 1,728,953.800	
UTM (NAD83, ZONE 17, METERS): NORTHING: 4,437,534.450 EASTING: 528,580.090	UTM (NAD83, ZONE 17, METERS): NORTHING: 4,441,101.056 EASTING: 526,986.172	
SPCS (NAD 83, WEST VIRGINIA NORTH): NORTHING: 580,378.410 EASTING: 1,642,614.841	SPCS (NAD 83, WEST VIRGINIA NORTH): NORTHING: 592,170.028 EASTING: 1,637,580.145	
GEOGRAPHIC (NAD27): LATITUDE: 40.087532° LONGITUDE: -80.664952°	GEOGRAPHIC (NAD27): LATITUDE: 40.119719° LONGITUDE: -80.683498°	
SPCS (NAD 27, WEST VIRGINIA NORTH): NORTHING: 580,341.674 EASTING: 1,674,050.108	SPCS (NAD 27, WEST VIRGINIA NORTH): NORTHING: 592,133.292 EASTING: 1,669,015.538	
GEOGRAPHIC (NAD83): LATITUDE: 40.105548° LONGITUDE: -80.675876°	GEOGRAPHIC (NAD83): LATITUDE: 40.136525° LONGITUDE: -80.690410°	
UTM (NAD83, ZONE 17, FEET): NORTHING: 14,565,333.310 EASTING: 1,731,047.980	UTM (NAD83, ZONE 17, FEET): NORTHING: 14,576,598.860 EASTING: 1,726,944.930	
UTM (NAD83, ZONE 17, METERS): NORTHING: 4,439,522.472 EASTING: 527,624.480	UTM (NAD83, ZONE 17, METERS): NORTHING: 4,442,956.218 EASTING: 526,373.867	
SPCS (NAD 83, WEST VIRGINIA NORTH): NORTHING: 586,954.725 EASTING: 1,639,588.111	SPCS (NAD 83, WEST VIRGINIA NORTH): NORTHING: 598,291.537 EASTING: 1,635,672.694	
GEOGRAPHIC (NAD27): LATITUDE: 40.105476° LONGITUDE: -80.676075°	GEOGRAPHIC (NAD27): LATITUDE: 40.136453° LONGITUDE: -80.690608°	
SPCS (NAD 27, WEST VIRGINIA NORTH): NORTHING: 586,917.991 EASTING: 1,671,023.455	SPCS (NAD 27, WEST VIRGINIA NORTH): NORTHING: 598,254.794 EASTING: 1,667,108.130	
GEOGRAPHIC (NAD83): LATITUDE: 40.106243° LONGITUDE: -80.676260°	GEOGRAPHIC (NAD83): LATITUDE: 40.137004° LONGITUDE: -80.690604°	
UTM (NAD83, ZONE 17, FEET): NORTHING: 14,565,585.920 EASTING: 1,730,939.660	UTM (NAD83, ZONE 17, FEET): NORTHING: 14,576,773.280 EASTING: 1,726,889.870	
UTM (NAD83, ZONE 17, METERS): NORTHING: 4,439,599.468 EASTING: 527,591.464	UTM (NAD83, ZONE 17, METERS): NORTHING: 4,443,009.382 EASTING: 526,357.085	
SPCS (NAD 83, WEST VIRGINIA NORTH): NORTHING: 587,209.205 EASTING: 1,639,483.995	SPCS (NAD 83, WEST VIRGINIA NORTH): NORTHING: 598,466.919 EASTING: 1,635,620.541	
GEOGRAPHIC (NAD27): LATITUDE: 40.106171° LONGITUDE: -80.676459°	GEOGRAPHIC (NAD27): LATITUDE: 40.136932° LONGITUDE: -80.690803°	
SPCS (NAD 27, WEST VIRGINIA NORTH): NORTHING: 587,172.472 EASTING: 1,670,919.342	SPCS (NAD 27, WEST VIRGINIA NORTH): NORTHING: 598,430.175 EASTING: 1,667,055.979	

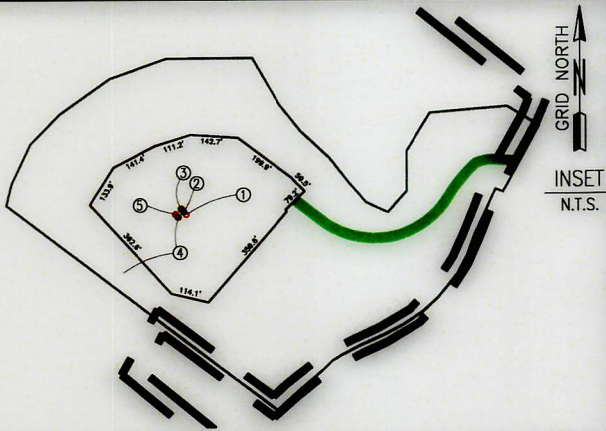

NOTE: ANY UTILITIES OR IMPROVEMENTS SHOWN ON THIS PLAT ARE FROM REASONABLE VISUAL OBSERVATIONS. NO UTILITY COMPANIES WERE CONTACTED FOR UTILITY LINE LOCATIONS.

LEGEND:	
PROPOSED SURFACE HOLE / BOTTOM HOLE	DRILLING UNIT
EXISTING / PRODUCING WELLHEAD	LEASE BOUNDARY
ABANDONED WELL	HARDLINE BOUNDARY
PLUGGED & ABANDONED WELL	UPP 2 > UPPER POINT PLEASANT PATH
LPL* LANDING POINT LOCATION	MAR 2 > MARCELLUS PATH

COMPANY:		
OPERATOR'S SHANNON FIELDS OHI		
WELL #: 5H		
DISTRICT: RICHLAND	COUNTY: OHIO	STATE: WEST VIRGINIA
SWN PRODUCTION COMPANY, LLC SURFACE HOLES		
1. "SHANNON FIELDS-OHI 210H" 2. "SHANNON FIELDS-OHI 10H" 3. "SHANNON FIELDS-OHI 1H" 4. "SHANNON FIELDS-OHI 3H" 5. "SHANNON FIELDS-OHI 5H"		
09/26/2025		
REVISIONS:		DATE: 03-31-2025
		DRAWN BY: TMF
		SCALE: 1" = 2500'
		DRAWING NO: ACE-2326
		INTERNAL WELL PLAT