

WW-7
8-30-06



West Virginia Department of Environmental Protection
Office of Oil and Gas
WELL LOCATION FORM: GPS

API: 4708501234 WELL NO.: Golden #1
FARM NAME: Mayme Golden
RESPONSIBLE PARTY NAME: Viking International Resources Company, Inc.
COUNTY: Ritchie DISTRICT: Murphy
QUADRANGLE: Harrisville
SURFACE OWNER: Ecosystems Investment Partners III, LLC
ROYALTY OWNER: Mayme Golden and Kelly Land & Mineral & Lyndall V.
UTM GPS NORTHING: 4327510.9
UTM GPS EASTING: 481943.62 GPS ELEVATION: 647 674'

The Responsible Party named above has chosen to submit GPS coordinates in lieu of preparing a new well location plat for a plugging permit or assigned API number on the above well. The Office of Oil and Gas will not accept GPS coordinates that do not meet the following requirements:

- Datum: NAD 1983, Zone: 17 North, Coordinate Units: meters, Altitude: height above mean sea level (MSL) – meters.
- Accuracy to Datum – 3.05 meters
- Data Collection Method:
Survey grade GPS : Post Processed Differential
Real-Time Differential
Mapping Grade GPS : Post Processed Differential
Real-Time Differential

4. **Letter size copy of the topography map showing the well location.**

I the undersigned, hereby certify this data is correct to the best of my knowledge and belief and shows all the information required by law and the regulations issued and prescribed by the Office of Oil and Gas.


M. L. Hua Signature Manager-Operations Title 8/15/18 Date

RECEIVED
Office of Oil and Gas

JAN 18 2019

47-085-01234P

\\svr-bridgeport\|SVR-PITTSBURGH\Projects\2018\161-250-GIS\Mapsets\OGI\61250_OXBOW_WELL_PLUGGING_NOV2018.mxd - 11/21/2018 - 1:18:49 PM (identical)

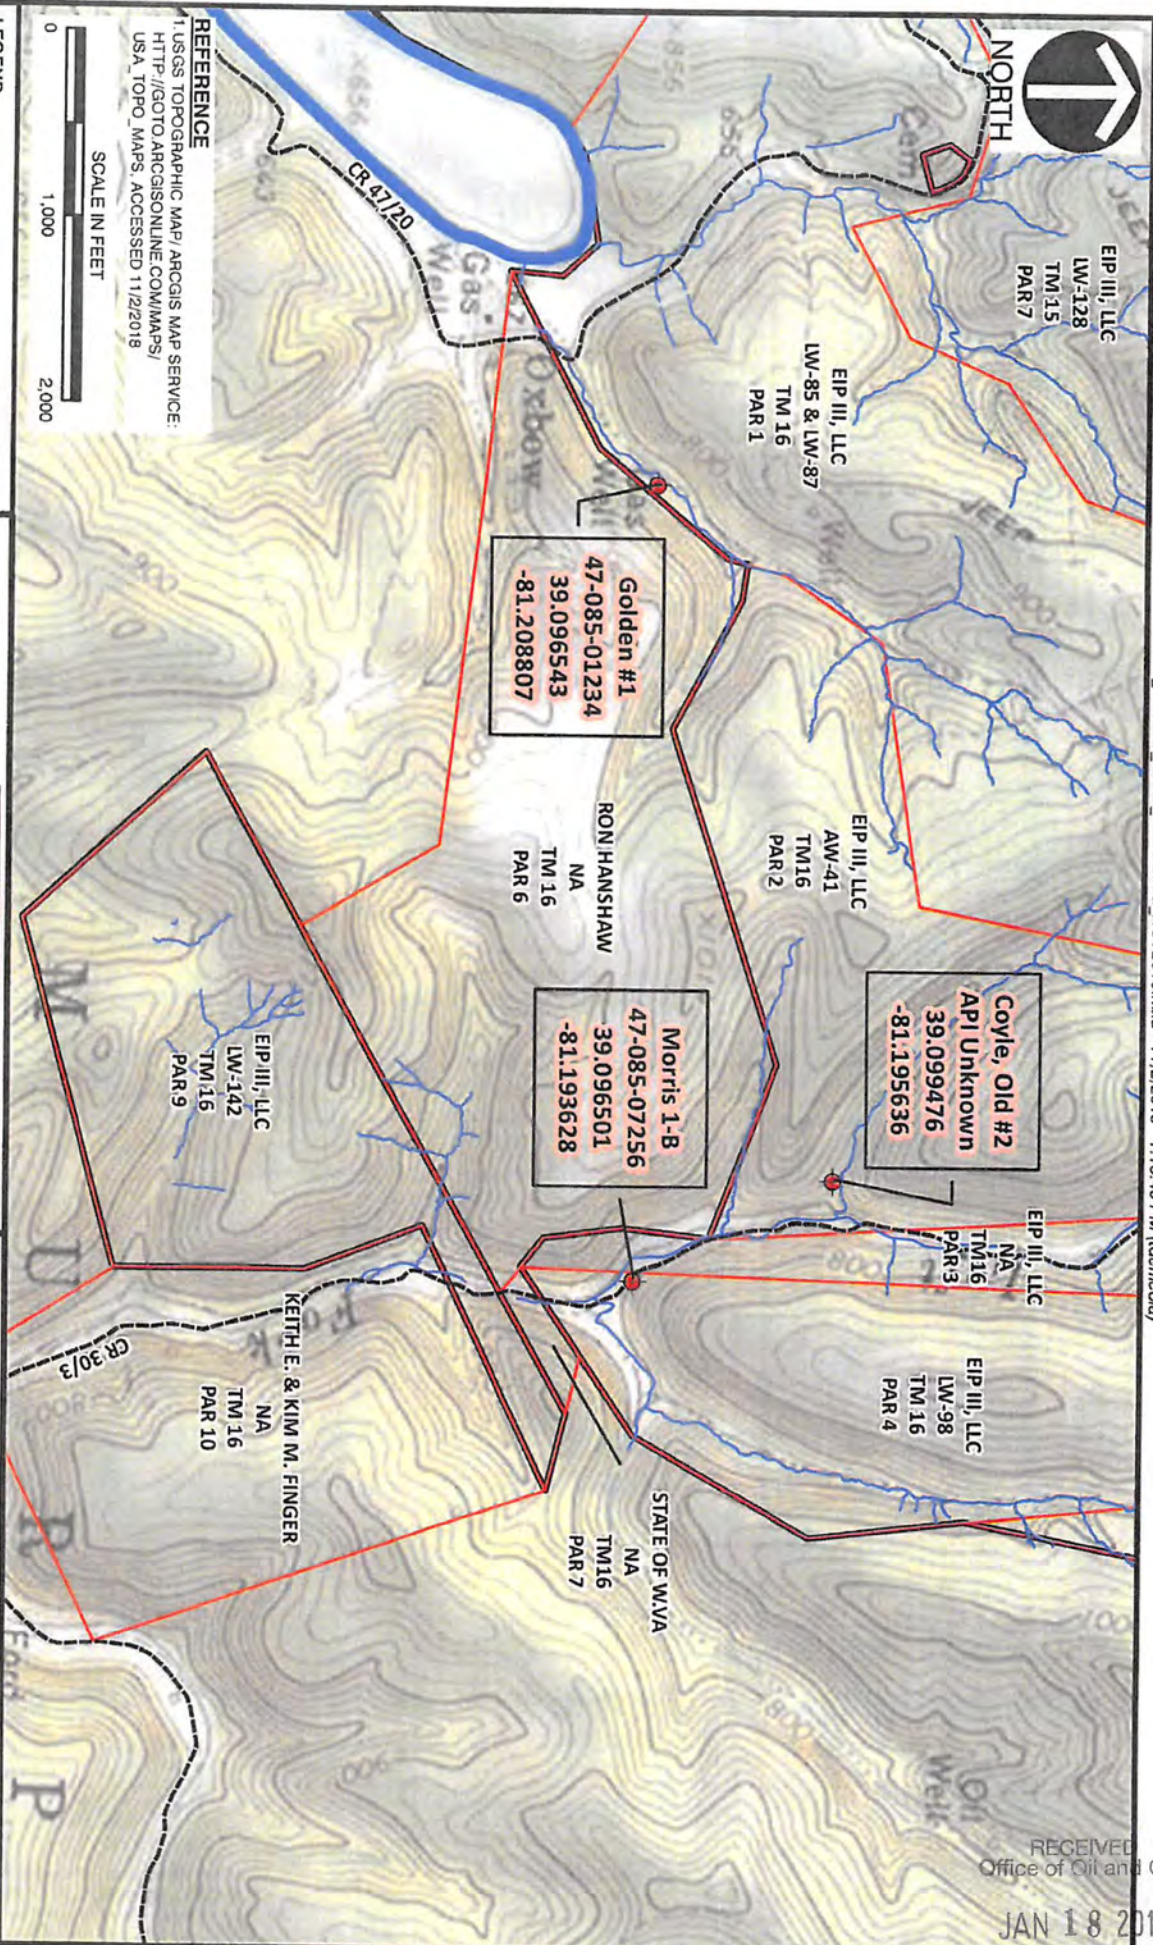

REFERENCE
 1. USGS TOPOGRAPHIC MAP/ ARCGIS MAP SERVICE:
 HTTP://GOTO.ARCGISONLINE.COM/MAPS/
 USA_TOPO_MAPS, ACCESSED 11/2/2018

- LEGEND**
- WELLS (TO BE PLUGGED)
 - COUNTY ROUTE (UNIMPROVED)
 - STREAMS
 - SOUTH FORK HUGHES RIVER
 - PROPERTY OWNERS
 - PROJECT BOUNDARY



Civil & Environmental Consultants, Inc.
 600 Marketplace Avenue, Suite 200 - Bridgeport, WV 26330-9121
 Ph: 304-933-3119 · Toll: 855-488-9539 · Fax: 304-933-3327
 www.ceecinc.com

EIP III CREDIT CO., LLC
 OXBOW MITIGATION BANK
 RITCHIE COUNTY, WEST VIRGINIA
WELL PLUGGING

DRAWN BY:	TAD	CHECKED BY:	MKD	APPROVED BY:	NSO	FIGURE NO.:	-
DATE:	11/02/2018	SCALE:	1" = 1,000'	PROJECT NO.:	161-250.020		

RECEIVED
 Office of Oil and Gas
 JAN 18 2019

161-250.020