4708501731P

WW-7
8-30-06

West Virginia Department of Environmental Protection
Office of Oil and Gas
WELL LOCATION FORM: GPS

API: 47-085-01731 WELL NO.: A Bell1

FARM NAME: Erma L Vannritter

RESPONSIBLE PARTY NAME: J F Deem

COUNTY: Ritchie DISTRICT: Union

QUADRANGLE: Pullman

SURFACE OWNER: Erma L Vannritter

ROYALTY OWNER: _____

UTM GPS NORTHING: 4,329,545

UTM GPS EASTING: 510,789 GPS ELEVATION: 256M 839.7FT

The Responsible Party named above has chosen to submit GPS coordinates in lieu of preparing a new well location plat for a plugging permit or assigned API number on the above well. The Office of Oil and Gas will not accept GPS coordinates that do not meet the following requirements:

1. Datum: NAD 1983, Zone: 17 North, Coordinate Units: meters, Altitude: height above mean sea level (MSL) – meters.
2. Accuracy to Datum – 3.05 meters
3. Data Collection Method:

Survey grade GPS ____: Post Processed Differential ____

Real-Time Differential ____

Mapping Grade GPS X: Post Processed Differential ____

Real-Time Differential ____

4. **Letter size copy of the topography map showing the well location.**

I the undersigned, hereby certify this data is correct to the best of my knowledge and belief and shows all the information required by law and the regulations issued and prescribed by the Office of Oil and Gas.

Signature | Owner (Title) | 9/30/13 (Date)

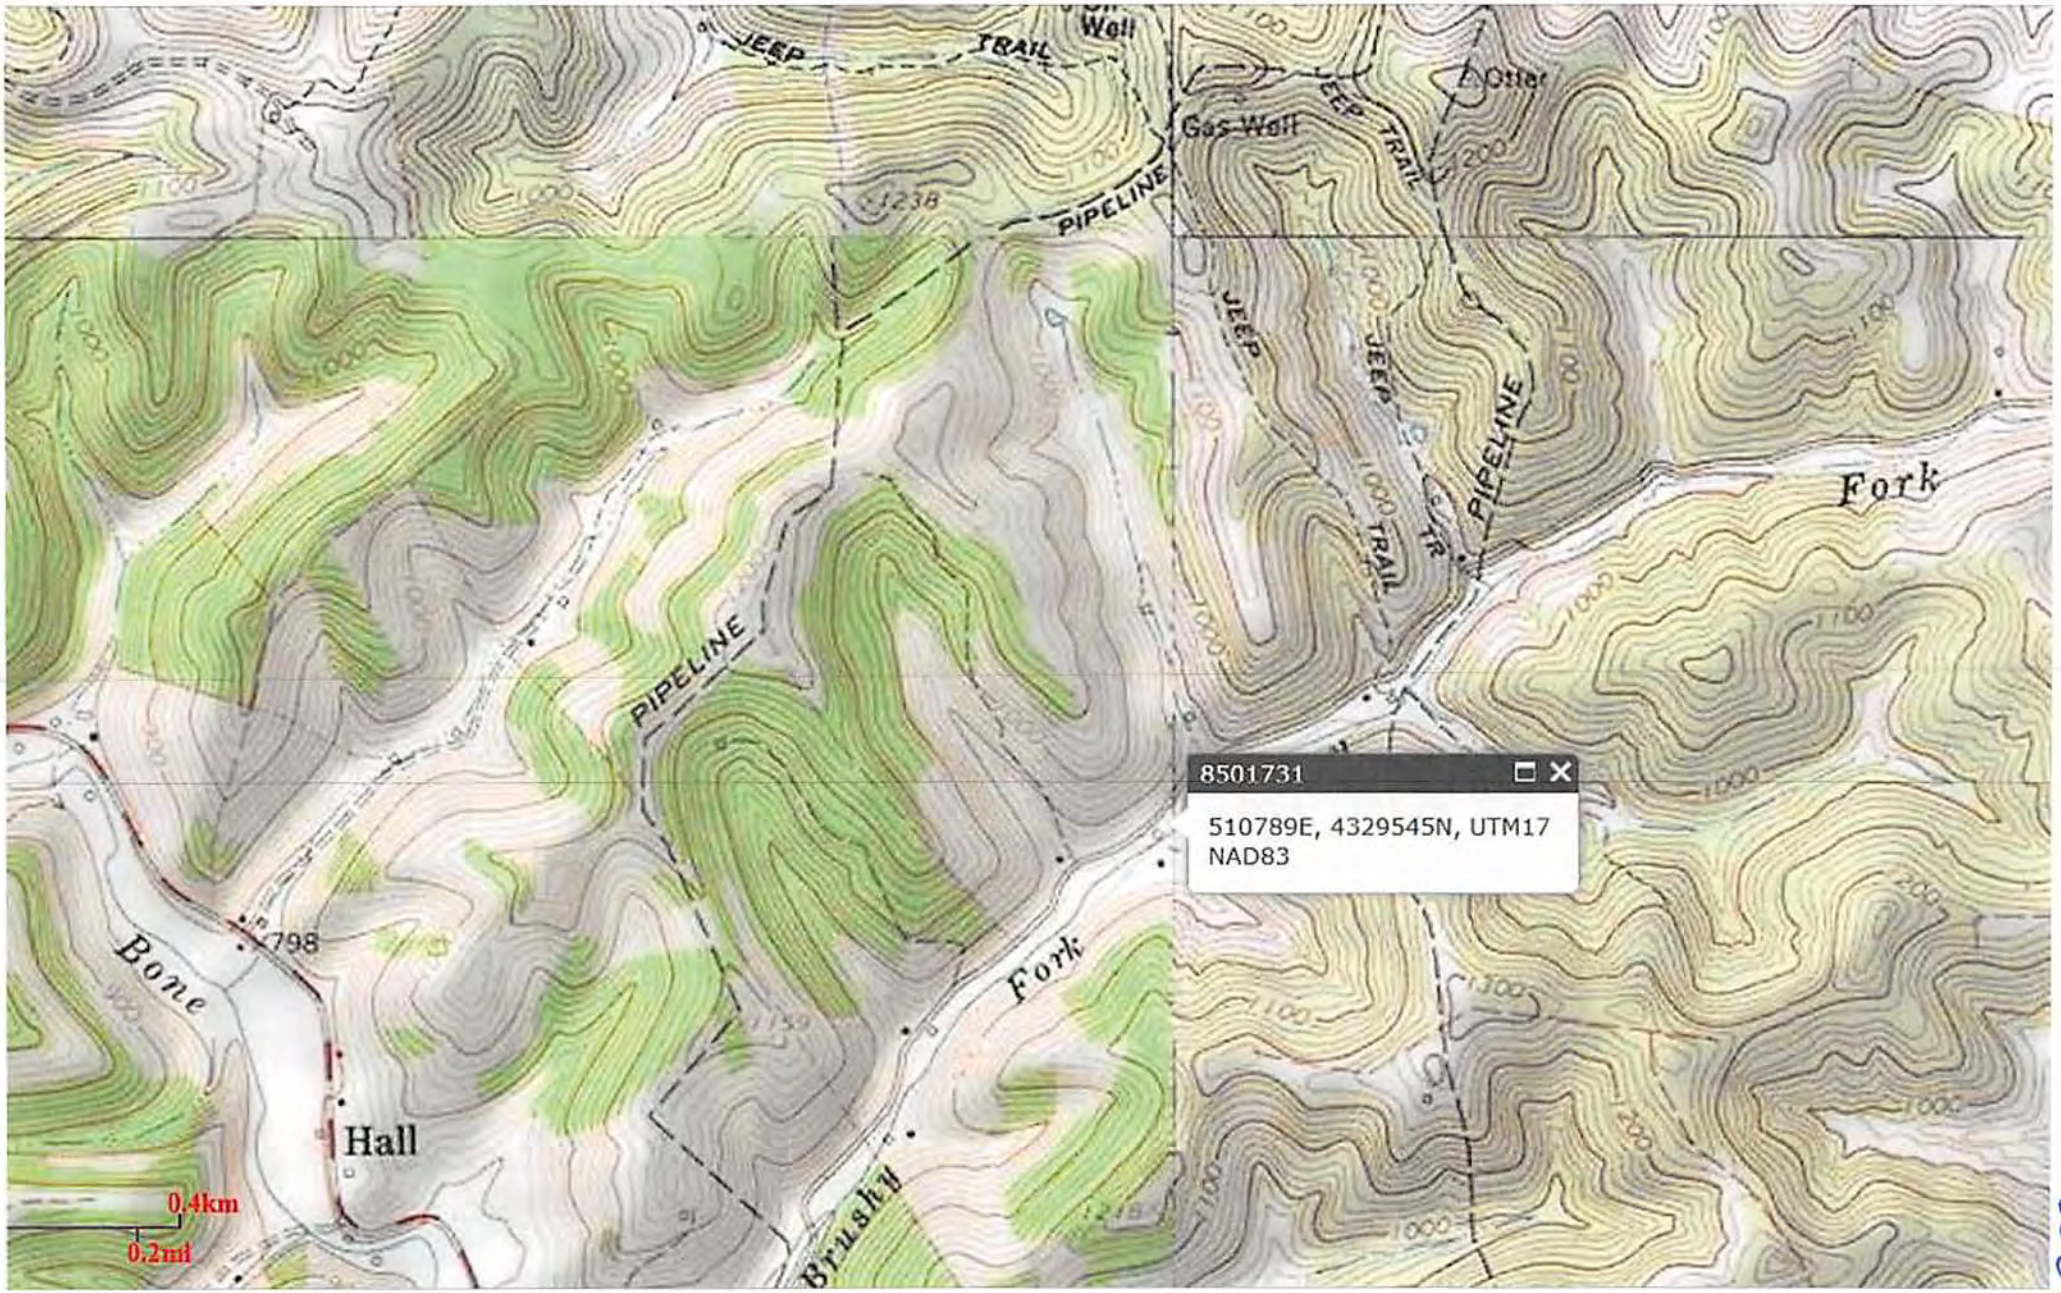
JEEP TRAIL
Well
Gas Well
Otter
PIPELINE
JEEP TRAIL
JEEP TRAIL
JEEP TR
PIPELINE
PIPELINE
Fork
Fork
Brushy
Bone
Hall
798
0.4km
0.2mi
8501731
510789E, 4329545N, UTM17
NAD83

8501731P