


4708502223P

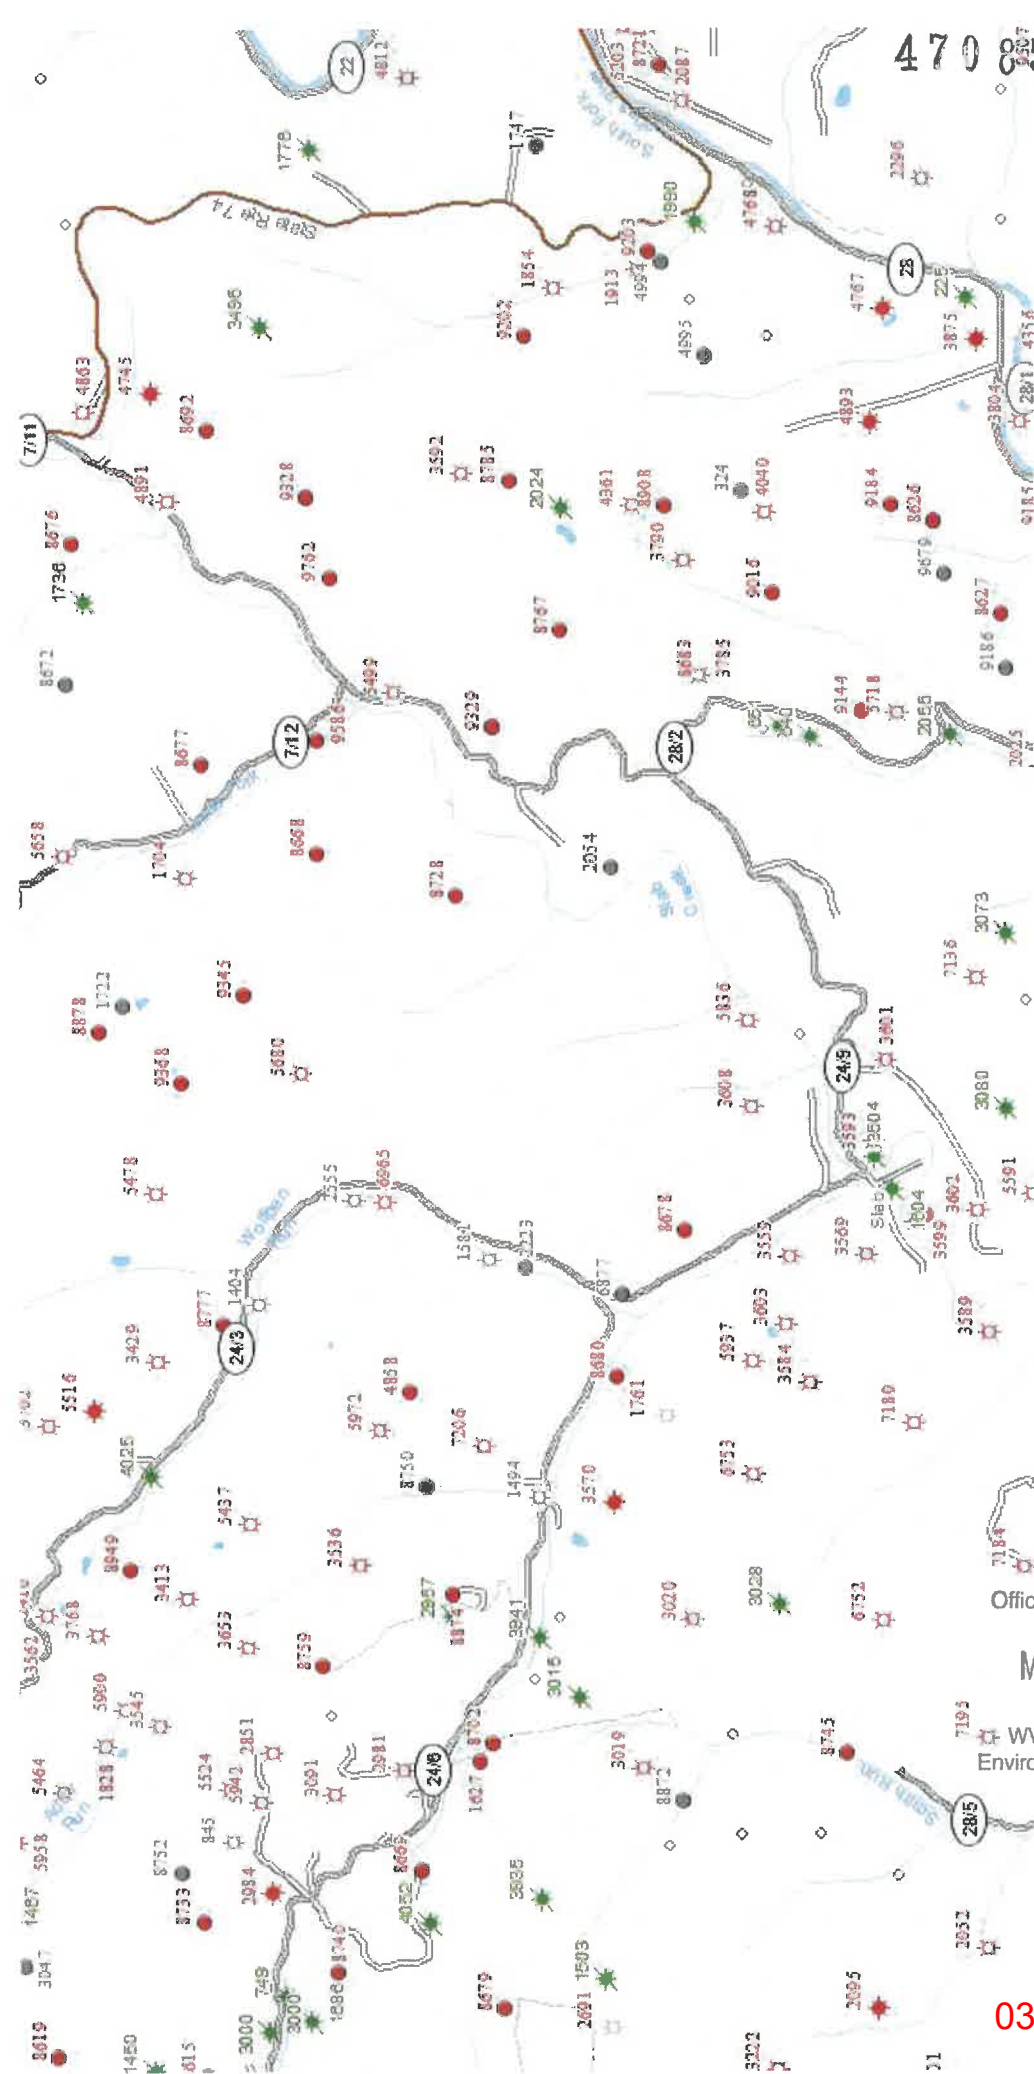





RECEIVED  
Office of Oil and Gas

MAR 25 2025

WV Department of  
Environmental Protection

03/28/2025

**Oil&Gas****Wells, Horizontal Only****WellStatus**


-  Active Well
-  Permit Issued
-  Permit Application
-  Plugged

**Wells, Active Status Only****WellUse**

-  Brine Disposal
-  Fluid Injection
-  Gas Production
-  House Gas
-  Observation
-  Oil Production
-  Production
-  Solution Mining
-  Storage
-  Vent
-  <all other values>

**Wells, Other than Active Status****WellUse**

-  Brine Disposal
-  Fluid Injection
-  Gas Production
-  House Gas
-  Observation
-  Oil Production
-  Production
-  Solution Mining

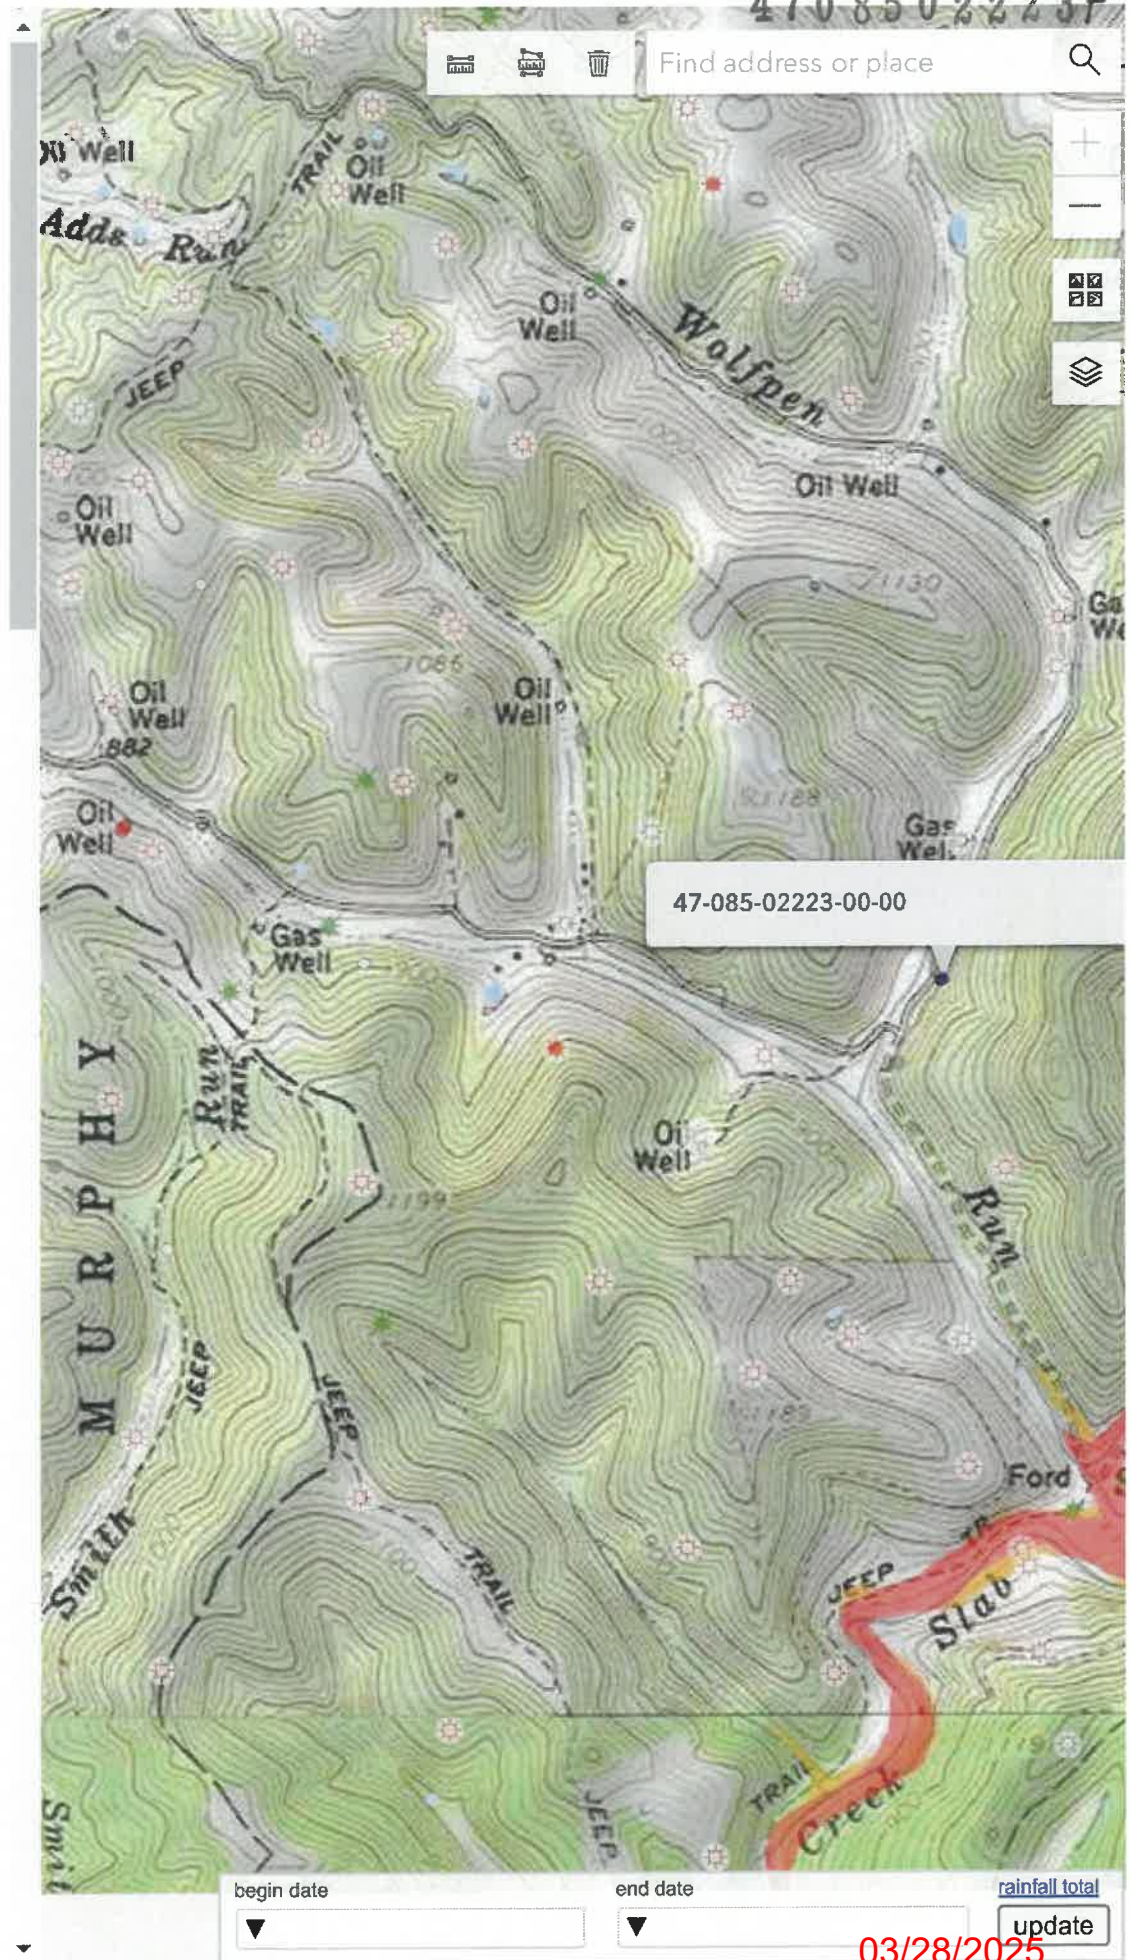



WW-7  
8-30-06



West Virginia Department of Environmental Protection  
Office of Oil and Gas  
**WELL LOCATION FORM: GPS**

API: 47 - 085 - 02223 WELL NO.: # 1  
FARM NAME: CARL EXLINE JR  
RESPONSIBLE PARTY NAME: WV DEP PAID PLUGGING CONTRACT  
COUNTY: RITCHIE - 085 DISTRICT: UNION  
QUADRANGLE: PULLMAN  
SURFACE OWNER: CARL EXLINE JR  
ROYALTY OWNER: MAXWELL HEIRS  
UTM GPS NORTHING: 4332168.9  
UTM GPS EASTING: 501745.7 GPS ELEVATION: 804'

The Responsible Party named above has chosen to submit GPS coordinates in lieu of preparing a new well location plat for a plugging permit or assigned API number on the above well. The Office of Oil and Gas will not accept GPS coordinates that do not meet the following requirements:

1. Datum: NAD 1983, Zone: 17 North, Coordinate Units: meters, Altitude: height above mean sea level (MSL) – meters.
2. Accuracy to Datum – 3.05 meters
3. Data Collection Method:

Survey grade GPS \_\_\_\_: Post Processed Differential \_\_\_\_

Real-Time Differential \_\_\_\_

Mapping Grade GPS X: Post Processed Differential \_\_\_\_

Real-Time Differential \_\_\_\_

4. **Letter size copy of the topography map showing the well location.**

I the undersigned, hereby certify this data is correct to the best of my knowledge and belief and shows all the information required by law and the regulations issued and prescribed by the Office of Oil and Gas.



Signature

**INSPECTOR**

Title

**1/21/2025**

Date

RECEIVED  
Office of Oil and Gas

**MAR 25 2025**

WV Department of  
Environmental Protection

03/28/2025