

WW-7
8-30-06



RECEIVED
Office of Oil and Gas

DEC 26 2018

WV Department of
Environmental Protection

47-085-03998P
03/08/2019

West Virginia Department of Environmental Protection
Office of Oil and Gas
WELL LOCATION FORM: GPS

API: 47-085-03998 WELL NO.: WV 604880 (W. H. Hall #4880)

FARM NAME: W. H. Hall

RESPONSIBLE PARTY NAME: EQT Production Company

COUNTY: Ritchie DISTRICT: Union

QUADRANGLE: Auburn 7.5'

SURFACE OWNER: Brian & Rochelle Taschler

ROYALTY OWNER: Piney Holdings

UTM GPS NORTHING: 4329807

UTM GPS EASTING: 513316 GPS ELEVATION: 341 m (1118 ft)

The Responsible Party named above has chosen to submit GPS coordinates in lieu of preparing a new well location plat for a plugging permit or assigned API number on the above well. The Office of Oil and Gas will not accept GPS coordinates that do not meet the following requirements:

- 1. Datum: NAD 1983, Zone: 17 North, Coordinate Units: meters, Altitude: height above mean sea level (MSL) – meters.
- 2. Accuracy to Datum – 3.05 meters
- 3. Data Collection Method:

Survey grade GPS _____ : Post Processed Differential _____
Real-Time Differential _____
Mapping Grade GPS X : Post Processed Differential X
Real-Time Differential _____

- 4. **Letter size copy of the topography map showing the well location.**

I the undersigned, hereby certify this data is correct to the best of my knowledge and belief and shows all the information required by law and the regulations issued and prescribed by the Office of Oil and Gas.

Signature

D5 # 2180
Title

11/13/18
Date

47-085-03998P

03/08/2019
RECEIVED
Office of Oil and Gas

Topo Quad: Auburn 7.5'

Scale: 1" = 2000'

County: Ritchie

Date: November 08, 2018

DEC 26 2018


District: Union

Project No: 68-38-00-08

WV Department of
Environmental Protection

47-085-03998 WV 604880 (W. H. Hall #4880)

Topo

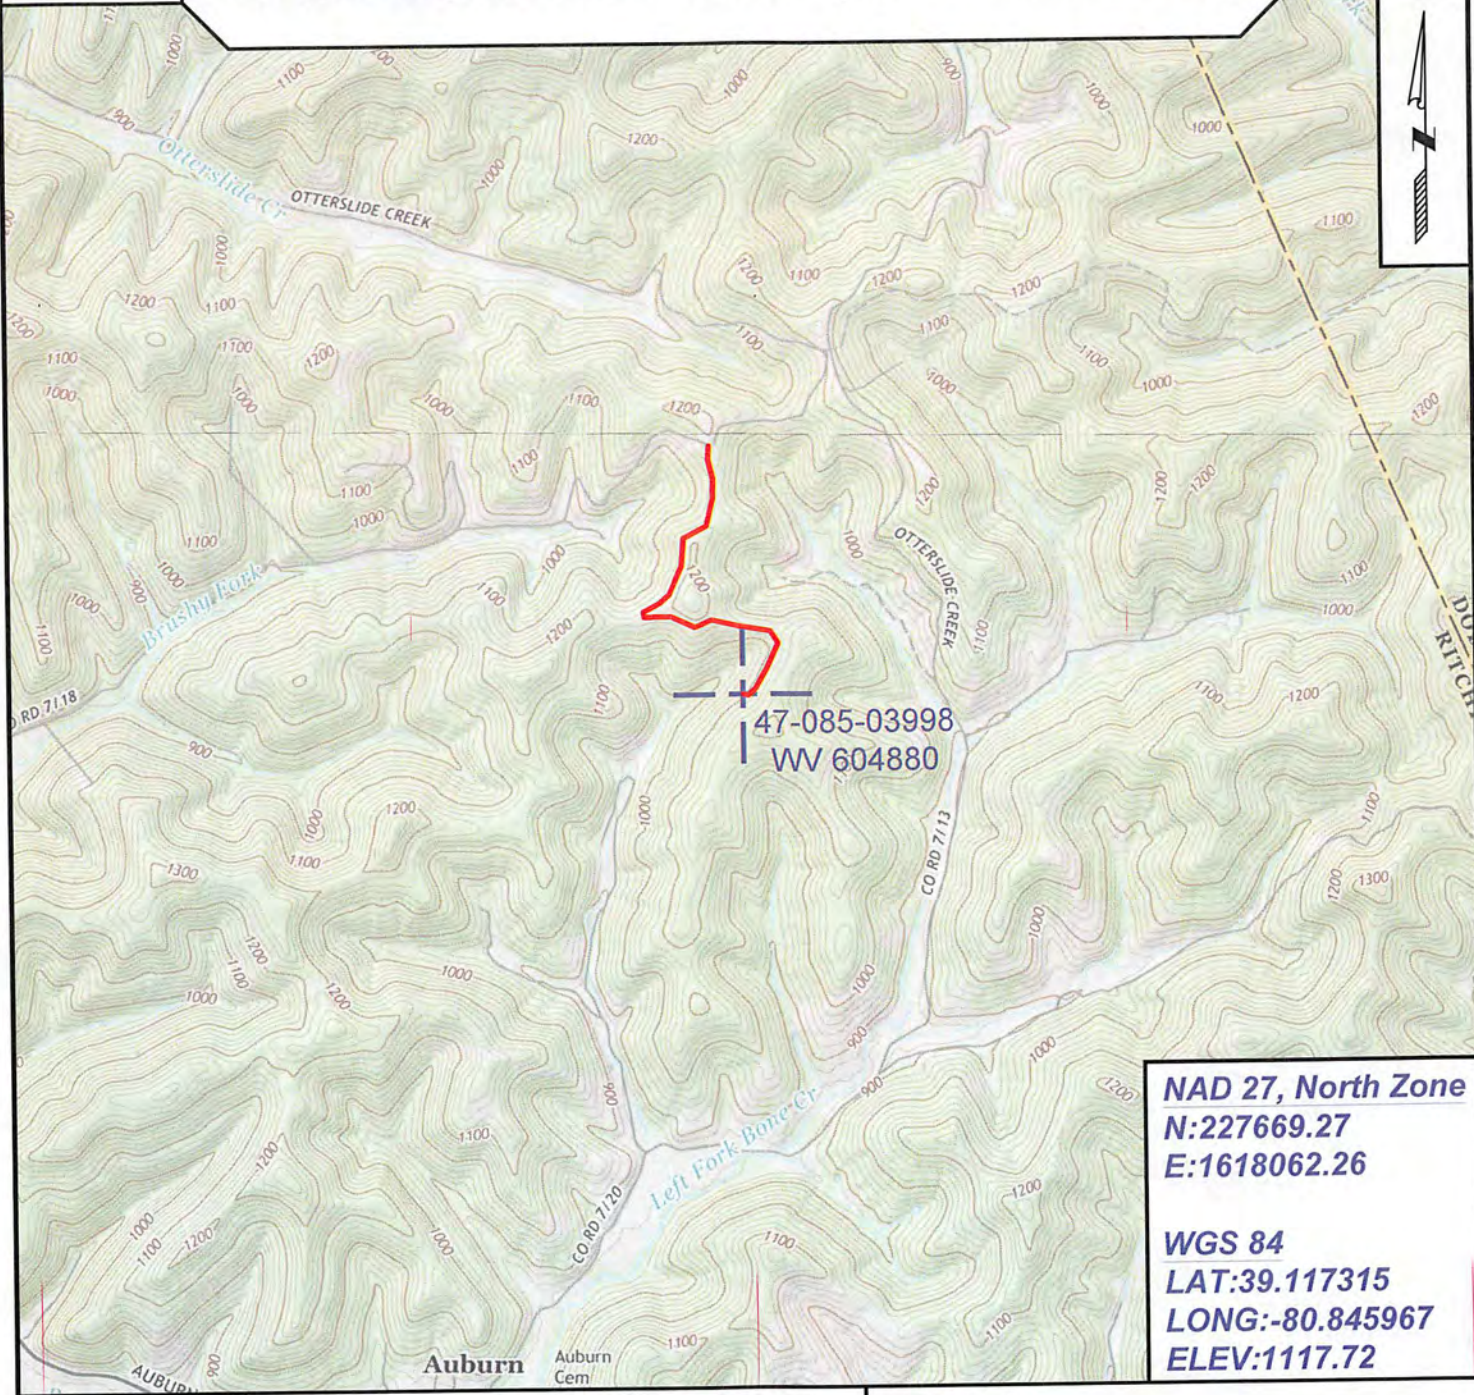

NAD 27, North Zone
N:227669.27
E:1618062.26

WGS 84
LAT:39.117315
LONG:-80.845967
ELEV:1117.72



SURVEYING AND MAPPING SERVICES PERFORMED BY:
ALLEGHENY SURVEYS, INC.
 1-800-482-8606
 237 Birch River Road
 Birch River, WV 26610
 PH: (304) 649-8606
 FAX: (304) 649-8608

PREPARED FOR:
EQT Production Company
 2400 Ansys Drive, Suite 200
 Cannonsburg, PA 15317