

WW-7
8-30-06



West Virginia Department of Environmental Protection
Office of Oil and Gas
WELL LOCATION FORM: GPS

API: 47-085-04244 WELL NO.: WV 651076 (S. Marsh #391)

FARM NAME: Sherman Marsh

RESPONSIBLE PARTY NAME: EQT Production Company

COUNTY: Ritchie DISTRICT: Clay

QUADRANGLE: Pennsboro 7.5'

SURFACE OWNER: William Barr Broadwater and Janet K. Broadwater

ROYALTY OWNER: Carol Marsh

UTM GPS NORTHING: 4347715

UTM GPS EASTING: 506677 GPS ELEVATION: 305 m (1002 ft)

The Responsible Party named above has chosen to submit GPS coordinates in lieu of preparing a new well location plat for a plugging permit or assigned API number on the above well. The Office of Oil and Gas will not accept GPS coordinates that do not meet the following requirements:

1. Datum: NAD 1983, Zone: 17 North, Coordinate Units: meters, Altitude: height above mean sea level (MSL) – meters.
2. Accuracy to Datum – 3.05 meters
3. Data Collection Method:
Survey grade GPS : Post Processed Differential
Real-Time Differential
Mapping Grade GPS X: Post Processed Differential X
Real-Time Differential

4. Letter size copy of the topography map showing the well location.

I the undersigned, hereby certify this data is correct to the best of my knowledge and belief and shows all the information required by law and the regulations issued and prescribed by the Office of Oil and Gas.

Signature

PS # 2180
Title

RECEIVED
Office of Oil and Gas
3/20/15
Date

APR 2 2015
WV Department of
Environmental Protection
07/03/2015

Topo Quad: Pennsboro 7.5'

Scale: 1" = 2000'

County: Ritchie

Date: March 17, 2015


District: Clay

Project No: 68-30-00-08

Water

47-085-04244 WV 651076 (S. Marsh #391)

No potential water wells within 1000'

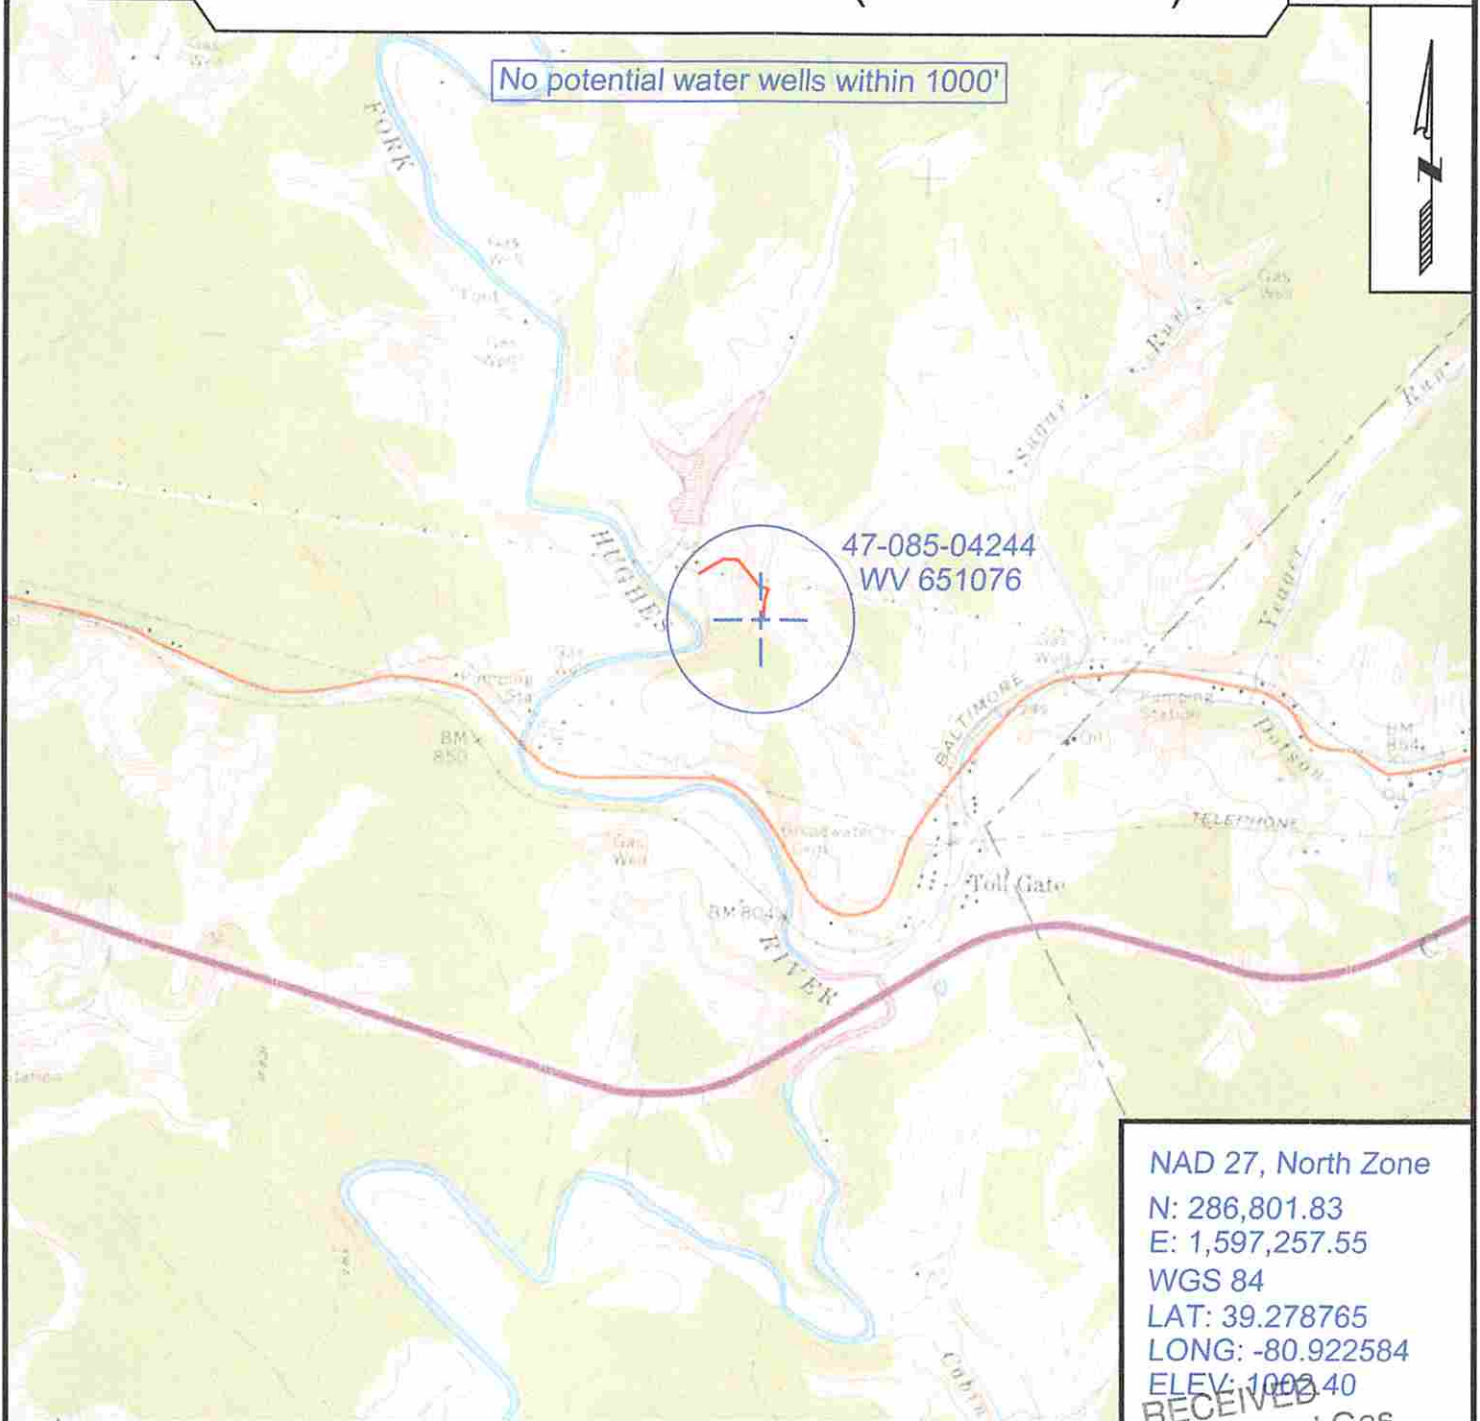

47-085-04244
WV 651076

NAD 27, North Zone
 N: 286,801.83
 E: 1,597,257.55
 WGS 84
 LAT: 39.278765
 LONG: -80.922584
 ELEV: 1003.40



SURVEYING AND MAPPING SERVICES PERFORMED BY:

ALLEGHENY SURVEYS, INC.

1-800-482-8606
 237 Birch River Road
 Birch River, WV 26610
 PH: (304) 649-8606
 FAX: (304) 649-8608

PREPARED FOR:

Office of Oil and Gas
EQT Production Company

P.O. Box 280
 Bridgeport, WV 26330

APR 0 2015
 WV Department of
 Environmental Protection
 RECEIVED
 07/03/2015