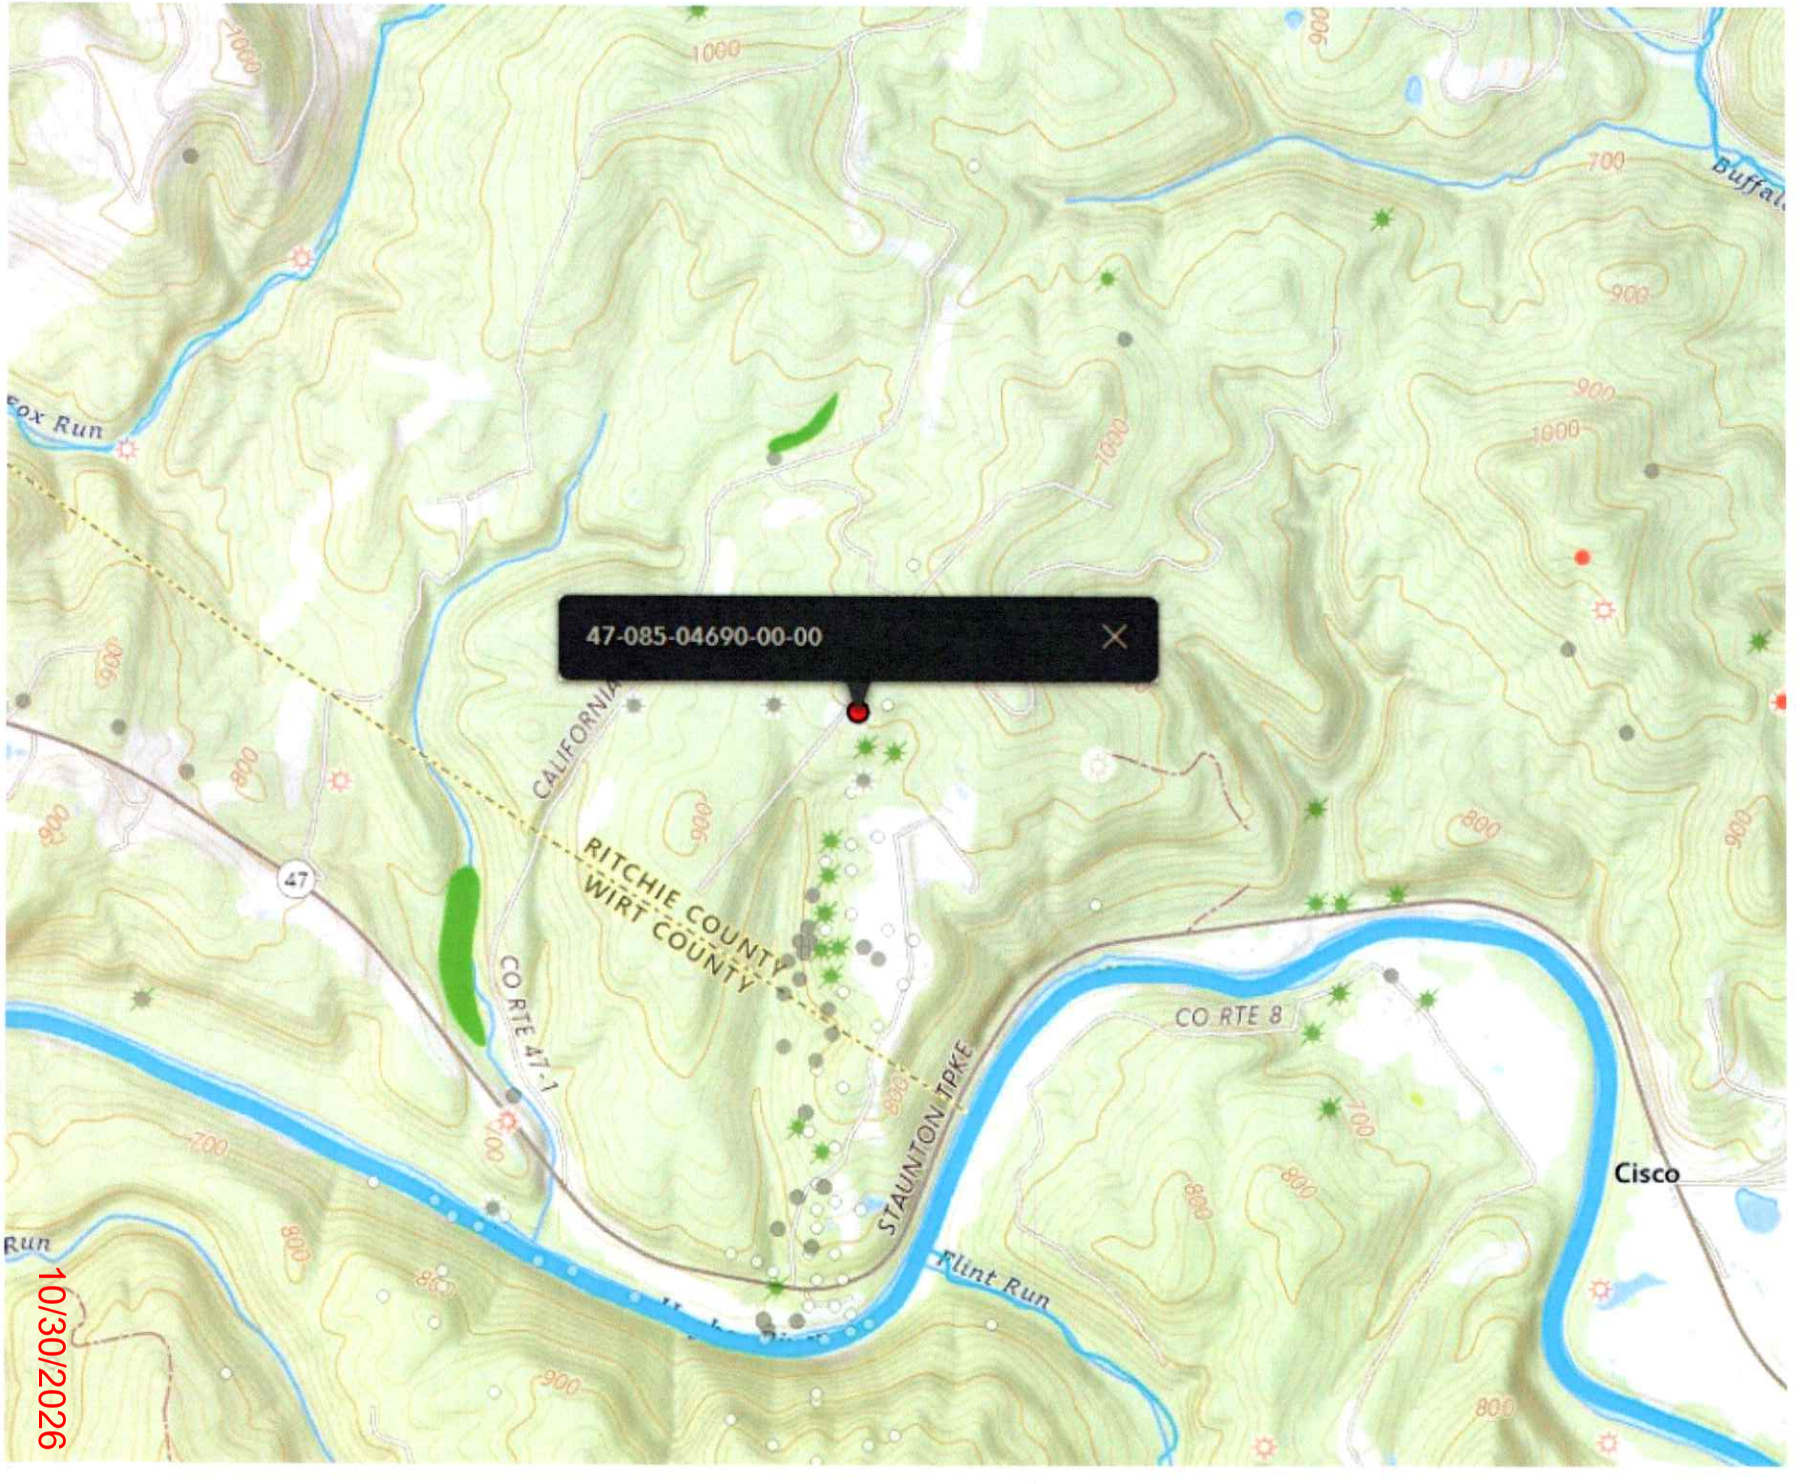
47-085-04690-00-00
CALIFORNIA
RITCHIE COUNTY
WIRT COUNTY
CO RTE 47-1
CO RTE 8
STAUNTON TPKE
Flint Run
Cisco
47
10/30/2026

WW-7
8-30-06

West Virginia Department of Environmental Protection
Office of Oil and Gas
WELL LOCATION FORM: GPS

API: 47-085-04690 **WELL NO.:** #2

FARM NAME: S.L DAUBENSPECK

RESPONSIBLE PARTY NAME: GARY P. & SHIRLEY J. JONES

COUNTY: RITCHIE **DISTRICT:** GRANT

QUADRANGLE: PETROLEUM

SURFACE OWNER: WESTVACO

ROYALTY OWNER: WESTVACO

UTM GPS NORTHING: 4331974.93

UTM GPS EASTING: 473878.4 **GPS ELEVATION:** 850

The Responsible Party named above has chosen to submit GPS coordinates in lieu of preparing a new well location plat for a plugging permit or assigned API number on the above well. The Office of Oil and Gas will not accept GPS coordinates that do not meet the following requirements:

1. Datum: NAD 1983, Zone: 17 North, Coordinate Units: meters, Altitude: height above mean sea level (MSL) – meters.
2. Accuracy to Datum – 3.05 meters
3. Data Collection Method:

Survey grade GPS ____: Post Processed Differential _____

Real-Time Differential _____

Mapping Grade GPS ____: Post Processed Differential _____

Real-Time Differential _____

RECEIVED
Office of Oil and Gas
SEP 22 2026
WV Department of Environmental Protection

4. **Letter size copy of the topography map showing the well location.**

I the undersigned, hereby certify this data is correct to the best of my knowledge and belief and shows all the information required by law and the regulations issued and prescribed by the Office of Oil and Gas.

Gary P. Jones — Signature

INDIVIDUAL SELF — Title

09/14/2026 — Date

10/30/2026