

WW-7  
8-30-06



West Virginia Department of Environmental Protection  
Office of Oil and Gas  
**WELL LOCATION FORM: GPS**

API: 47-085-05171 P WELL NO.: WV 657226 (S. M. Grimm #1845)  
 FARM NAME: S. M. Grimm  
 RESPONSIBLE PARTY NAME: EQT Production Company  
 COUNTY: Ritchie, DISTRICT: Union  
 QUADRANGLE: Pullman 7.5'  
 SURFACE OWNER: Samuel & Charlotte Grimm  
 ROYALTY OWNER: Jessie Jeanette Wilburn, et al.  
 UTM GPS NORTHING: 4335385  
 UTM GPS EASTING: 505564 GPS ELEVATION: 254 m (835 ft)

The Responsible Party named above has chosen to submit GPS coordinates in lieu of preparing a new well location plat for a plugging permit or assigned API number on the above well. The Office of Oil and Gas will not accept GPS coordinates that do not meet the following requirements:

1. Datum: NAD 1983, Zone: 17 North, Coordinate Units: meters, Altitude: height above mean sea level (MSL) – meters.
2. Accuracy to Datum – 3.05 meters
3. Data Collection Method:

Survey grade GPS \_\_\_\_\_ : Post Processed Differential \_\_\_\_\_  
 Real-Time Differential \_\_\_\_\_

Mapping Grade GPS X : Post Processed Differential X  
 Real-Time Differential \_\_\_\_\_

4. **Letter size copy of the topography map showing the well location.**

I the undersigned, hereby certify this data is correct to the best of my knowledge and belief and shows all the information required by law and the regulations issued and prescribed by the Office of Oil and Gas.

*Steve O'Brien*  
Signature

PS# 2180  
Title

3/27/15  
Date

Received  
Office of Oil & Gas

APR 08 2015

06/12/2015

47 08 50 51 71

Topo Quad: Pullman 7.5'

Scale: 1" = 2000'

County: Ritchie


Date: March 25, 2015

District: Union

Project No: 68-38-00-08

47-085-05171 **P** WV 657226 (S. M. Grimm #1845)

Topo

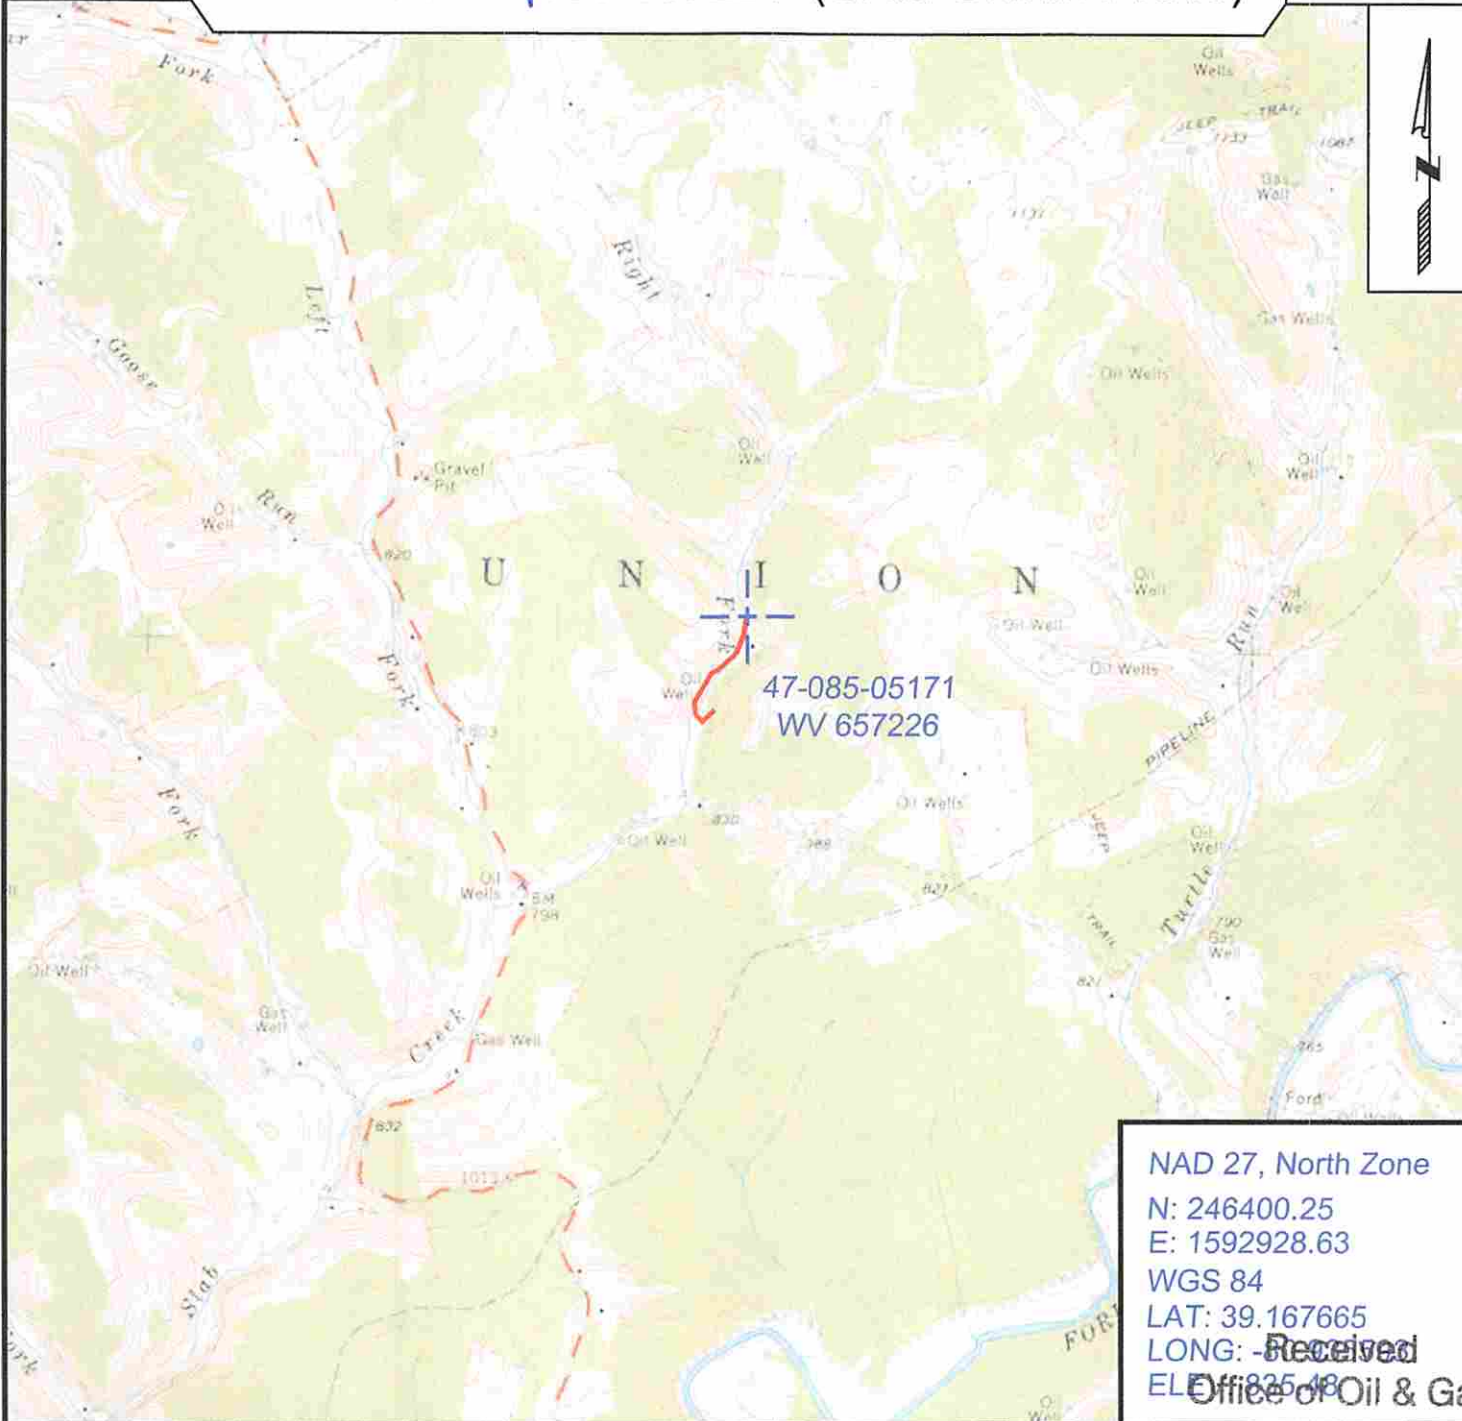

47-085-05171  
WV 657226

NAD 27, North Zone  
 N: 246400.25  
 E: 1592928.63  
 WGS 84  
 LAT: 39.167665  
 ELEV: 825.48

Received  
Office of Oil & Gas



SURVEYING AND MAPPING SERVICES PERFORMED BY:

**ALLEGHENY SURVEYS, INC.**

1-800-482-8606  
237 Birch River Road  
Birch River, WV 26610  
PH: (304) 649-8606  
FAX: (304) 649-8608

PREPARED FOR:

APR 08 2015

**EQT Production Company**

P.O. Box 280  
Bridgeport, WV 26330

06/12/2015