WW-7	
8-30-06	



nvironmental Protection nd Gas		
FORM: GPS		
WELL NO.: 32		
DISTRICT: Grant		
man, Sr.		
rman, Sr.		
GPS ELEVATION: 810'		

The Responsible Party named above has chosen to submit GPS coordinates in lieu of preparing a new well location plat for a plugging permit or assigned API number on the above well. The Office of Oil and Gas will not accept GPS coordinates that do not met AY 1 0 2021 the following requirements:

- Datum: NAD 1983, Zone: 17 North, Coordinate Units: meters, Altitude: WV Department of height above mean sea level (MSL) - meters.
- 2. Accuracy to Datum 3.05 meters
- 3. Data Collection Method:

Survey grade GPS × \_\_\_: Post Processed Differential \_\_


Real-Time Differential X

Mapping Grade GPS \_\_\_\_: Post Processed Differential \_\_\_\_

Real-Time Differential

4. Letter size copy of the topography map showing the well location. I the undersigned, hereby certify this data is correct to the best of my knowledge and belief and shows all the information required by law and the regulations issued and prescribed by the Office of Oil and Gas.

Buttony	Noodu	Senior Regulatory Analyst	5/4/21	
Signature	, voor g	Title	Date	
0				07/02/2021

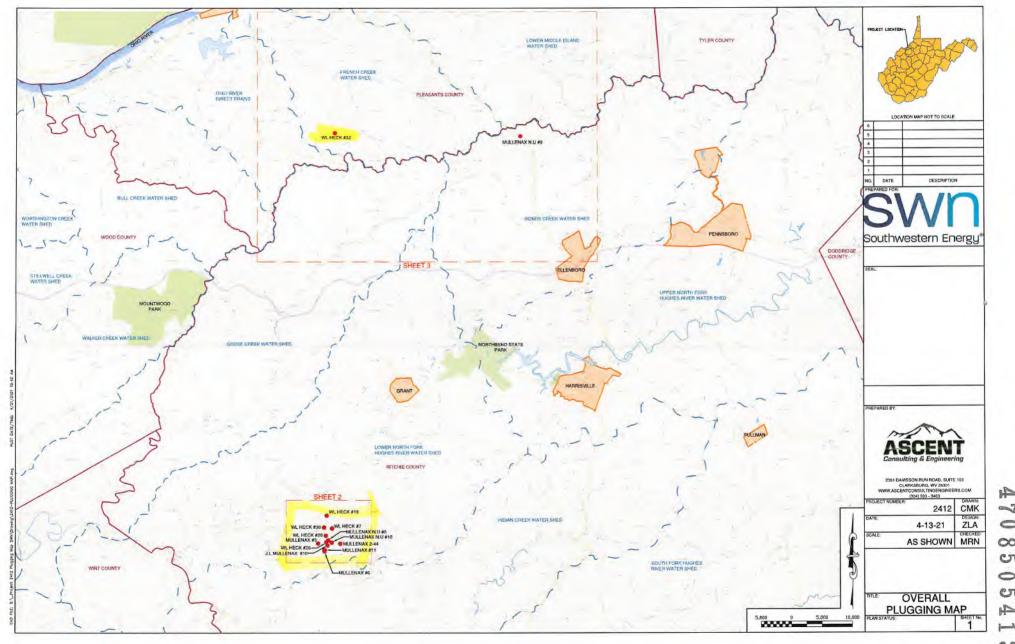

CT P 1-2 00