



West Virginia Department of Environmental Protection
Office of Oil and Gas
WELL LOCATION FORM: GPS

API: 47-085-05676 WELL NO.: WV 657326 (D. P. Mullenix #1865)

FARM NAME: D. P. Mullenix

RESPONSIBLE PARTY NAME: EQT Production Company

COUNTY: Ritchie DISTRICT: Union

QUADRANGLE: Pullman 7.5'

SURFACE OWNER: Denver and Donna Rae Mullenix (Life Estate)

ROYALTY OWNER: Denver and Donna Rae Mullenix (Life Estate)

UTM GPS NORTHING: 4336294

UTM GPS EASTING: 501962 GPS ELEVATION: 345 m (1132 ft)

The Responsible Party named above has chosen to submit GPS coordinates in lieu of preparing a new well location plat for a plugging permit or assigned API number on the above well. The Office of Oil and Gas will not accept GPS coordinates that do not meet the following requirements:

1. Datum: NAD 1983, Zone: 17 North, Coordinate Units: meters, Altitude: height above mean sea level (MSL) – meters.
2. Accuracy to Datum – 3.05 meters
3. Data Collection Method:

Survey grade GPS _____ : Post Processed Differential _____ **RECEIVED**
 Real-Time Differential _____ **Office of Oil and Gas**
 Mapping Grade GPS X : Post Processed Differential X
 Real-Time Differential _____ **APR 23 2018**

4. **Letter size copy of the topography map showing the well location.**

I the undersigned, hereby certify this data is correct to the best of my knowledge and belief and shows all the information required by law and the regulations issued and prescribed by the Office of Oil and Gas.

WV Department of Environmental Protection

[Signature]
Signature

PS # 2100
Title

3/22/18
Date

4708505676P

Topo Quad: Pullman 7.5'

Scale: 1" = 2000'

County: Ritchie

Date: February 28, 2018


District: Union

Project No: 68-38-00-08

Water

47-085-05676 WV 657326 (D.P. Mullenix #1865)

No Potential Water Sources within 1000'

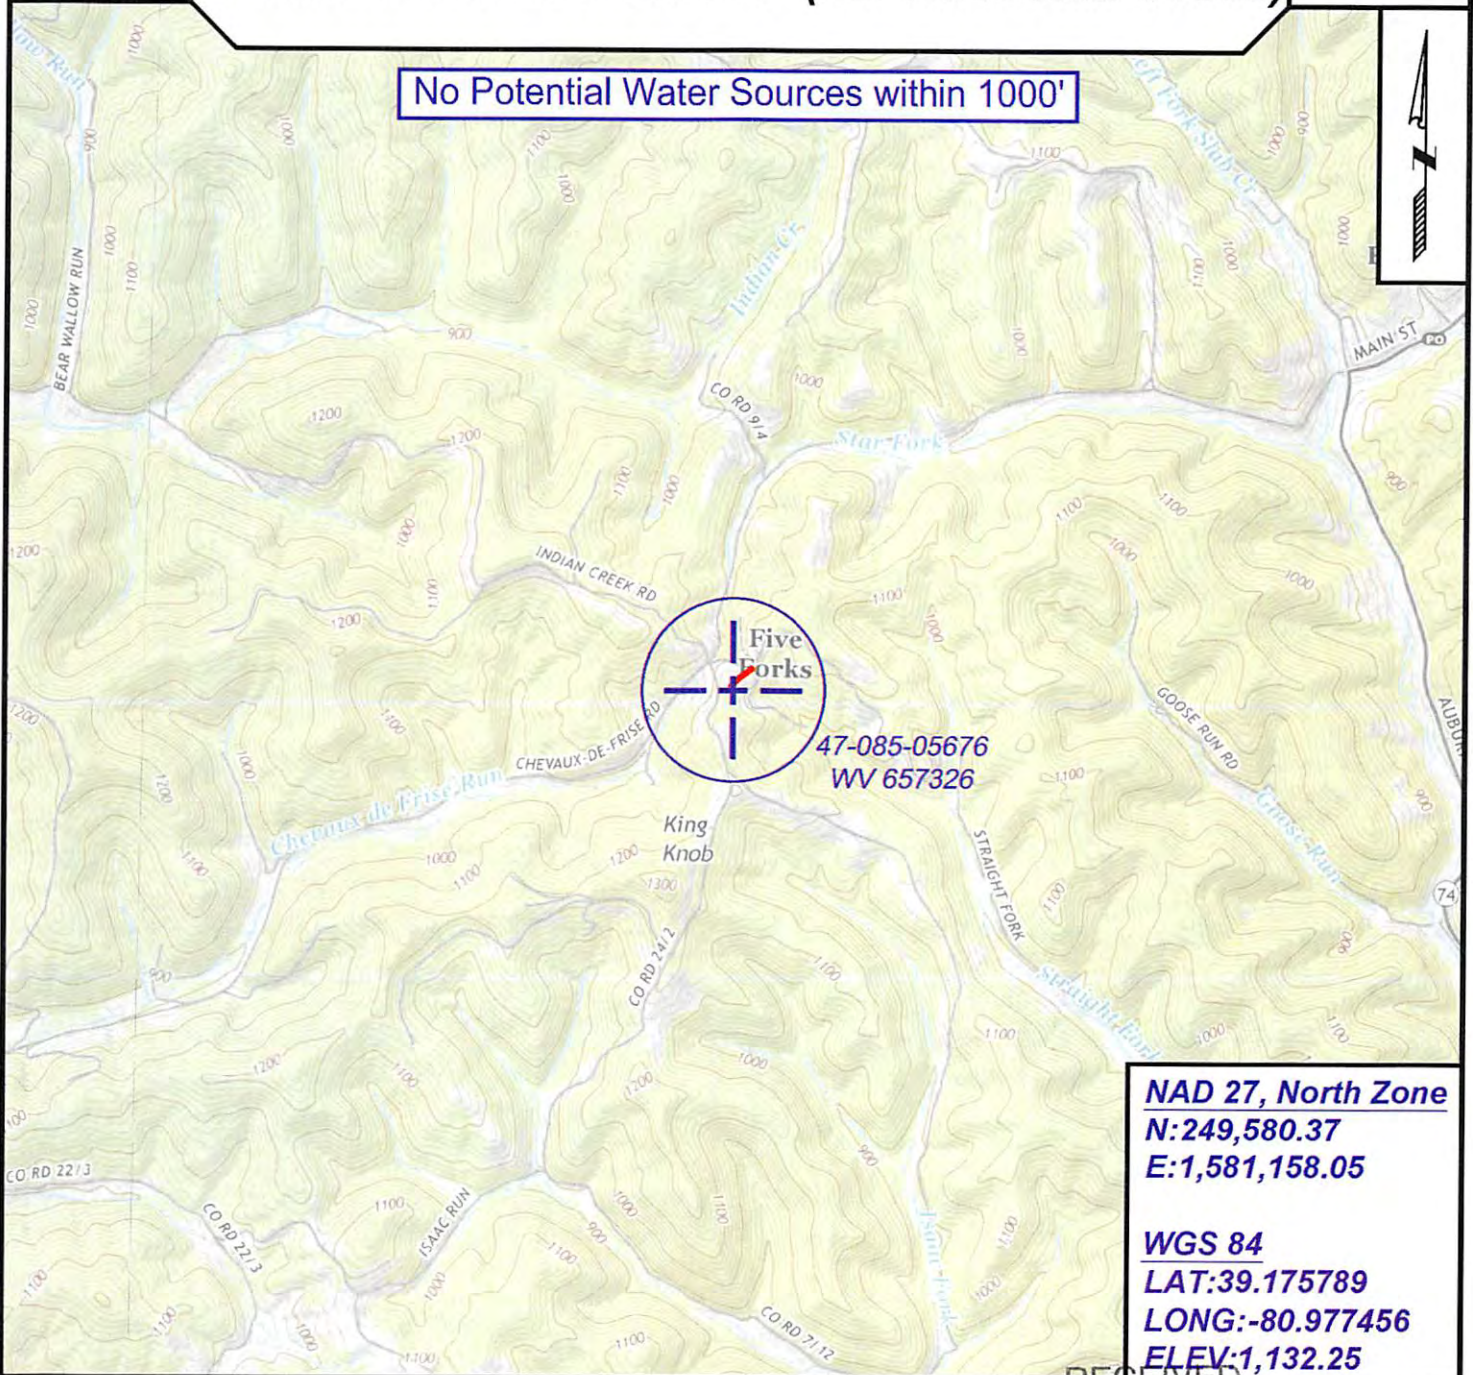

47-085-05676
WV 657326

NAD 27, North Zone
N:249,580.37
E:1,581,158.05

WGS 84
LAT:39.175789
LONG:-80.977456
ELEV:1,132.25



SURVEYING AND MAPPING SERVICES PERFORMED BY:

ALLEGHENY SURVEYS, INC.

1-800-482-8606
237 Birch River Road
Birch River, WV 26610
PH: (304) 649-8606
FAX: (304) 649-8608

PREPARED FOR:

Office of Oil and Gas
EQT Production Company

APR 23 2018
P.O. Box 280
Bridgeport, WV 26330

RECEIVED
WV Department of
Environmental Protection
05/18/2018