

WW-7
8-30-06



West Virginia Department of Environmental Protection
Office of Oil and Gas
WELL LOCATION FORM: GPS

API: 47-085-5755 WELL NO.: 1
 FARM NAME: Hissem Ball
 RESPONSIBLE PARTY NAME: Haught Energy Corporation
 COUNTY: Ritchie DISTRICT: Grant
 QUADRANGLE: Ellenboro 7.5
 SURFACE OWNER: First Apostolic Church
 ROYALTY OWNER: First Apostolic Church
 UTM GPS NORTHING: 493044.53
 UTM GPS EASTING: 4345426.9 GPS ELEVATION: 804.2'

The Responsible Party named above has chosen to submit GPS coordinates in lieu of preparing a new well location plat for a plugging permit or assigned API number on the above well. The Office of Oil and Gas will not accept GPS coordinates that do not meet the following requirements:

1. Datum: NAD 1983, Zone: 17 North, Coordinate Units: meters, Altitude: height above mean sea level (MSL) – meters.
2. Accuracy to Datum – 3.05 meters
3. Data Collection Method:

Survey grade GPS _____: Post Processed Differential _____

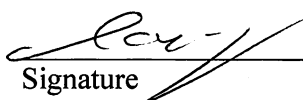
Real-Time Differential _____

Mapping Grade GPS : Post Processed Differential _____

Real-Time Differential _____

4. **Letter size copy of the topography map showing the well location.**

I the undersigned, hereby certify this data is correct to the best of my knowledge and belief and shows all the information required by law and the regulations issued and prescribed by the Office of Oil and Gas.


Signature

President

Title

5-11-2021

Date

RECEIVED
Office of Oil and Gas

JUN 04 2021

WV Department of
Environmental Protection

06/18/2021

