

4708505813 P

WW-7  
8-30-06



West Virginia Department of Environmental Protection  
Office of Oil and Gas

WELL LOCATION FORM: GPS

API: 47-085-05813 WELL NO.: 1-A

FARM NAME: COKELEY

RESPONSIBLE PARTY NAME: LITTLE KANAWHA CONSERVATION DISTRICT

COUNTY: RITCHIE DISTRICT: GRANT

QUADRANGLE: HARRISVILLE 7.5

SURFACE OWNER: WV DIV. OF NATURAL RESOURCES LANDS AND STREAMS OFFICE

ROYALTY OWNER: UNKNOWN

UTM GPS NORTHING: 4340412.3

UTM GPS EASTING: 492546.5 GPS ELEVATION: 835

The Responsible Party named above has chosen to submit GPS coordinates in lieu of preparing a new well location plat for a plugging permit or assigned API number on the above well. The Office of Oil and Gas will not accept GPS coordinates that do not meet the following requirements:

- Datum: NAD 1983, Zone: 17 North, Coordinate Units: meters, Altitude: height above mean sea level (MSL) – meters.
- Accuracy to Datum – 3.05 meters
- Data Collection Method:  
Survey grade GPS  : Post Processed Differential   
Real-Time Differential   
Mapping Grade GPS  : Post Processed Differential   
Real-Time Differential

RECEIVED  
Office of Oil and Gas

DEC 11 2020

WV Department of  
Environmental Protection


4. Letter size copy of the topography map showing the well location.

I the undersigned, hereby certify this data is correct to the best of my knowledge and belief and shows all the information required by law and the regulations issued and prescribed by the Office of Oil and Gas.

K. Robert Buchanan Chairman 11/13/20  
Signature Title Date

04/02/2021

47-085-05813 P

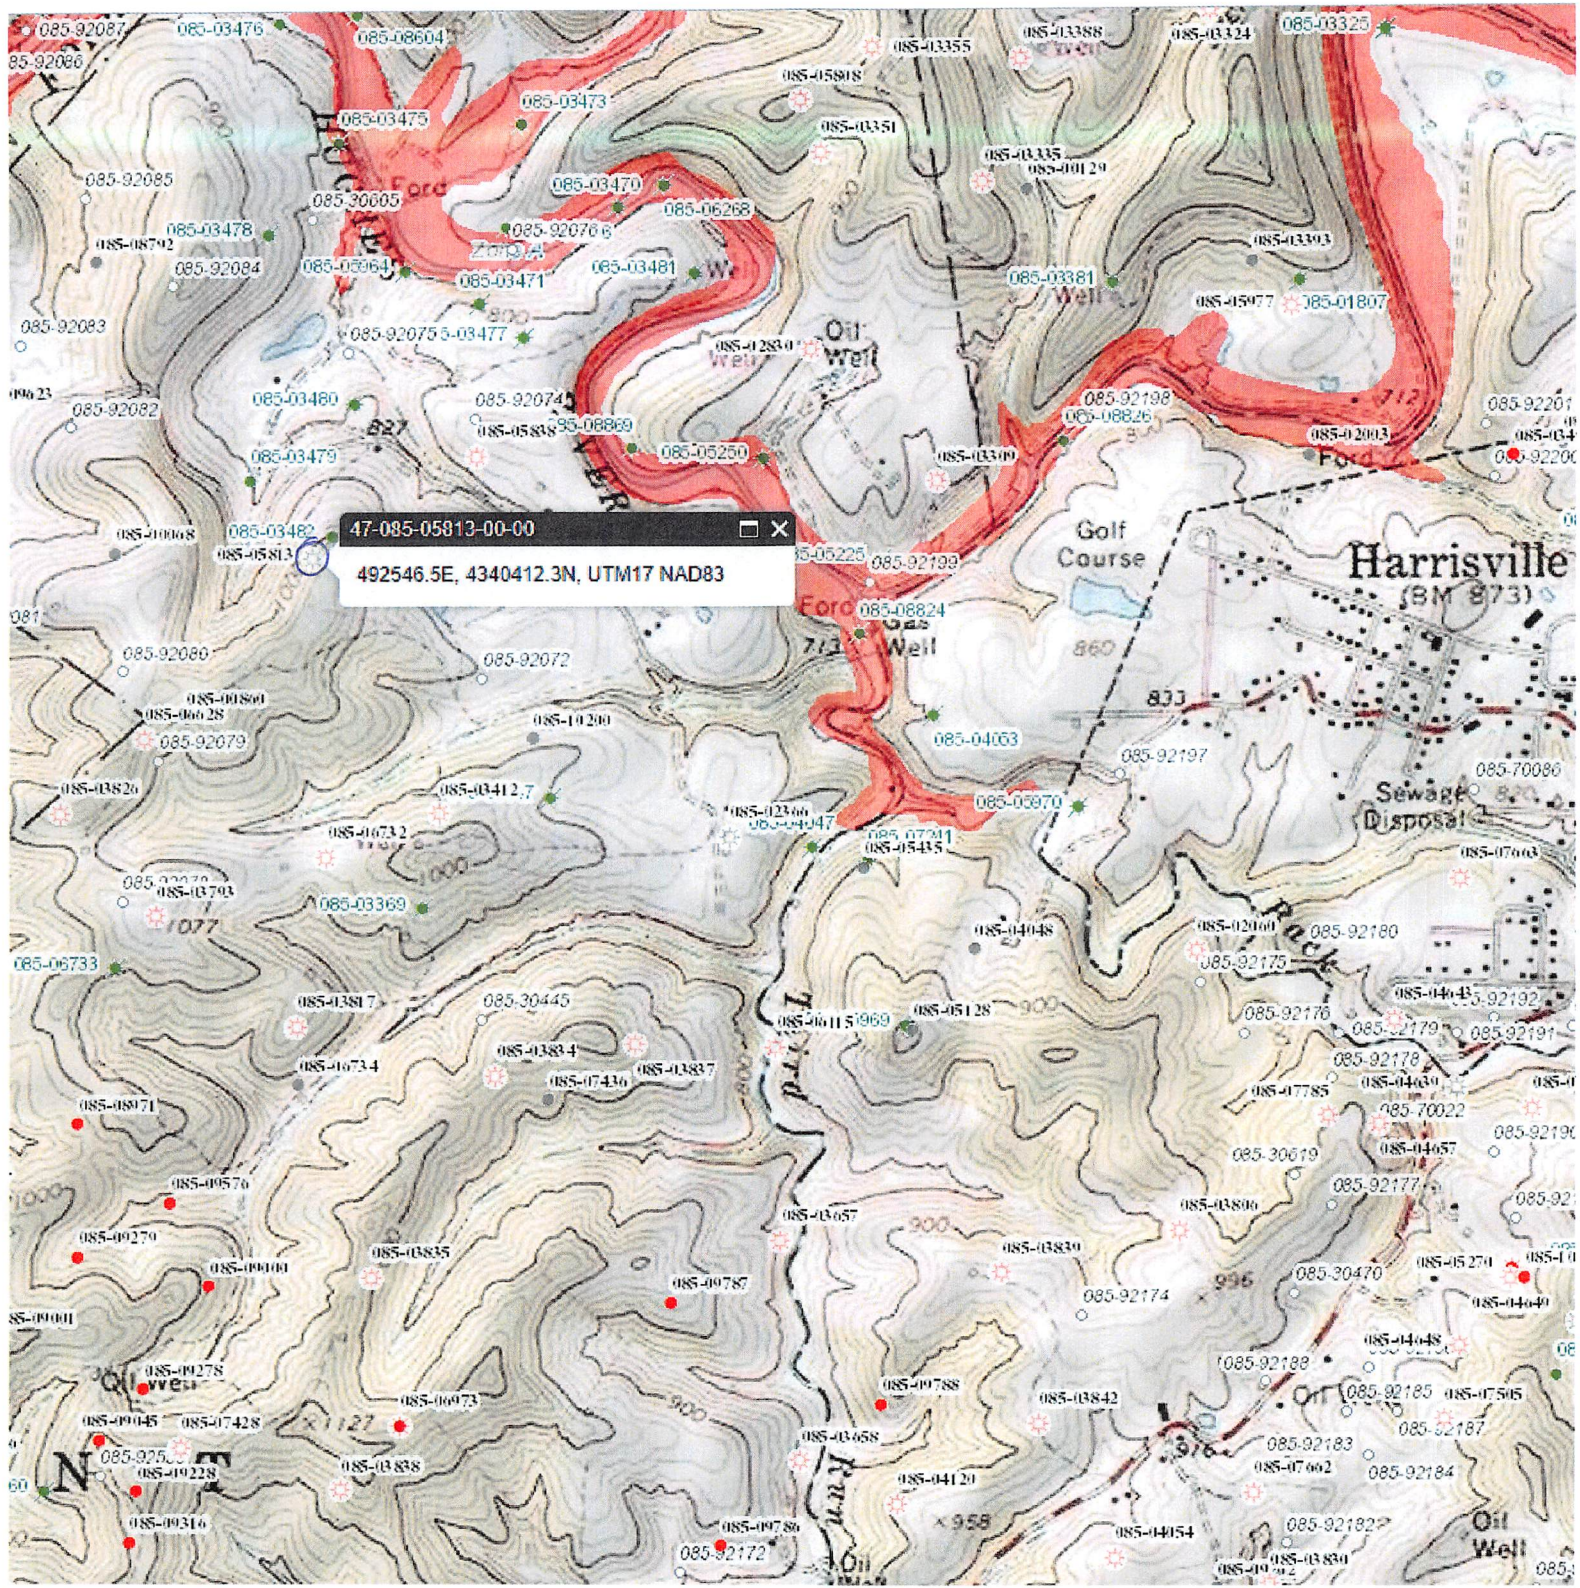

04/02/2021