

JOSEPH E. CAMPBELL

290/203
T.M. 43 PAR. 30

BOUNDARY TO WELL TIE

LINE	BEARING	DISTANCE
L10	S 13°15' E	103.42
L11	N 55°03' W	220.27

JOSEPH E. CAMPBELL

279/769
T.M. 43 PAR. 25

ROXIE EVANS
PH # 1

S 65°00' W - 1650.00

MICHAEL D. CAMPBELL

277/475
T.M. 43 PAR. 29
40 Acres

RICHARD A. JONES

276/495
T.M. 43 PAR. 32


N 48°30' E - 1155.00

LINE	BEARING	DISTANCE
L1	S 66°00' E	198.00
L2	S 57°00' E	627.00
L3	S 33°00' E	231.00
L4	S 62°00' E	140.25
L5	S 72°00' E	115.50
L6	N 04°30' W	412.50
L7	N 59°00' W	429.00
L8	N 53°00' W	272.25
L9	N 42°00' W	305.25

S 53°12' E
45°58' E
CLOSED

MICHAEL D. CAMPBELL

117/26
T.M. 43 PAR. 31

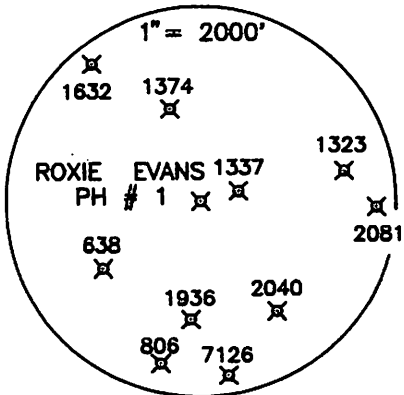

NAD 27
LAT. = 39.0280723
LONG. = 81.0861992

TOPO
LOC.


(+) DENOTES LOCATION OF WELL ON UNITED STATES TOPOGRAPHIC MAPS

LEGEND

- CALCULATED POINT
- ⊙ IRON PIPE FOUND

FILE NO. _____
 DRAWING NO. 07-23
 SCALE 1" = 500
 MINIMUM DEGREE OF ACCURACY 1 IN 200
 PROVEN SOURCE OF ELEVATION G.P.S.

I THE UNDERSIGNED, HEREBY CERTIFY THAT THIS PLAT IS CORRECT TO THE BEST OF MY KNOWLEDGE AND BELIEF AND SHOWS ALL THE INFORMATION REQUIRED BY LAW AND THE REGULATIONS ISSUED AND PRESCRIBED BY THE DEPARTMENT OF ENERGY.
 (SIGNED) *[Signature]*
 R.P.E. _____ L.L.S. 851

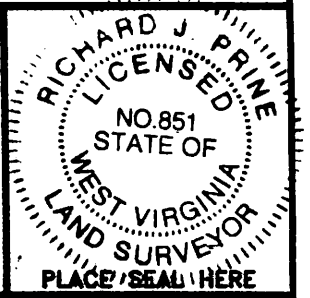

STATE OF WEST VIRGINIA
 Division of Environmental Protection
 OFFICE OF OIL AND GAS

DATE 07-22, 2008
 OPERATOR'S WELL NO. ROXIE EVANS PH # 1
 API WELL NO. 47 - 085 - 09474-F
 STATE 47 COUNTY 085 PERMIT 09474-F

WELL TYPE: OIL GAS LIQUID INJECTION _____ WASTE DISPOSAL _____
 (IF "GAS") PRODUCTION STORAGE _____ DEEP _____ SHALLOW

LOCATION: ELEVATION 1094 WATER SHED FOLFPEN FORK of LEATHERBARK CREEK
 DISTRICT MURPHY COUNTY RITCHIE

QUADRANGLE SMITHVILLE 7.5'

SURFACE OWNER MICHAEL D. CAMPBELL ACREAGE 40
 OIL & GAS ROYALTY OWNER ROXIE B. EVANS HEIRS LEASE ACNT/GE 40
 LEASE NO. _____

PROPOSED WORK: DRILL _____ CONVERT _____ DRILL DEEPER _____ REDRILL _____ FRACTURE OR STIMULATE PLUG OFF OLD FORMATION _____ PERFORATE NEW FORMATION _____ OTHER PHYSICAL CHANGE IN WELL (SPECIFY): _____

PLUG AND ABANDON _____ CLEAN OUT AND REPLUG _____
 TARGET FORMATION MARCELLUS ESTIMATED DEPTH 6,250'
 WELL OPERATOR PETROEDGE RESOURCES (WV) LLC DESIGNATED AGENT DAN MULLINS
 ADDRESS 2925 BRIARPARK DRIVE HOUSTON, TX. 77042 ADDRESS 101 WEST MAIN STREET HARRISVILLE, WV. 26362

CANCELLED