

4708510021

WW-7
8-30-06



West Virginia Department of Environmental Protection
Office of Oil and Gas
WELL LOCATION FORM: GPS

API: 47-085-10021 WELL NO.: McCabe 1H

FARM NAME: Lockhart Heirs

RESPONSIBLE PARTY NAME: Antero Resources Corporation

COUNTY: Ritchie DISTRICT: Union

QUADRANGLE: Pullman

SURFACE OWNER: Karah Leigh Lofton

ROYALTY OWNER: _____

UTM GPS NORTHING: 4337994.49 m

UTM GPS EASTING: 509483.23 m GPS ELEVATION: 1143.8 ft

RECEIVED
Office of Oil and Gas

MAR 03 2023

WV Department of
Environmental Protection

The Responsible Party named above has chosen to submit GPS coordinates in lieu of preparing a new well location plat for a plugging permit or assigned API number on the above well. The Office of Oil and Gas will not accept GPS coordinates that do not meet the following requirements:

- Datum: NAD 1983, Zone: 17 North, Coordinate Units: meters, Altitude: height above mean sea level (MSL) – meters.
- Accuracy to Datum – 3.05 meters
- Data Collection Method:

Survey grade GPS : Post Processed Differential _____
Real-Time Differential

Mapping Grade GPS : Post Processed Differential _____
Real-Time Differential

- Letter size copy of the topography map showing the well location.

I the undersigned, hereby certify this data is correct to the best of my knowledge and belief and shows all the information required by law and the regulations issued and prescribed by the Office of Oil and Gas.

[Signature]
Signature

Permitting Manager
Title


3/2/23
Date

RECEIVED
Office of Oil and Gas

MAR 03 2023

WV Department of
Environmental Protection

03/17/2023

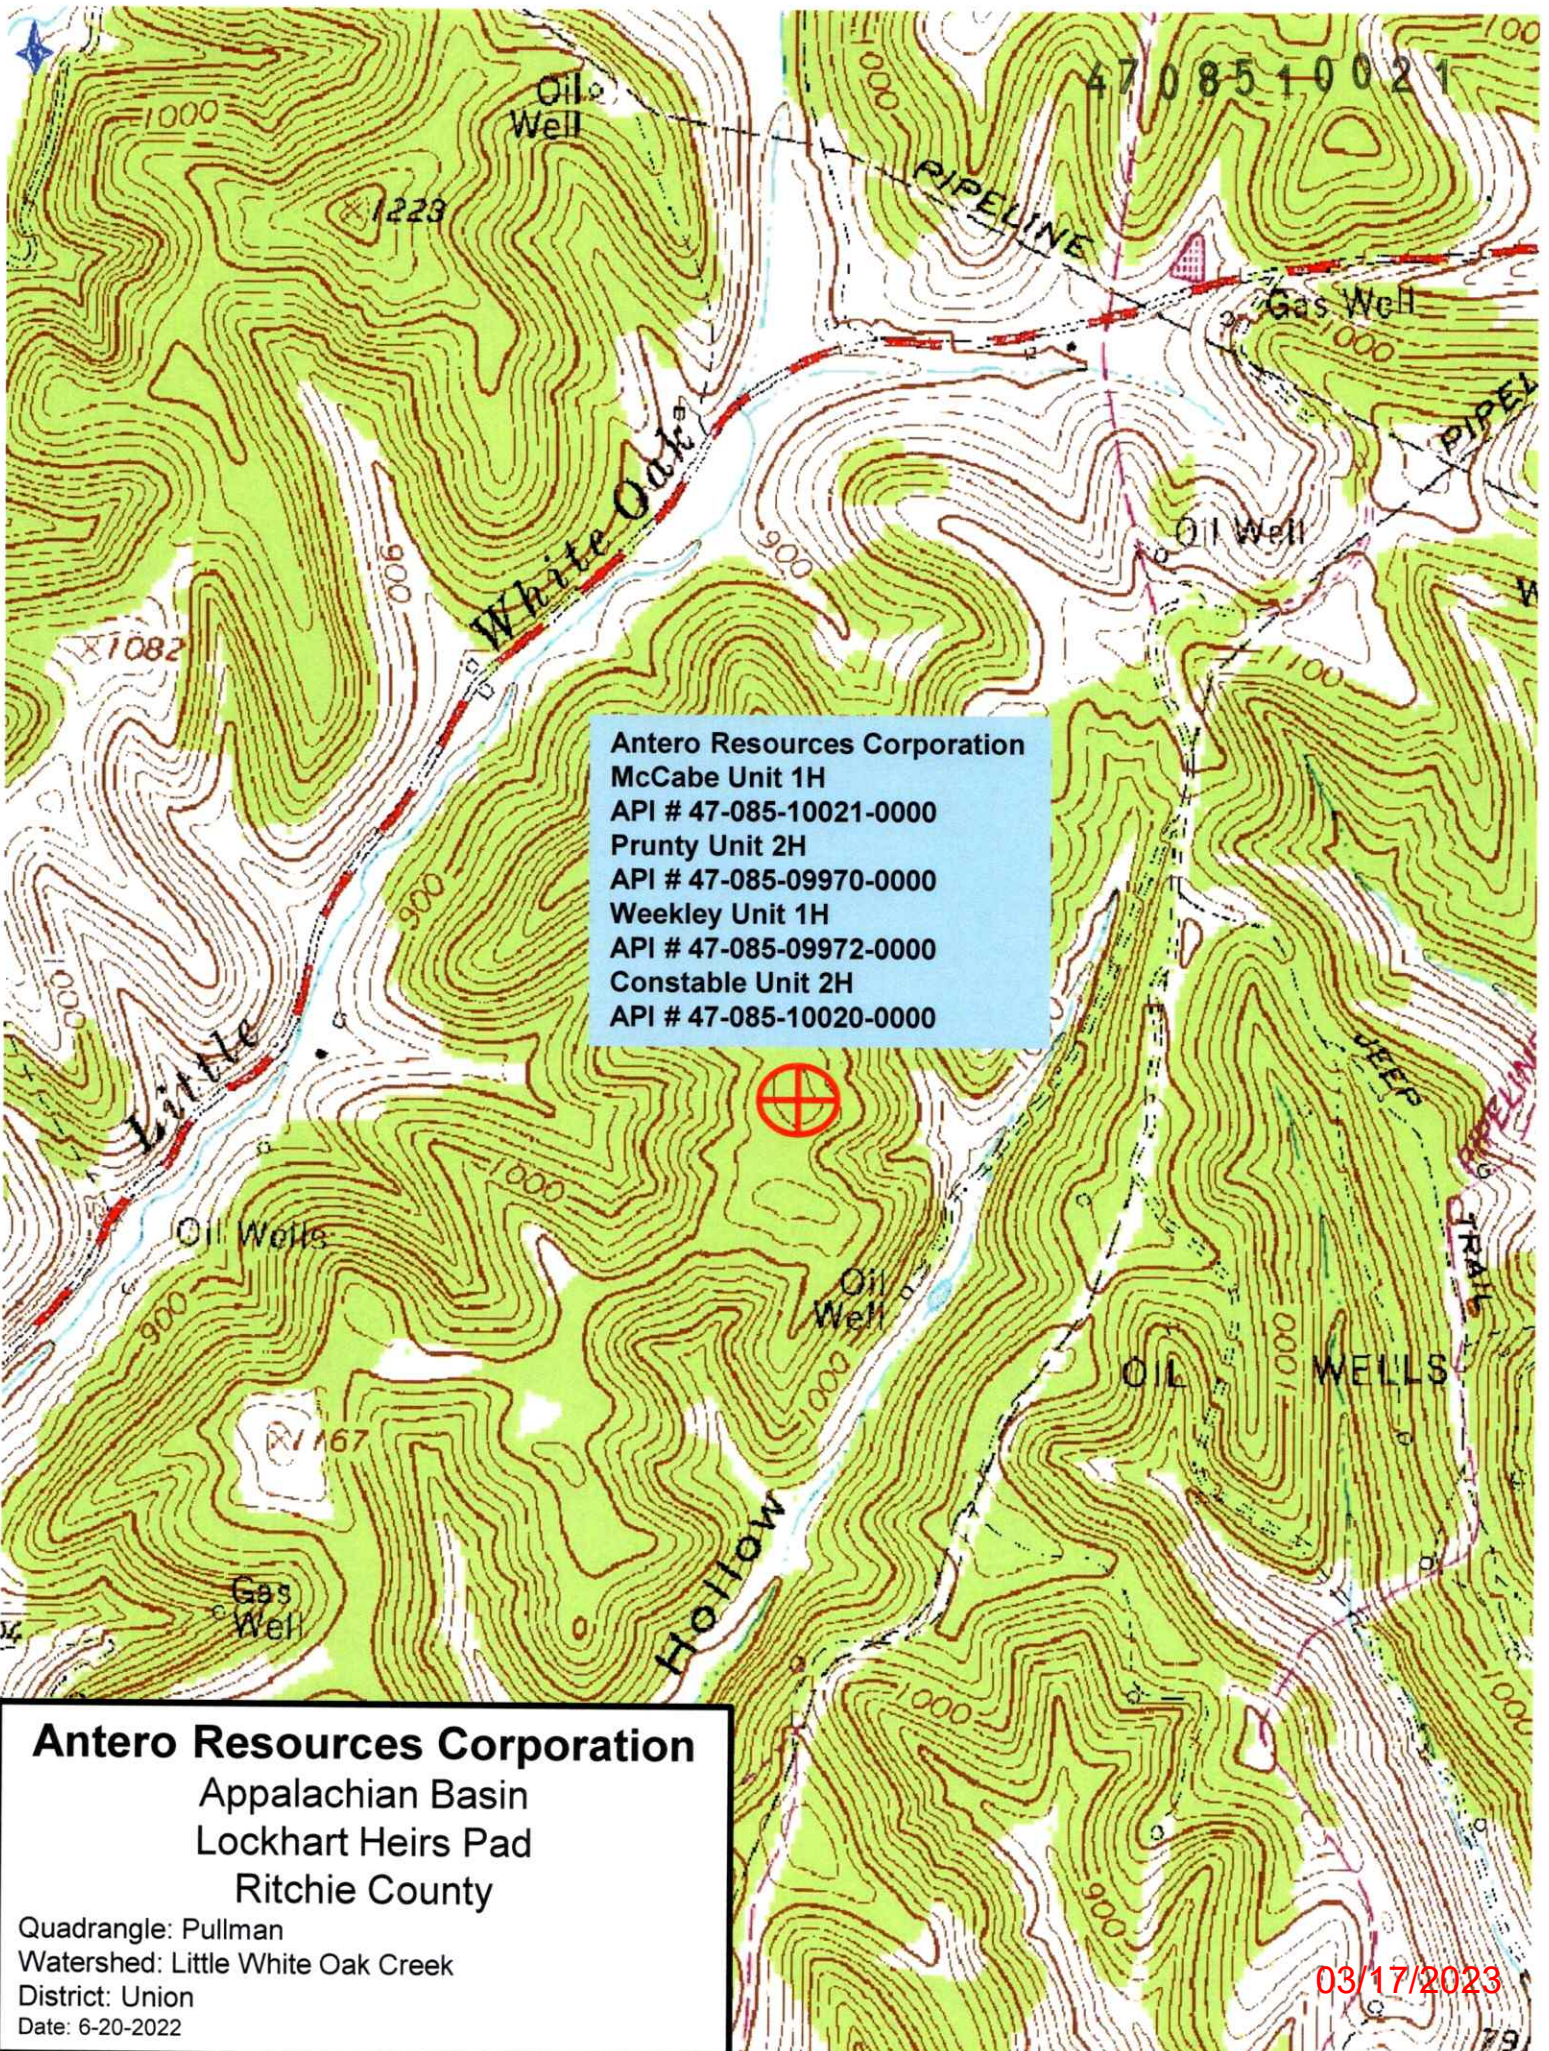

Antero Resources Corporation
McCabe Unit 1H
API # 47-085-10021-0000
Prunty Unit 2H
API # 47-085-09970-0000
Weekley Unit 1H
API # 47-085-09972-0000
Constable Unit 2H
API # 47-085-10020-0000

Antero Resources Corporation
Appalachian Basin
Lockhart Heirs Pad
Ritchie County

Quadrangle: Pullman
Watershed: Little White Oak Creek
District: Union
Date: 6-20-2022

03/17/2023