



Antero Resources
 Constable Unit 1H
 Ritchie County WV
 Northing: 14231532.79
 Easting: 1671480.50
 As Drilled ST1

WELL DETAILS: Constable Unit 1H

+N/-S	+E/-W	Northing	Ground Level	1142.0
0.0	0.0	14231532.79	Easting	1671480.5039° 11.271928 N80° 53.23308 W
			Latitude	
			Longitude	
			Spot	

PROJECT DETAILS: Ritchie County WV

 Datum: NAD 83 / USCSN (CONUS)
 Zone: Zone 17N (84 W to 78 W)
 System Datum: Mean Sea Level

RESISTANCE INFORMATION

Contract (N2) Reference: Final Constable Unit 1H, 04/18/13
 Well (V2) Reference: Constable Unit 1H, 04/18/13
 Well (V3) Reference: Constable Unit 1H, 04/18/13
 421 South Eagle Lane
 Oklahoma City, OK

LEGEND

- Constable Unit 1H, Sidetrack 1, Plan 3 V0
- Constable Unit 1H, Original Wellpath, As Drilled V0
- As Drilled ST1

DESIGN TARGET DETAILS

Name	TVD	+N/-S	+E/-W	Northing	Easting	Latitude	Longitude
Actual BHL Constable Unit 1H	6934.3	-4378.91	4238467.06	1667101.8339	12.36.542 N00° 54' 20.834 W		

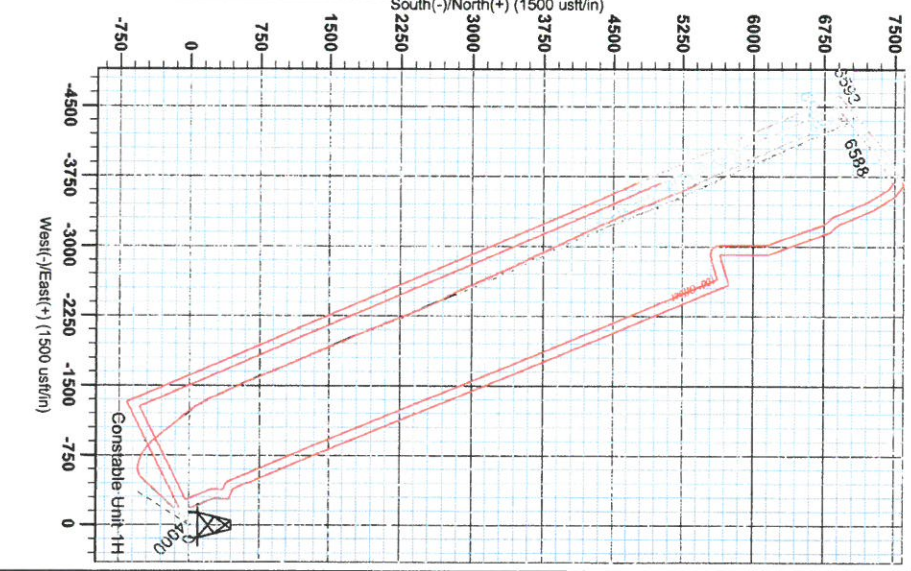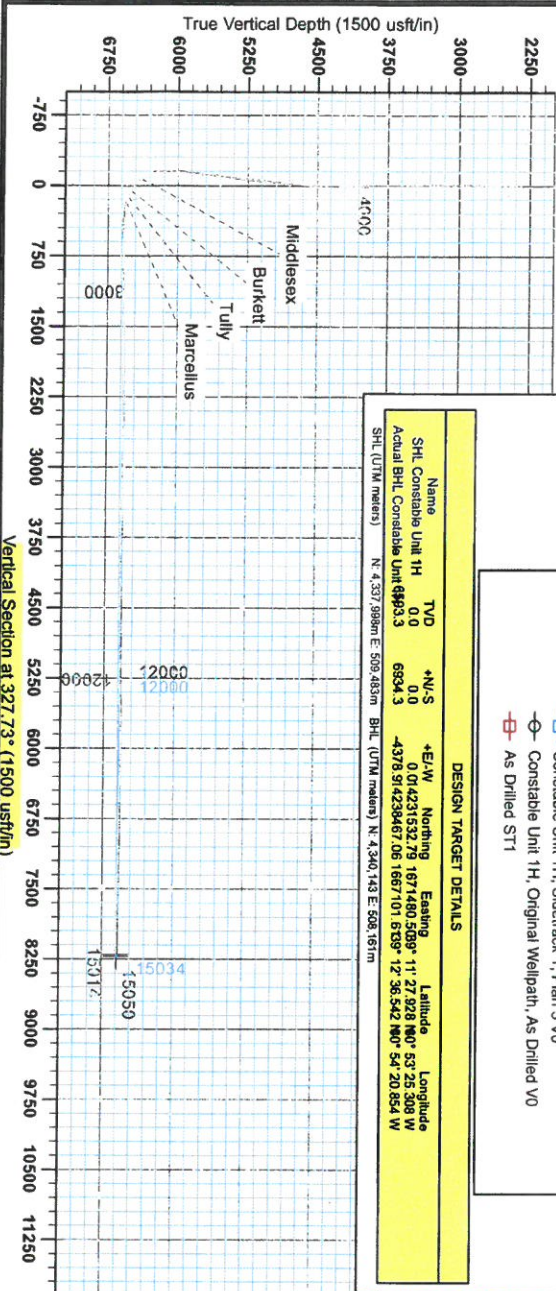

Asimuth to Grid North
 True North: -0.07°
 Magnetic North: -8.40°
 Magnetic Field
 Strength: 66.85T
 Dip Angle: 66.85°
 Date: 5/17/2013
 Model: IGRF2010

MORGANTOWN, WV
 GEOLOGICAL SURVEY
 MWM

3102 9 2 3ED

RECEIVED