

4708510036

RECEIVED

DEC 16 2013

WV GEOLOGICAL SURVEY
MORGANTOWN, WV



Antero Resources
Blanche Unit 1H
Ritchie County WV
Northing: 14283559.28
Easting: 1663033.84
As Drilled

WELL DETAILS: Blanche Unit 1H


PROJECT DETAILS: Ritchie County WV

Geocode System: UTM Zone 17N
Datum: NAD 83
Elevation: Sea Level
Zone: Zone 17N (84 W to 78 W)
System Datum: Mean Sea Level

REFERENCE INFORMATION

Co-ordinate (NAD 83) Reference: UTM Zone 17N, Datum: NAD 83
Datum: NAD 83
System: UTM
Zone: Zone 17N (84 W to 78 W)
Datum: Mean Sea Level
System Datum: Mean Sea Level



Genie Lightfoot
10:57, September 09 2013
Scientific Drilling
421 South Eagle Lane
Oklahoma City, OK




LEGEND

□ Blanche Unit 1H, Original Wellpath, Plan 1 V0

⊖ As Drilled

DESIGN TARGET DETAILS

Name	TVD	+N/S	+E/W	Northing	Easting	Latitude	Longitude
SHL (UTM meters)				4,353,659m	509,926m		
BHL (UTM meters)				4,365,747m	505,789m		

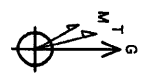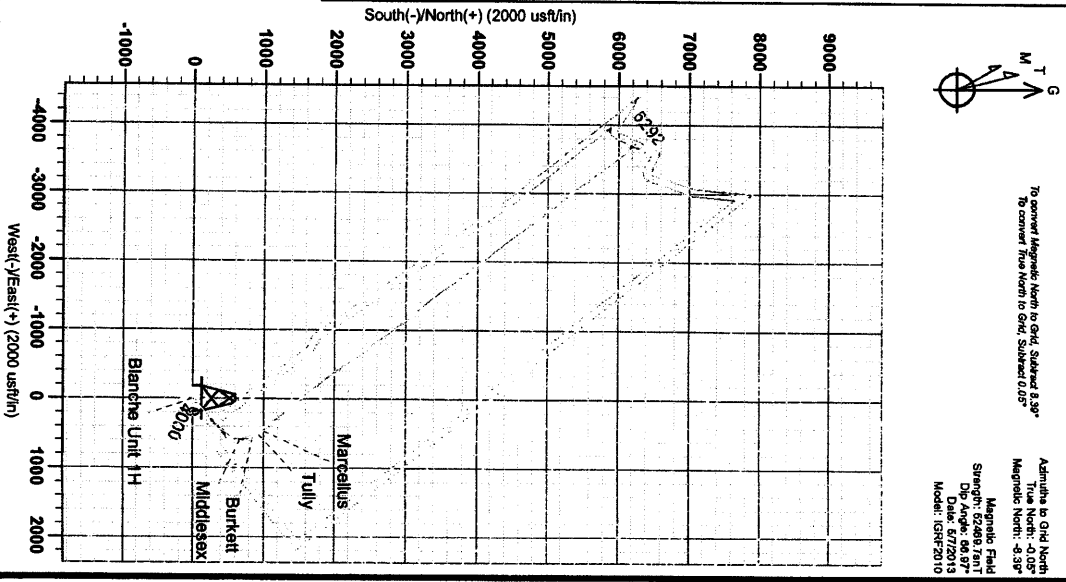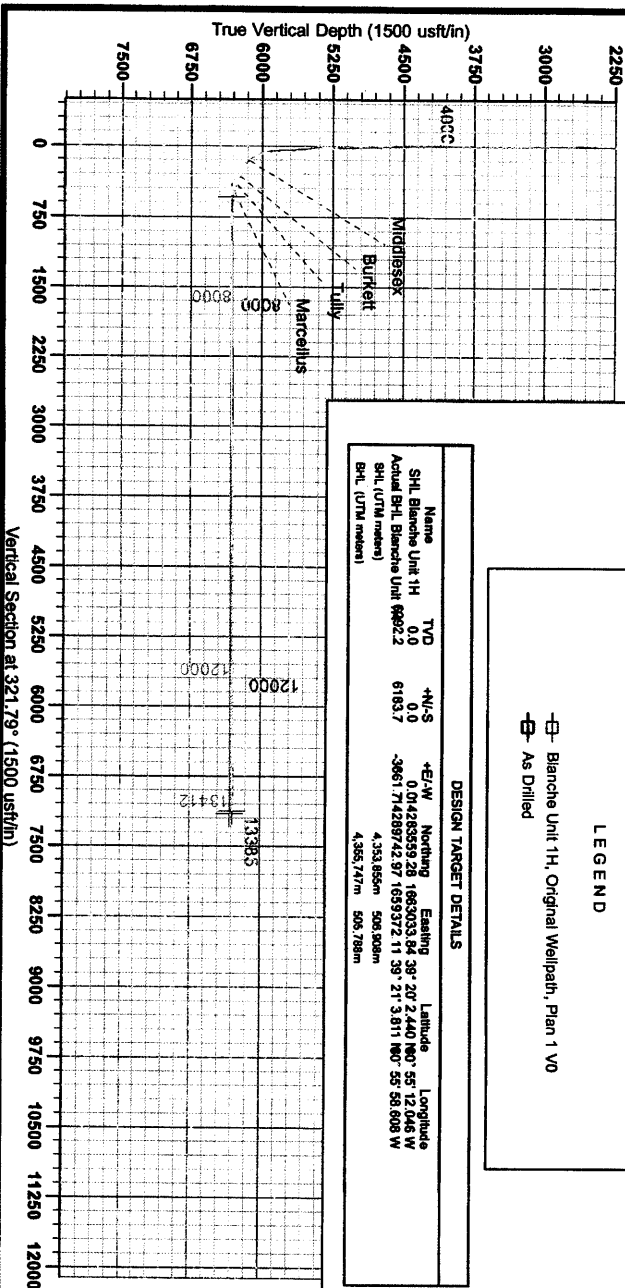



Magnetic Field
Strength: 62489.7 nT
Dip Angle: 66.97°
Date: 6/7/2013
Model: IGRF2010