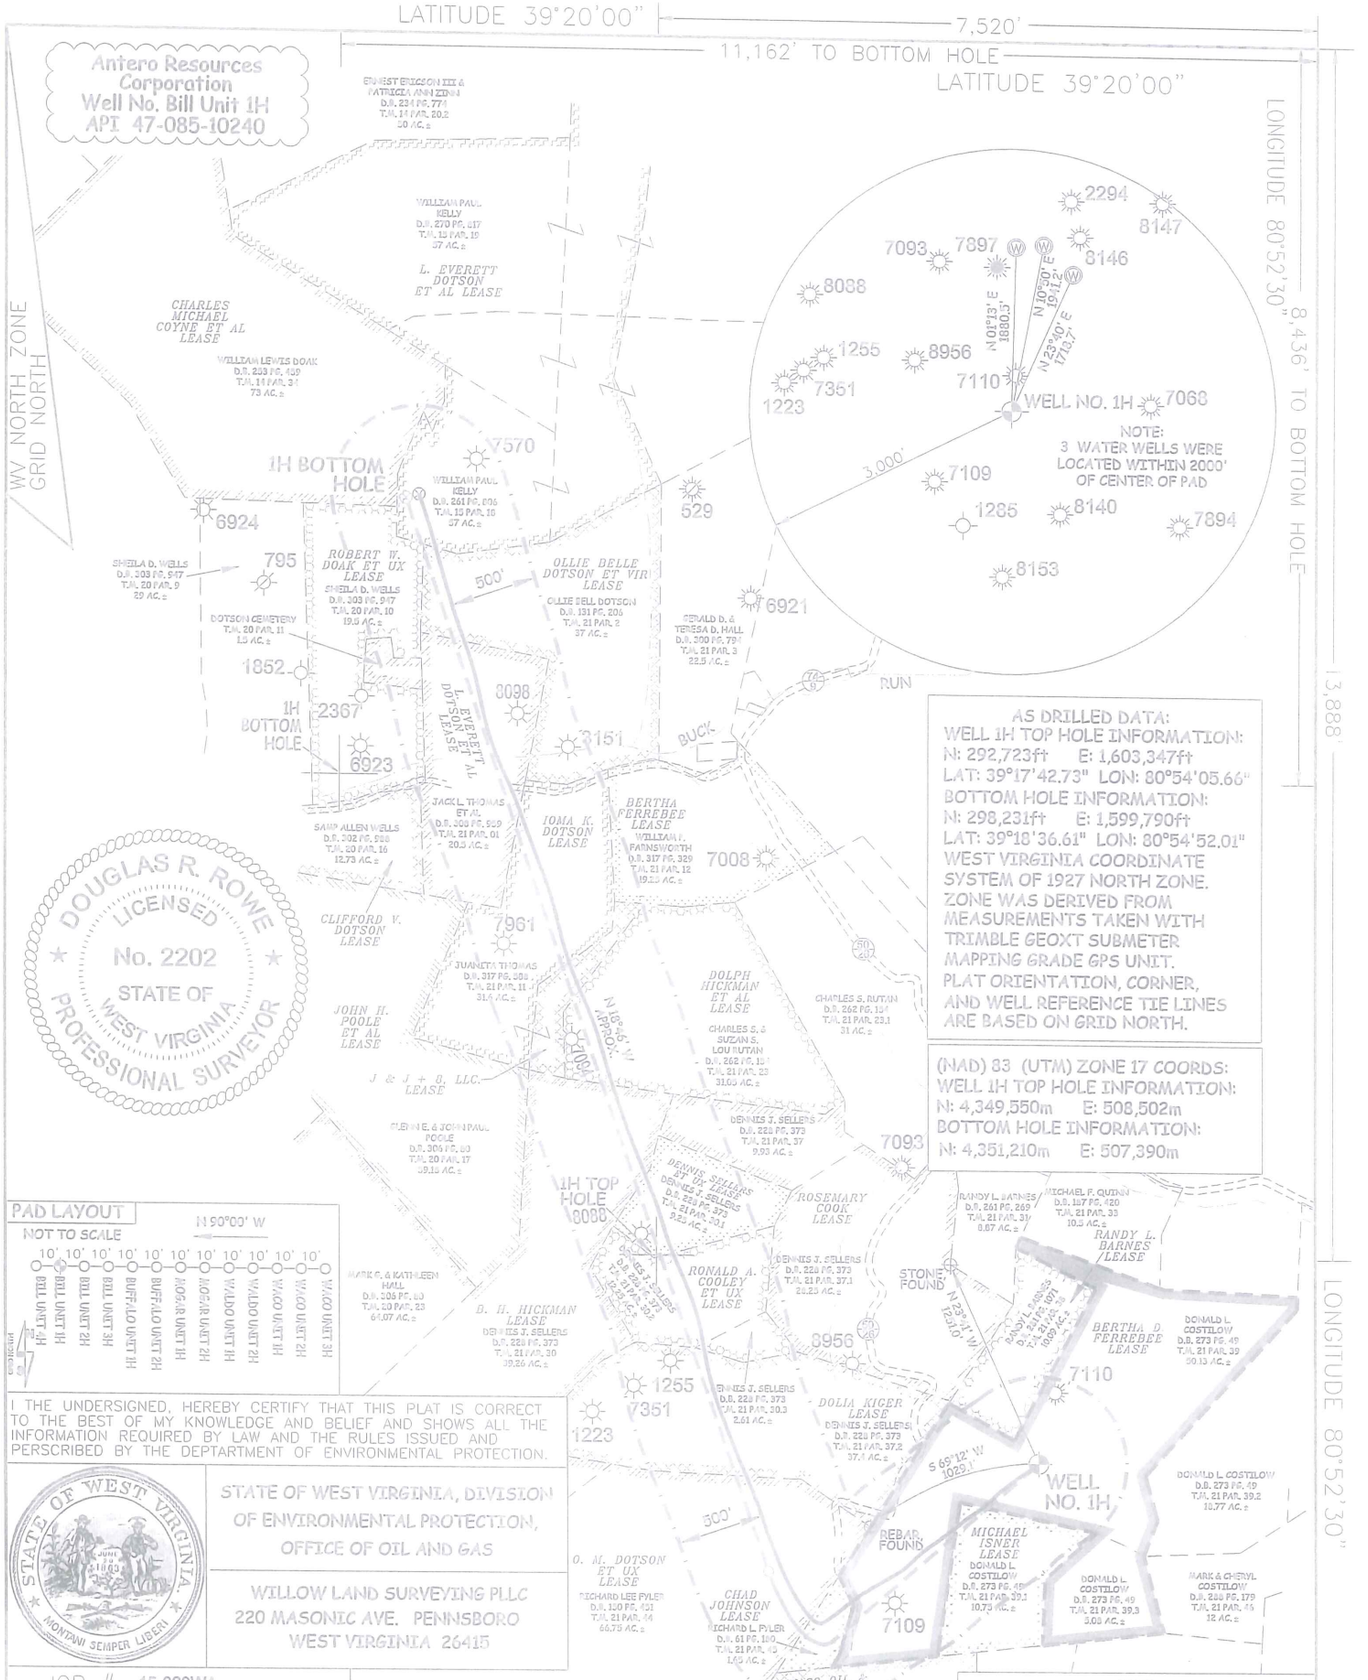

WELL TYPE: OIL ___ GAS X LIQUID INJECTION ___ WASTE DISPOSAL ___
(IF "GAS") PRODUCTION X STORAGE ___ DEEP ___ SHALLOW X
LOCATION: ELEVATION 1,221' - AS BUILT WATERSHED NORTH FORK HUGHES RIVER
QUADRANGLE PENNSBORO 7.5' DISTRICT CLAY COUNTY RITCHIE
SURFACE OWNER DONALD L. COSTILOW ACREAGE 50.13 ACRES +/-
OIL & GAS ROYALTY OWNER BERTHA D. FERREBEE; MICHAEL ISNER; CHAD JOHNSON; O. M. DOTSON ET UX; DOLIA KIGER; RONALD A. COOLEY ET UX; DENNIS SELLERS ET UX; B. H. HICKMAN; DOLPH HICKMAN ET AL; J & J + B, LLC.; IOMA K. DOTSON; L. EVERETT DOTSON ET AL; OLLIE BELLE DOTSON ET VIR; L. EVERETT DOTSON ET AL. LEASE ACREAGE 67 AC.±; 10.75 AC±; 13.99 AC±; 1.65 AC±; 40 AC±; 13.99 AC±; 9.25 AC±; 400 AC.±; 26.52 AC±; 4.58 AC±; 27 AC±; 21 AC±; 37 AC±; 75 AC±
PROPOSED WORK: DRILL ___ CONVERT ___ DRILL DEEPER ___ REDRILL ___ FRACTURE OR STIMULATE ___
PLUG OFF OLD FORMATION ___ PERFORATE NEW FORMATION ___ OTHER PHYSICAL CHANGE IN WELL (SPECIFY) AS DRILLED PLUG & ABANDON ___ CLEAN OUT & REPLUG ___
TARGET FORMATION MARCELLUS ESTIMATED DEPTH 6,580' TVD 13,366' MD
WELL OPERATOR ANTERO RESOURCES CORP. DESIGNATED AGENT DIANNA STAMPER - CT CORPORATION SYSTEM
ADDRESS 1615 WYNKOOP ST. ADDRESS 5400 D BIG TYLER ROAD
DENVER, CO 80202 CHARLESTON, WV 25313
FORM WW-6
COUNTY NAME PERMIT
47 — 085 — 10240
STATE COUNTY PERMIT