FORM WW 6 – SHEET 2 OF 2

OXF122
WV 514083
EQT PRODUCTION COMPANY

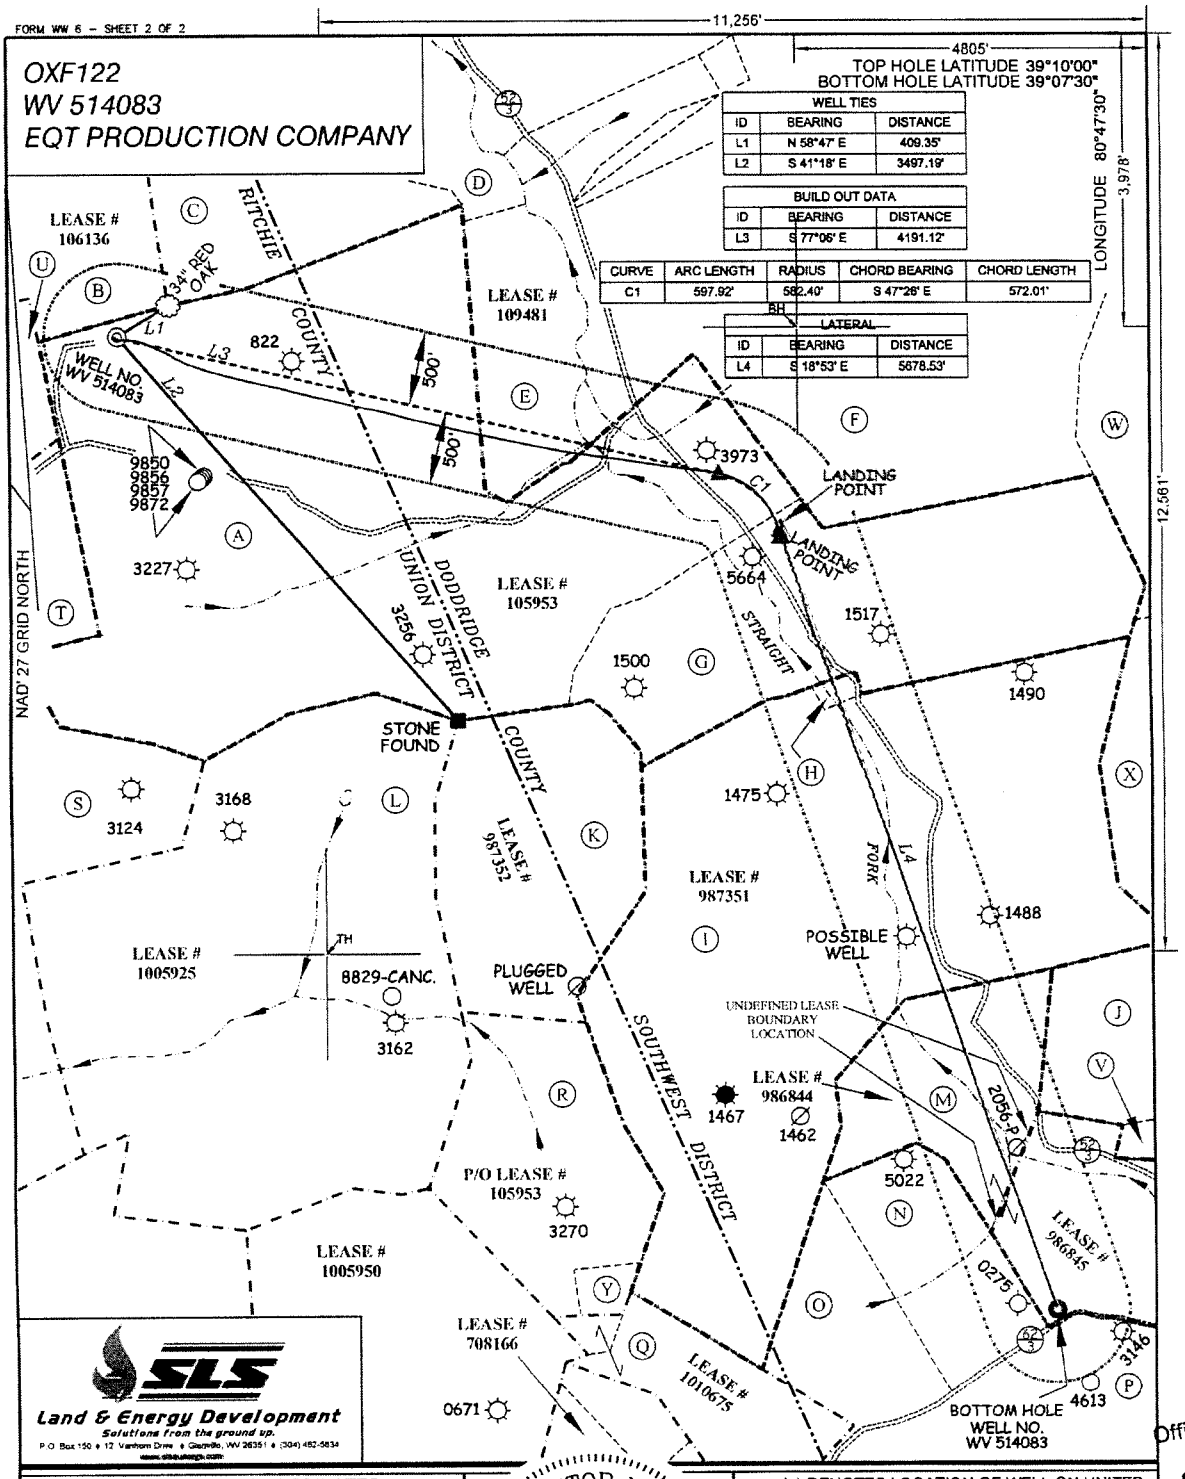

SLS
Land & Energy Development
Solutions from the ground up.
P.O. Box 150 • 12 Vanhorn Drive • Glenville, WV 26351 • (304) 462-5634

AS DRILLED COORDINATES
(OXF122 H9)

(S.P.C. NORTH ZONE) (UTM/M) ZONE 17 NORTH)

NAD'27 S.P.C.(FT)	N. 233,051.21	E. 1,622,340.01
NAD'27 GEO.	LAT-(N) 39.132179	LONG-(W) 80.831346
NAD'83 UTM (M)	N. 4,331,467.90	E. 514,591.79
LANDING POINT		
NAD'27 S.P.C.(FT)	N. 231,677.82	E. 1,626,865.19
NAD'27 GEO.	LAT-(N) 39.128592	LONG-(W) 80.815325
NAD'83 UTM (M)	N. 4,331,072.53	E. 515,977.34
BOTTOM HOLE		
NAD'27 S.P.C.(FT)	N. 226,385.09	E. 1,628,695.45
NAD'27 GEO.	LAT-(N) 39.114080	LONG-(W) 80.808601
NAD'83 UTM (M)	N. 4,329,463.36	E. 516,581.92

VICTOR MOYERS
LICENSED
No. 849
STATE OF
WEST VIRGINIA
PROFESSIONAL SURVEYOR
C.A. 12-06-16

(+) DENOTES LOCATION OF WELL ON UNITED STATES TOPOGRAPHIC MAPS.

LEGEND

LEASE LINE
SURFACE LINE
PROPOSED PATH
AS DRILLED PATH
OFFSET LINE
TIE LINE
CREEK
ROAD
COUNTY ROUTE
PROPOSED WELL
EXISTING WELL
PERMITTED WELL
DODDRIDGE COUNTY SOUTHWEST DISTRICT TAX MAP–PARCEL — D–SW–TM–00–00
RITCHIE COUNTY UNION DISTRICT TAX MAP–PARCEL — R–U–TM–00–00

COUNTY NAME
PERMIT

SCALE 1" = 1000' FILE NO. 6811AD514083

DATE APRIL 05 , 20 16

REVISED 04/11/16 & 12/06/16

OPERATORS WELL NO. WV 514083

API WELL NO. 47 — 085 — 10285H
STATE — COUNTY — PERMIT

STATE OF WEST VIRGINIA
DIVISION OF
ENVIRONMENTAL PROTECTION
OFFICE OF OIL AND GAS

WELL OPERATOR EQT PRODUCTION COMPANY
ADDRESS 115 PROFESSIONAL PLACE P.O. BOX 280
BRIDGEPORT, WV 26330

DESIGNATED AGENT REX C. RAY
ADDRESS 115 PROFESSIONAL PLACE P.O. BOX 280
BRIDGEPORT, WV 26330

RECEIVED
Office of Oil and Gas
SEP 14 2017
WV Department of
Environmental Protection