



West Virginia Department of Environmental Protection
Office of Oil and Gas

WELL LOCATION FORM: GPS

API: 47 - 085 - 10441 WELL NO.: HANLON # 1
FARM NAME: CAROLE HANLON
RESPONSIBLE PARTY NAME: UNKNOWN-WV DEP PAID PLUGGING CONTRACT
COUNTY: RITCHIE - 085 DISTRICT: GRANT
QUADRANGLE: CARIO
SURFACE OWNER: CAROLE HANLON
ROYALTY OWNER: J.W. MASON
UTM GPS NORTHING: 4334711
UTM GPS EASTING: 479773 GPS ELEVATION: 639'

The Responsible Party named above has chosen to submit GPS coordinates in lieu of preparing a new well location plat for a plugging permit or assigned API number on the above well. The Office of Oil and Gas will not accept GPS coordinates that do not meet the following requirements:

- Datum: NAD 1983, Zone: 17 North, Coordinate Units: meters, Altitude: height above mean sea level (MSL) – meters.
- Accuracy to Datum – 3.05 meters
- Data Collection Method:
Survey grade GPS _____: Post Processed Differential _____
Real-Time Differential _____
Mapping Grade GPS X: Post Processed Differential _____
Real-Time Differential X

RECEIVED
Office of Oil & Gas
OCT 17 2022
WV Department of
Environmental Protection

4. Letter size copy of the topography map showing the well location.

I the undersigned, hereby certify this data is correct to the best of my knowledge and belief and shows all the information required by law and the regulations issued and prescribed by the Office of Oil and Gas.

Signature


INSPECTOR

Title

9/12/2022

Date

4708510441P

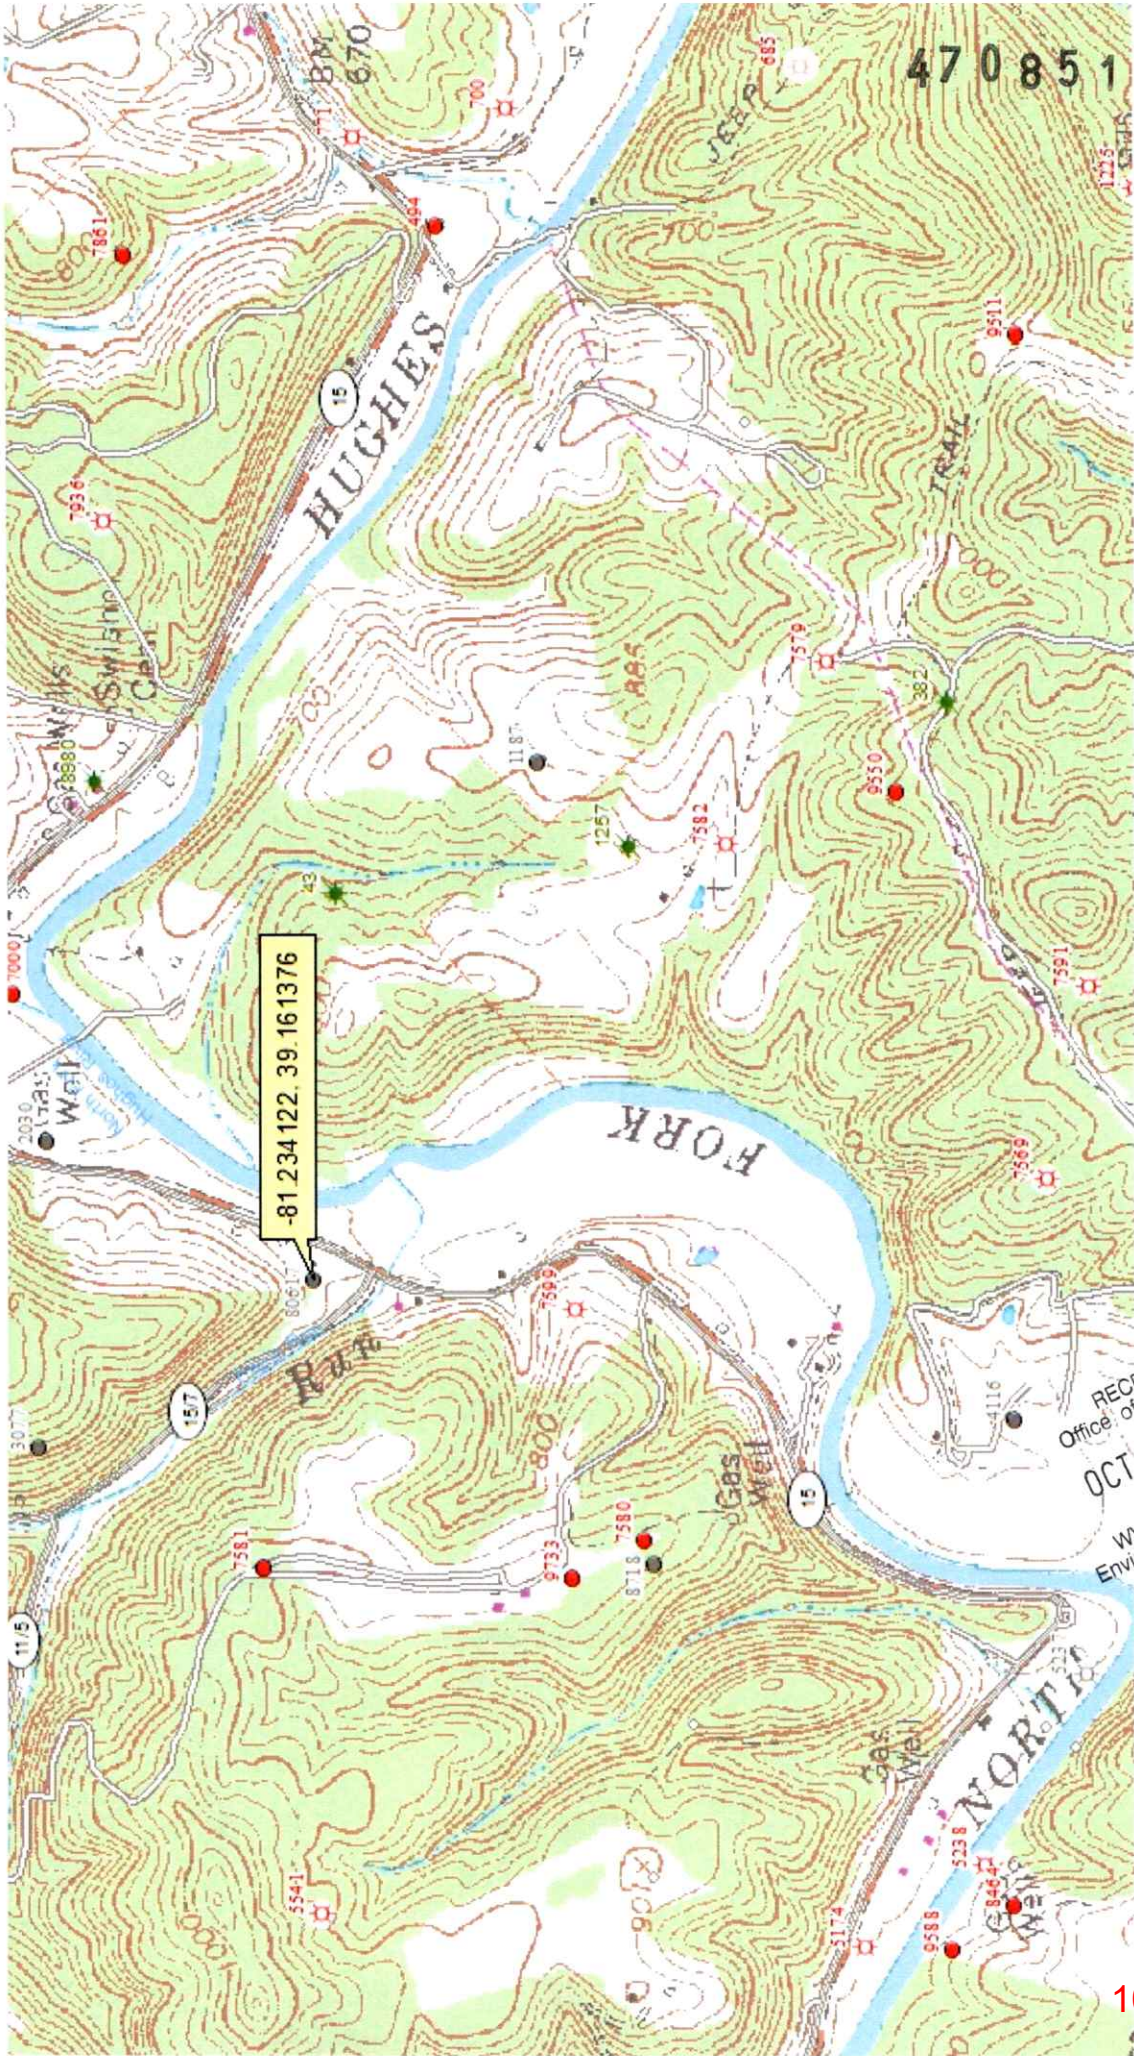

-81 234 122 39.161376

RECEIVED
Office of Oil & Gas
OCT 17 2022
WV Department of
Environmental Protection

10/21/2022