


FILE NO. _____
 DRAWING NO. _____
 SCALE 1" = 500'
 MINIMUM DEGREE OF ACCURACY 1:200
 PROVEN SOURCE OF ELEVATION GPS
 OBSERVATION

I, THE UNDERSIGNED, HEREBY CERTIFY THAT THIS PLAT IS CORRECT TO THE BEST OF MY KNOWLEDGE AND BELIEF AND SHOWS ALL THE INFORMATION REQUIRED BY LAW AND THE REGULATIONS ISSUED AND PRESCRIBED BY THE DEPARTMENT OF ENERGY.

(SIGNED) _____
 PROFESSIONAL SURVEYOR: 551

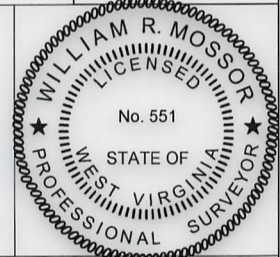

STATE OF WEST VIRGINIA
DEPARTMENT OF ENERGY
DIVISION OF OIL AND GAS

DATE SEPTEMBER 30TH, 2021
 OPERATORS WELL NO. NORMA SMITH #1

API 47 - 085 - 10111
 STATE COUNTY PERMIT

WELL TYPE: OIL ___ GAS ___ LIQUID INJECTION ___ WASTE DISPOSAL XX
 (IF GAS) PRODUCTION ___ STORAGE ___ DEEP XX SHALLOW ___

LOATION: ELEVATION 839' WATER SHED NUTTER FORK OF GOOSE CREEK
 DISTRICT GRANT COUNTY RITCHIE QUADRANGLE CAIRO

SURFACE OWNER ROGER SMITH 1/3, WAYNE SMITH 1/3, ROGER SMITH & DARREN SMITH 1/3 ACREAGE +/- 157.63
 OIL & GAS ROYALTY NORMA SMITH, ET AL LEASE AC. +/- 157

PROPOSED WORK: DRILL XX CONVERT ___ DRILL DEEPER ___ REDRILL ___
 FRACTURE OR STIMULATE XX PLUG OFF OLD FORMATION ___
 PERFORATE NEW FORMATION XX
 OTHER PHYSICAL CHANGE IN WELL ___
 PLUG AND ABANDON ___ CLEAN OUT AND REPLUG ___

TARGET FORMATION ORISKANY - BASS ISLAND ESTIMATED DEPTH 5700' TO 6300'


WELL OPERATOR MOUNTAINEER WELL SERVICES, LLC DESIGNATED AGENT PAT BRAKE
 ADDRESS 114 SOUTHGATE PARKWAY ADDRESS P. O. BOX 2722
CAMBRIDGE, OH 43725 BUCKHANNON, WV 26201

12/09/2022

FORM WW - 6

COUNTY NAME
 PERMIT

MOUNTAINEER WELL SERVICES, LLC
Well: Norma Smith # 1
Norma Smith, et al +/- 157 Acre Lease
Grant District Ritchie County West Virginia

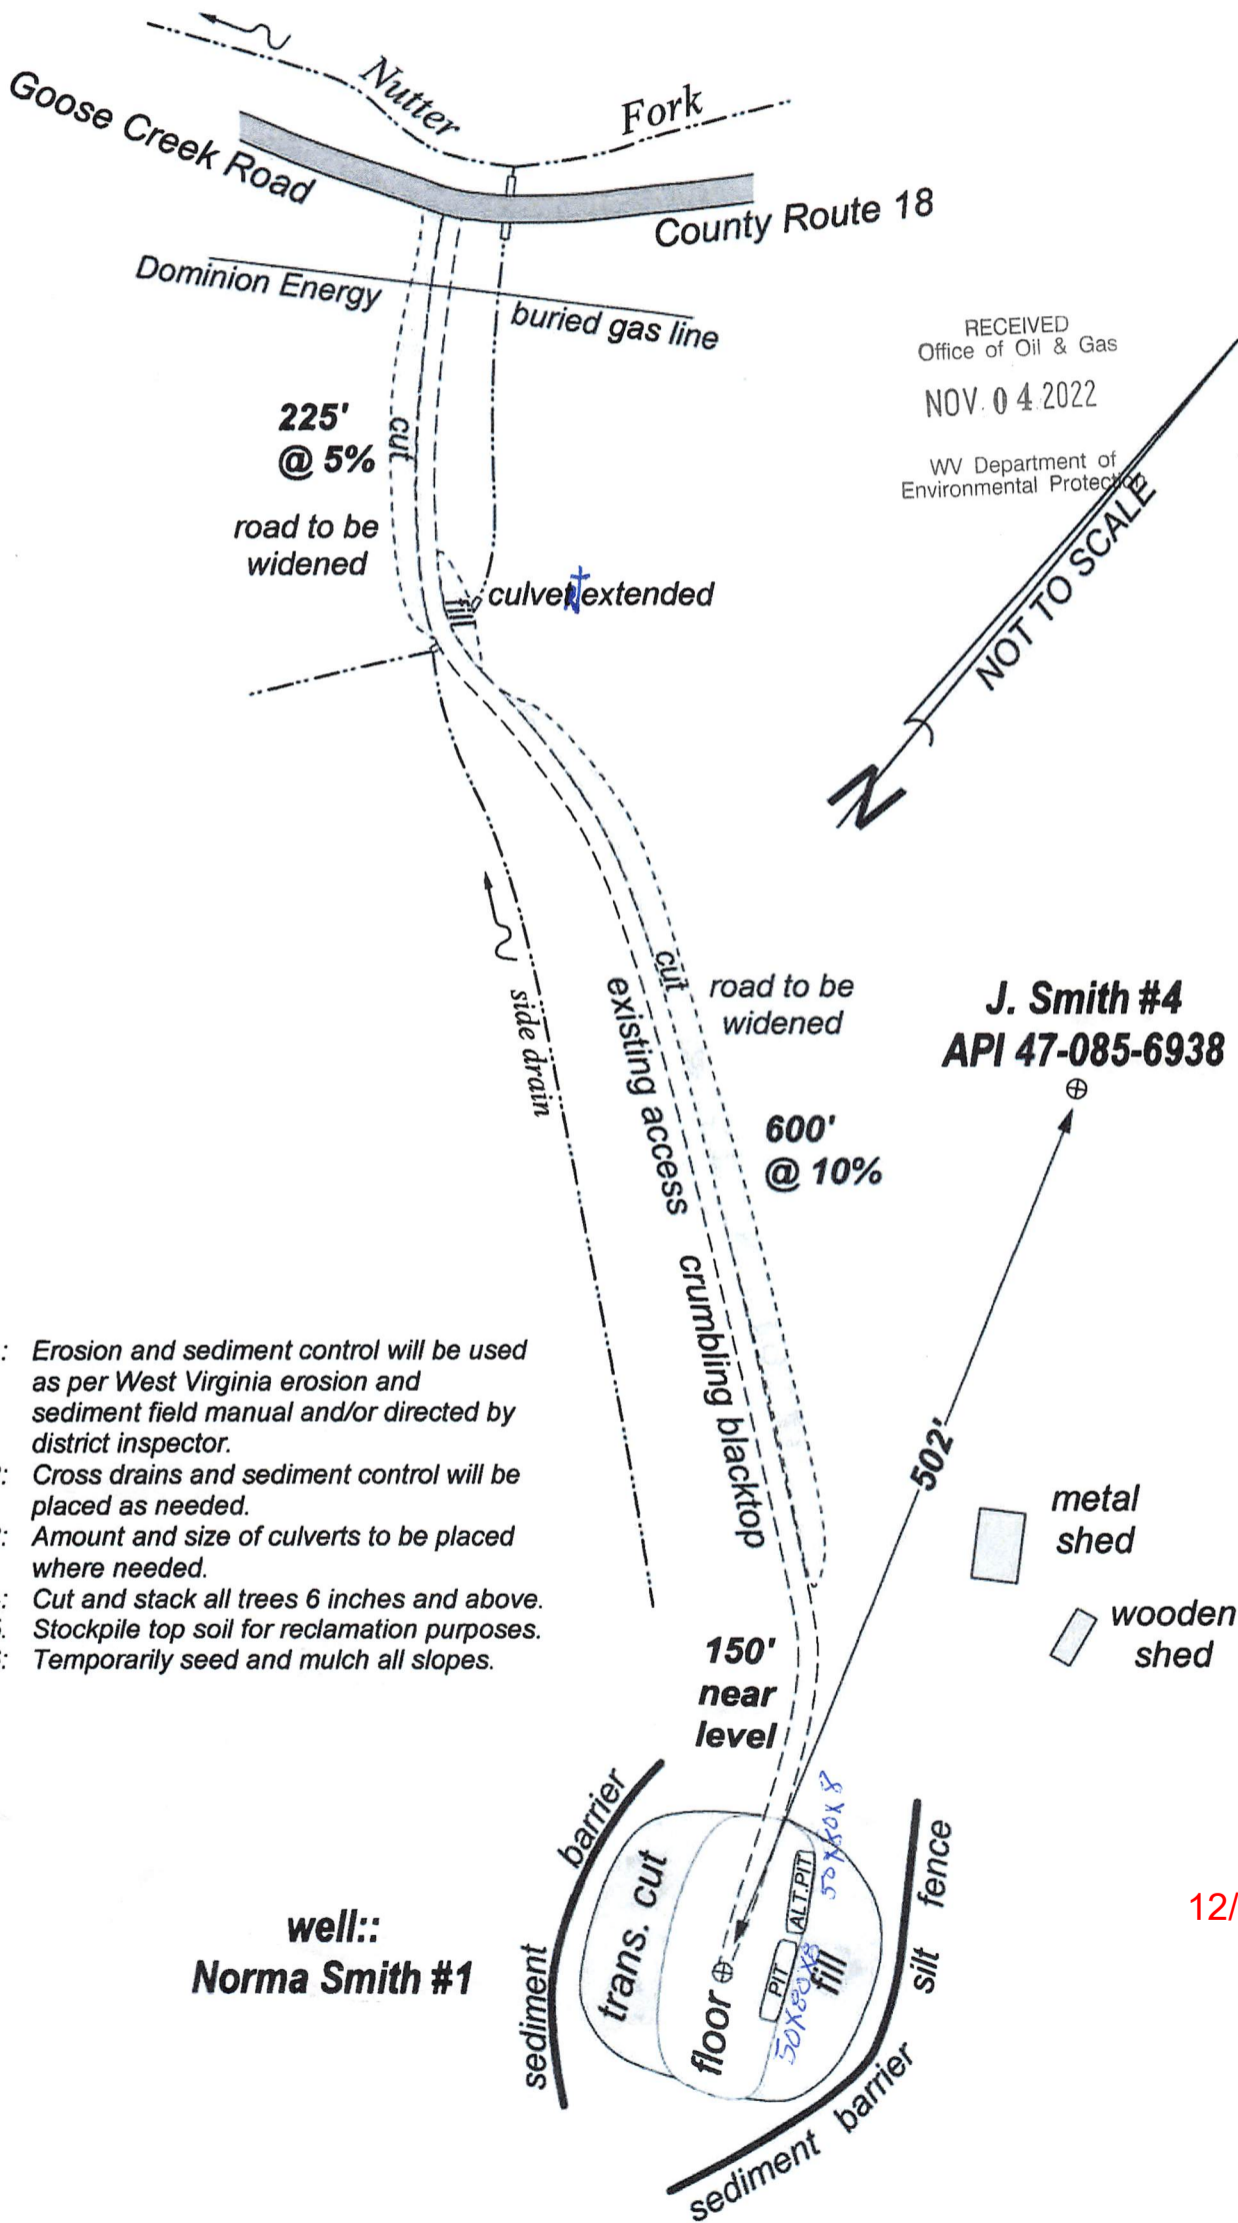

RECEIVED
Office of Oil & Gas
NOV. 04 2022
WV Department of
Environmental Protection

J. Smith #4
API 47-085-6938

- 1: Erosion and sediment control will be used as per West Virginia erosion and sediment field manual and/or directed by district inspector.
- 2: Cross drains and sediment control will be placed as needed.
- 3: Amount and size of culverts to be placed where needed.
- 4: Cut and stack all trees 6 inches and above.
- 5: Stockpile top soil for reclamation purposes.
- 6: Temporarily seed and mulch all slopes.

well::
Norma Smith #1

12/09/2022

Stephen
Mccoy

Digitally signed by
Stephen Mccoy
Date: 2022.11.03
11:48:40 -04'00'