



### Oil&Gas

#### Wells, Horizontal Only

##### WellStatus

-  Active Well
-  Permit Issued
-  Permit Application
-  Plugged

#### Wells, Active Status Only


##### WellUse

-  Brine Disposal
-  Fluid Injection
-  Gas Production
-  House Gas
-  Observation
-  Oil Production
-  Production
-  Solution Mining
-  Storage
-  Vent
-  <all other values>

#### Wells, Other than Active Status

##### WellUse

-  Brine Disposal
-  Fluid Injection
-  Gas Production
-  House Gas
-  Observation
-  Oil Production
-  Production
-  Solution Mining

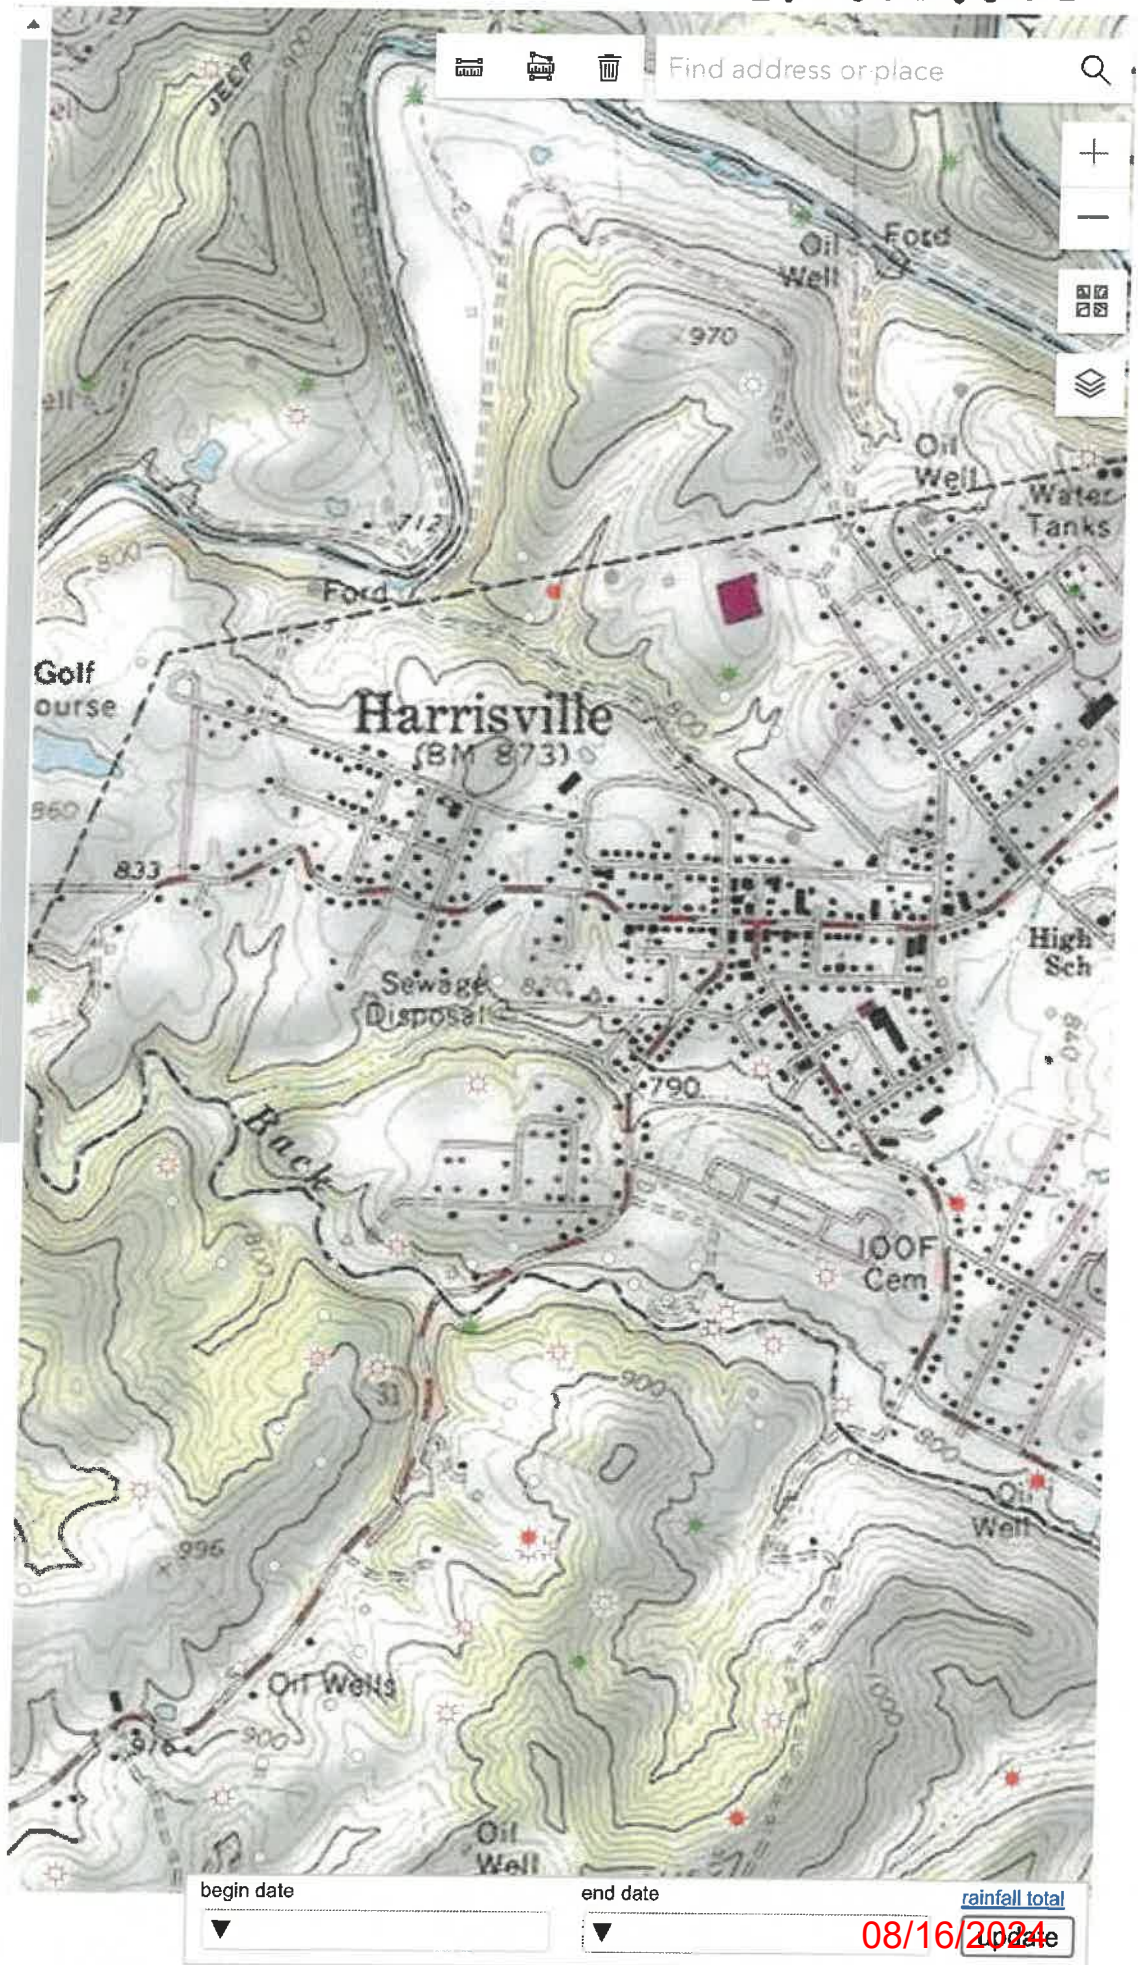

WW-7  
8-30-06



West Virginia Department of Environmental Protection  
Office of Oil and Gas

**WELL LOCATION FORM: GPS**

API: 4708510534 WELL NO.: Mosser 80629

FARM NAME: Roena Mosser

RESPONSIBLE PARTY NAME: DEP Paid Plugging Contract

COUNTY: Ritchie DISTRICT: Union

QUADRANGLE: Harrisville

SURFACE OWNER: Roena Mosser

ROYALTY OWNER: Gene Stalnaker

UTM GPS NORTHING: 4 96 323

UTM GPS EASTING: 43 40 563 GPS ELEVATION: 916'

The Responsible Party named above has chosen to submit GPS coordinates in lieu of preparing a new well location plat for a plugging permit or assigned API number on the above well. The Office of Oil and Gas will not accept GPS coordinates that do not meet the following requirements:

1. Datum: NAD 1983, Zone: 17 North, Coordinate Units: meters, Altitude: height above mean sea level (MSL) – meters.
2. Accuracy to Datum – 3.05 meters
3. Data Collection Method:

Survey grade GPS \_\_\_\_: Post Processed Differential \_\_\_\_

Real-Time Differential \_\_\_\_

Mapping Grade GPS X: Post Processed Differential \_\_\_\_

Real-Time Differential \_\_\_\_

4. **Letter size copy of the topography map showing the well location.**

I the undersigned, hereby certify this data is correct to the best of my knowledge and belief and shows all the information required by law and the regulations issued and prescribed by the Office of Oil and Gas.

Bryan Harris

July 16, 2024

Signature

Title

Date

RECEIVED  
Office of Oil and Gas

AUG 13 2024

WV Department of  
Environmental Protection

08/16/2024