


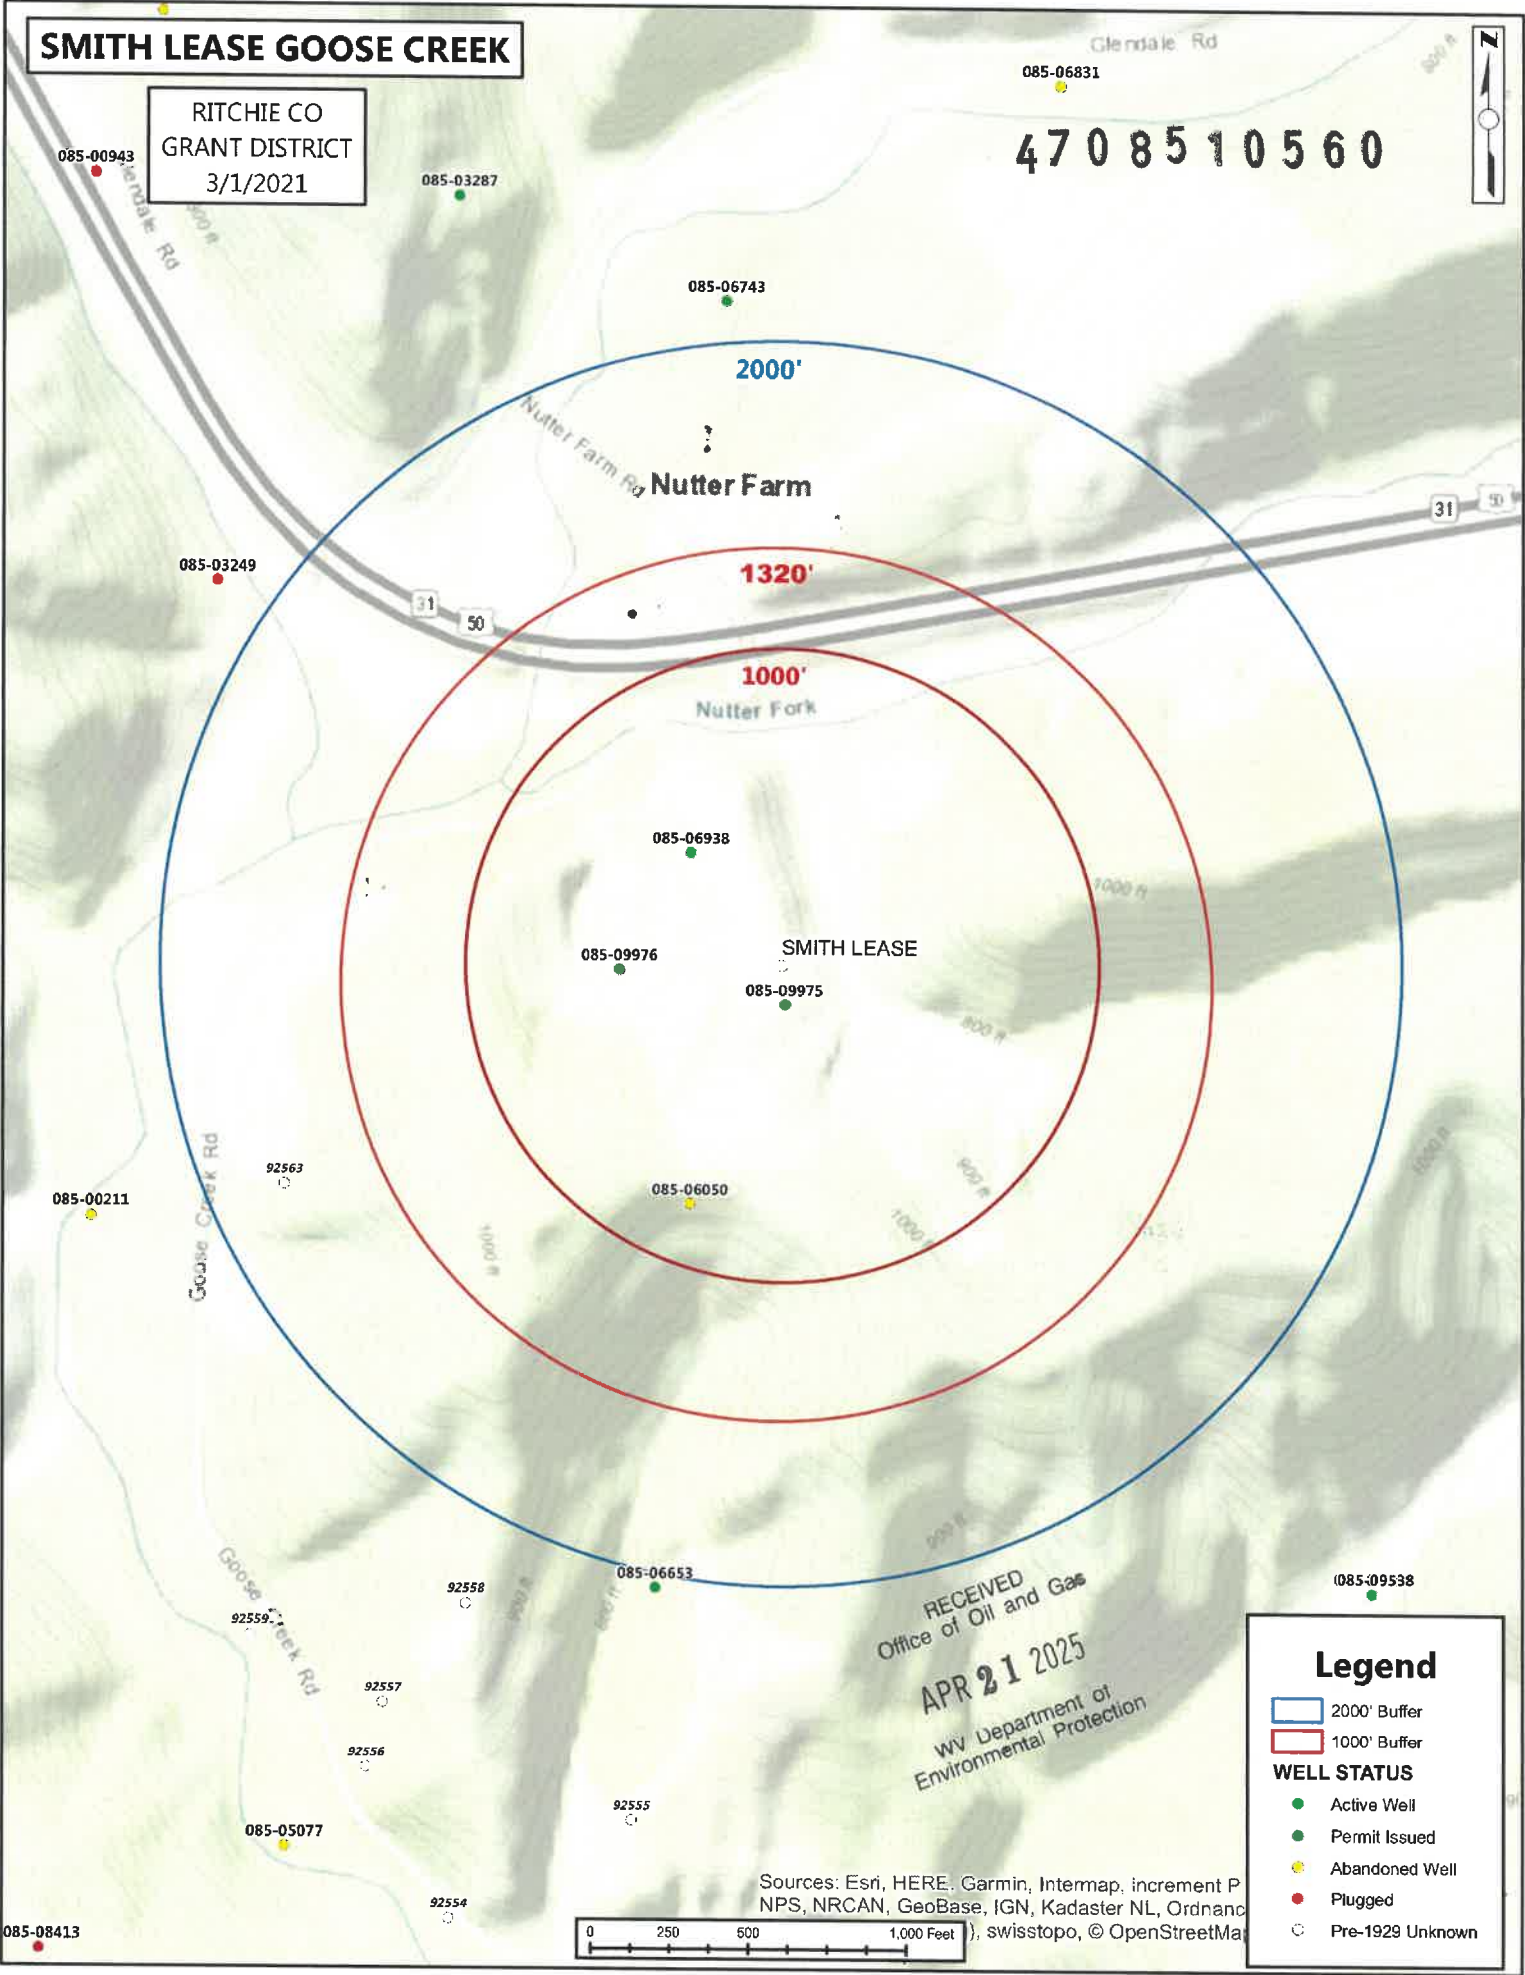


05/09/2025


SMITH LEASE GOOSE CREEK

RITCHIE CO
GRANT DISTRICT
3/1/2021

Water Well Sampling Sites
1-4

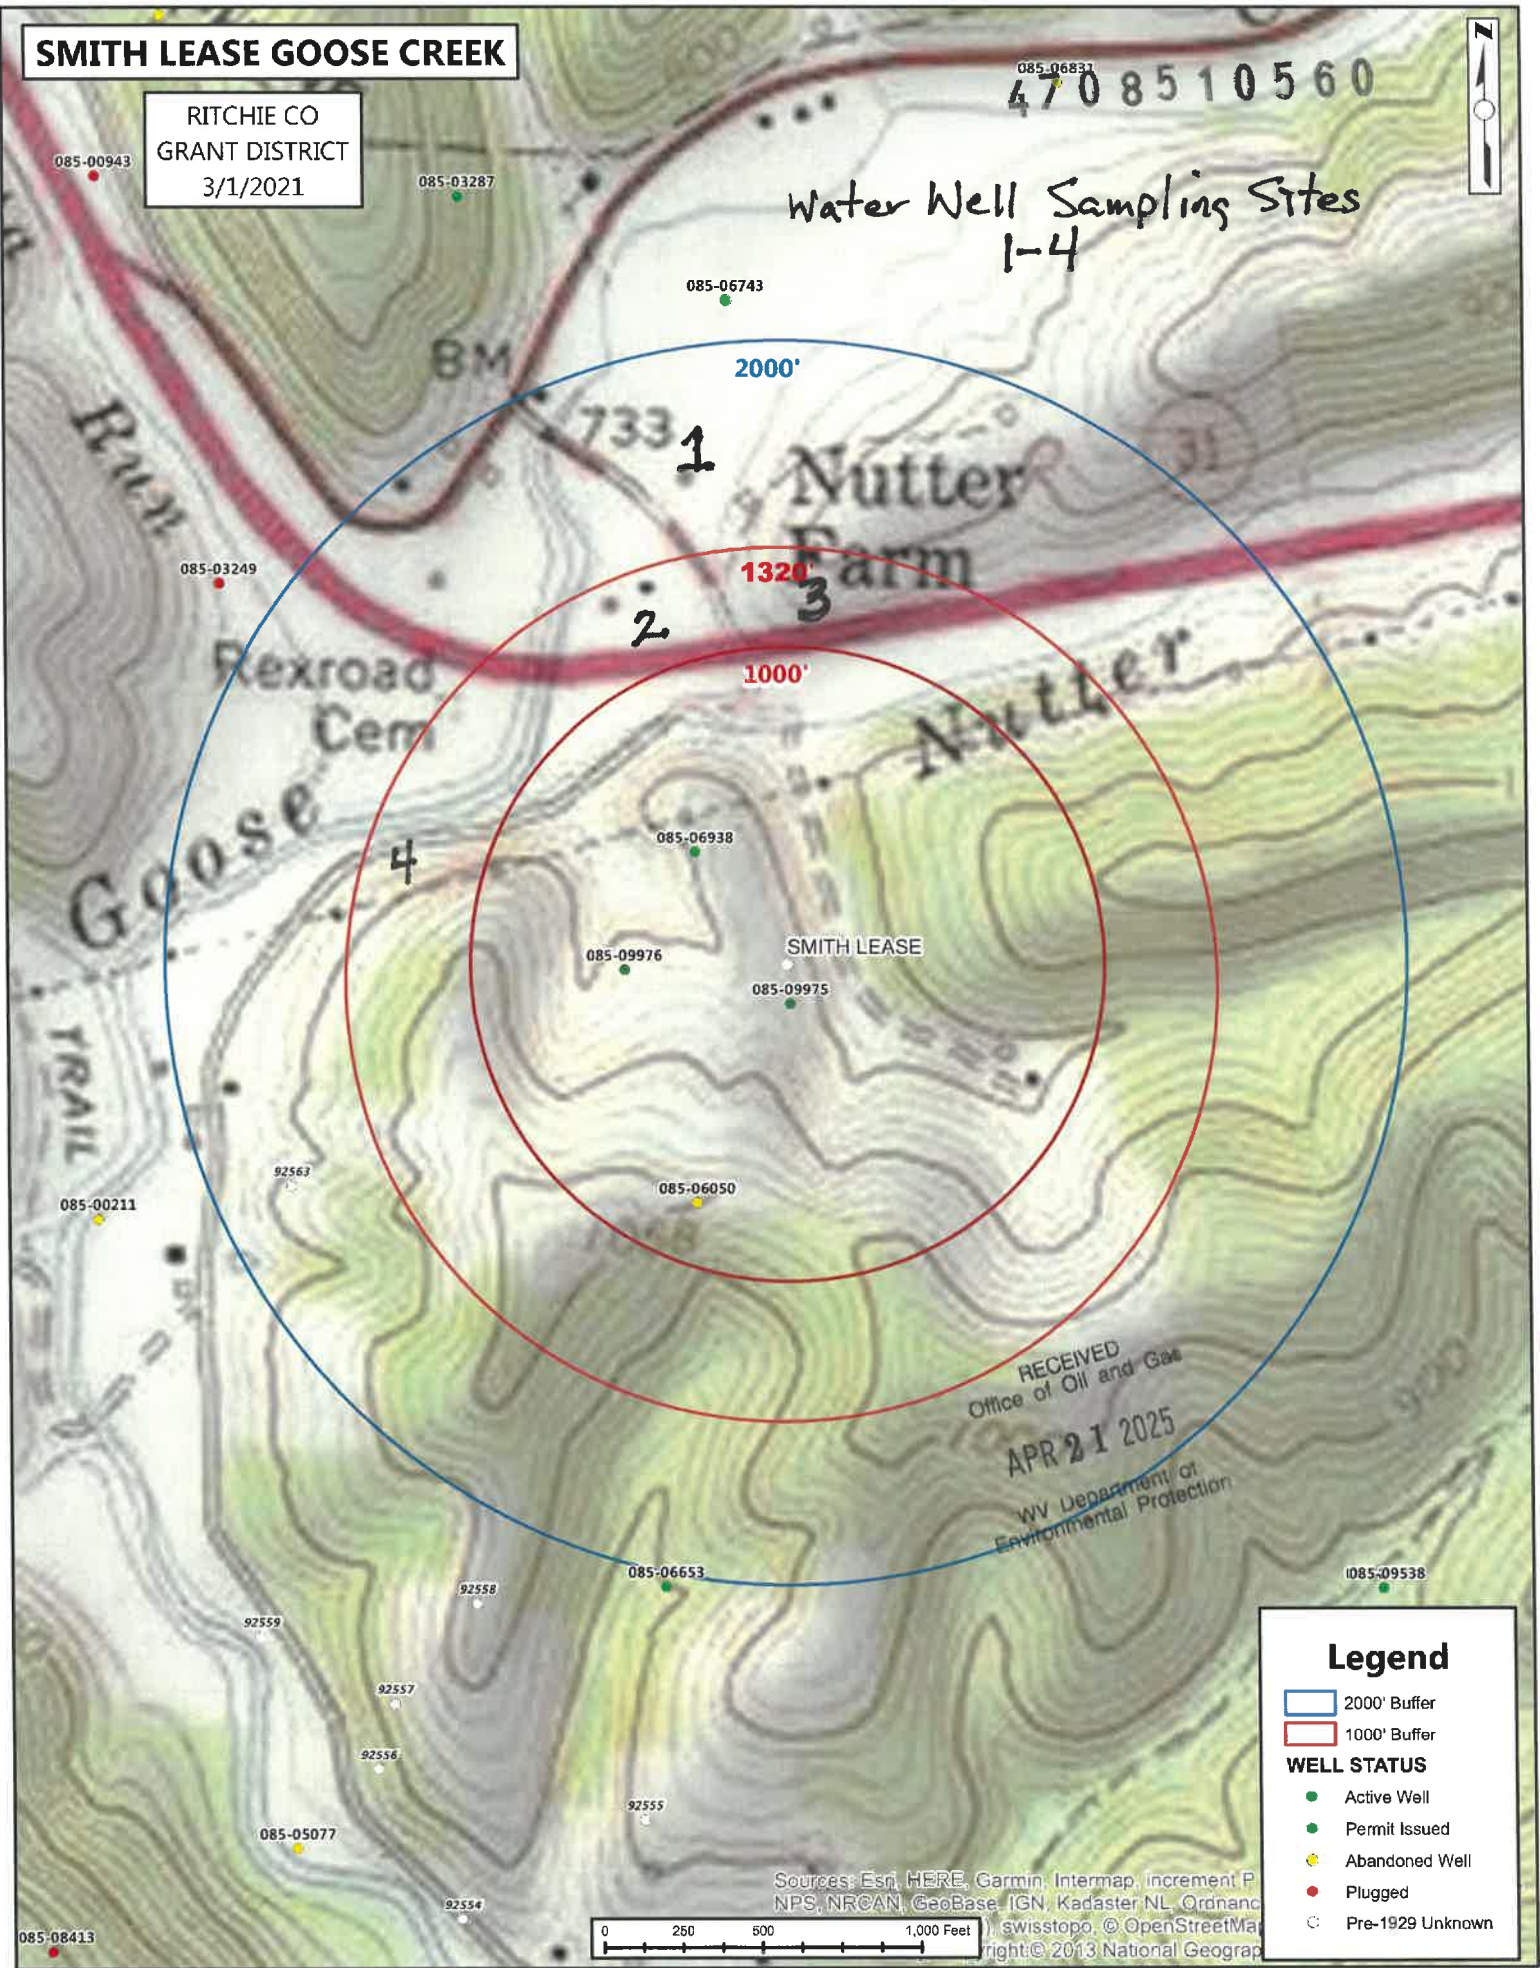

05/09/2025

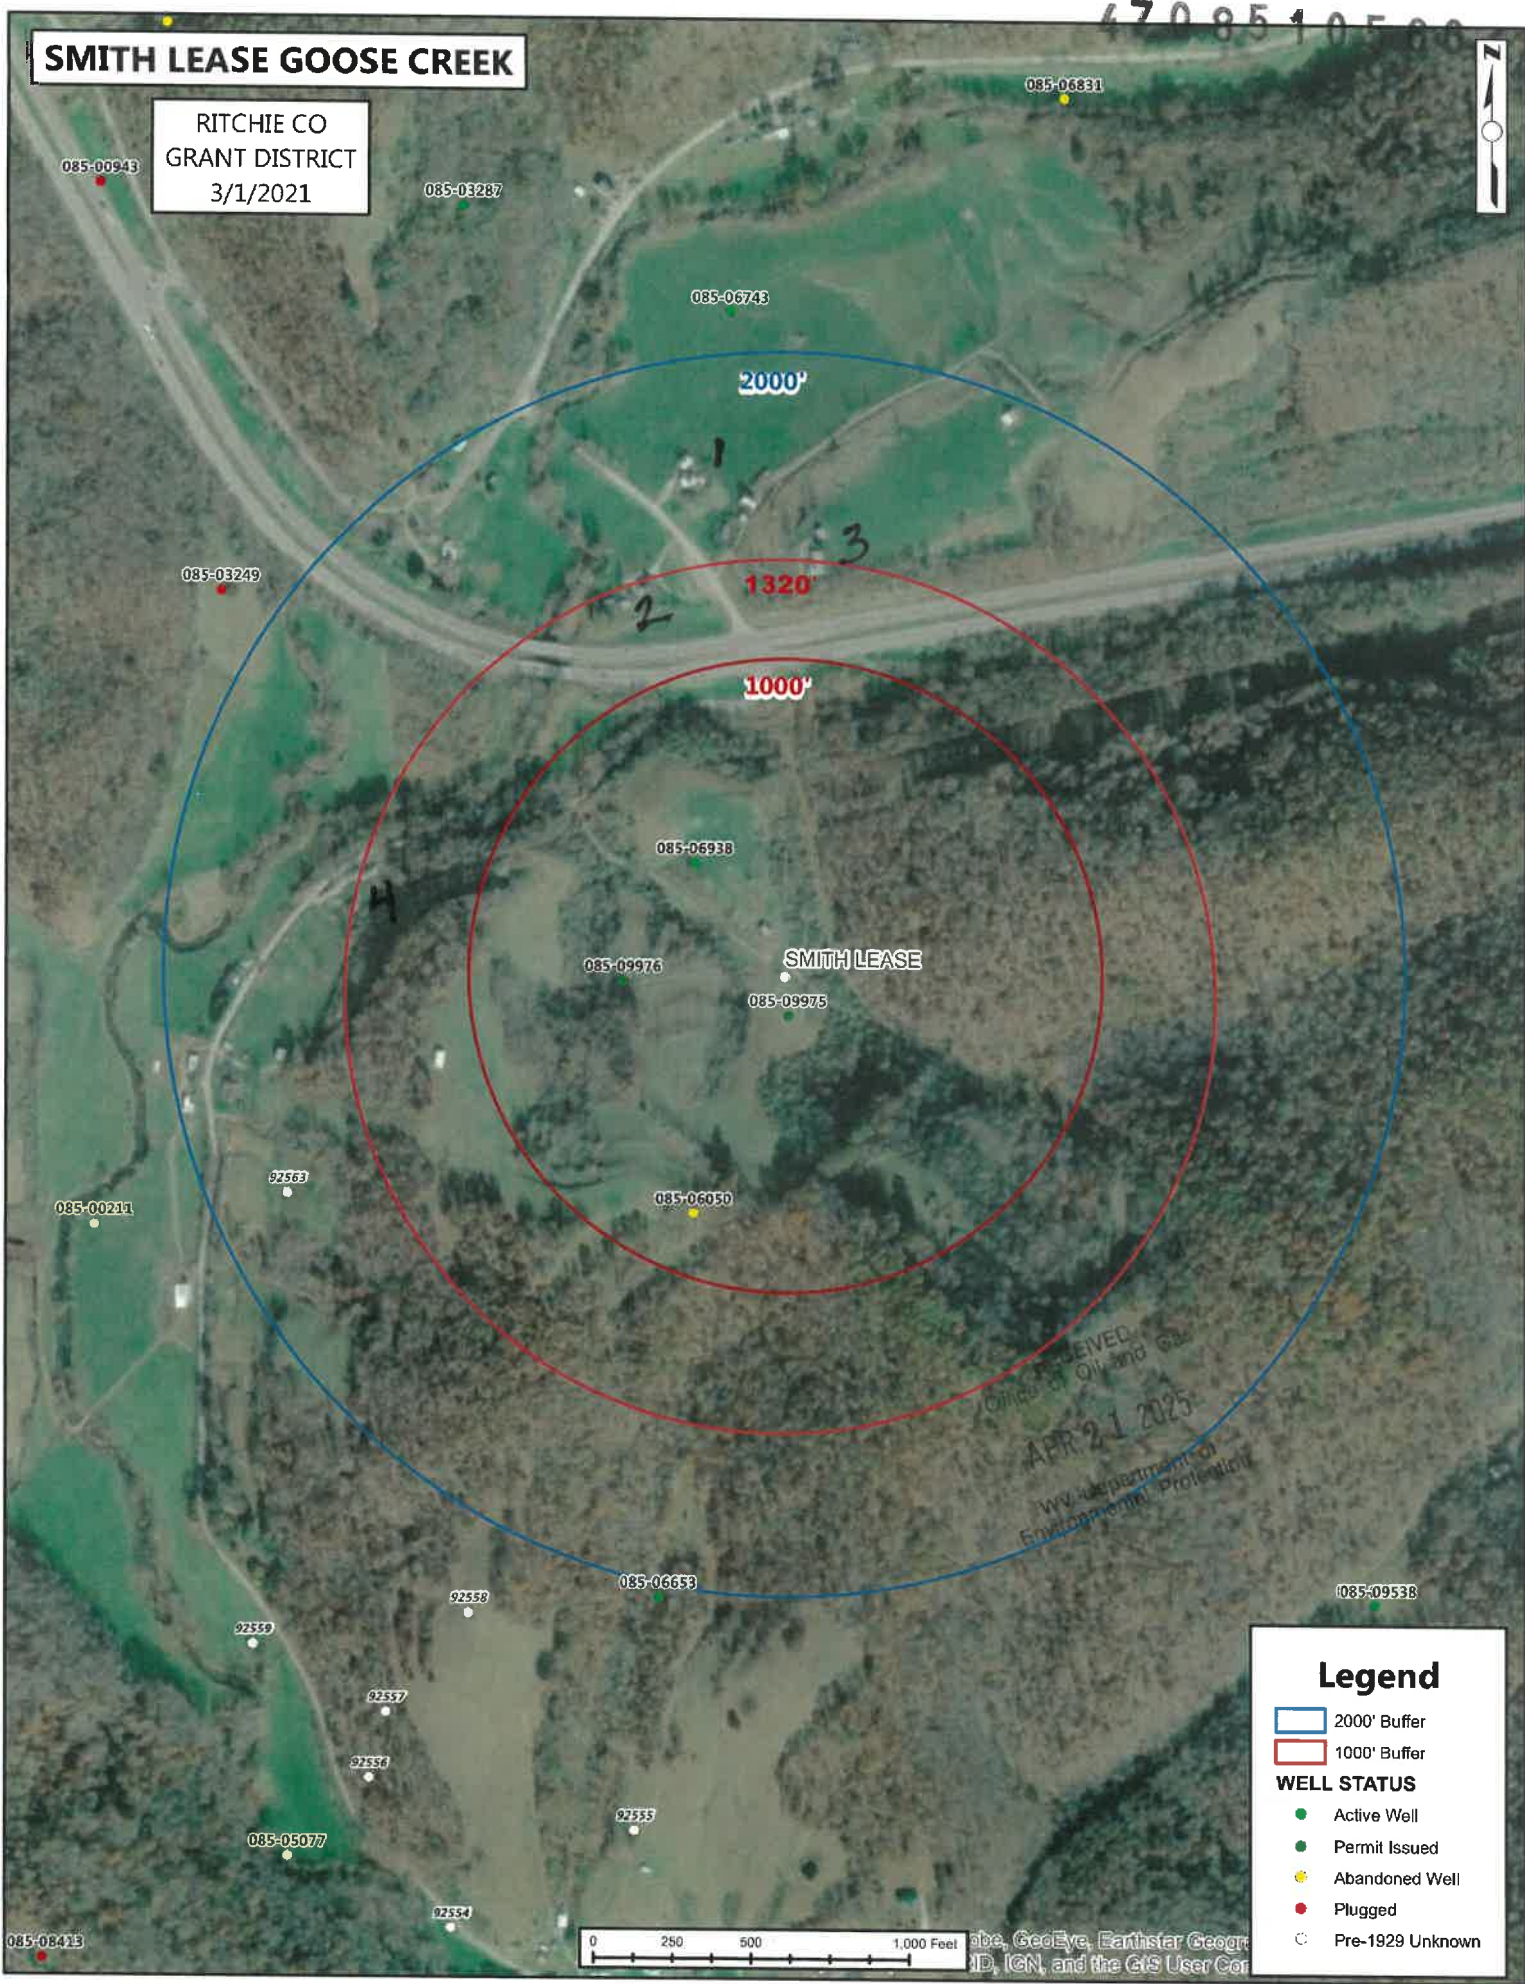

05/09/2025