


For GPP

4708510580

MOUNTAINEER WELL SERVICES, LLC
Well: Norma Smith # 1R
Norma Smith, et al +/- 157 Acre Lease
Grant District Ritchie County West Virginia

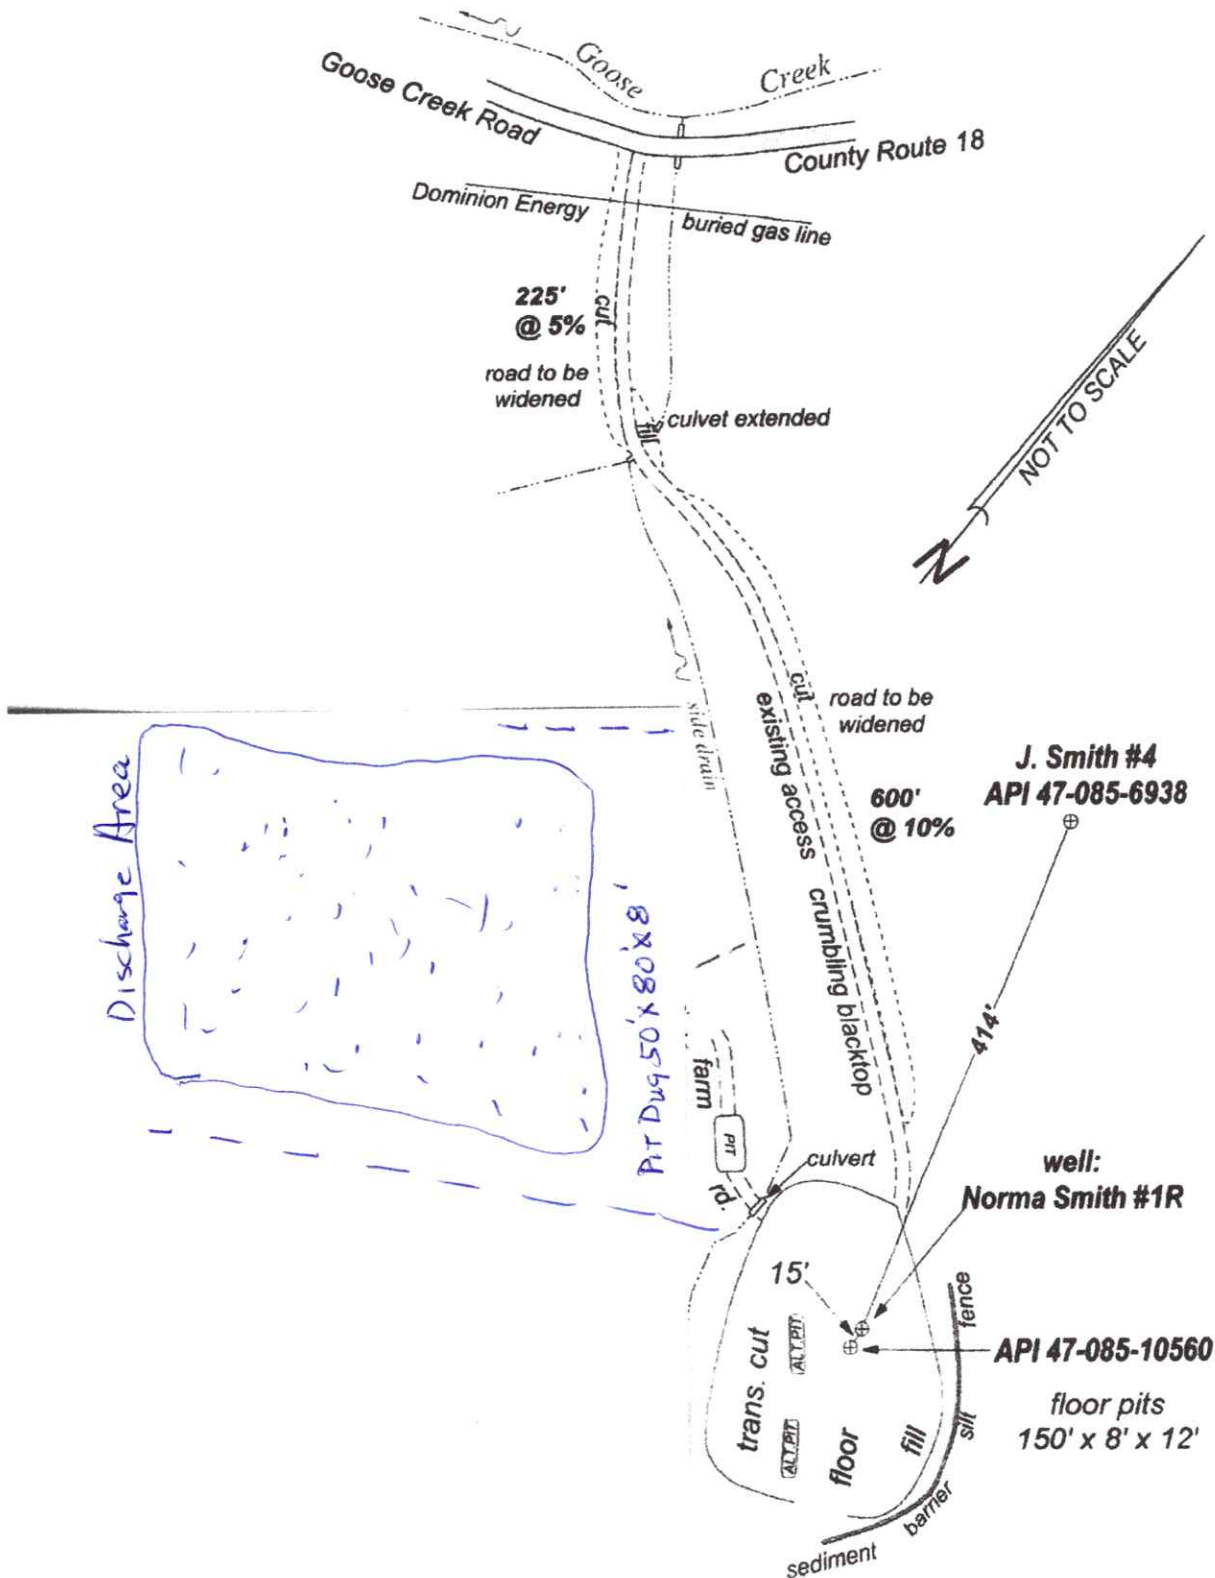

RECEIVED
Office of Oil and Gas

JAN 08 2026


WV Department of
Environmental Protection

01/16/2026

MOUNTAINEER WELL SERVICES, LLC
Well: Norma Smith # 1R
Norma Smith, et al +/- 157 Acre Lease
Grant District Ritchie County West Virginia



7708310580

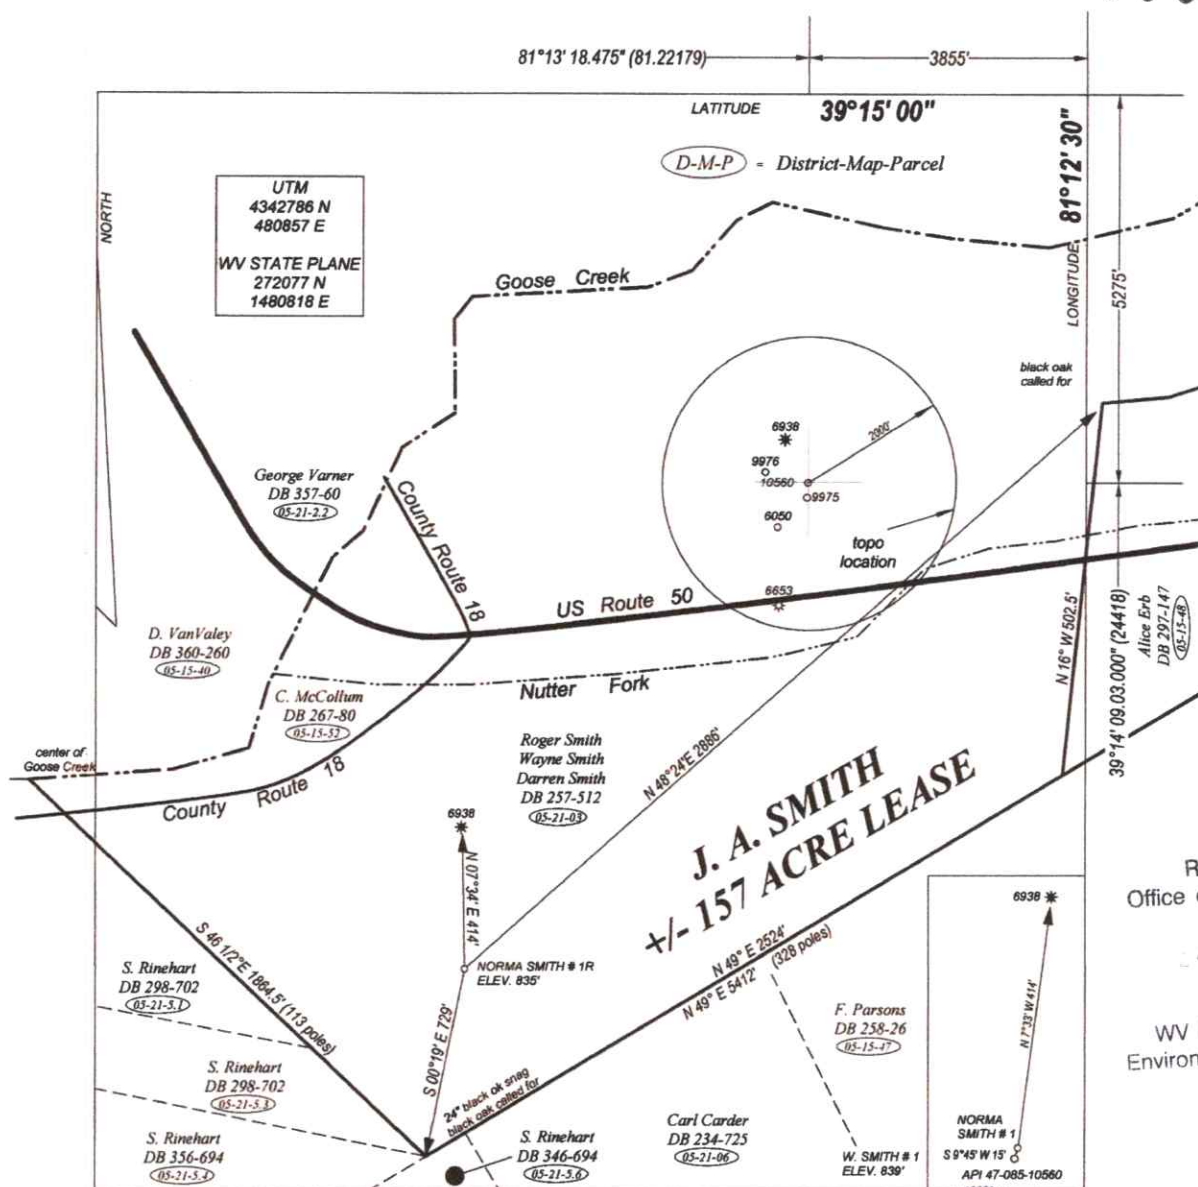

RECEIVED
Office of Oil and Gas


08 2026

WV Department of
Environmental Protection

FILE NO. _____
DRAWING NO. _____
SCALE 1" = 500'
MINIMUM DEGREE
OF ACCURACY 1:200
PROVEN SOURCE
OF ELEVATION GPS
OBSERVATION

I, THE UNDERSIGNED, HEREBY CERTIFY THAT THIS
PLAT IS CORRECT TO THE BEST OF MY KNOWLEDGE
AND BELIEF AND SHOWS ALL THE INFORMATION
REQUIRED BY LAW AND THE REGULATIONS ISSUED
AND PRESCRIBED BY THE DEPARTMENT OF ENERGY

(SIGNED) *[Signature]*
PROFESSIONAL SURVEYOR: 551

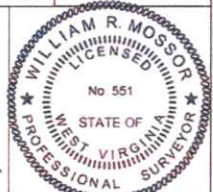

STATE OF WEST VIRGINIA
DEPARTMENT OF ENERGY
DIVISION OF OIL AND GAS

DATE DECEMBER 31ST, 2025
OPERATORS WELL NO. NORMA SMITH #1R

API 47 - 085 -
STATE COUNTY PERMIT

WELL TYPE: OIL ☐ GAS ☐ LIQUID INJECTION ☐ WASTE DISPOSAL ☒
(IF GAS) PRODUCTION ☐ STORAGE ☐ DEEP ☒ SHALLOW ☐

LOCATION: ELEVATION 835' WATER SHED NUTTER FORK OF GOOSE CREEK
DISTRICT GRANT COUNTY MITCHELL QUADRANGLE CAIRO

SURFACE OWNER ROGER SMITH 1/3, WAYNE SMITH 1/3, ROGER SMITH & DARREN SMITH 1/3 ACREAGE +/- 157.63
OIL & GAS ROYALTY NORMA SMITH, ET AL LEASE AC +/- 157

PROPOSED WORK: DRILL ☒ CONVERT ☐ DRILL DEEPER ☐ REDRILL ☐
FRACTURE OR STIMULATE ☒ PLUG OFF OLD FORMATION ☐
PERFORATE NEW FORMATION ☒
OTHER PHYSICAL CHANGE IN WELL _____
PLUG AND ABANDON ☐ CLEAN OUT AND REPLUG ☐

TARGET FORMATION ORISKANY - BASS ISLAND ESTIMATED DEPTH 5700' TO 6300'

WELL OPERATOR MOUNTAINEER WELL SERVICES, LLC DESIGNATED AGENT PAT BRAKE
ADDRESS 579 CAMPUS DRIVE, SUITE 220 ADDRESS P. O. BOX 2722
WESTERVILLE, OH 43087 BUCKHANNON, WV 26201

FORM WV-8

COUNTY NAME
PERMIT

01/16/2026