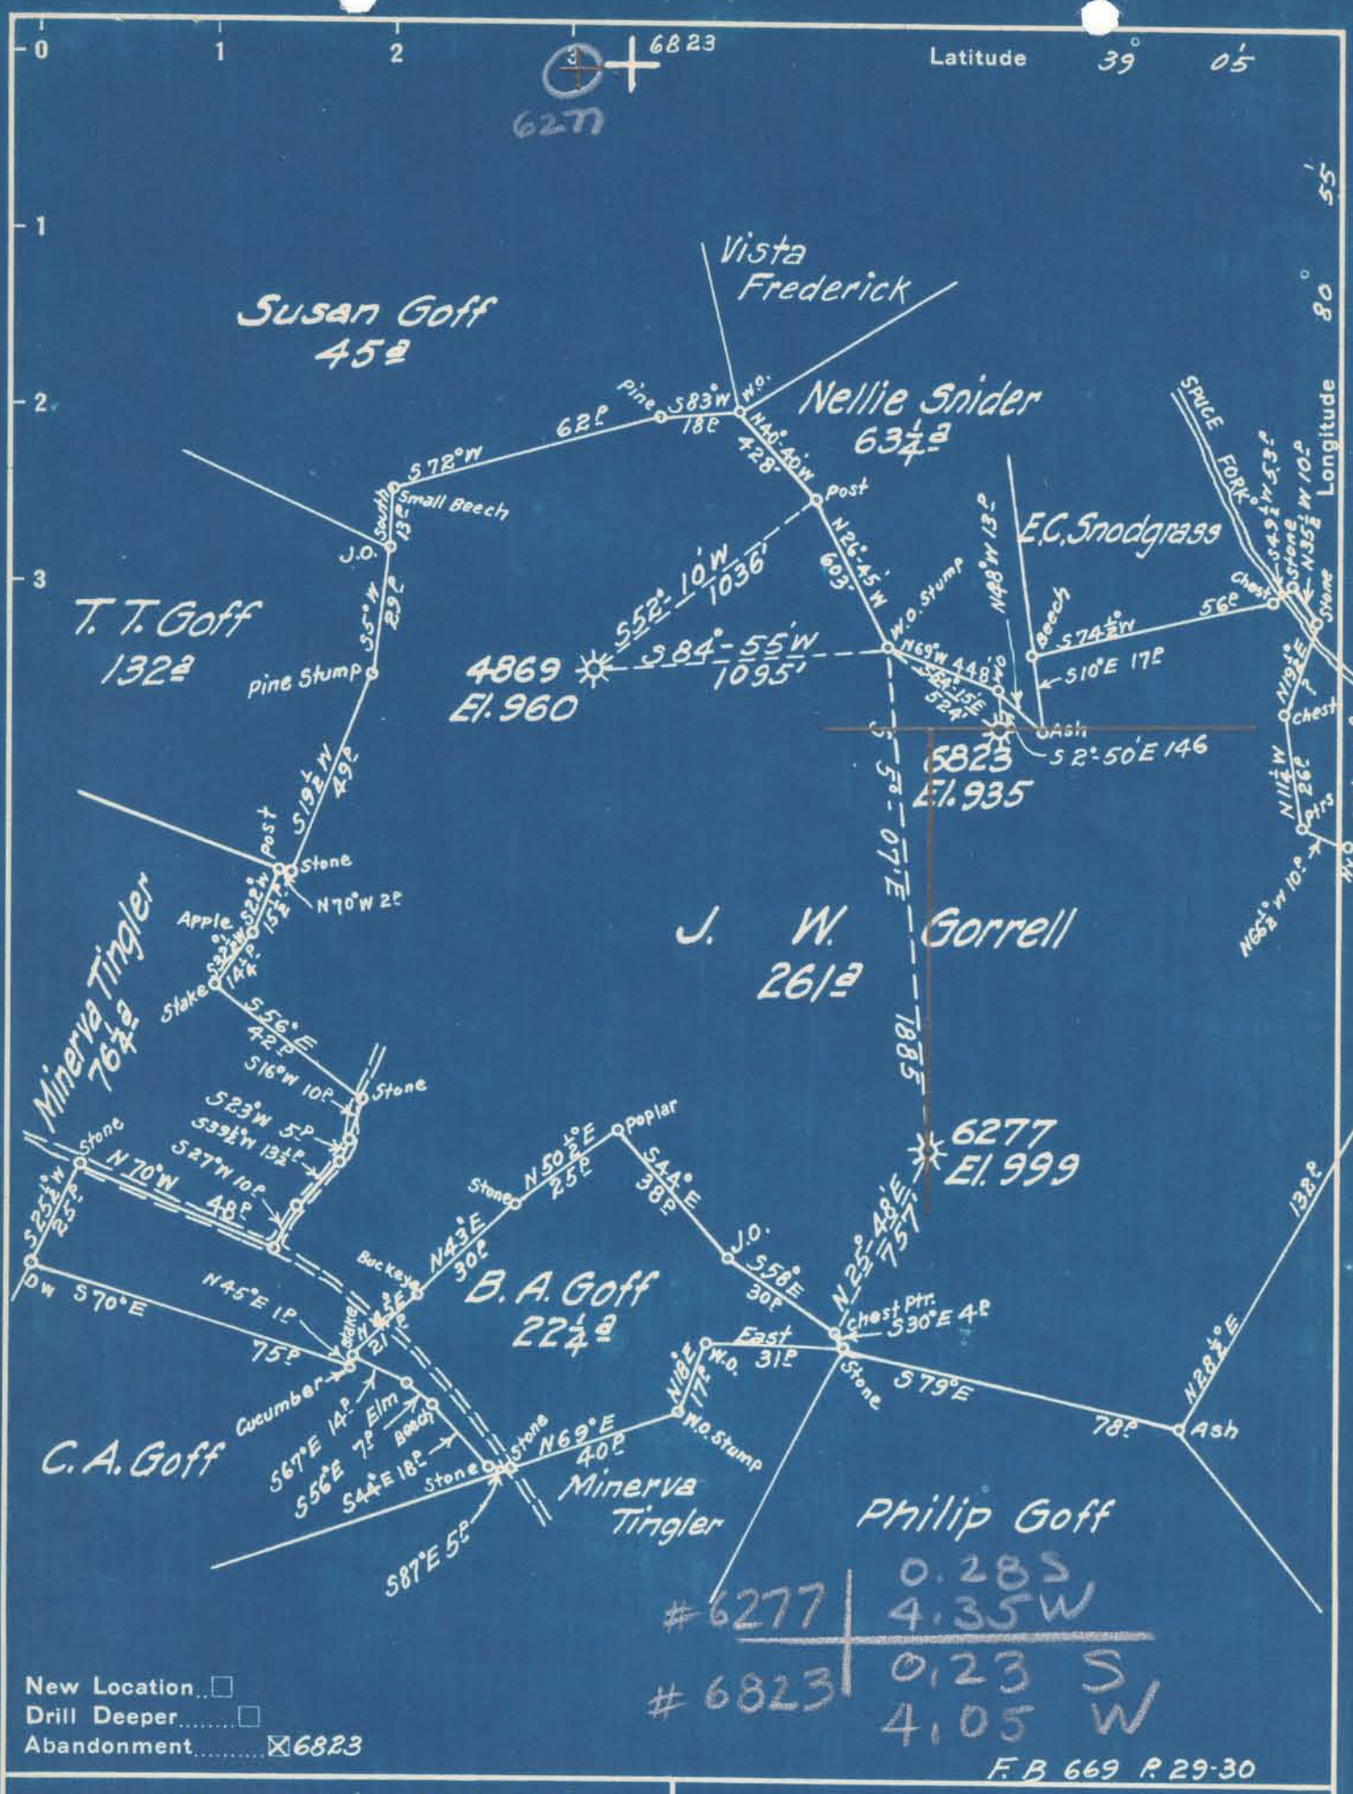

New Location ☐
Drill Deeper ☐
Abandonment ☒ 6823

F.B. 669 P. 29-30

Company Hope Natural Gas Co.
Address Clarksburg, W. Va.
Farm J. W. Gorrell
Tract _____ Acres 261 Lease No. 14001
Well (Farm) No. 3 Serial No. 4869-6277-6823
Elevation (Spirit Level) 960-999-935
Quadrangle Holbrook
County Ritchie District Murphy
Engineer Wm Bowers
Engineer's Registration No. 900
File No. _____ Drawing No. _____
Date Feb. 17, 1939 Scale 1" = 40 rds

STATE OF WEST VIRGINIA
DEPARTMENT OF MINES
OIL AND GAS DIVISION
CHARLESTON

WELL LOCATION MAP

FILE NO. Rit-389-A
6823 4277— Rit 734-A

+ Denotes location of well on United States Topographic Maps, scale 1 to 62,500, latitude and longitude lines being represented by border lines as shown.

— Denotes one inch spaces on border line of original tracing.

SW

PRINTED ON "IMPERIAL" TRACING CLOTH K & E CO., N. Y.

1564

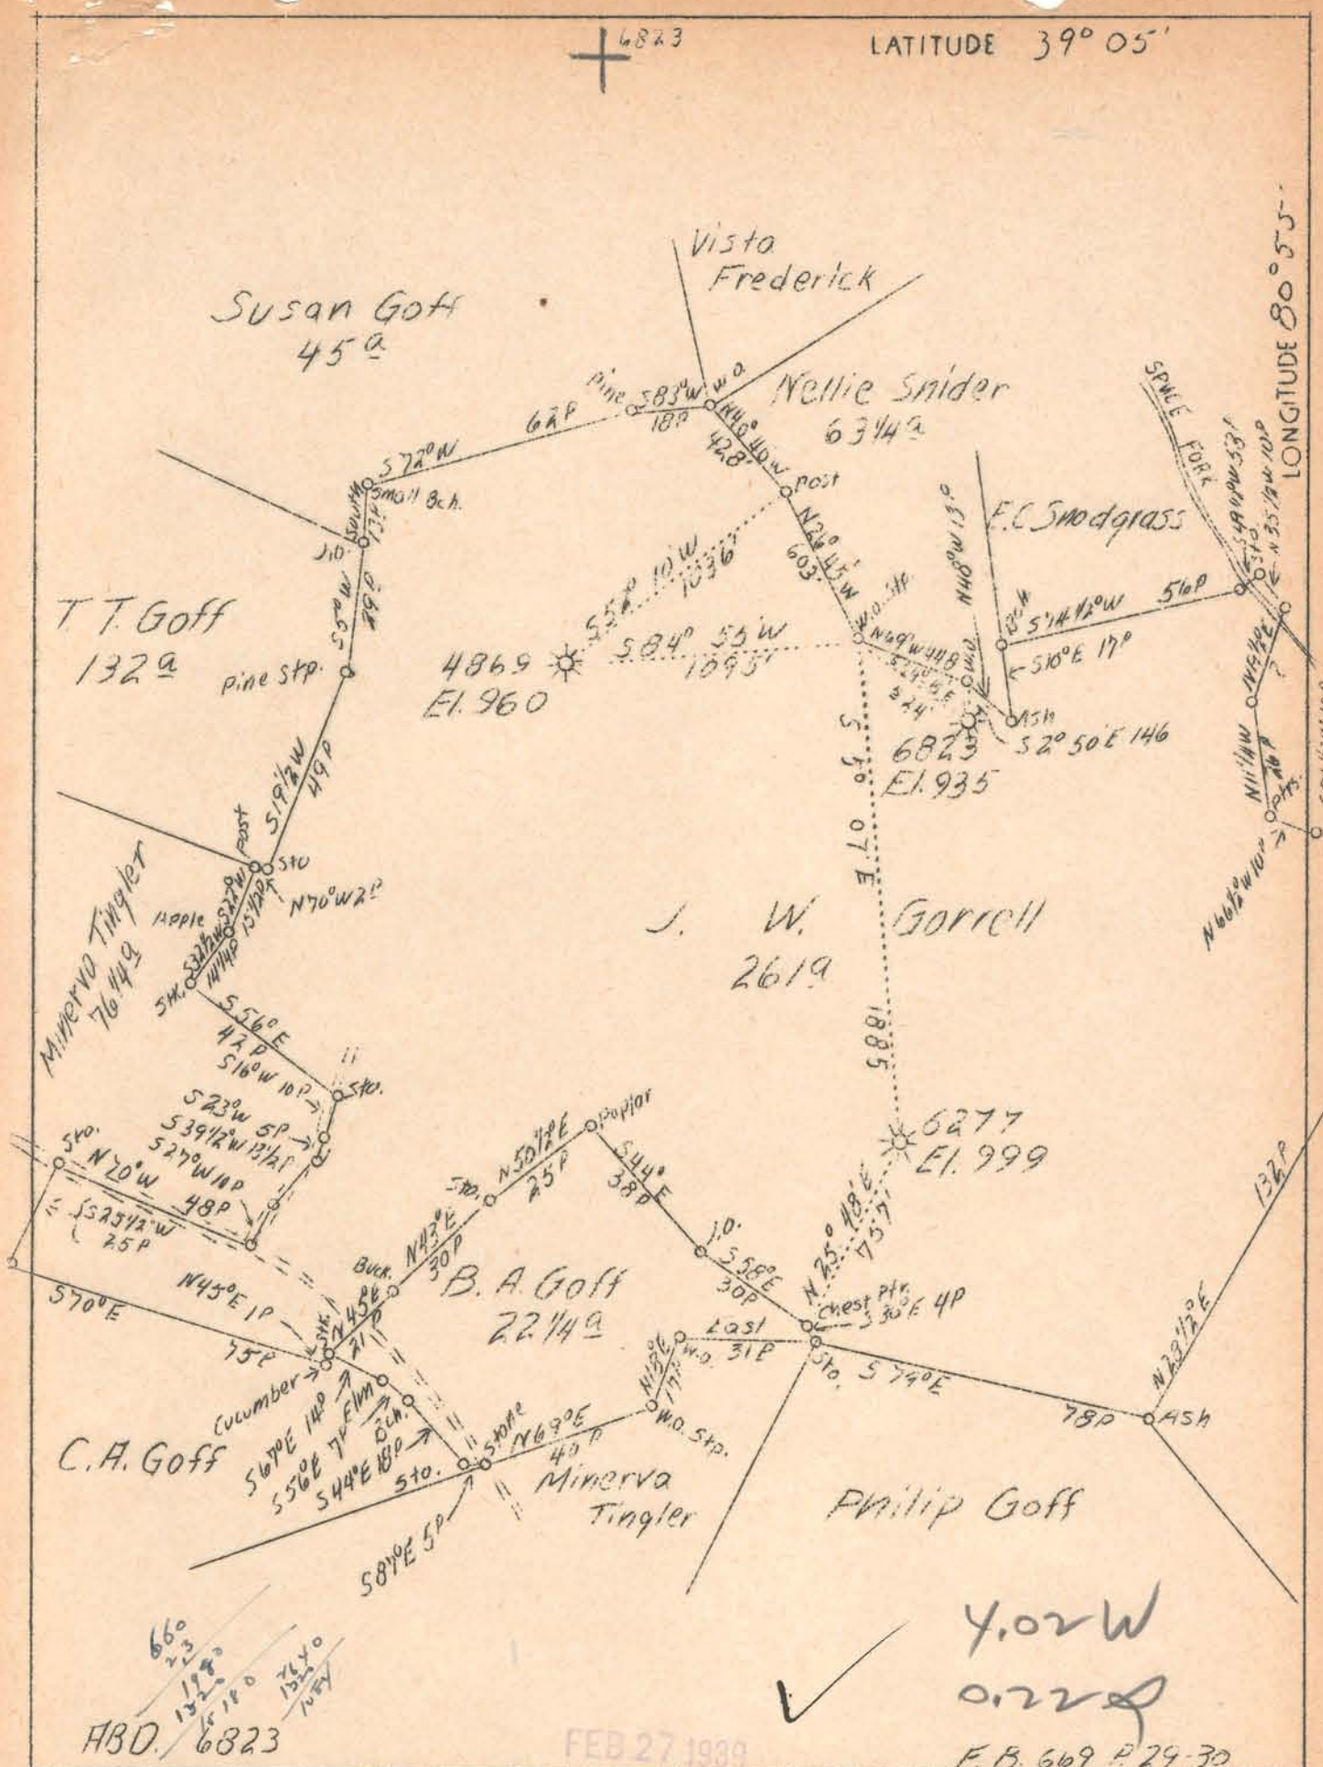

Company	Hope Natural Gas Co.
Address	Clarksburg, W. Va.
Farm	J. W. Gorrell
Acres	261
Lease No.	14001
Well (Farm) No.	3
Serial No.	4869 - 6277 - 6823
Elevation (SL)	960 - 999 - 935
Quadrangle	Holbrook
County	Ritchie
District	Murphy
Engineer	W. M. Bowers
Eng. Reg. No.	900
Date	Feb. 17, 1939
Scale	1" - 40 poles

SW

STATE OF WEST VIRGINIA
Department of Mines
OIL & GAS DIVISION
Charleston

Well location map

File No. Rit-389-A
Well #6823

x Denotes location of well on U. S. Topographic Maps, scale 1 to 62,500, latitude and longitude lines being represented by border lines as shown.

- Denotes one inch spaces on border line of original tracing.

J. W. GORRELL NO. 3 - (6823) HOPE NATURAL GAS CO. - 1564 RIT-389-A.

J. W. CORRELL NO. 6823 WELL. No. 446 O.W.-Ritchie.

389A

Murphy District, Ritchie County, W. Va.
By Hope Natural Gas Co., Clarksburg, W. Va.
On 261 acres, on Spruce Creek.
Elevation, 935' L.
Surface owned by Aaron A. Tingler, Burnt House, W. Va.
Drilling commenced Oct. 4, 1926; completed, Nov. 8, 1926.
Shot Dec. 8, 1926, at 1733-1740'.
No water recorded.
10" casing, 147' (pulled); 8¼", 1011'; 6⅝", 1895' (pulled).
Casing not cemented. No coal was encountered.
Gas well. Abandonment reported to Dept. of Mines Feb. 17, 1939.
Record to RCT from Mrs. Griffith March 6, 1939.

	Top.	Bottom.
Little Dunkard Sand	905 -	910
Gas Sand	1017 -	1186
First Salt Sand	1375 -	1430
Second Salt Sand (gas, 1657')	1590 -	1681
Maxton Sand (gas, 1739')	1704 -	1742
Little Lime	1806 -	1833
Pencil Cave	1833 -	1838
Big Lime	1838 -	1915
Big Injun Sand	1915 -	1980
Berea Sand	2330 -	2337
Original total depth		2525
Lower hole abandoned and filled to present total depth		1775

OG-10

STATE OF WEST VIRGINIA
DEPARTMENT OF MINES
OIL AND GAS DIVISION

WELL RECORD

Permit No. HP/389-A

Oil or Gas Well Gas (Kind)

Company Hope Natural Gas Company
Address Clarksburg, W. Va.
Farm J. W. Gorrell Acres 261
Location (waters) Spruce Creek
Well No. 6823 (3) Elev. 935
District Murphy County Ritchie
The surface of tract is owned in fee by Aaron A. Tingler
Address Burnt House, W.Va.
Mineral rights are owned by
Address
Drilling commenced 10-4-1926
Drilling completed 11-8-1926
Date shot 12-8-1926 Depth of shot 1733-1740
Open Flow /10ths Water in Inch
/10ths Merc. in Inch
Volume Cu. Ft.
Rock Pressure lbs. hrs.
Oil bbls., 1st 24 hrs.
Fresh water None Recorded feet feet
Salt water None recorded feet feet

Casing and Tubing	Used in Drilling	Left in Well	Packers
Size			
16			Kind of Packer
13			
10	147	Pulled	Size of
8¼	1011	1011	
6 5/8	1895	Pulled	Depth set
5 3/16			
3			Perf. top
2			Perf. bottom
Liners Used			Perf. top
			Perf. bottom

CASING CEMENTED SIZE No. FT. Date
Not cemented
COAL WAS ENCOUNTERED AT FEET INCHES
FEET No coal INCHES FEET INCHES
FEET INCHES FEET INCHES

Formation	Color	Hard or Soft	Top	Bottom	Oil Gas or Water	Depth Found	Remarks
Little Dunkard Sand			905	910			
Gas Sand			1017	1188			
First Salt Sand			1375	1430			
Second Salt Sand			1590	1681	Gas	1657	
Maxon Sand			1704	1742	Gas	1739	
Little Lime			1808	1833			
Pencil Cave			1833	1838			
Big Lime			1838	1915			
Big Injun Sand			1915	1980			
Berea Sand			2330	2337			

Original total depth---------- 2525 lower hole abandoned and-
filled to present total depth ---- 1775

(Over)

MAR - 6 1939

Formation	Color	Hard or Soft	Top	Bottom	Oil, Gas or Water	Depth Found	Remarks

Date February 17, 1939

APPROVED Hope Natural Gas Company, Owner

By C. O. Reed General Supt.

(Title)