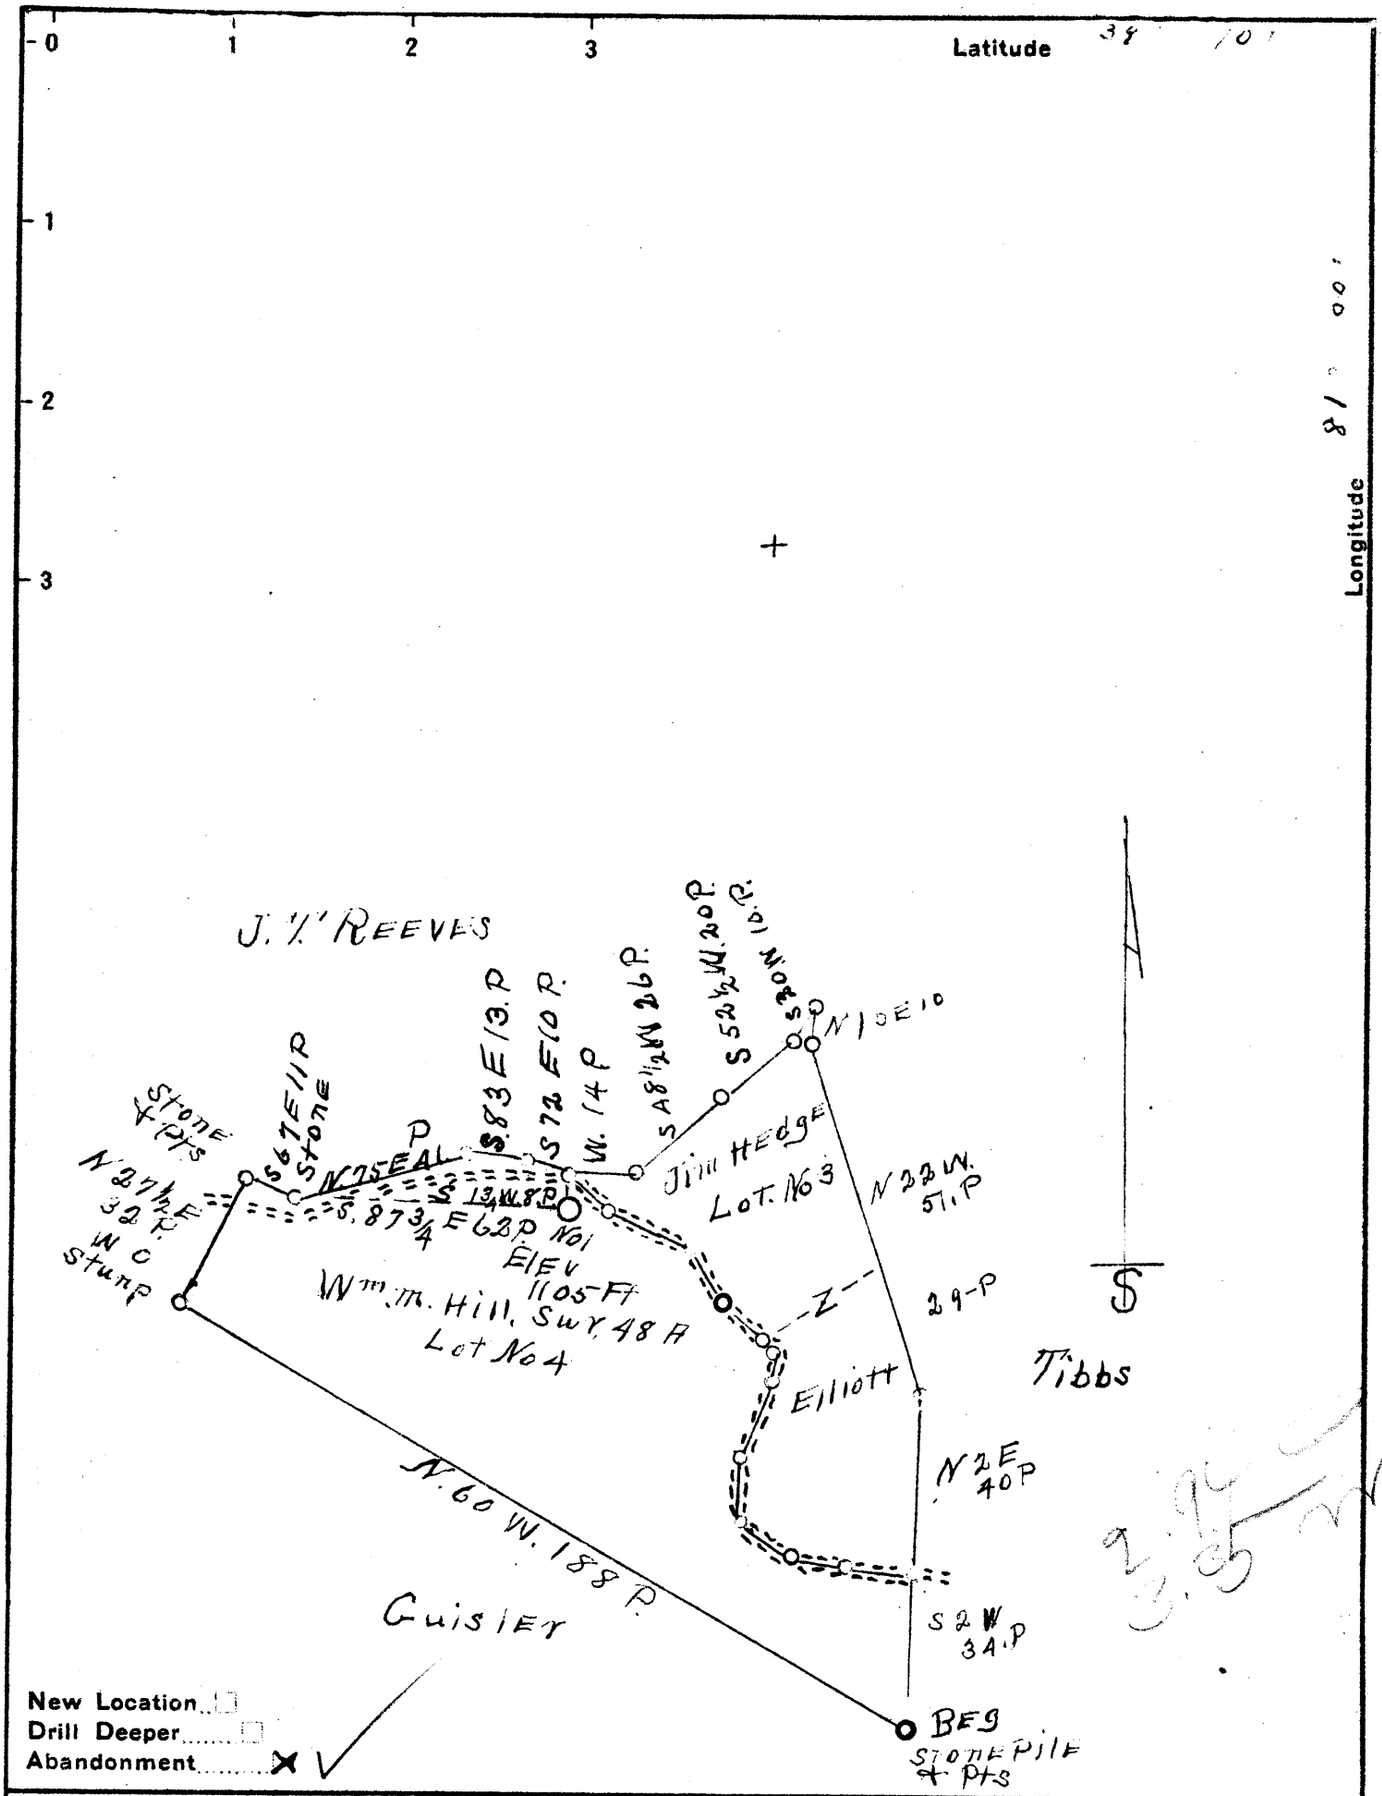

New Location ☐
Drill Deeper ☐
Abandonment ☒

Company J. J. Shore
Address 2106 Oak St. Parkersburg
Farm Wm M Hill
Tract 4 Acres 55 Lease No.
Well (Farm) No. Serial No.
Elevation (Spirit Level) 1105 Ft
Quadrangle Harrisville
County Ritchie District Murphy
~~Engineer~~ D. C. McGregor, Surveyor
Engineer's Registration No.
File No. Drawing No.
Date 10-1935 Scale 1" = 40 P

STATE OF WEST VIRGINIA
DEPARTMENT OF MINES
OIL AND GAS DIVISION
CHARLESTON

WELL LOCATION MAP

FILE NO. RIT-404A

✚ Denotes location of well on United States Topographic Maps, scale 1 to 62,500, latitude and longitude lines being represented by border lines as shown.

— Denotes one inch spaces on border line of original tracing.

"IMPERIAL" TRACING CLOTH
K & E CO., N. Y.