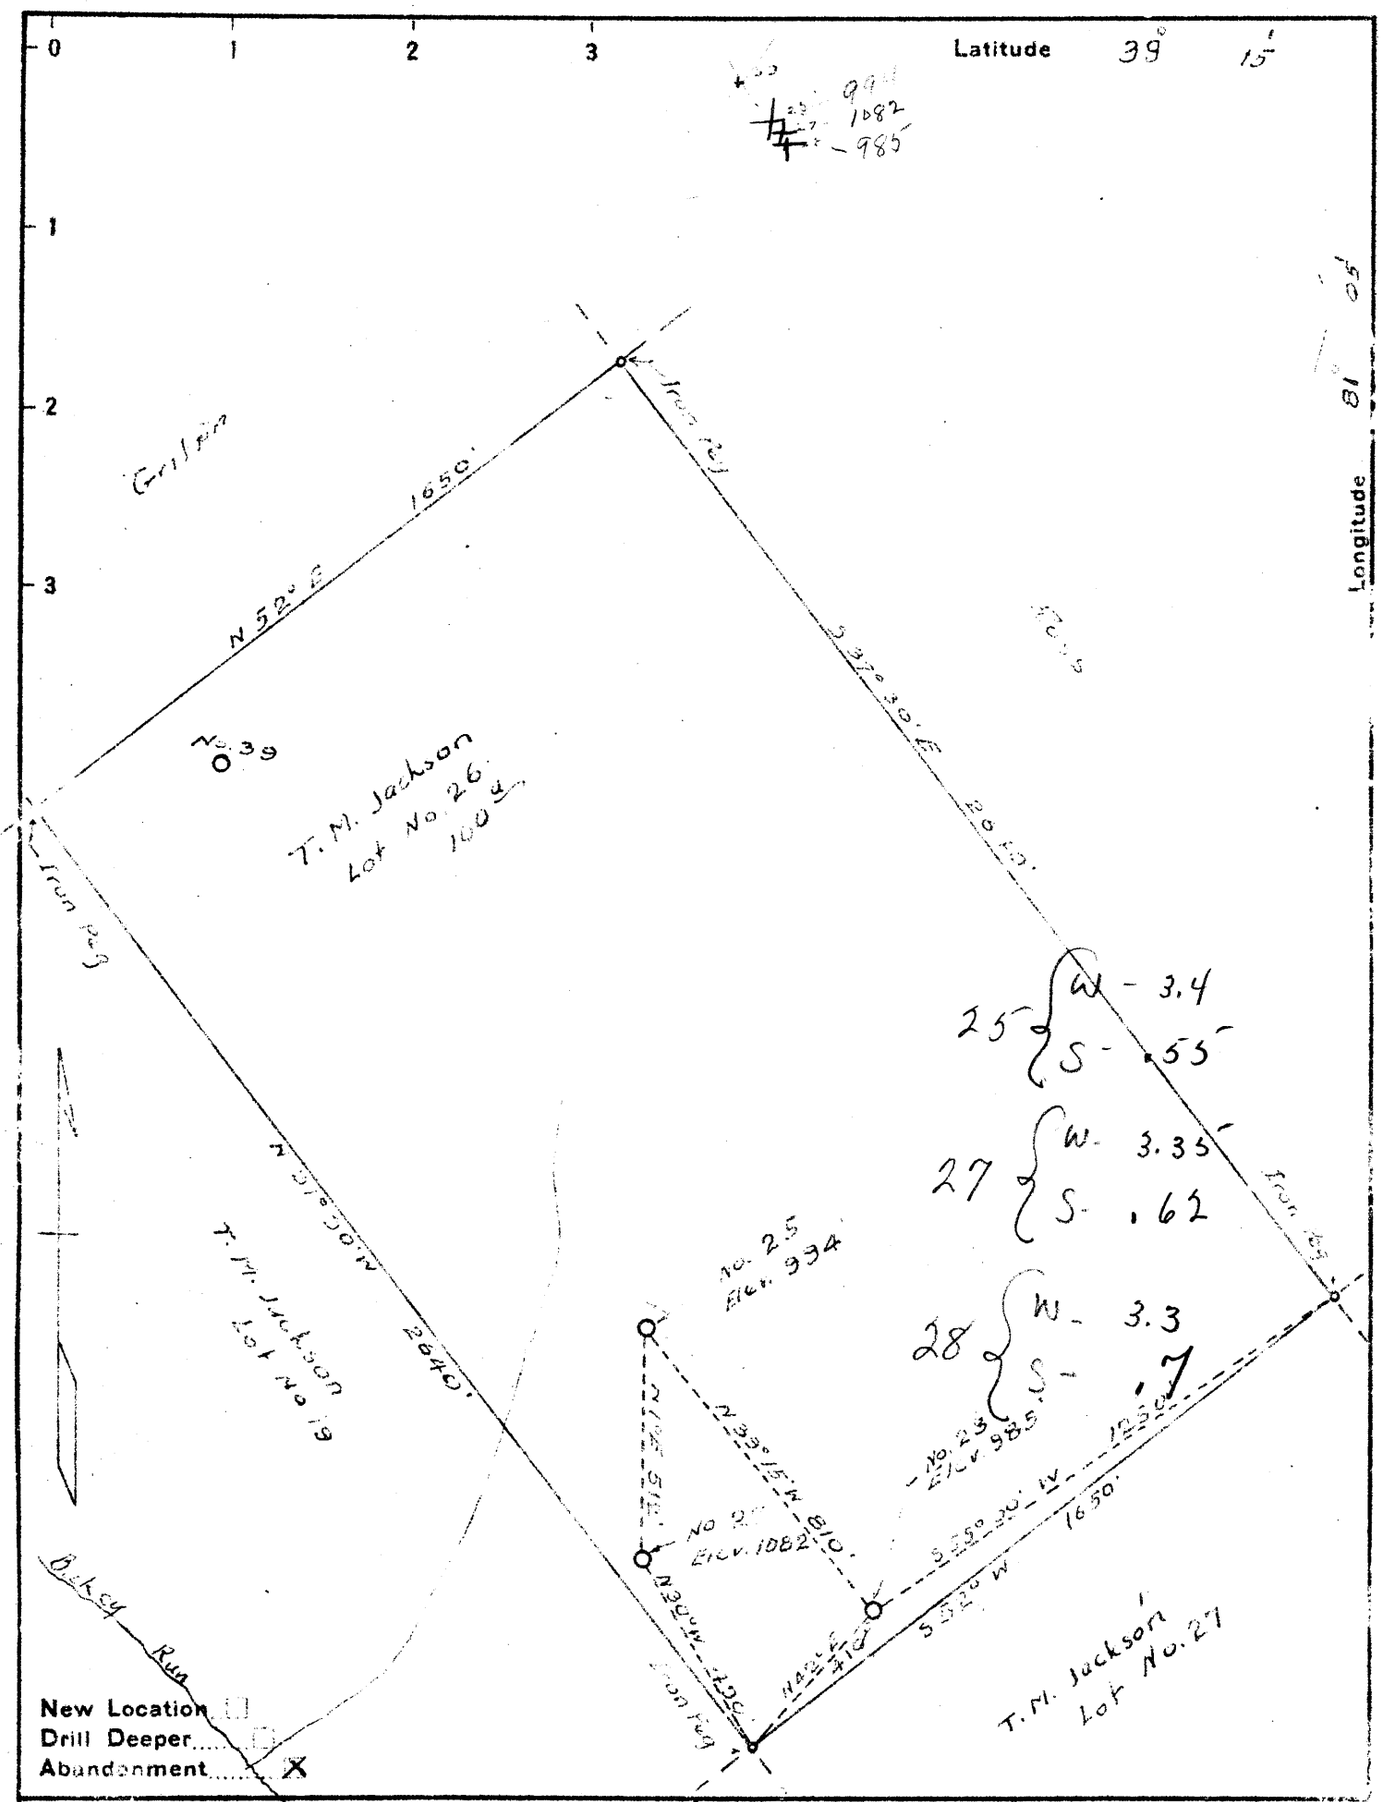

Company W. S. King

Address Spencer, W. Va.

Farm T. M. Jackson

Tract One Acres 100 Lease No.

Well (Farm) No. 25, 27, 28 Serial No.

Elevation (Spirit Level)

Quadrangle Harrisville N.

County Ritchie District Grant

Engineer Logan McDonald

Engineer's Registration No. 610

File No. Drawing No.

Date Sept 10, 1955 Scale 1" = 400'

STATE OF WEST VIRGINIA
DEPARTMENT OF MINES
OIL AND GAS DIVISION
CHARLESTON

WELL LOCATION MAP

FILE NO. RIT-480-2 & 3 A
WELLS 25 - 27 & 28

✚ Denotes location of well on United States Topographic Maps, scale 1 to 62,500, latitude and longitude lines being represented by border lines as shown.

— Denotes one inch spaces on border line of original tracing.