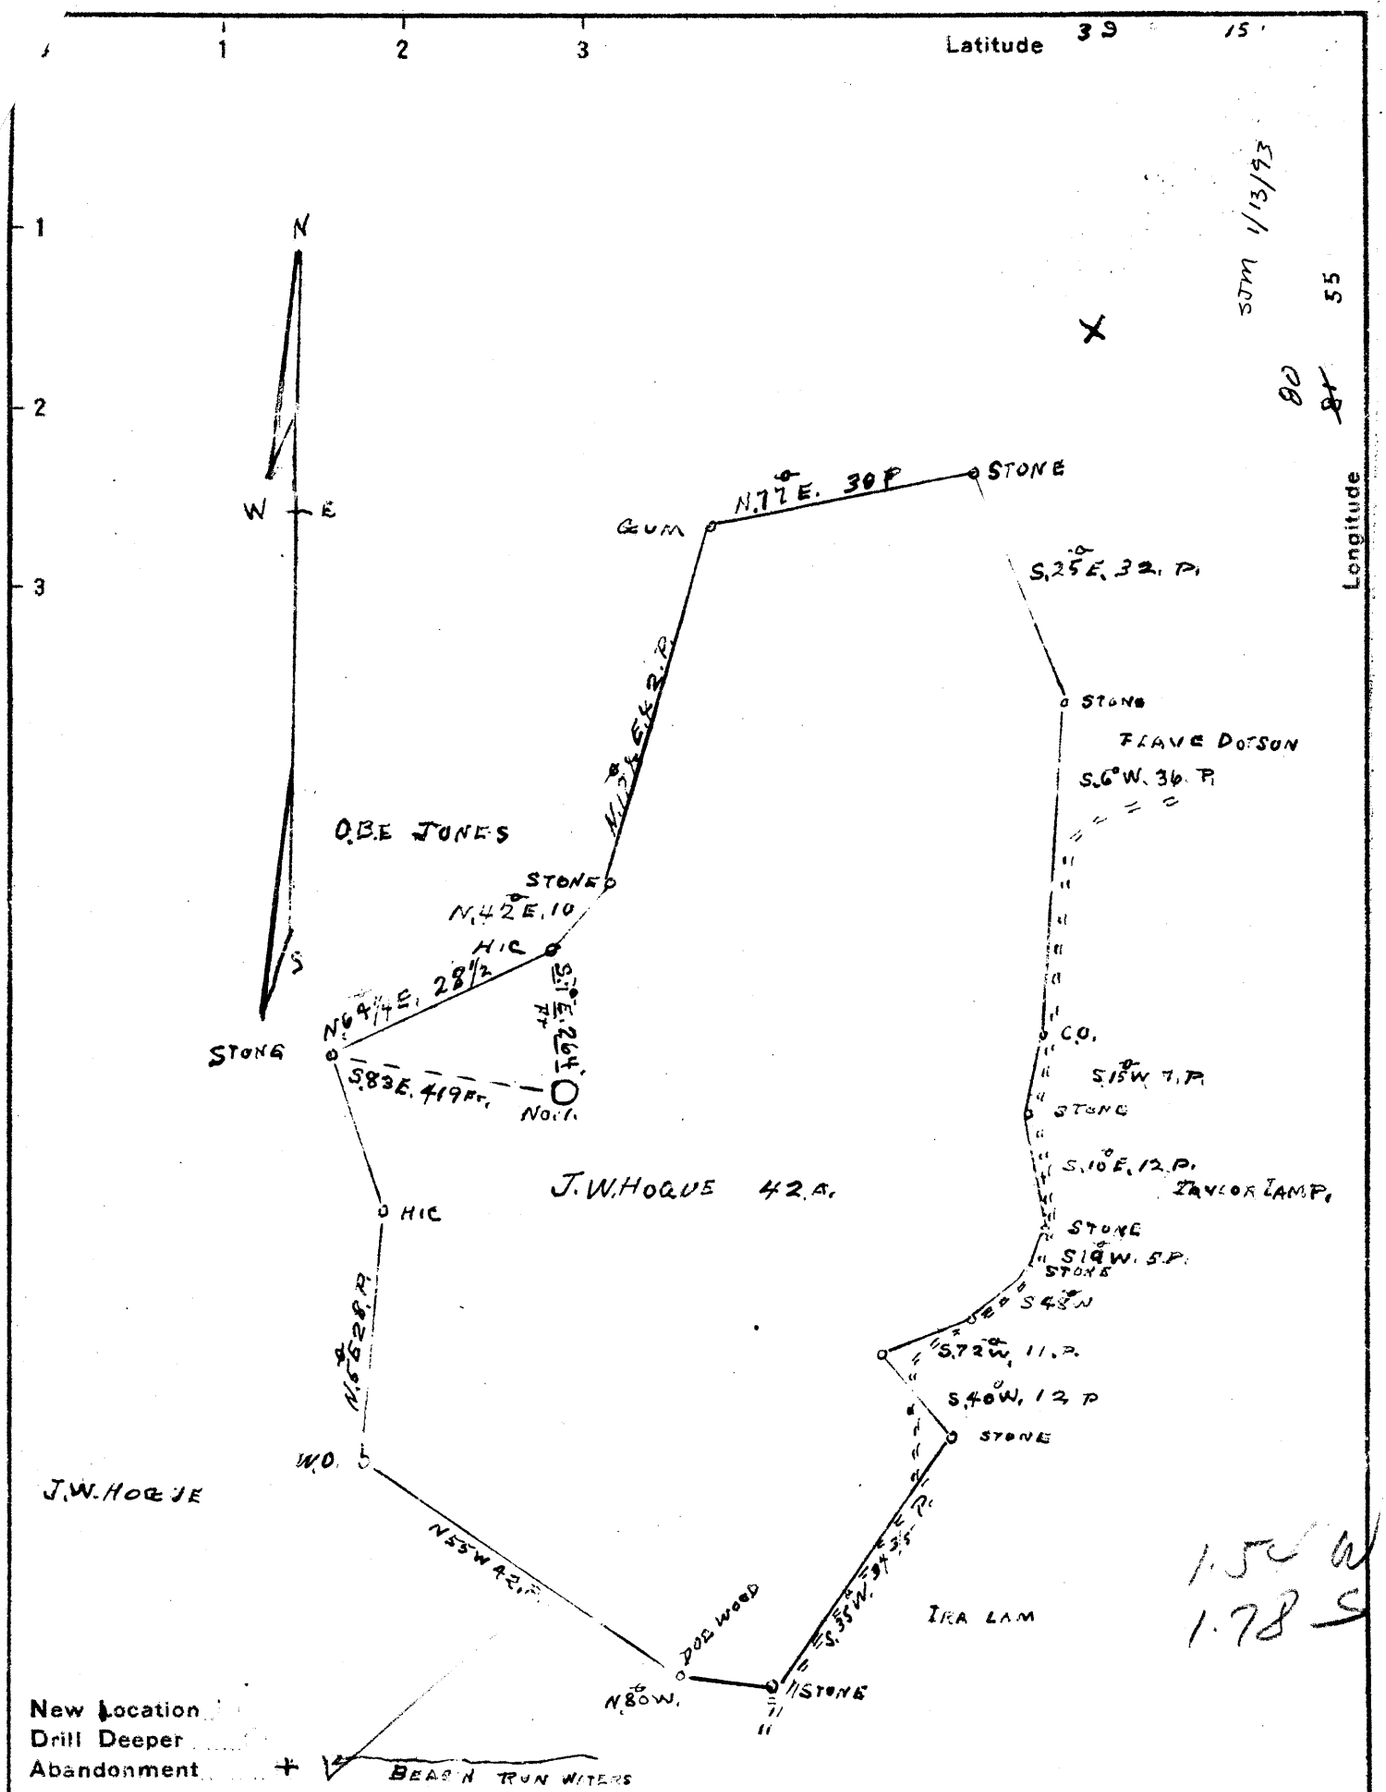

Company M. & M. Oil & Gas Co
c/o J.E. MURPHY.
Address PENNSBORO W.Va.
Farm J.W.HOGUE
Tract ____ Acres 42 Lease No. ____
Well (Farm) No. 1 Serial No. ____
Elevation (Spirit Level) 1085
Quadrangle HOLBROOK
County RITCHIE District CLAY
Engineer J. V. Dunbar
Engineer's Registration No. 65
File No. C-23 Drawing No. ____
Date May 2, 1941 Scale 20" = 1

STATE OF WEST VIRGINIA
DEPARTMENT OF MINES
OIL AND GAS DIVISION
CHARLESTON

WELL LOCATION MAP

FILE NO. RIT-532A

+ Denotes location of well on United States Topographic Maps, scale 1 to 62,500, latitude and longitude lines being represented by border lines as shown.

— Denotes one inch spaces on border line of original tracing.